


LEWIS HOMES - RAINBOW VISTA NO. 9

BEING A PORTION OF THE NORTH HALF (N1/2) OF SECTION 26,
TOWNSHIP 20 SOUTH, RANGE 60 EAST, M.D.M., CITY OF
LAS VEGAS, CLARK COUNTY, NEVADA


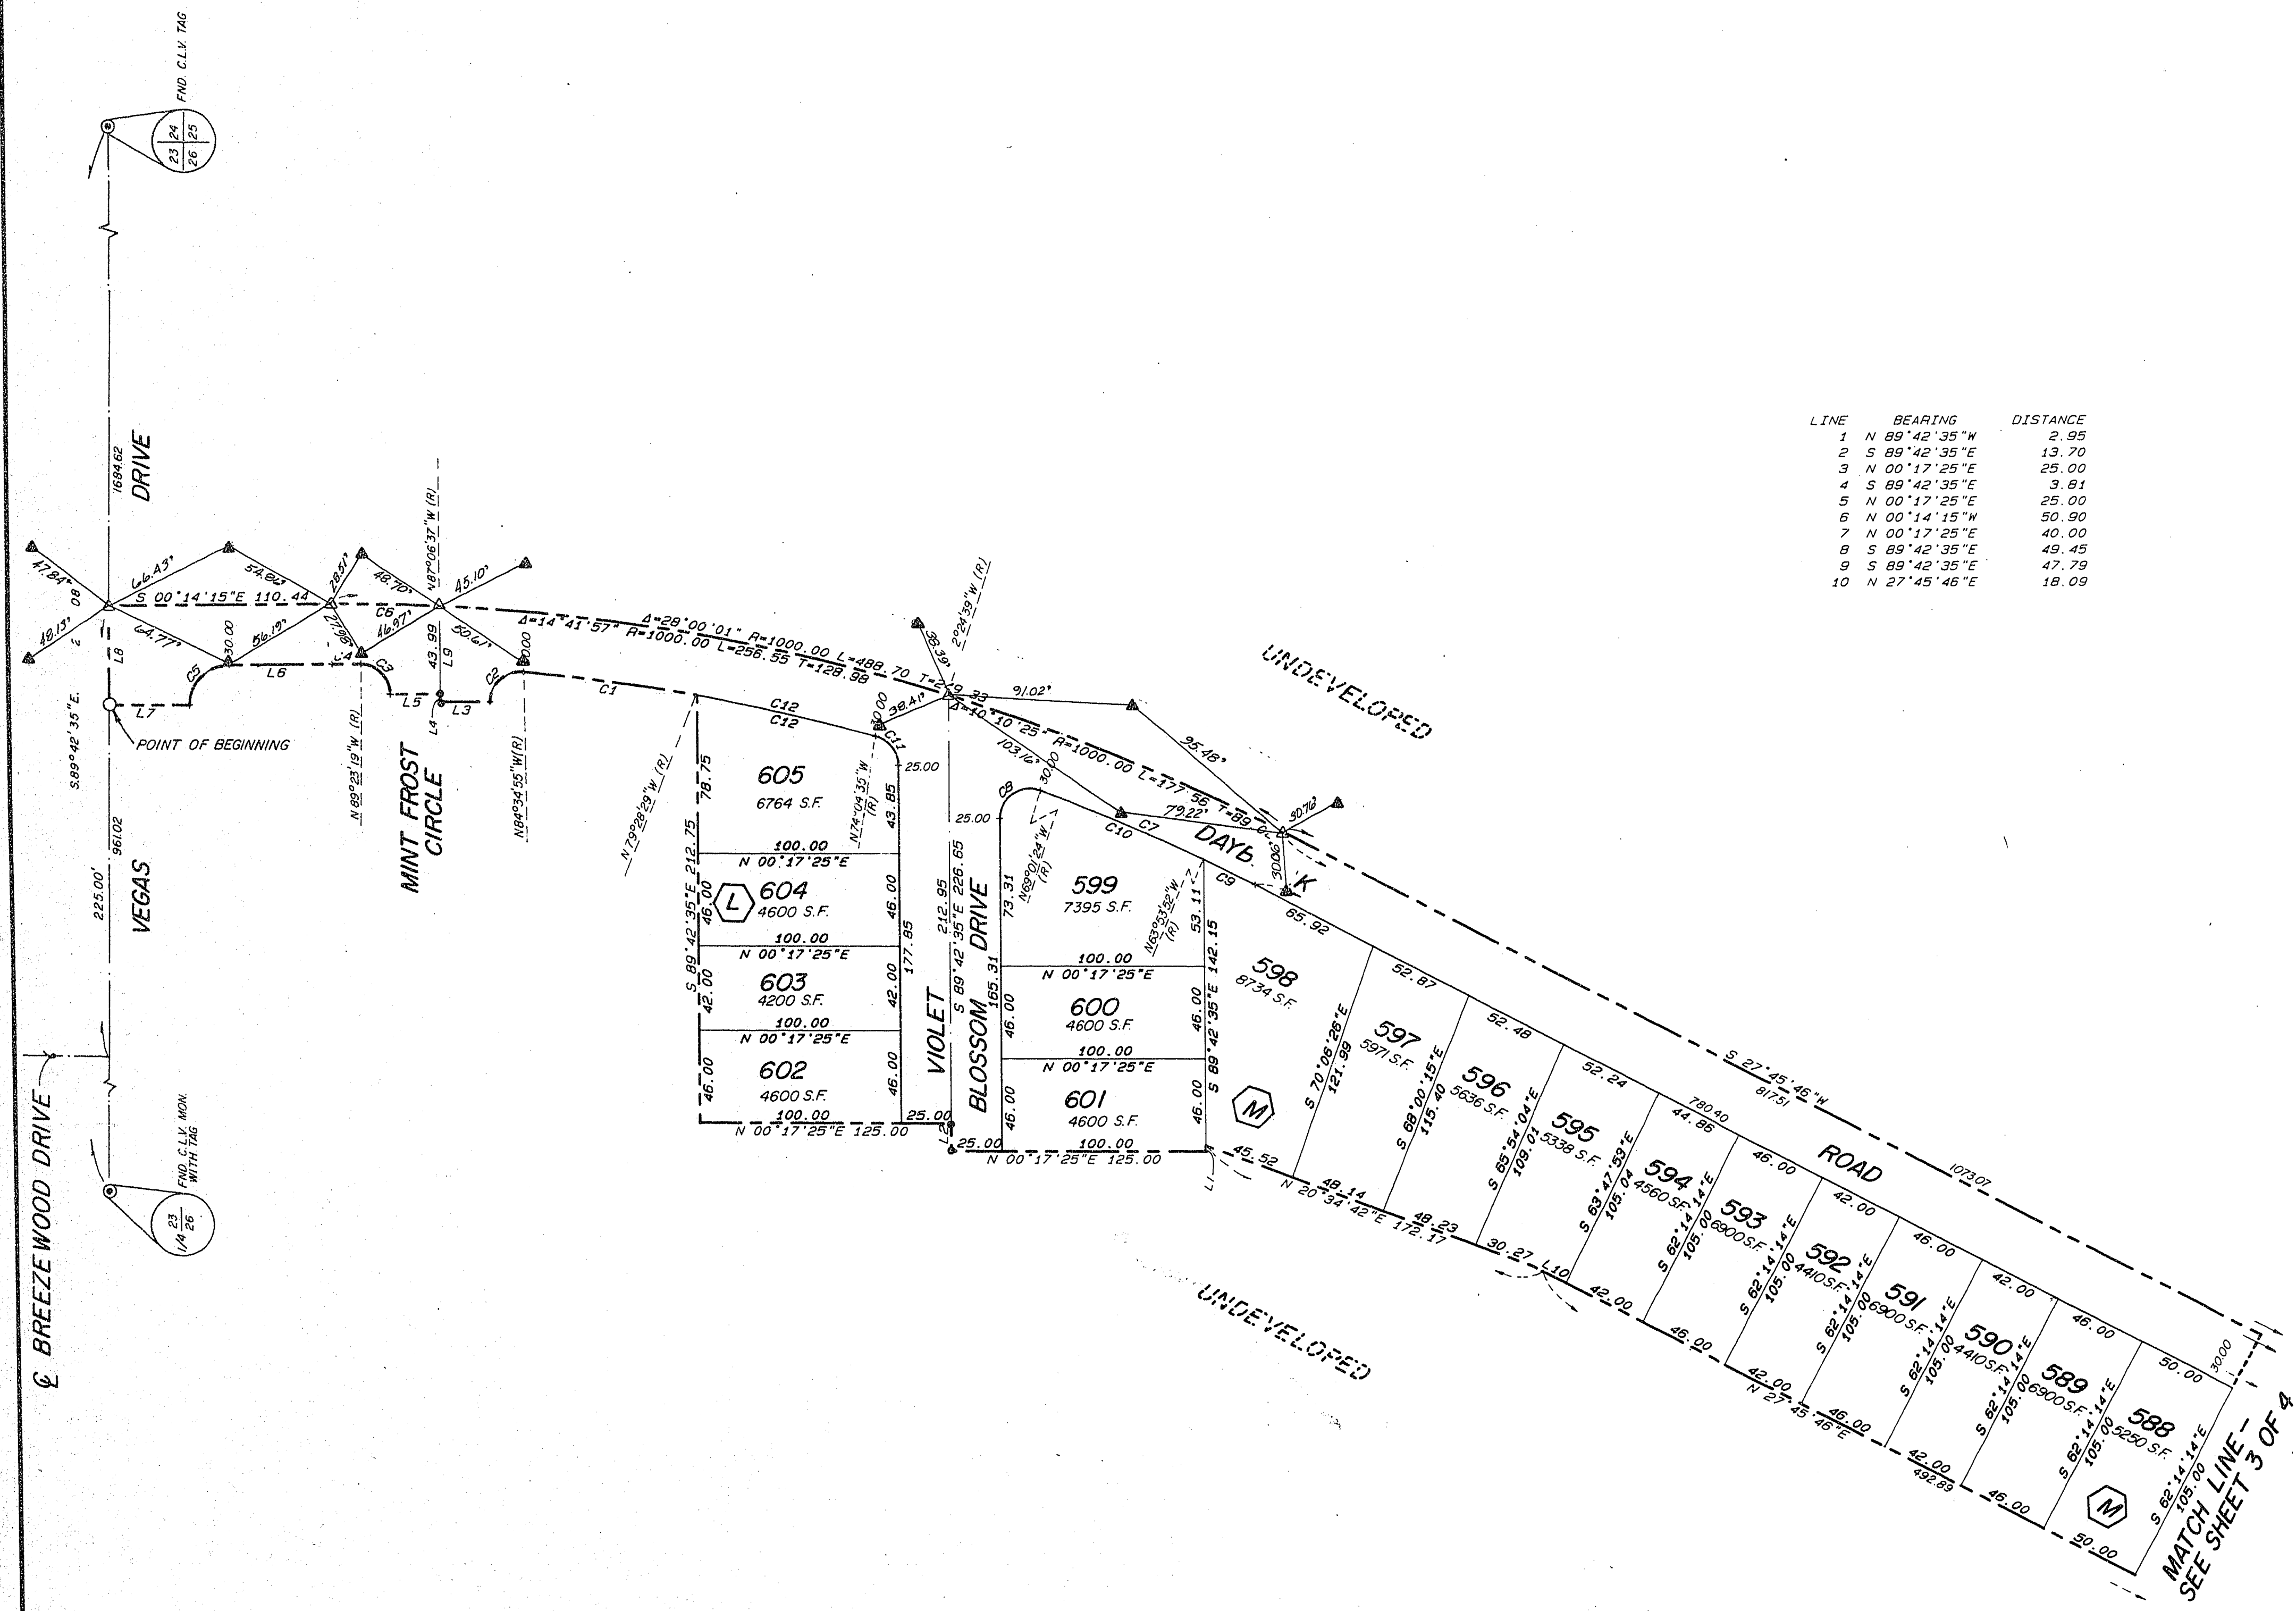


LINE	BEARING	DISTANCE
1	N 89° 42' 35" W	2.95
2	S 89° 42' 35" E	13.70
3	N 00° 17' 25" E	25.00
4	S 89° 42' 35" E	3.81
5	N 00° 17' 25" E	25.00
6	N 00° 14' 15" W	50.90
7	N 00° 17' 25" E	40.00
8	S 89° 42' 35" E	49.45
9	S 89° 42' 35" E	47.79
10	N 27° 45' 46" E	18.09

CURVE	DELTA	RADIUS	LENGTH	TANGENT
1	5° 06' 26"	970.00	86.46	43.26
2	95° 01' 40"	15.00	24.90	16.41
3	89° 40' 44"	15.00	23.48	14.92
4	0° 50' 56"	970.00	14.37	7.19
5	89° 28' 20"	20.00	31.23	19.82
6	3° 07' 38"	1000.00	54.58	27.30
7	6° 47' 10"	970.00	114.89	57.51
8	110° 41' 11"	15.00	26.88	21.70
9	1° 39' 39"	970.00	26.11	14.06
10	5° 07' 32"	970.00	86.77	43.42
11	74° 22' 00"	15.00	19.47	11.39
12	5° 23' 54"	970.00	91.39	45.73

LEGEND

- 5 LOT NUMBER
- (M) BLOCK NUMBER
- SUBDIVISION BOUNDARY
- SET 5/8" REBAR AND ALCAP R.L.S. 2050 WITH BRASS CAP REFERENCE TIES IN TOP OF CURB, AS SHOWN
- ⊙ POINT FOUND AS SHOWN
- REFERENCE POINT NOT FOUND OR SET
- C1 CURVE NUMBER
- △ SET TYPE III MONUMENT, PLS 7635
- ▲ SET 2" ALCAP IN TOP OF CURB, PLS 7635

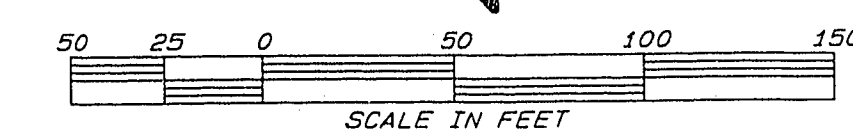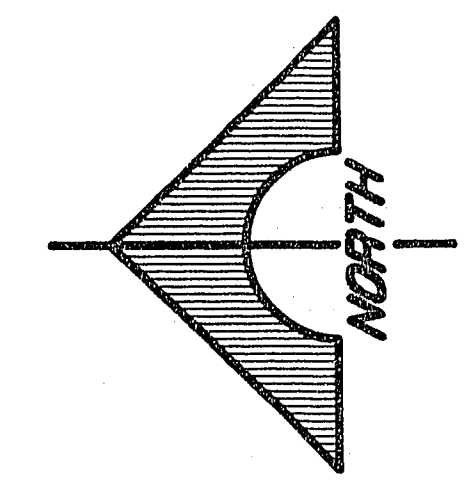

MONUMENT TIE MAP

SHEET 4 OF 4

Book 42 Page 57
058-2032-9

56-108