

LOS PRADOS PHASE 1 - UNIT 1


A PORTION OF SECTION 36, T. 19 S., R. 60 E., M.D.M., CITY OF LAS VEGAS, CLARK COUNTY, NEVADA

FND REBAR & TAG, RLS
2050 (FND CONC MON;
RE 2090, 120'S & 0.4
W OF REBAR & TAG -
NOT ACCEPTED)

DECATUR BLVD
N00°05'20"E
BASIS OF BEARINGS

FND 2x2 W/100' RP
545,077.4739 N
611,164.799 E


550,514.3289 N
611,172.6028 E

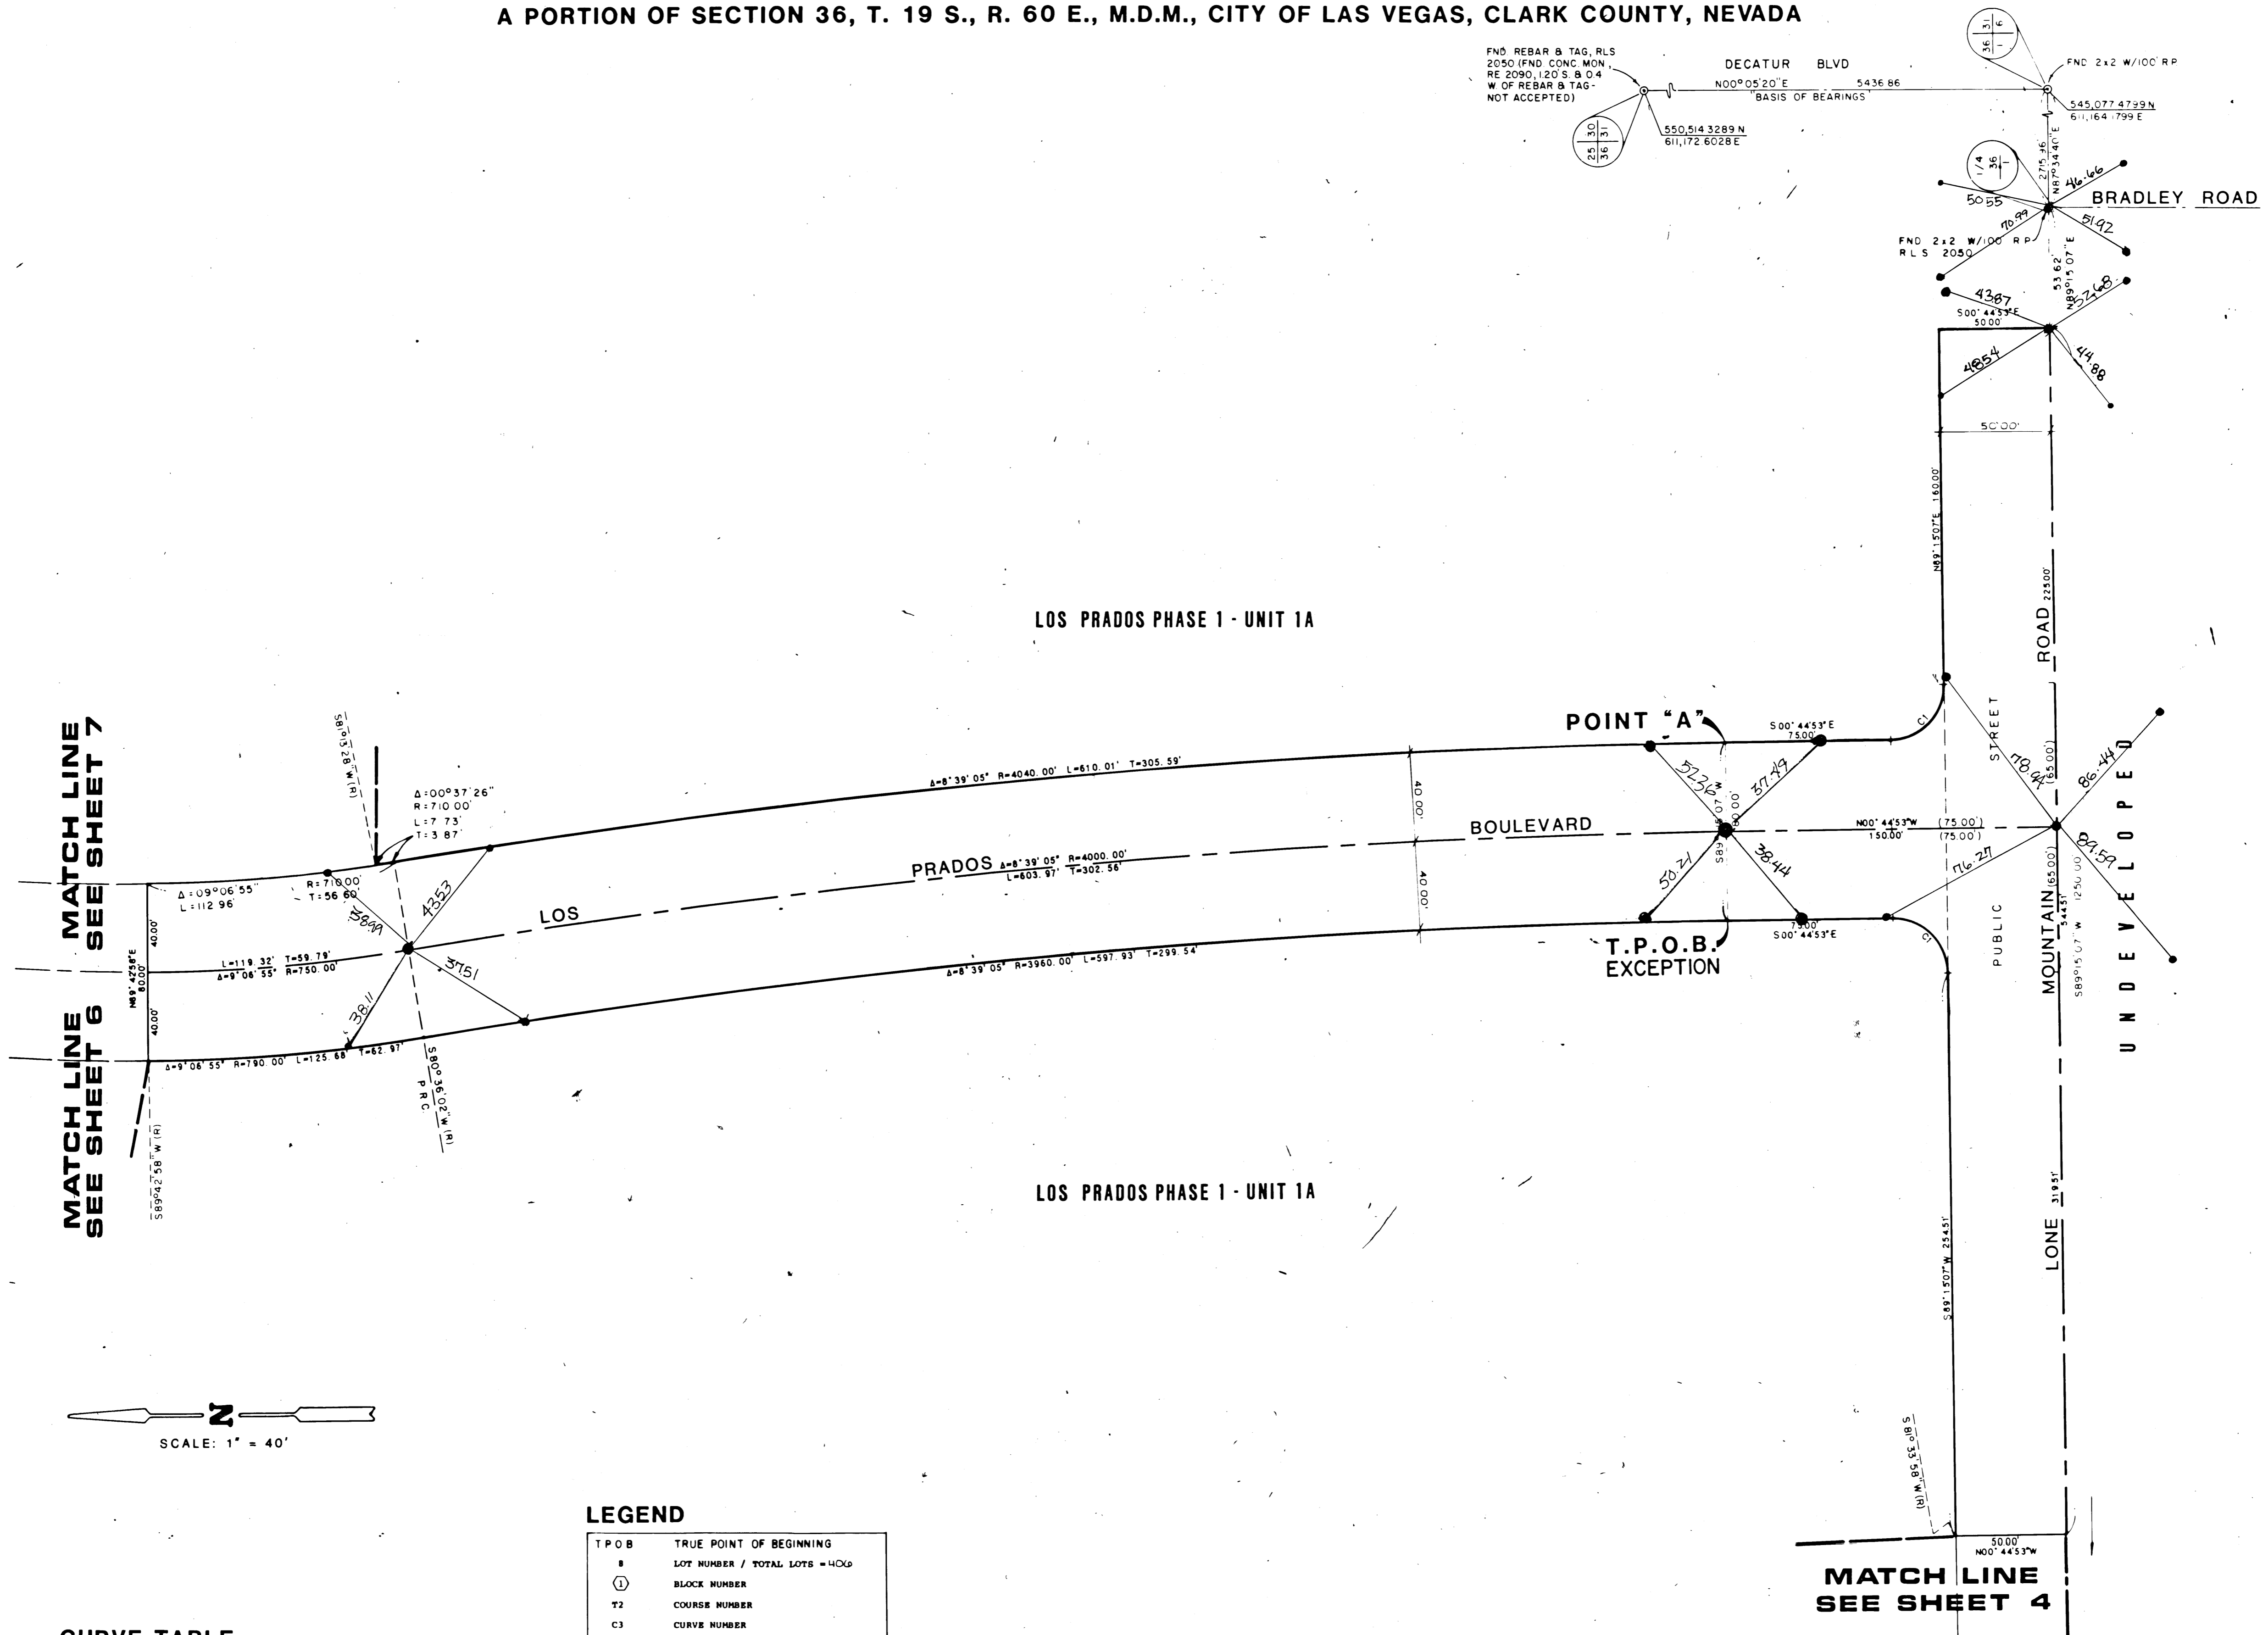

MATCH LINE SEE SHEET 7

MATCH LINE SEE SHEET 6

MATCH LINE SEE SHEET 4

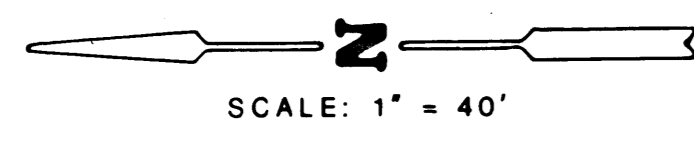

**CURVE TABLE
SHEET 8 ONLY**

NO.	DELTA	RADIUS	LENGTH	TAN
C1	90°00'00"	25.00'	39.27'	25.00'

LEGEND

- T.P.O.B TRUE POINT OF BEGINNING
 - ⊕ LOT NUMBER / TOTAL LOTS = 406
 - ① BLOCK NUMBER
 - T2 COURSE NUMBER
 - C3 CURVE NUMBER
 - BUILDING SETBACK LINE MINIMUMS:
FRONT = 20' CORNER = 15'
 - FOUND POINT AS INDICATED
 - SET 5/8" REBAR & ALUM. CAP W/BRASS
CAP REF. L.S. 6201
 - (R) RADIAL LINE
- NOTE: ALL STREETS ARE PRIVATE DRIVE AND P.U.E.
UNLESS OTHERWISE NOTED.

t-6-76