


00839

MONUMENT TIE MAP

A PORTION OF THE E 1/2 OF THE NE 1/4 OF THE SW 1/4 OF THE SE 1/4 OF SECTION 1, T. 21 S., R. 60 EAST., M.D.M., CITY OF LAS VEGAS, CLARK COUNTY, NEVADA

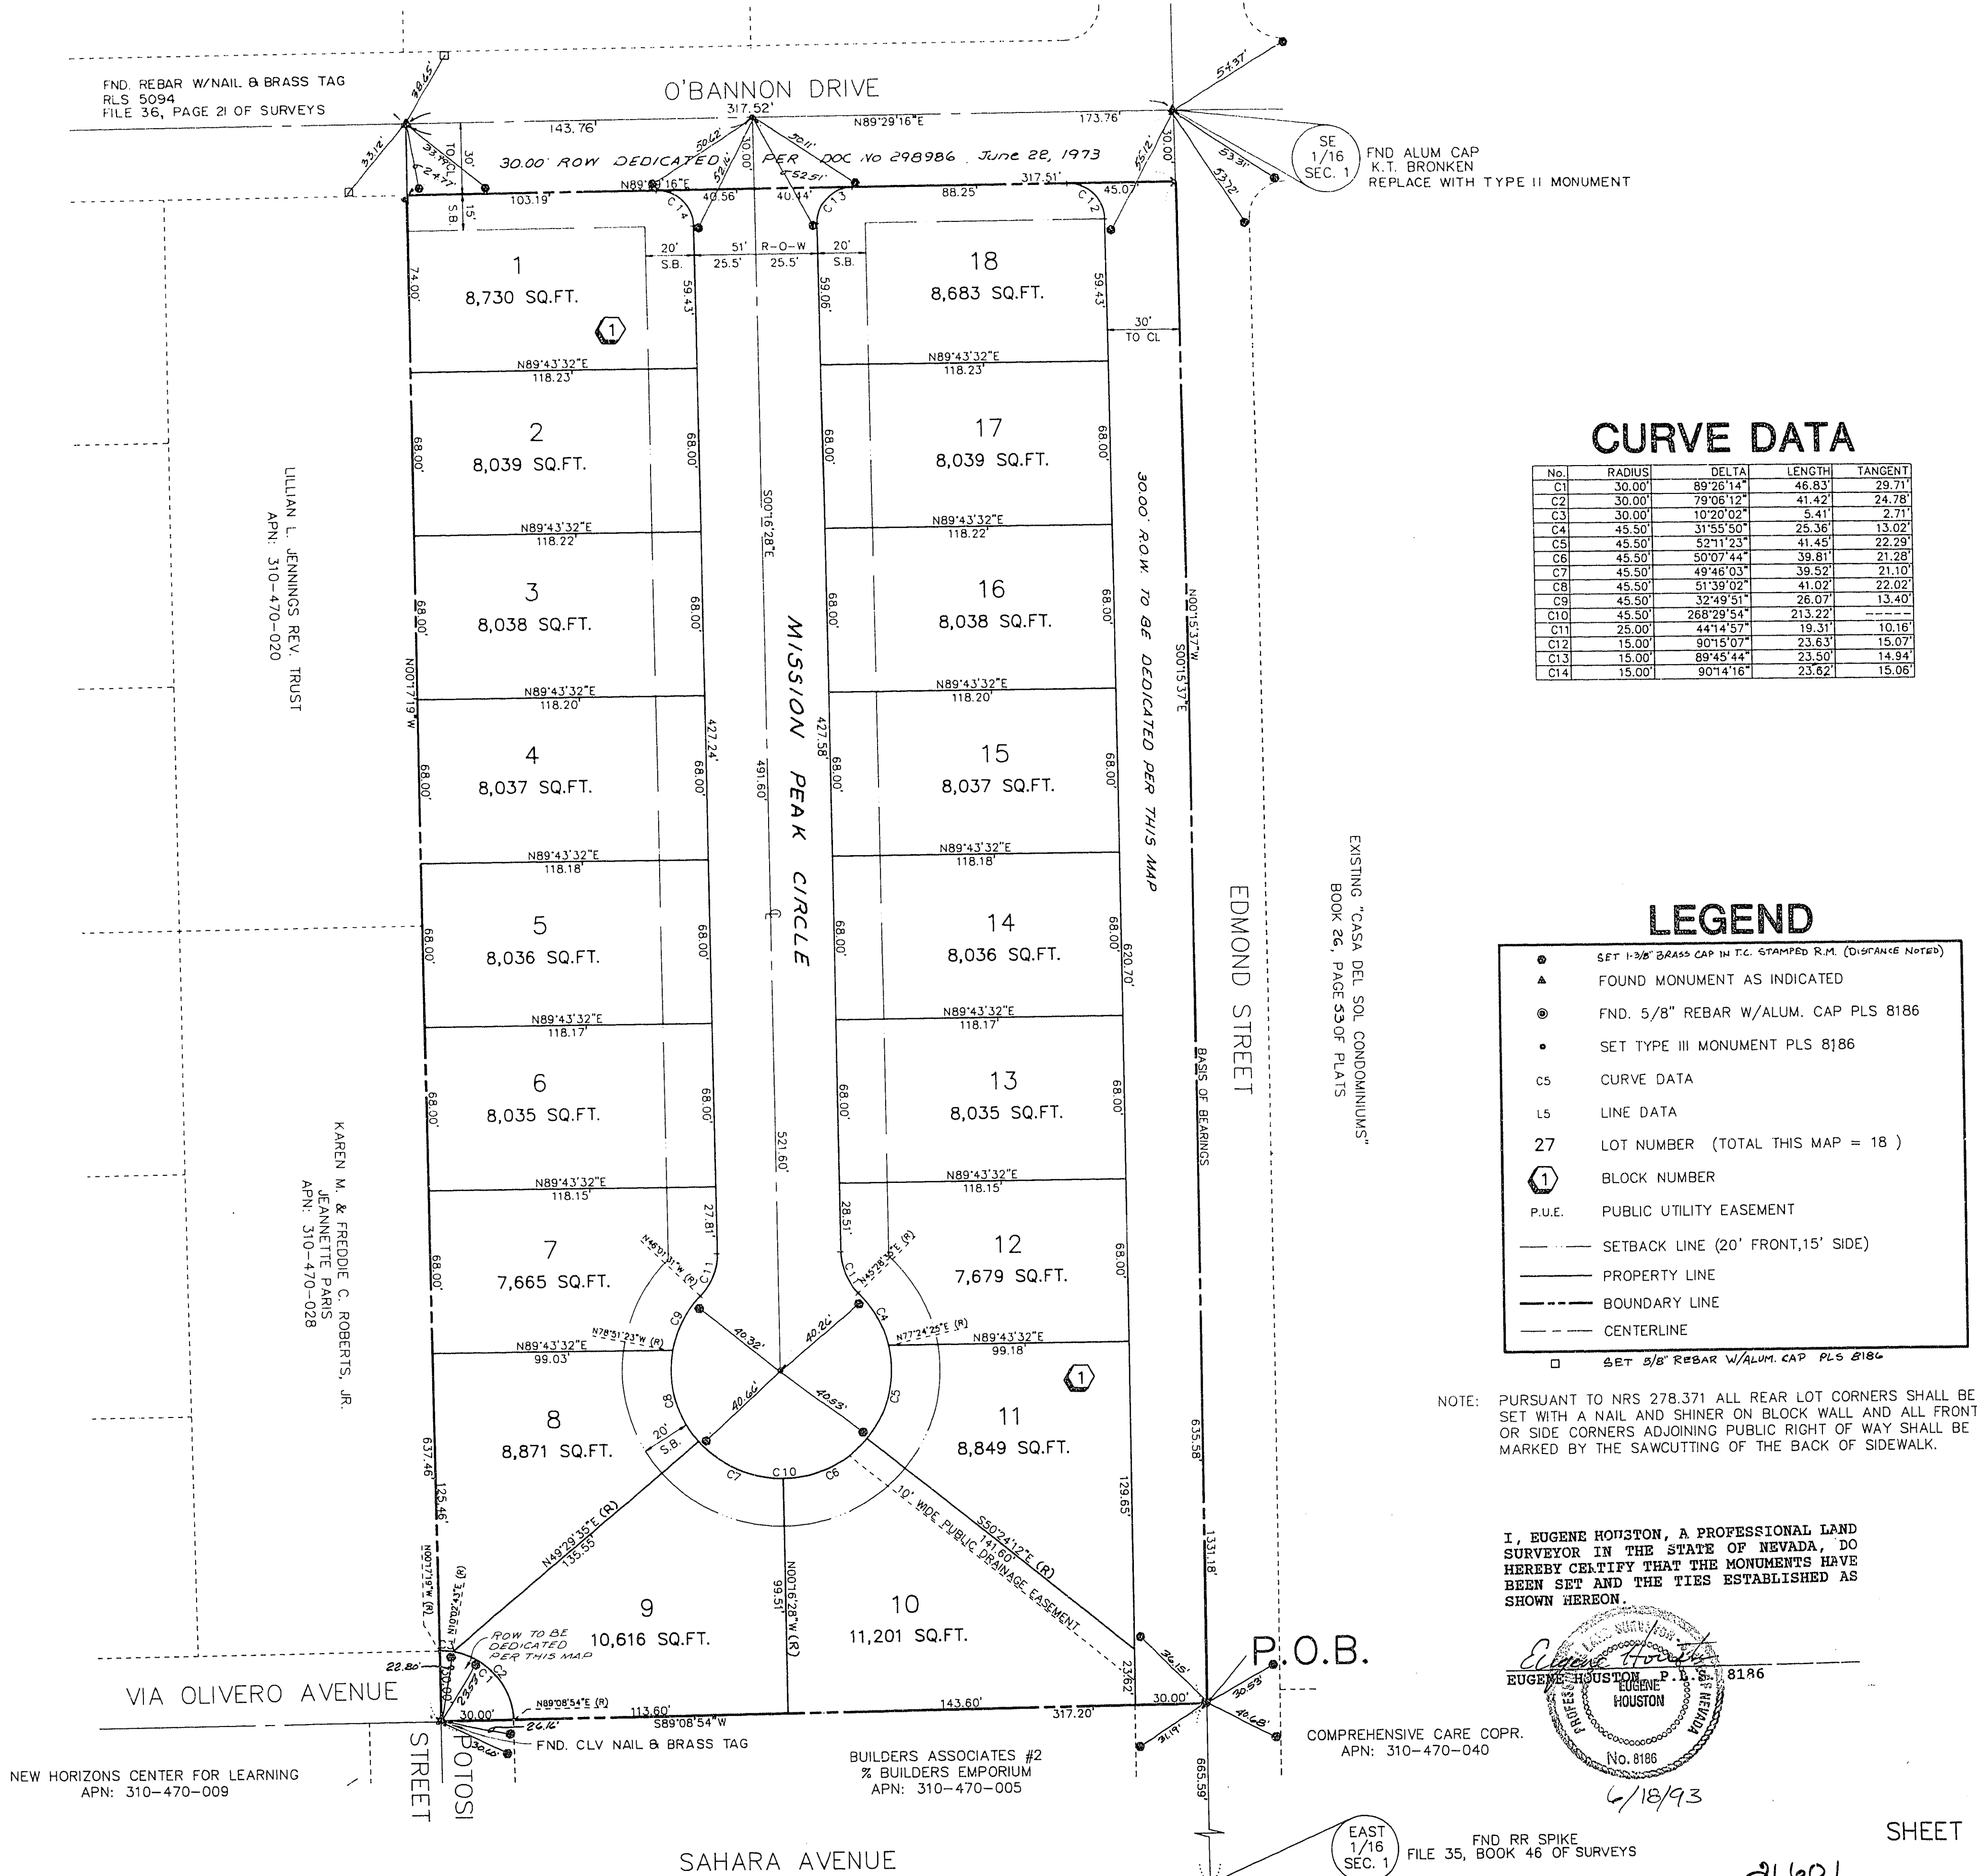

No.	RADIUS	DELTA	LENGTH	TANGENT
C1	30.00°	89°26'14"	46.83	29.71
C2	30.00°	79°06'12"	41.42	24.78
C4	45.50°	31°55'50"	25.36	13.02
C6	45.50°	50°07'44"	39.81	21.28
C9	45.50°	32°49'51"	26.07	13.40
C10	45.50°	268°29'54"	213.22	-----
C11	25.00°	44°14'57"	19.31	10.16
C13	15.00°	89°45'44"	23.50	14.94
C14	15.00°	90°14'16"	23.62	15.06

LEGEND

- ② SET 1-3/8" BRASS CAP IN P.C. STAMPED R.M. (DISTANCE NOTED)
 ▲ FOUND MONUMENT AS INDICATED
 ② FND. 5/8" REBAR W/ALUM. CAP PLS 8186
 • SET TYPE III MONUMENT PLS 8186
 C5 CURVE DATA
 L5 LINE DATA
 ① BLOCK NUMBER
 P.U.E. PUBLIC UTILITY EASEMENT
 ———— SETBACK LINE (20' FRONT, 15' SIDE)
 ———— PROPERTY LINE
 - - - - BOUNDARY LINE
 ———— CENTERLINE
 □ SET 5/8" REBAR W/ALUM. CAP PLS 8186

NOTE: PURSUANT TO NRS 278.371 ALL REAR LOT CORNERS SHALL BE SET WITH A NAIL AND SHINER ON BLOCK WALL AND ALL FRONT OR SIDE CORNERS ADJOINING PUBLIC RIGHT OF WAY SHALL BE MARKED BY THE SAWCUTTING OF THE BACK OF SIDEWALK.

I, EUGENE HONSTON, A PROFESSIONAL LAND SURVEYOR IN THE STATE OF NEVADA, DO HEREBY CERTIFY THAT THE MONUMENTS HAVE BEEN SET AND THE TIES ESTABLISHED AS SHOWN HEREON.

NO. 8186

6/18/93

SHEET 2 OF 2

11-6-55 BOOK 53 PAGE 60⁰⁵⁸⁻⁴

W.O.#	DATE	# LOTS	DATE	BY	BY
260-A350		18	MARCH 1992	JANIS	
			REVISION DESCRIPTION		
	6/9/92		Added TYPE II Man @ SE 1/4 of Recorded Map ref. for BNDY		Gene