


GENERAL NOTES:


- All construction and materials shall be in accordance with the Design and Construction Standards of the City of Las Vegas and the Uniform Standard Specifications for Public Works' Construction Off-Site Improvements, Clark County Area, Nevada, 1978. In all cases, the City's Criteria shall supersede the Uniform Standard Specifications.
- City of Las Vegas drawings shall apply to all construction.
- Sewer mains only to be laid in sewer trenches.
- All 4" house laterals to be laid at not less than minimum slopes.
- Sewer laterals locations to be marked in accordance with Standard Drawing 512.7 IN THE CITY OF LAS VEGAS STANDARDS. **ADD. NO. 2 ITEM-1**
- I shall be the contractor's responsibility to perform construction as per plans. Any additions, deletions, or changes shall first meet with the approval of the City of Las Vegas.
- If a lateral is under a driveway, concrete slab, or A.C. area, a cleanout shall be installed and raised to grade with a slotted brass cap or within a water meter box which has a metal cover marked "Sew. C.O."
- Cut sheets must be submitted to the City before construction will be permitted to start.
- All contractors installing sewer mains which will be under the jurisdiction of the City of Las Vegas must be Class "A" contractors.
- Construct Concrete Collars per Standard Drawing No. 512.9.

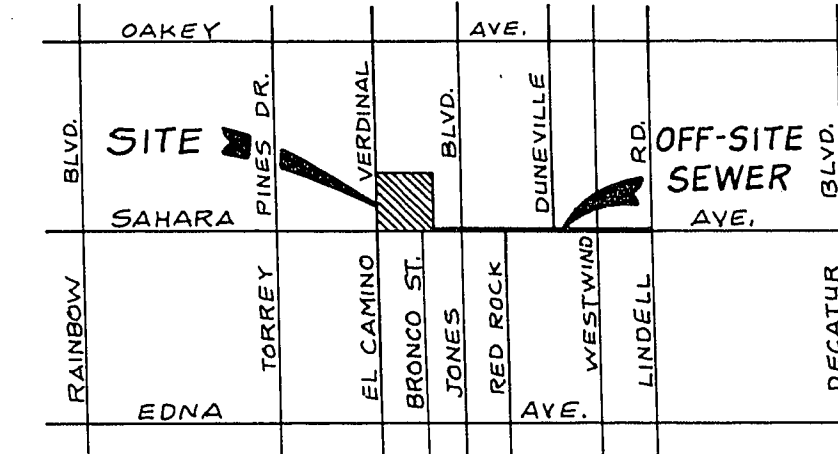

VICINITY MAP
NO SCALE

Addendum No. 2

ITEM NO. 16 - Refer to Sheets C-12, 13, 14 and 15 Pipe Materials: Ring-Tite PVC Gravity Sewer Pipe and Fitting may be substituted for Vitrified Clay Pipe (VCP). The PVC Gravity Sewer Pipe and Fittings shall meet the requirements of ASTM Specification D-3034 for SDR-35. The pipe shall be colored green for in-ground identification as sewer pipe.

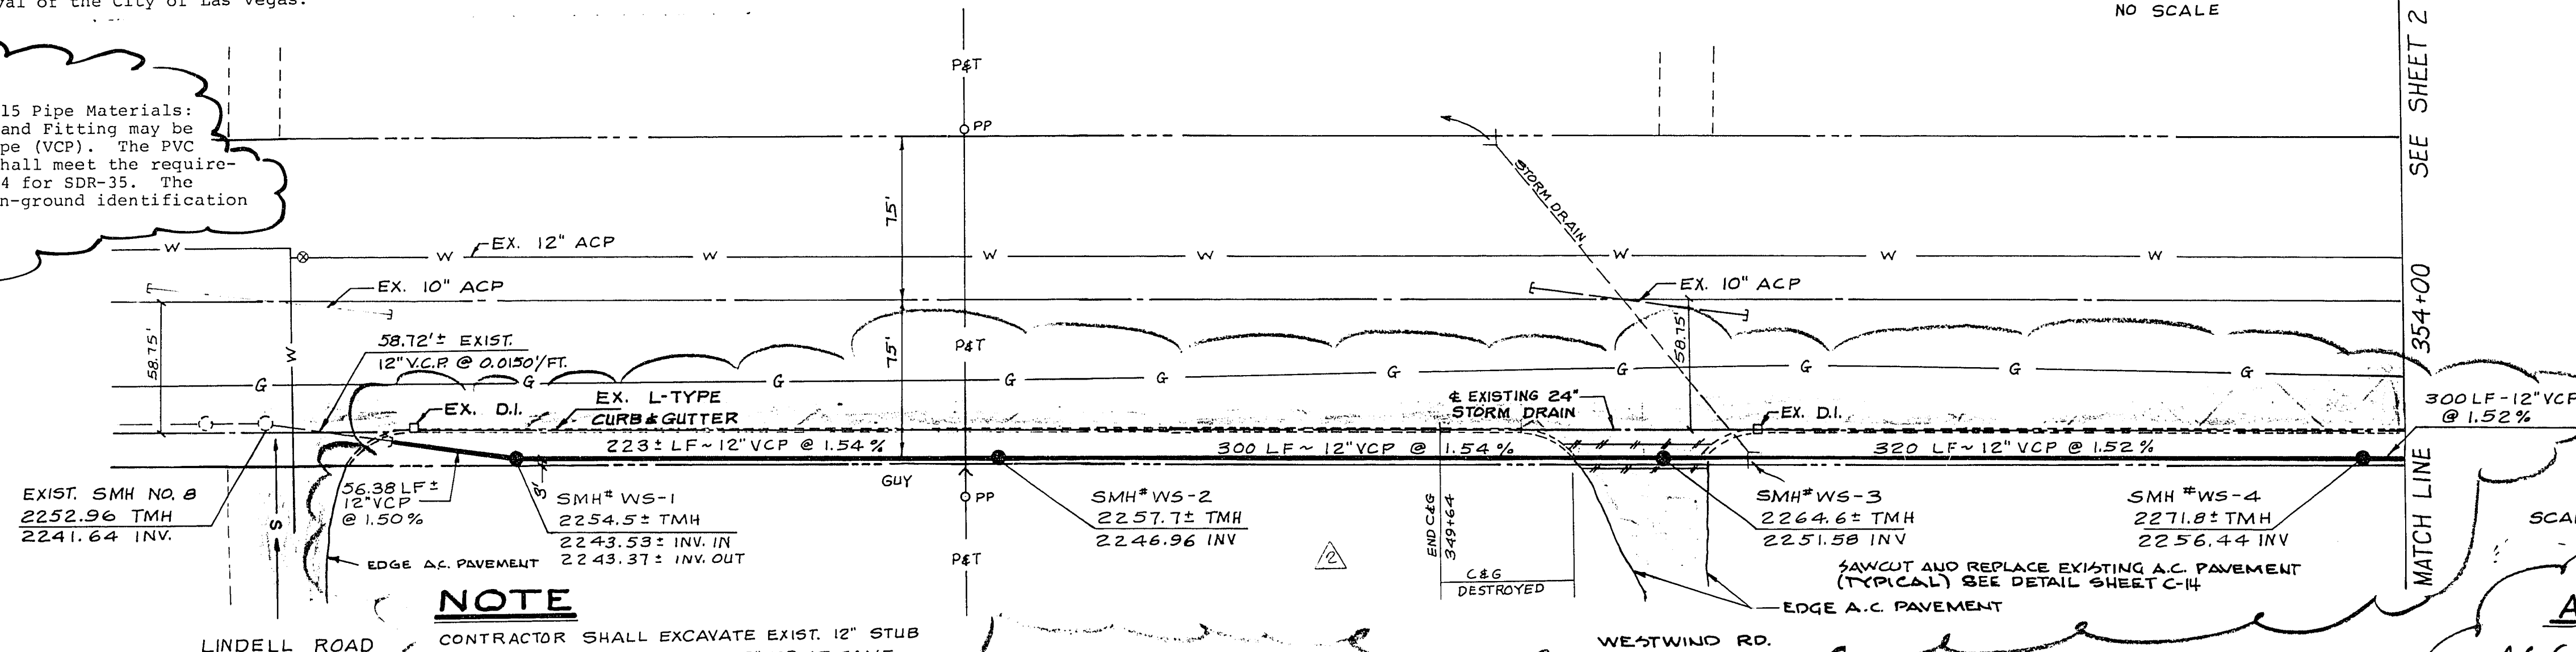

NOTE

CONTRACTOR SHALL EXCAVATE EXIST. 12" STUB AND EXTEND BY ADDING NEW 12" VCP AT SAME RATE AND ON LINE TO INTERSECT A LINE WHICH IS 3.00' SOUTH OF A PARALLEL TO THE PROPERTY LINE AND CONSTRUCT MH#WS-1 AT THE POINT OF INTERSECTION.

BENCH MARK

TOP OF CURB 60' NORTH OF INTERSECTION OF SAHARA AVE. & VERDINAL DRIVE.
CLARK COUNTY ENG. DEPT. DATUM
ELEVATION = 2310.34

APPROVALS

C.L.V. SANITATION ENGR. DATE
C.L.V. QUALITY CONTROL ENGR. DATE
C.L.V. ENGR. DATE

NOTE:

ALL EXISTING PIPE GRADES TO BE VERIFIED IN THE FIELD.

BEGIN OFF-SITE SEWER CONST.


ADD. NO. 2
ITEM NO. 2

QUANTITY ESTIMATE

12" VCP SEWER MAIN 3622 LF
4" DIA. ECC. MANHOLE (PER 512.8) 16 EA.
8" VCP SEWER MAIN 74 LF

UTILITY NOTE

The location of underground utilities shown hereon has been determined from surface diversions of their existence or from information obtained from the utility companies. The engineer accepts no liability for the existence or non-existence of utility lines. Contractors and others using this map must confirm the location of underground lines or structures with the utility companies prior to commencing any excavation.

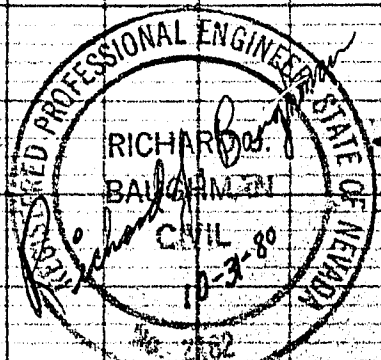

DATE	10-31-80	DESIGN	M.M.	DRAWN	M.M.	CHECK	J.B.	SCALE	1"=50'-V 1"=5'
DATE	10-31-80	DESIGN	M.M.	DRAWN	M.M.	CHECK	J.B.	SCALE	1"=50'-V 1"=5'
BAUGHMAN & TURNER CIVIL ENGINEERS MINING ENGINEERS LAND SURVEYORS 2335 WEST CHARLESTON BOULEVARD LAS VEGAS, NEVADA 89102 702-870-8271									
OFF-SITE SEWER SECTION 1, TOWNSHIP 21 SOUTH, RANGE 60 EAST, M.D.B. & M. CLARK COUNTY, NEVADA NEVADA POWER COMPANY									
SHEET C 12 OF 18 PROJ. NO. 107-V1158									