


△ Addendum No. 2

ITEM NO. 16 - Refer to Sheets C-12, 13, 14 and 15 Pipe Materials: Ring-Tite PVC Gravity Sewer Pipe and Fitting may be substituted for Vitrified Clay Pipe (VCP). The PVC Gravity Sewer Pipe and Fittings shall meet the requirements of ASTM Specification D-3034 for SDR-35. The pipe shall be colored green for in-ground identification as sewer pipe.

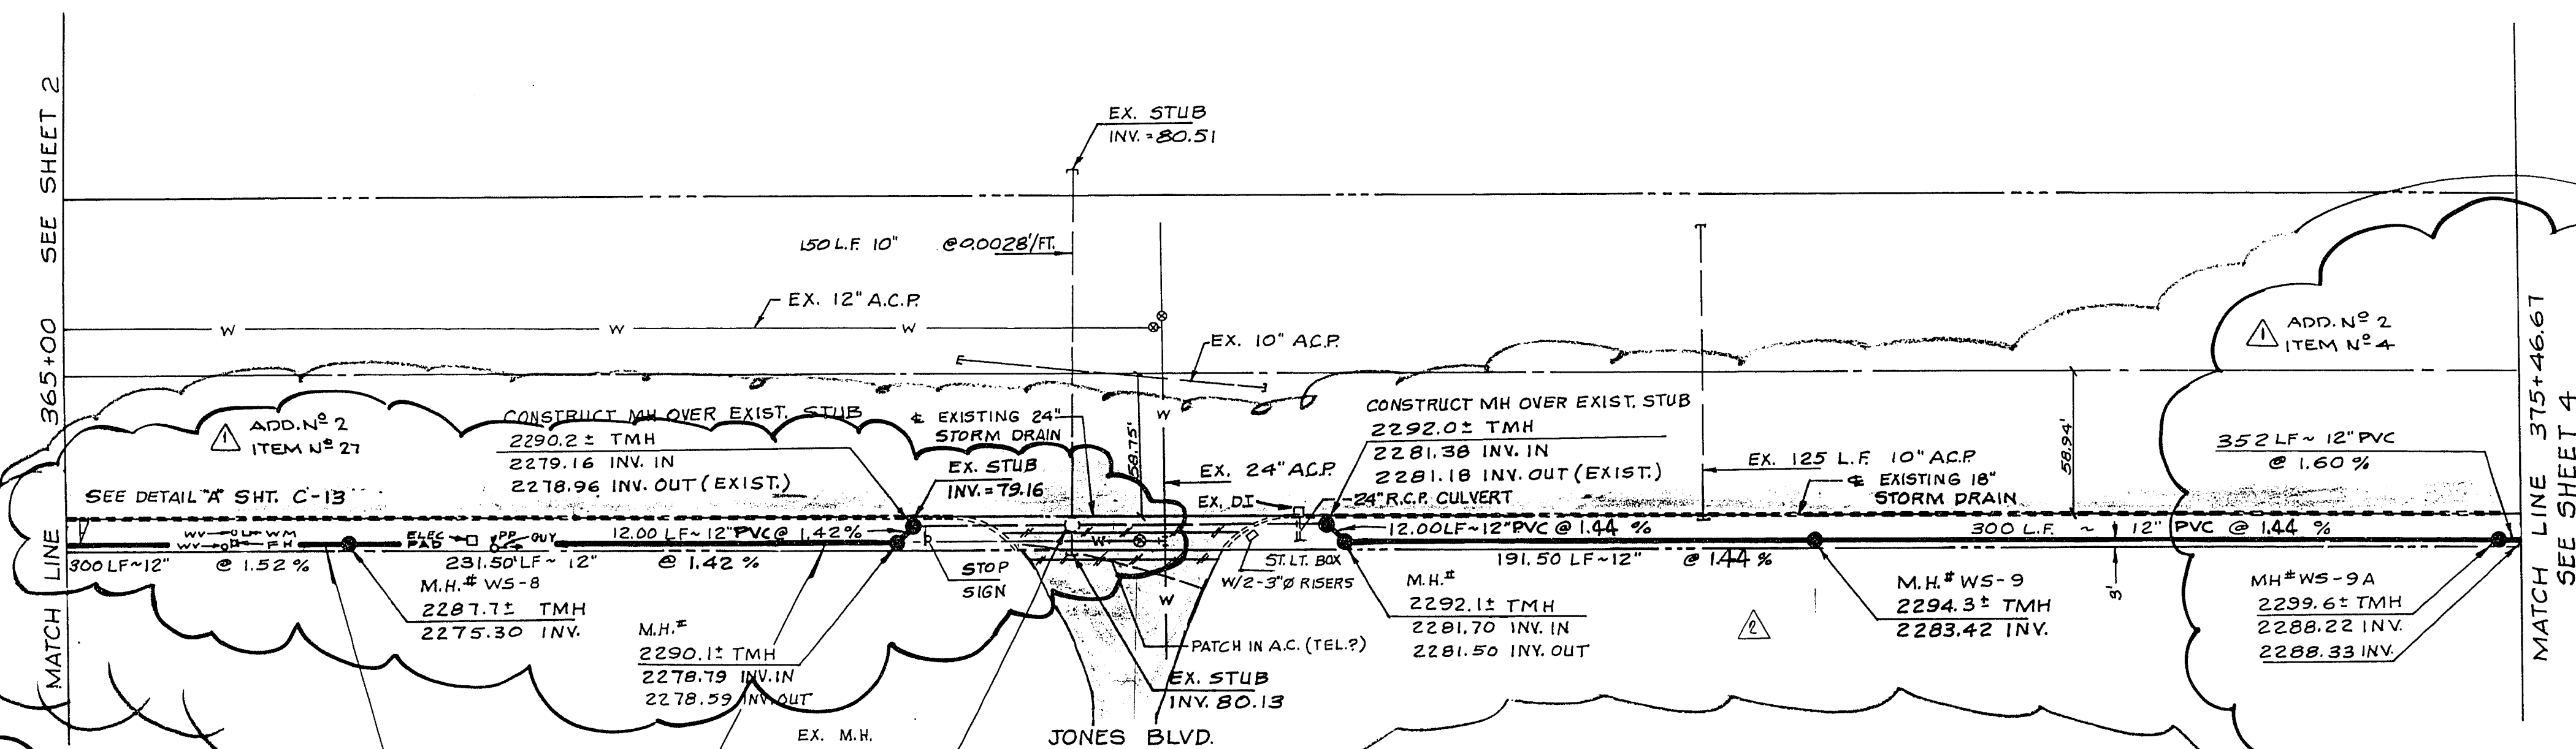

SCALE: HORIZ: 1"=50'
VERT: 1"=5'

APPROVALS


R. D. Anton 2-4-81
C.L.V. SANITATION ENGINEER DATE
David M. Smith 2-5-81
C.L.V. QUALITY CONTROL ENGINEER DATE
John 2/6/81
C.L.V. ENGINEER DATE

BENCH MARK

TOP OF CURB 60' NORTH OF INTERSECTION
OF SAHARA AVE. & VERDINAL DRIVE.
CLARK COUNTY ENG. DEPT. DATUM
ELEVATION = 2310.34

SAHARA AVE.

PERMANENT PAVEMENT

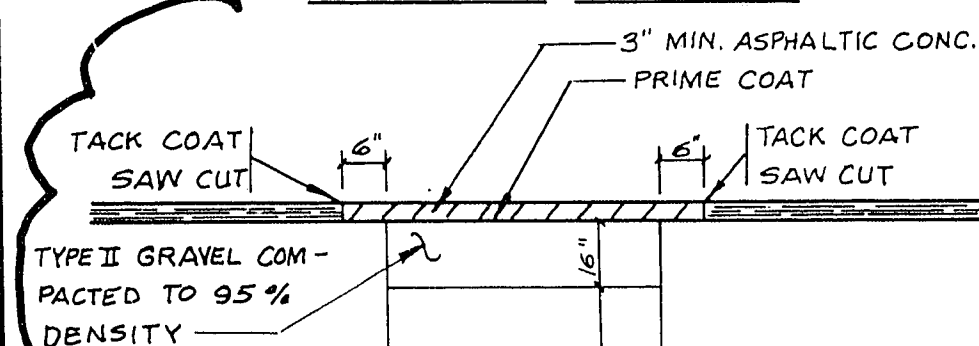


TYPE II GRAVEL BACKFILL
SHALL BE COMPACTED TO
90% BY TAMPING.

BACKFILL FOR 12\"/>


**BACKFILL AND PAVEMENT
REPLACEMENT DETAIL**
NO SCALE

MATCH LINE 365+00 SEE SHEET 2

MATCH LINE 375+46.67
SEE SHEET 4

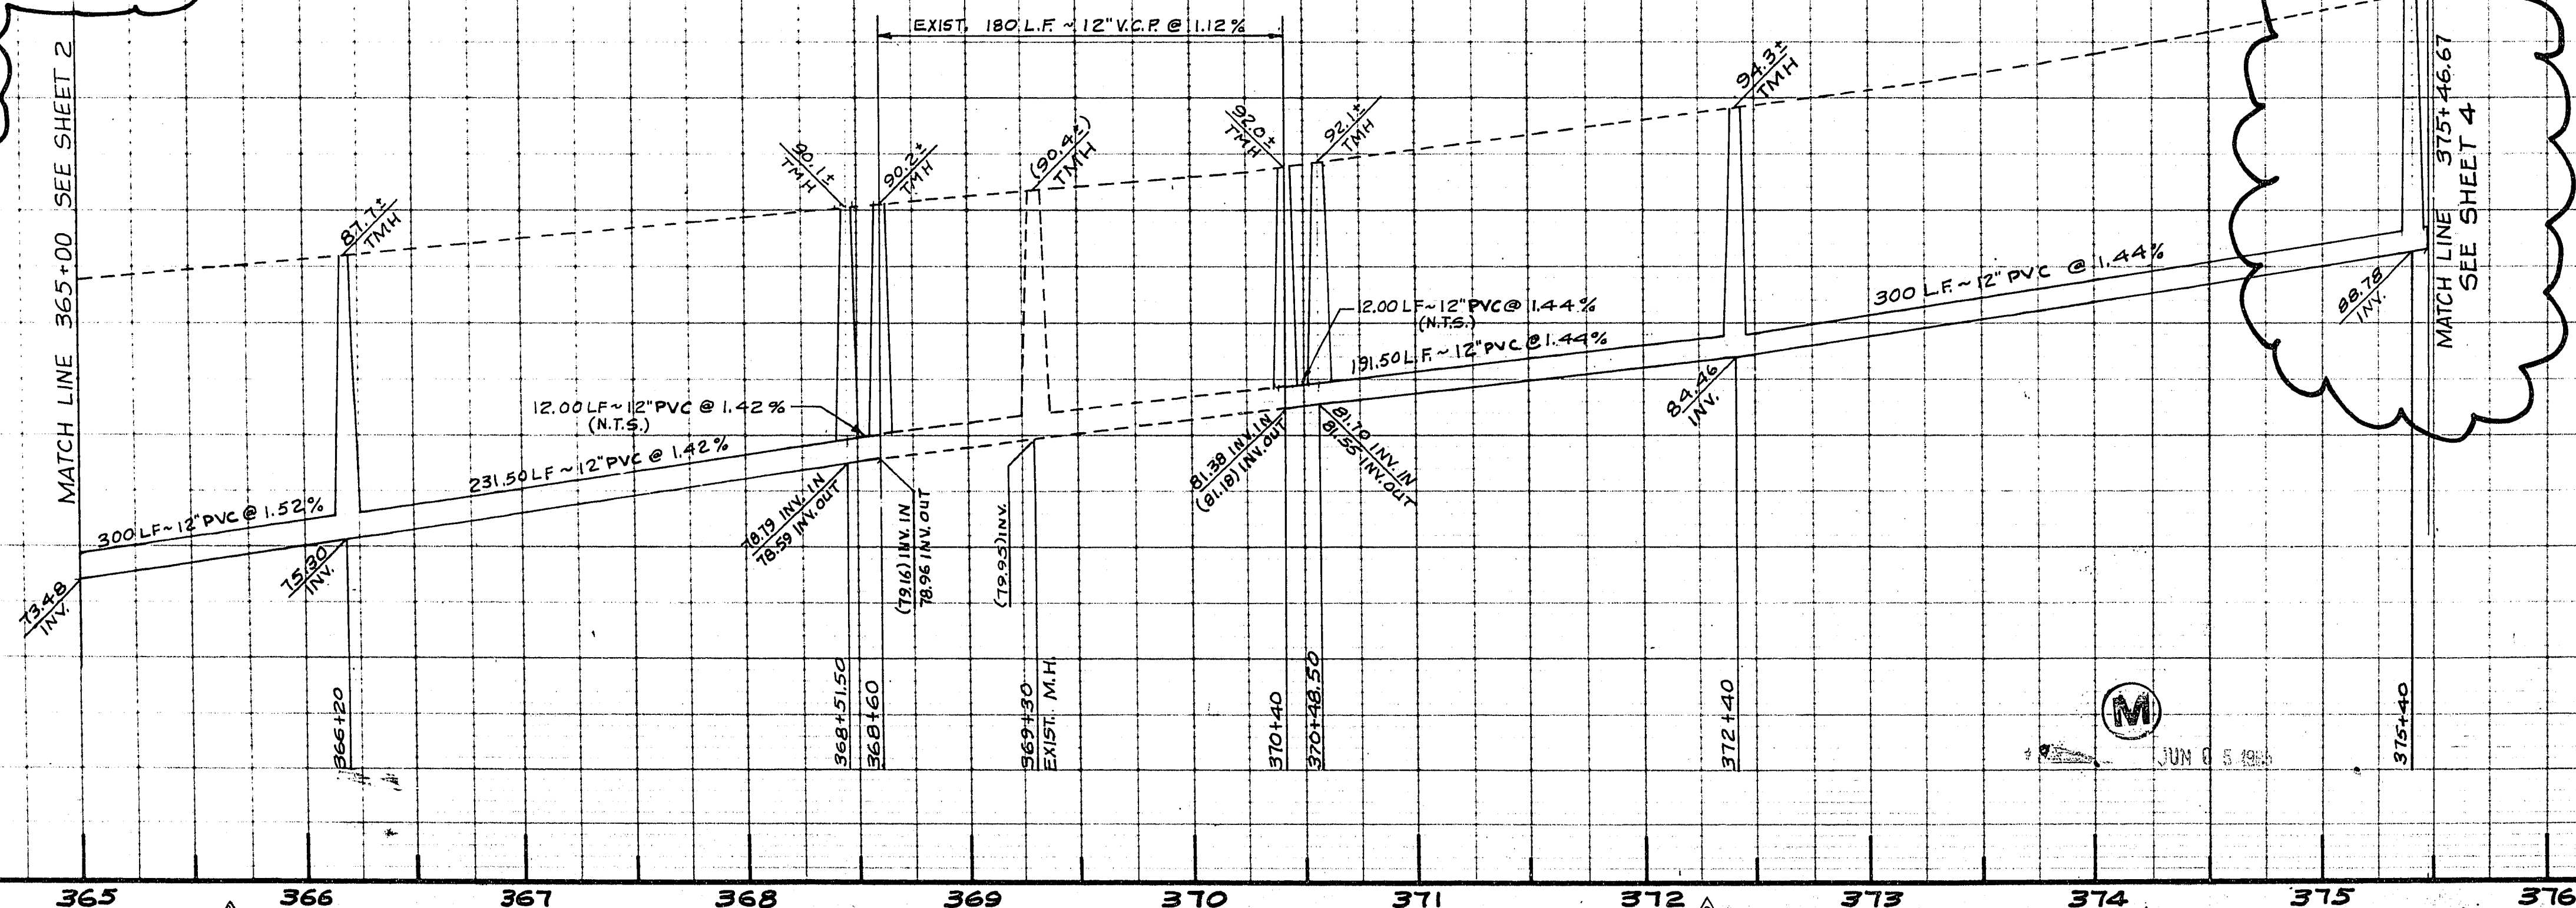

UTILITY NOTE
The location of underground utilities shown herein has been determined from surface evidence of their existence or from information obtained from the utility companies. The Engineer accepts no liability for the existence or non-existence of utility lines. Contractors and others using this map must confirm the location of underground lines or structures with the utility companies prior to commencing any excavation.

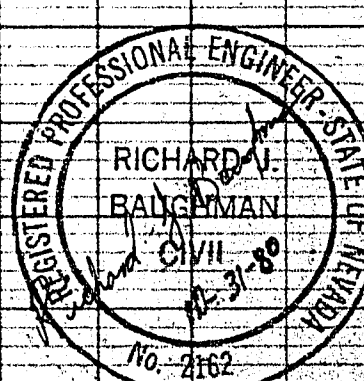

DATE: 10-31-80	DESIGN: M.M.	PREPARED FOR: BAUGHMAN & TURNER	REVISIONS: 1. ADD ADDENDUM NO. 2 ITEM NOS. 16, 17, 27 2. RELOCATE 12\"/>
	DRAWN: M.M.		
CHECK: R.T.B.	SCALE: H 1"=50' V 1"=5'	CIVIL ENGINEERS	LAND SURVEYORS
LAS VEGAS, NEVADA 89102		2325 WEST CHARLESTON BOULEVARD 702-870-8771	
OFF-SITE SEWER		NEVADA POWER COMPANY	
SECTION 1, TOWNSHIP 21 SOUTH, RANGE 60 EAST, M.D.B. & M.		CLARK COUNTY NEVADA	
SHEET 14 OF 14		PROJ. NO. 107-V-1158	