



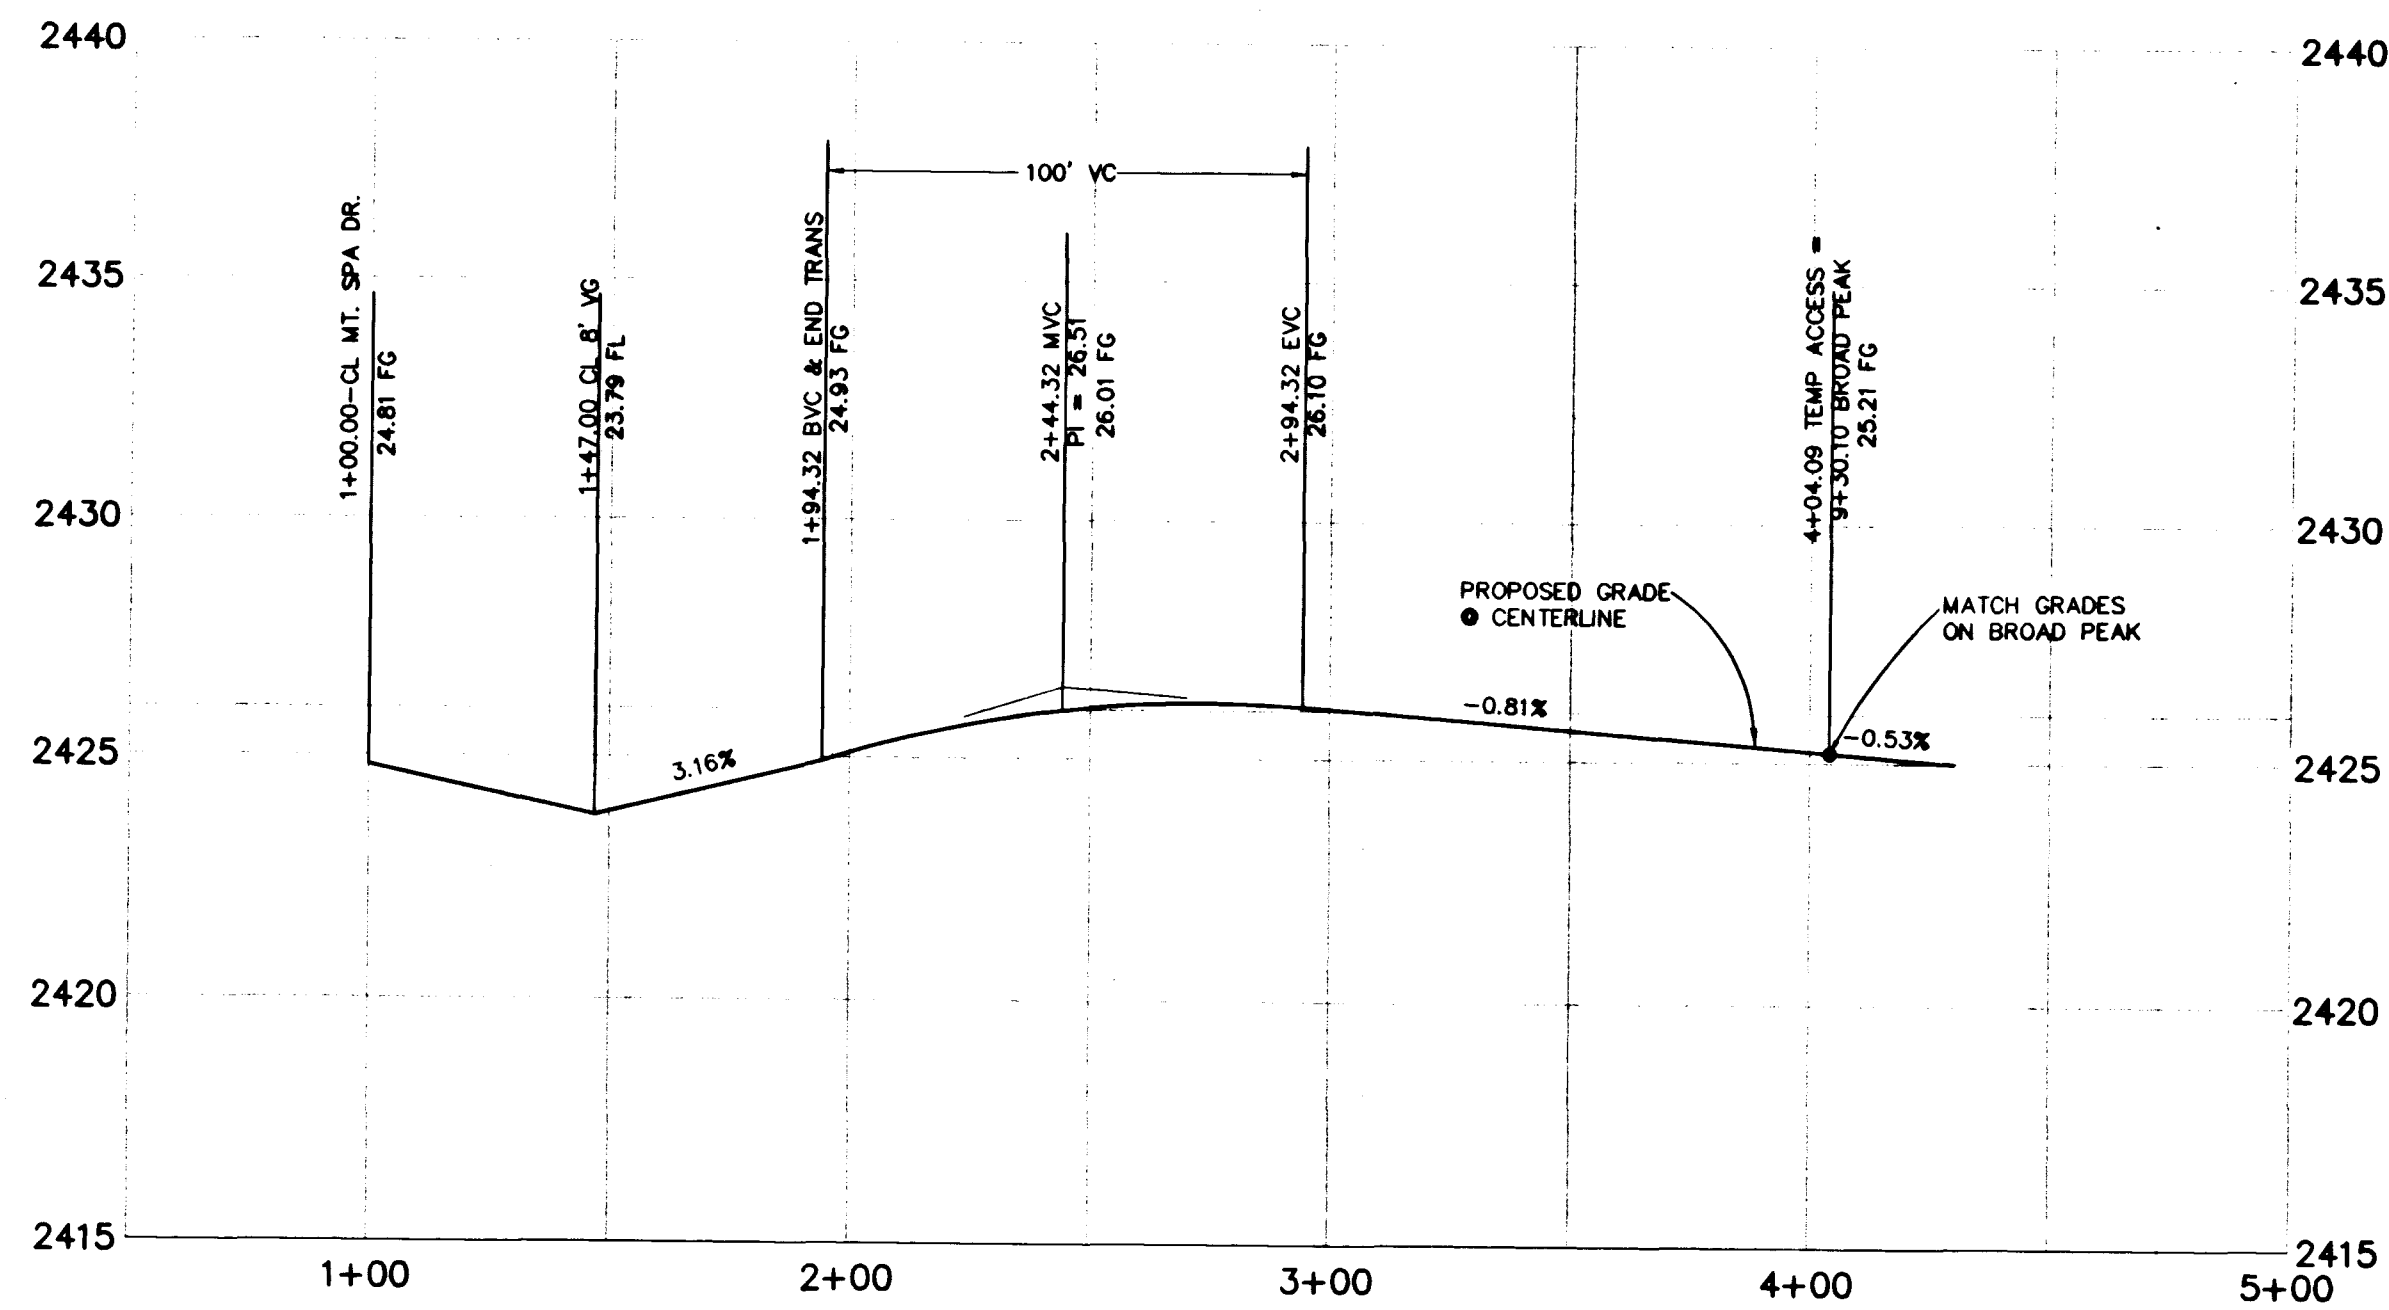


TEMPORARY ACCESS ROAD

PROFILE

SCALE: HORIZ. 1" = 40'
VERT. 1" = 4'

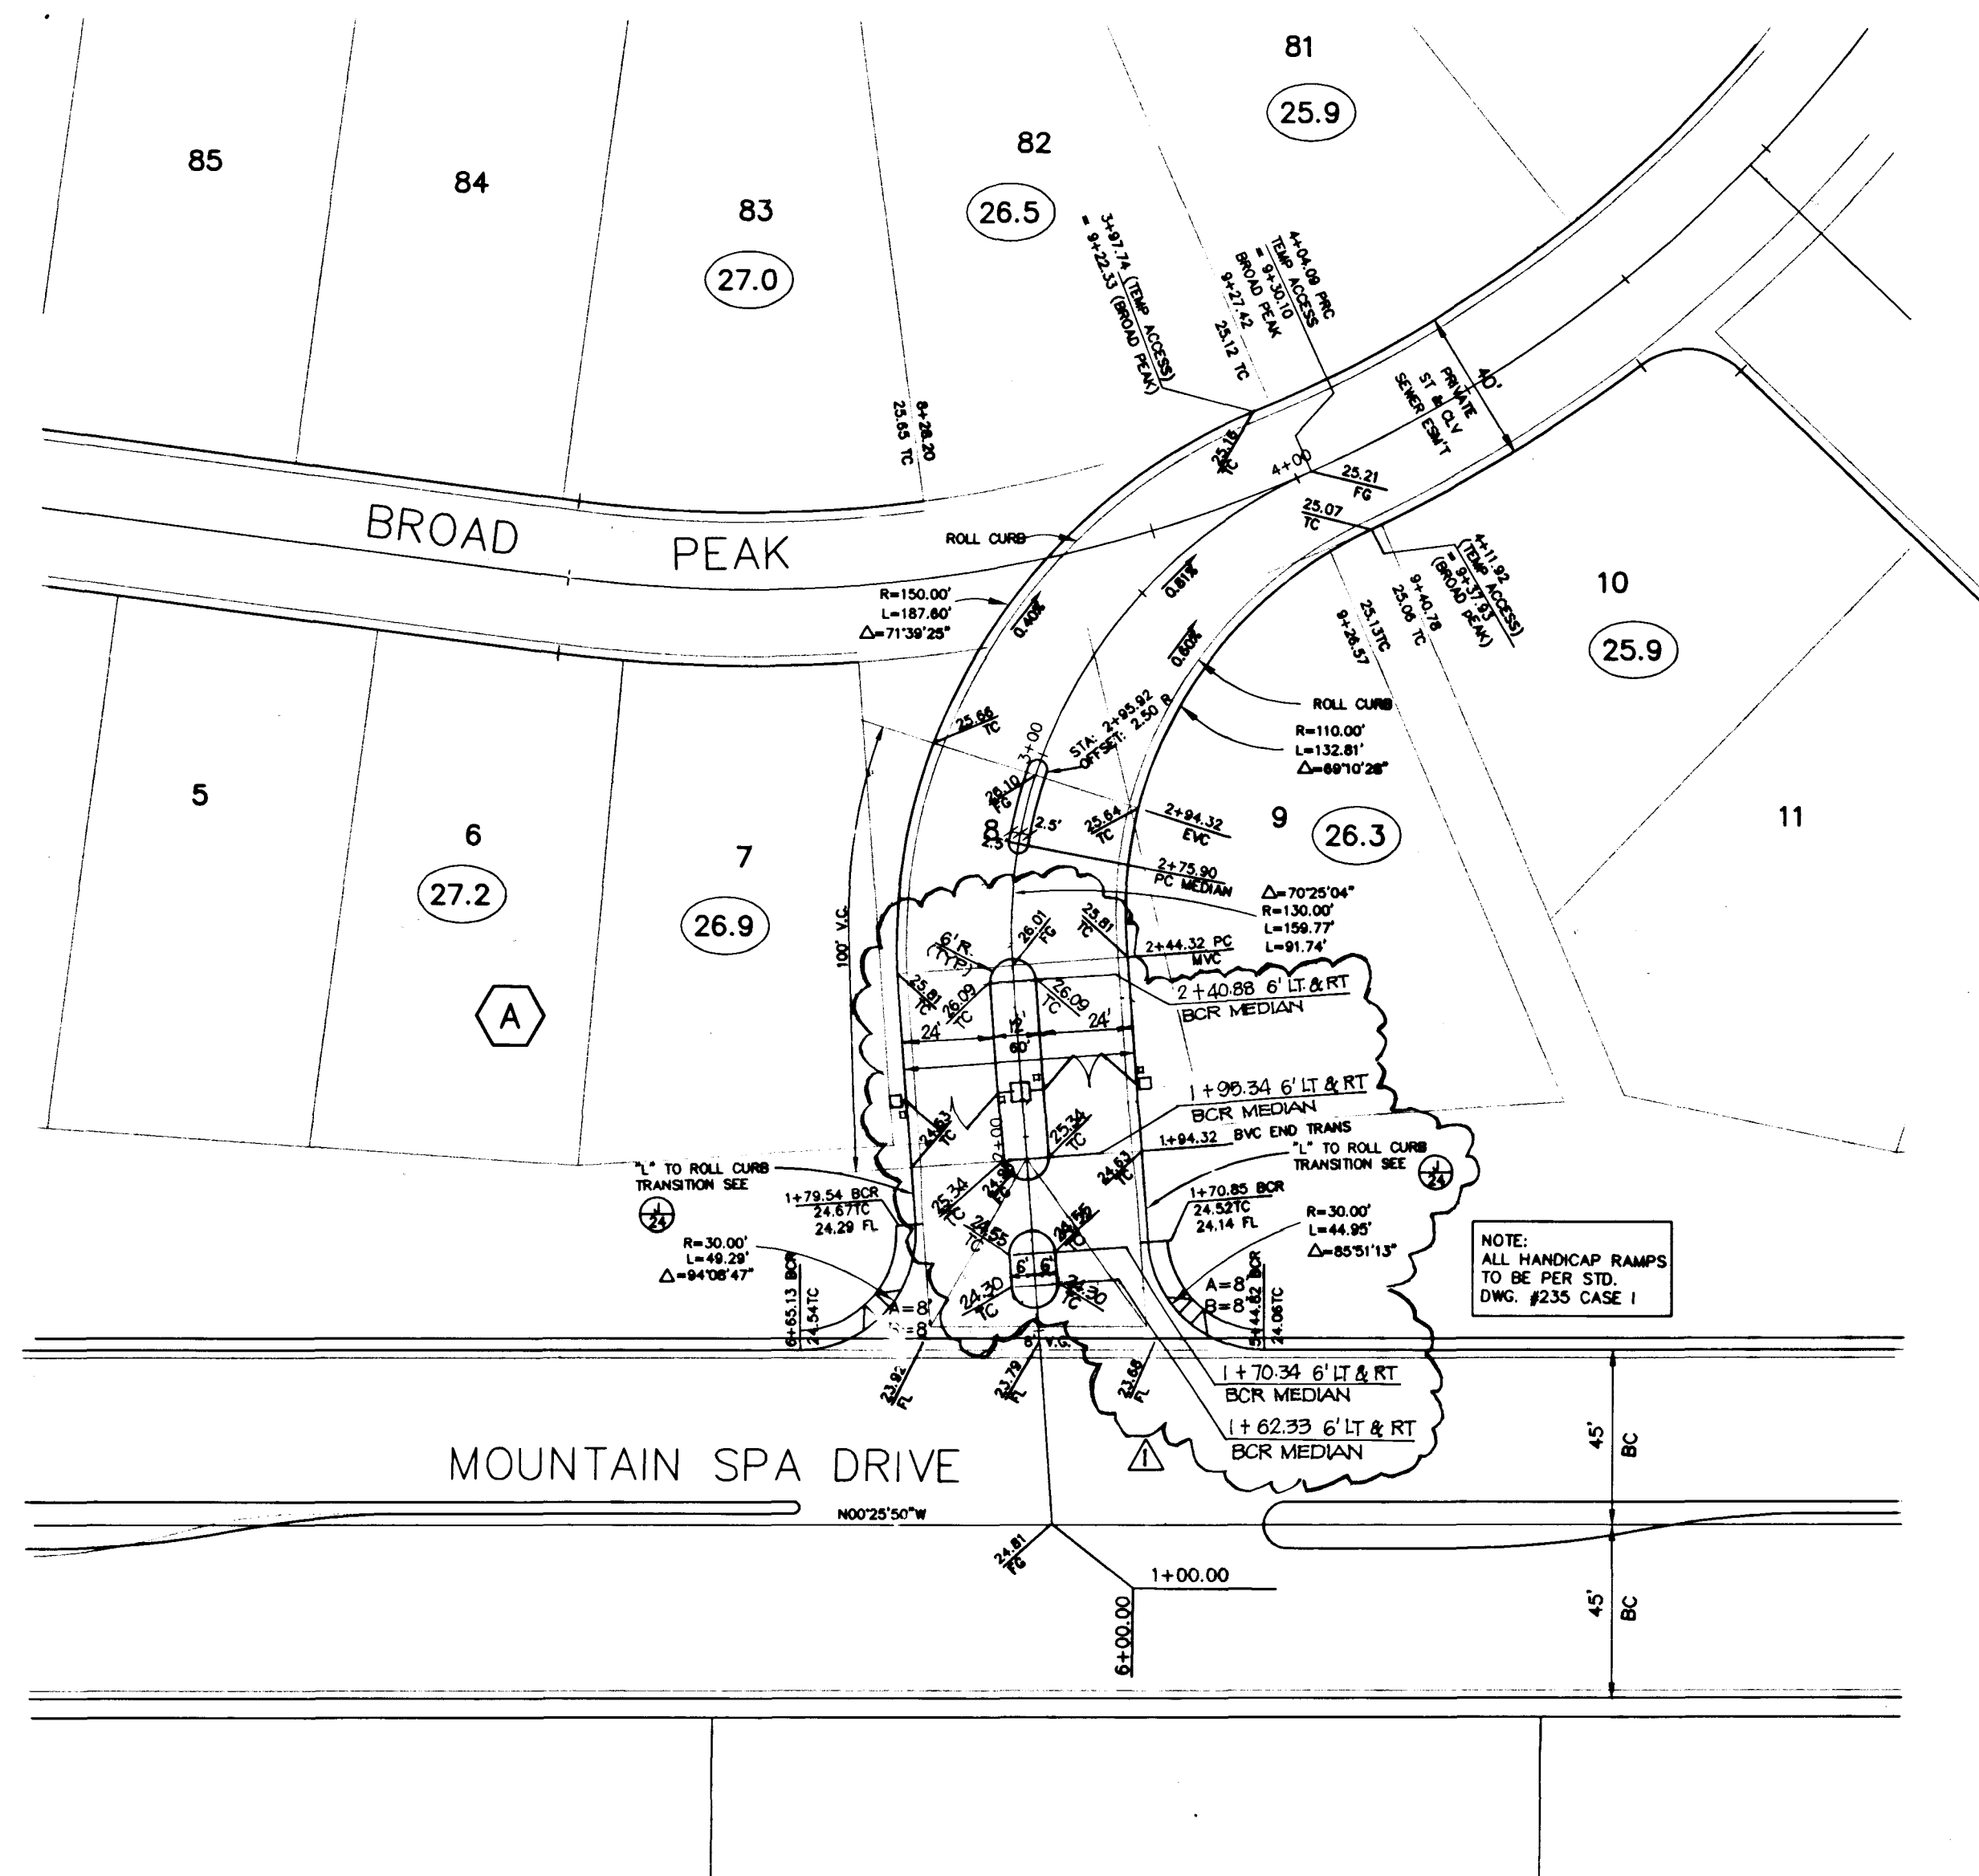

TEMPORAY ACCESS ROAD

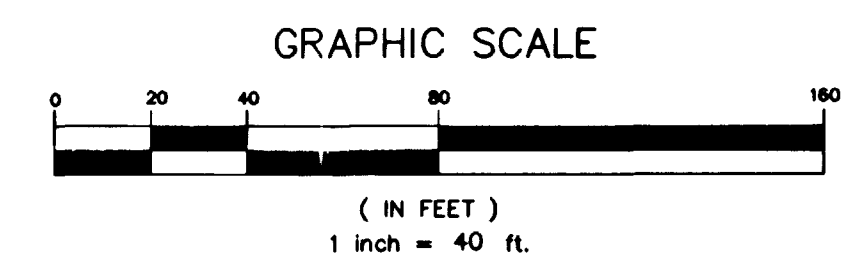

BENCHMARK

BLM BRASS CAP #41, RAINBOW BLVD. & HORSE DRIVE
BM #1L90/11W4, ELEV. = 2396.994' (NGVD29) *
ELEV. = 731.3392 METERS/2399.402' (NAVD88)
* NGVD29 DATUM USED. ADD 2.41 FEET TO ALL
ELEVATIONS TO CONVERT TO NAVD 88 DATUM.

NO.	DESCRIPTION	DATE	APP'D
7/1/99	REVISED MEDIAN CURB AT ENTRY		


MOUNTAIN SPA RESIDENTIAL DEVELOPMENT, LLC.
2810 WEST CHARLESTON BLVD. SUITE F-36
LAS VEGAS, NV 89102
(702) 870-1234

PENTACORE
CIVIL ENGINEERING, LAND SURVEYING, PLANNING
CONSULTING
7633 WEST CHARLESTON BOULEVARD
LAS VEGAS, NEVADA 89102 (702)256-0115

TEMPORARY ACCESS ROAD

MOUNTAIN SPA
UNIT NO. 1

DATE:	JAN. 99
PM:	LENNARD
DRAWN BY:	
DESIGNED BY:	
ADA CHECKED:	
JOB NO.:	0158.0200
SCALE:	1" = 40'

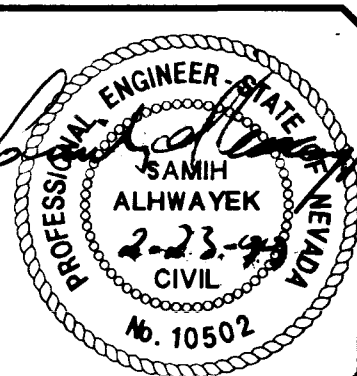

SHEET	26	OF	29
C.L.V. DWG.#			

