
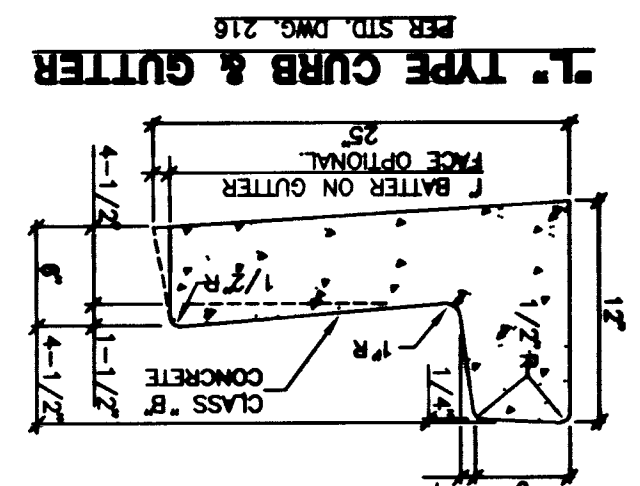
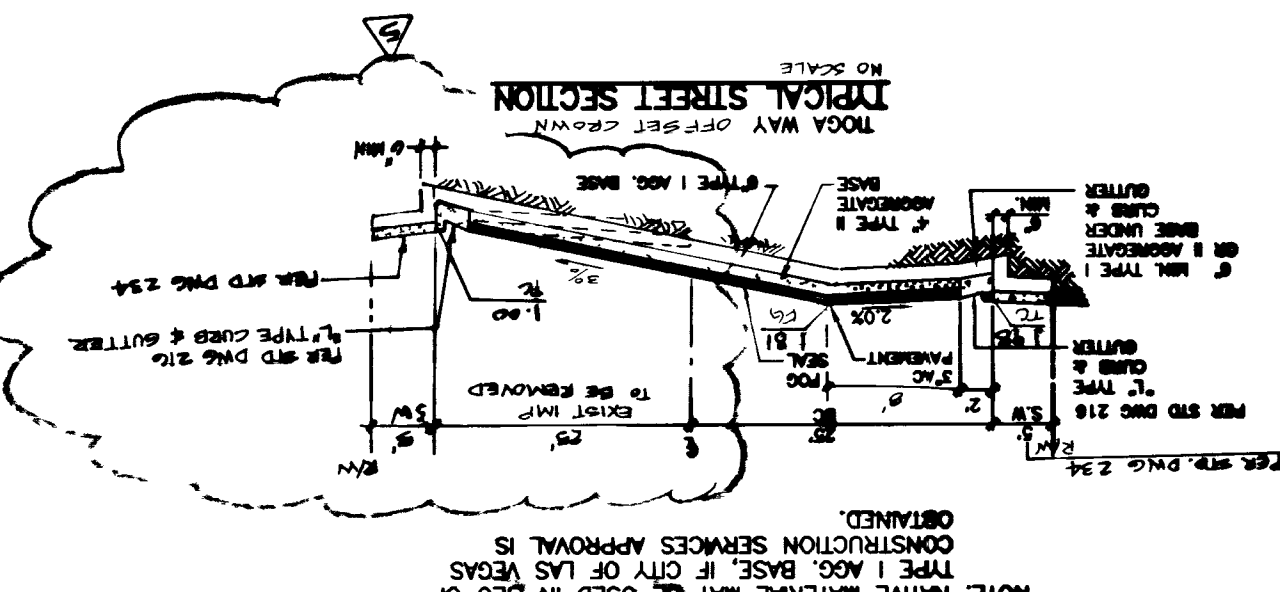
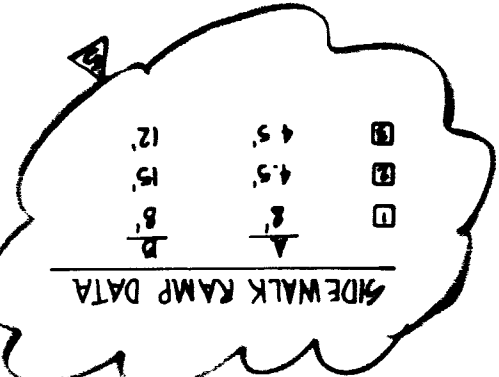



BENCHMARK
CLARK COUNTY BENCHMARK 2010-35MS
ELEVATION = 702.571 METERS (NAVD 88)
OF SHAWNA AND BUTTELO NEAR PO OF SHAWNA
MET AND PLATE IN TOP OF CURB AT NORTH EAST CORNER
SECTION 2, TOWNSHIP 20 SOUTH, RANGE 60 EAST, AS SHOWN ON
RECORD OF SURVEY ON FILE IN THE CLARK COUNTY, NEVADA RECORDERS
OFFICE IN THE FILE 75 OF SURVEYS, AT PAGE 78.
NORTH 88°35'42" EAST, BEING THE BEARING OF THE SOUTH LINE OF THE
NORTHWEST QUARTER (NW 1/4) OF THE SOUTHWEST QUARTER (SW 1/4) OF
SECTION 2, TOWNSHIP 20 SOUTH, RANGE 60 EAST, AS SHOWN ON

Call before you Dig
2 working days
1-800-277-2600

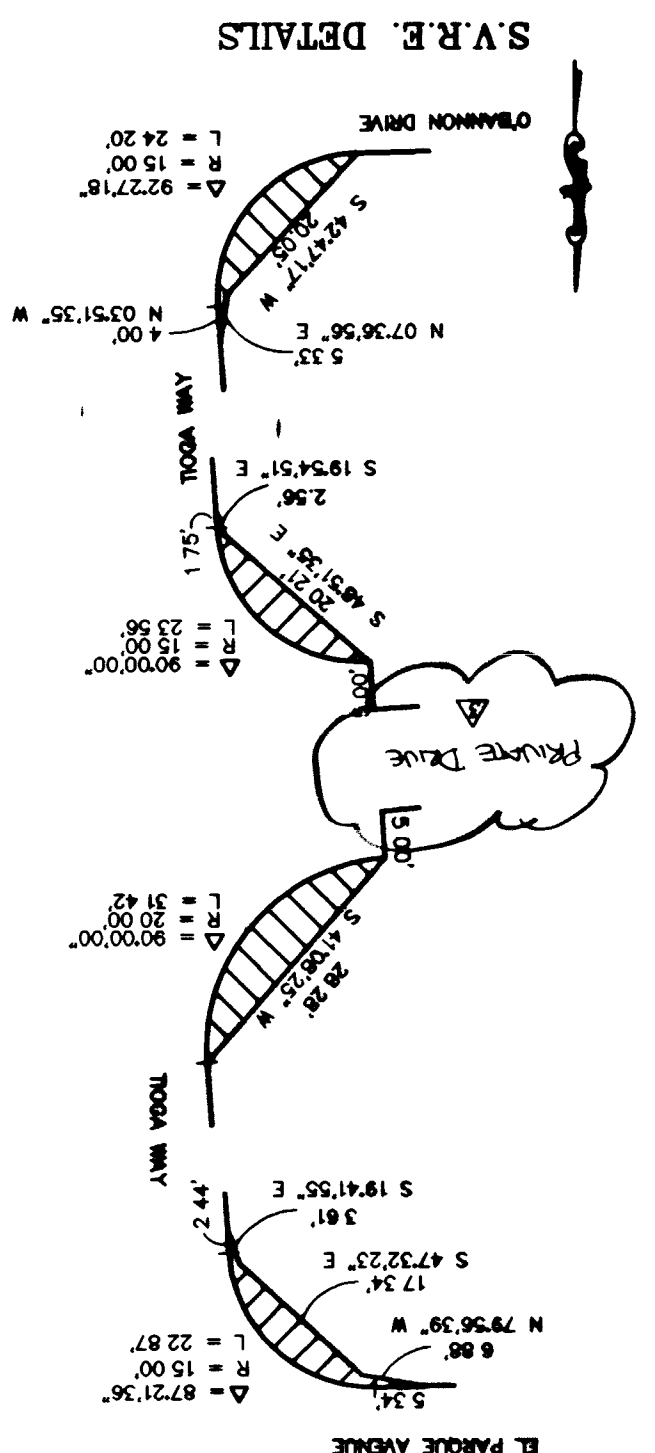

HC RAMP DATA


CASE 1
A
B

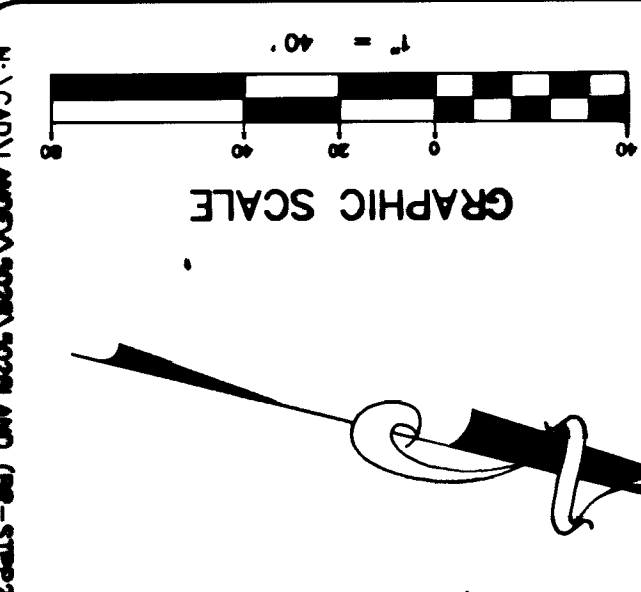



107Y-4434-3

4 of 7 SHEETS

DATE	4/26/96
BY	CJP
NO. NO.	5028

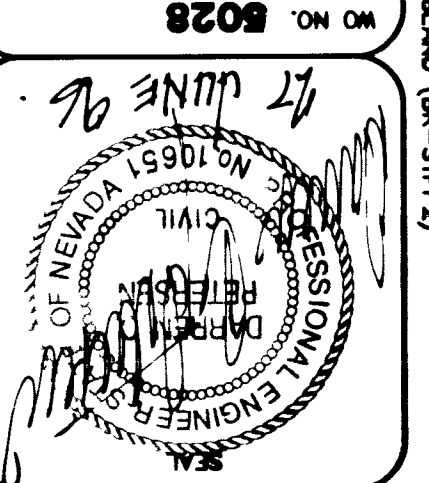

STREET - PLAN AND PROFILE
MOUNTAIN SHADOWS III

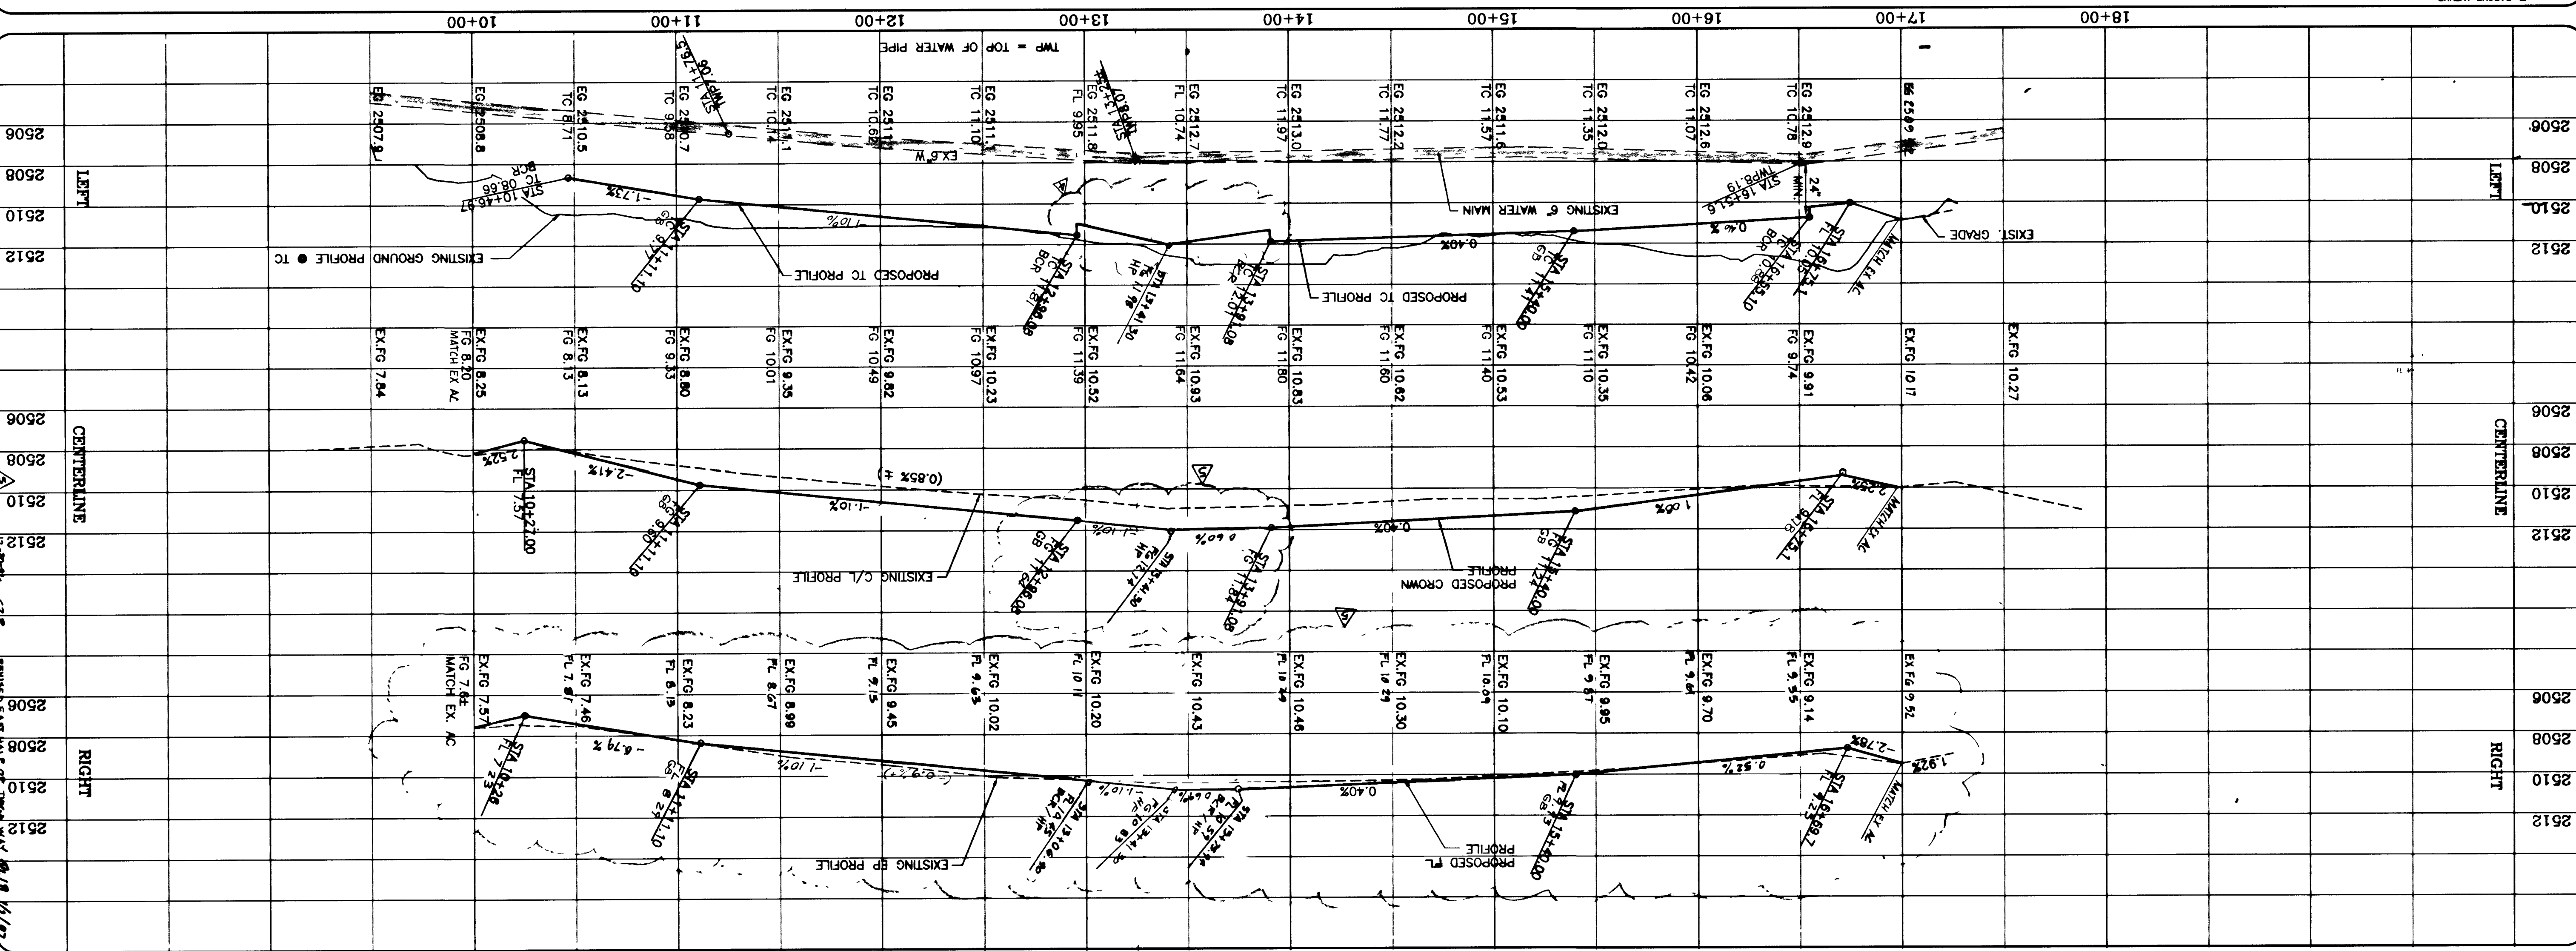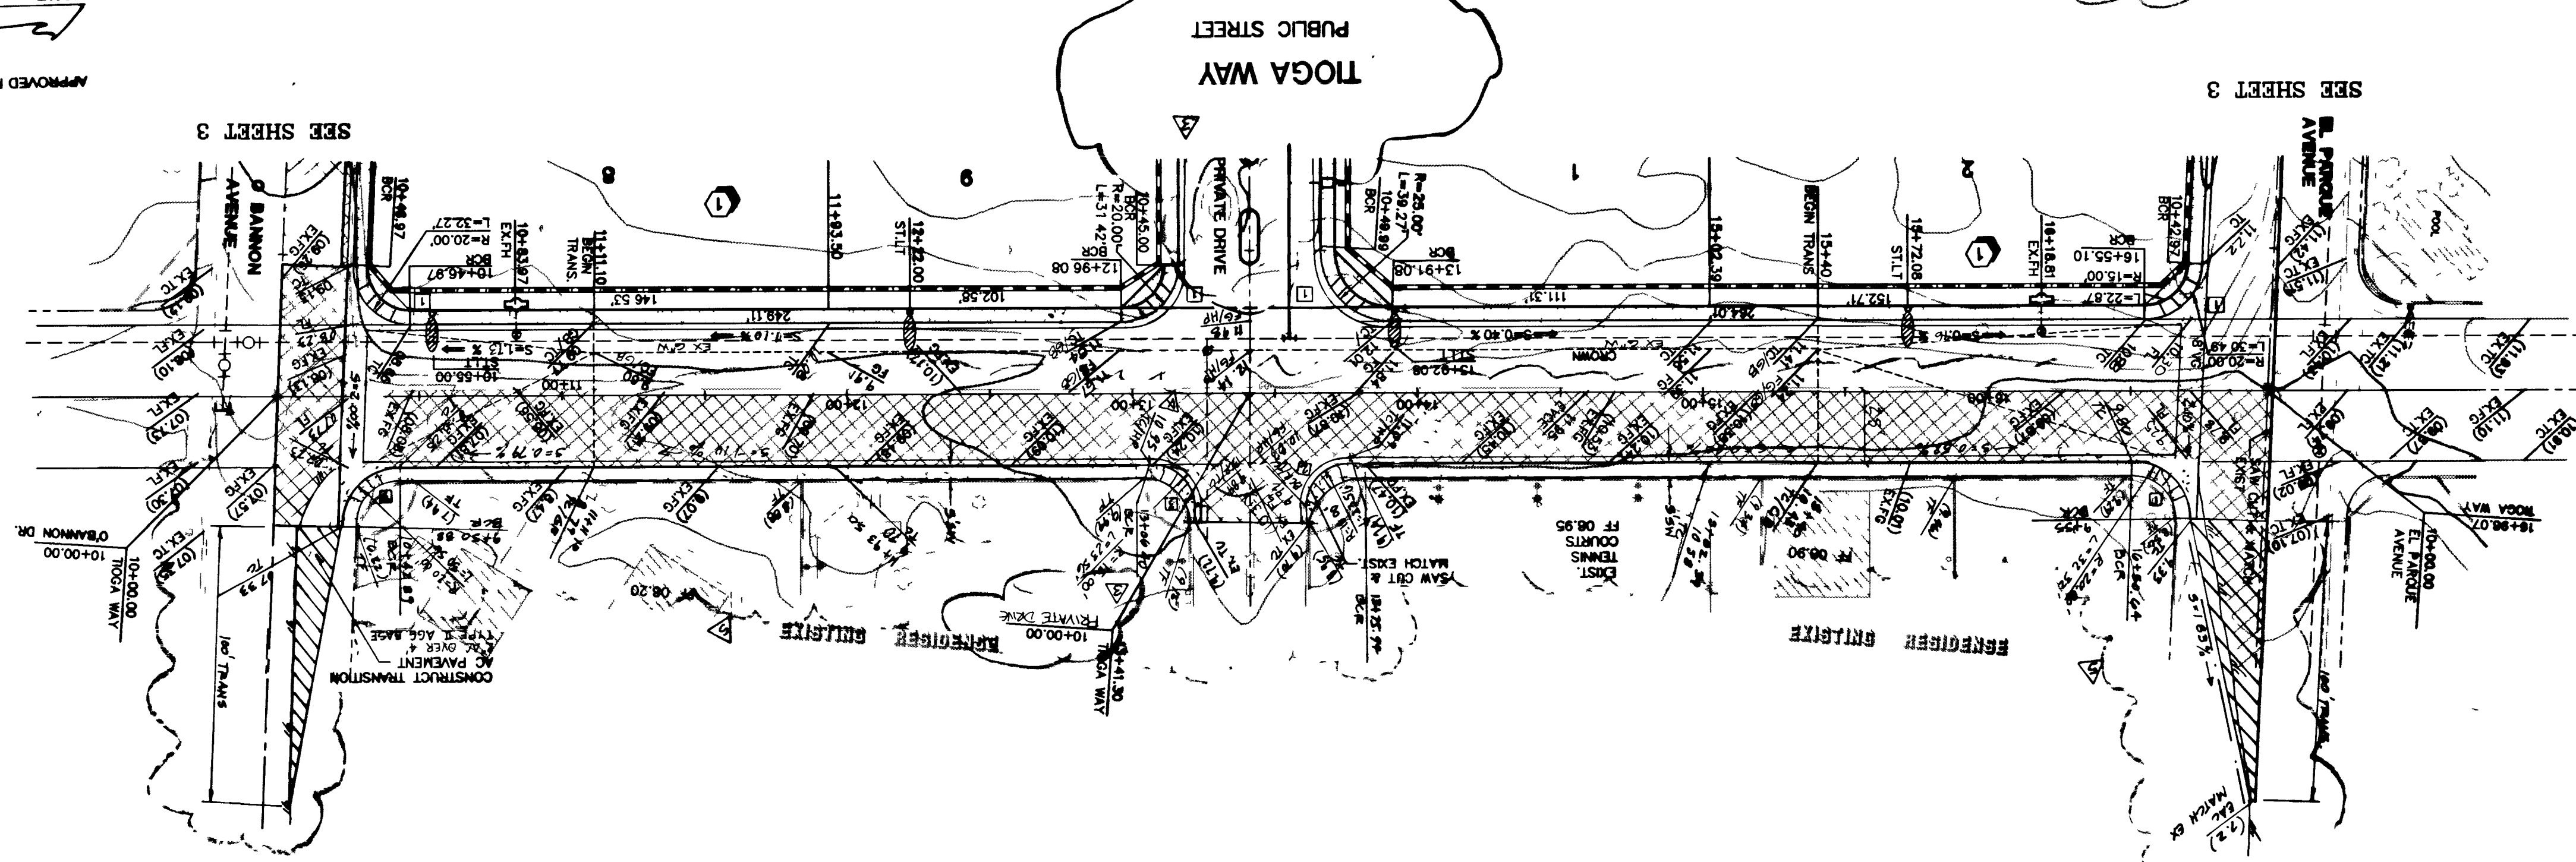

JAMES JANY
CITY OF LAS VEGAS

CONSULTING ENGINEERS • PLANNERS • LAND SURVEYORS
2727 SOUTH RAINBOW BOULEVARD
LAS VEGAS, NEVADA 89102-5148 PHONE (702) 873-7550 FAX (702) 362-2597

107Y-4436-3


25-9-11



STREET - PLAN AND PROFILE
MOUNTAIN SHADOWS II



STREET - PLAN AND PROFILE
MOUNTAIN SHADOWS II

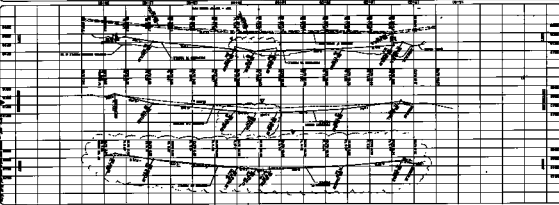

STREET - PLAN AND PROFILE
MOUNTAIN SHADOWS II