



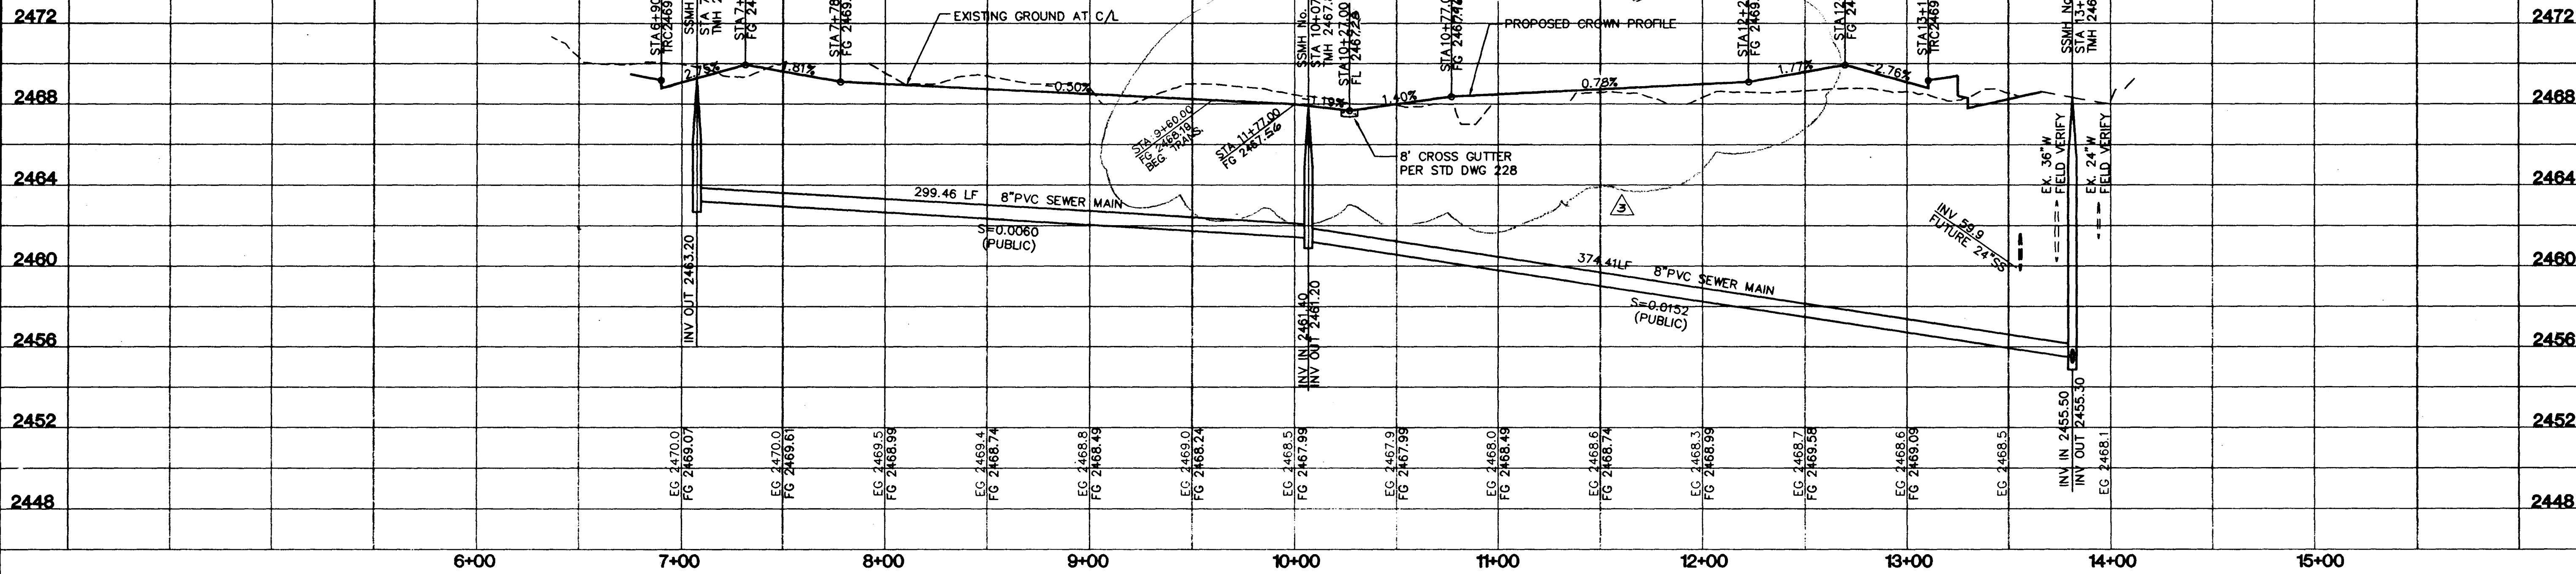

TOPAZ HOMES				CITY OF LAS VEGAS, NEVADA			
CONSULTING ENGINEERS • PLANNERS • LAND SURVEYORS				2727 SOUTH RAINBOW BOULEVARD LAS VEGAS, NEVADA 89102-5148 PHONE (702) 873-7550 FAX (702) 362-2997			
REVISION				DATE			
BY				REV			
REV PER CLV COMMENTS				REV PER CLV COMMENTS			
CZP				CZP			
8-24-98				8-29-98			
TA.H.				TA.H.			
REV'D GRADES				REV'D GRADES			
9/15/98				9/15/98			

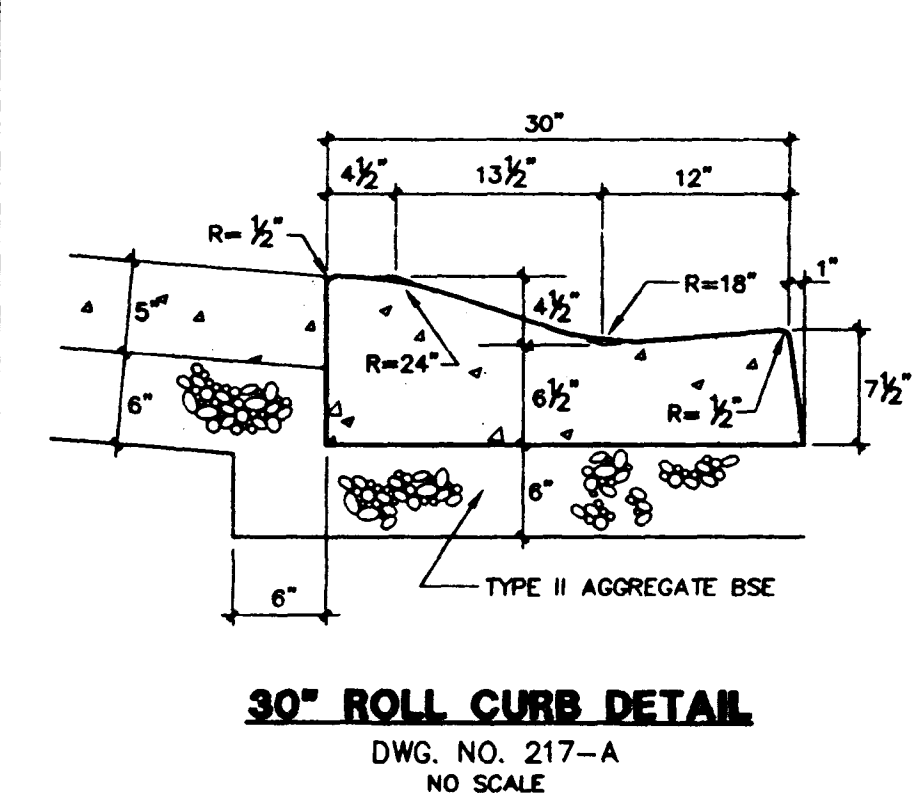

2 working
days

Call
before you
Dig



1-800-227-2800


BASIS OF BEARINGS:

NORTH 03°21'07" WEST, BEING THE BEARING OF THE CENTERLINE OF TENAYA WAY AND THE WEST LINE OF THE SOUTHEAST QUARTER (SE 1/4) OF THE NORTHWEST QUARTER (NW 1/4) OF SECTION 3, TOWNSHIP 21 SOUTH, RANGE 60 EAST, M.D.M., CLARK COUNTY, NEVADA, AS SHOWN ON THAT CERTAIN PLAT ON FILE IN THE COUNTY RECORDER'S OFFICE, CLARK COUNTY, NEVADA, IN BOOK 42 OF PLATS, AT PAGE 69.


BENCHMARK:

CLV BM 7C10-10M4
NAVD 88 ELEV: 747.919 METERS (2453.90 FEET)
RIVET AND SQUARE ALUMINUM PLATE IN THE NORTHEAST CORNER OF FIRE HYDRANT BASE,
400 FEET SOUTH OF SAHARA AVENUE ON THE WEST SIDE OF TENAYA WAY.

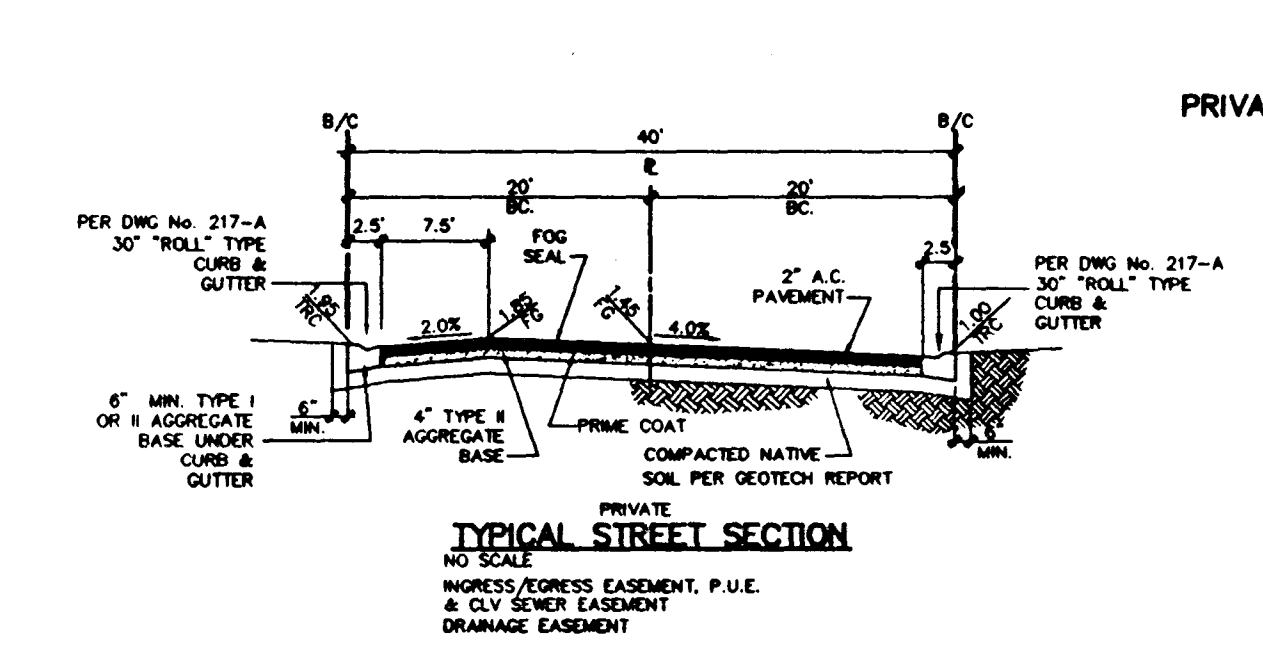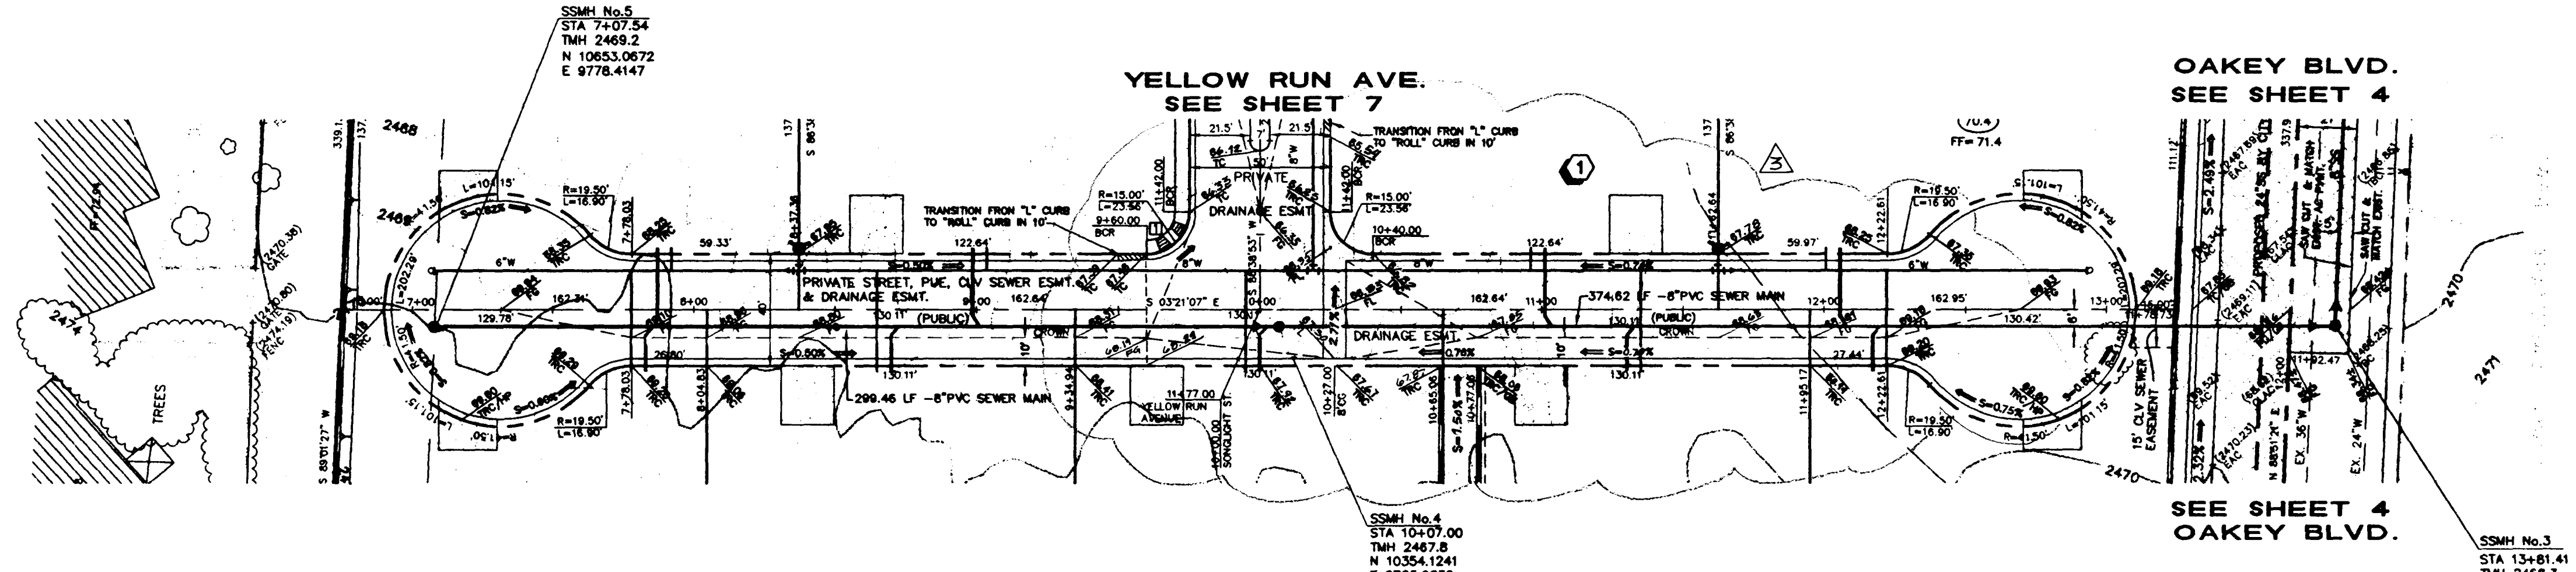

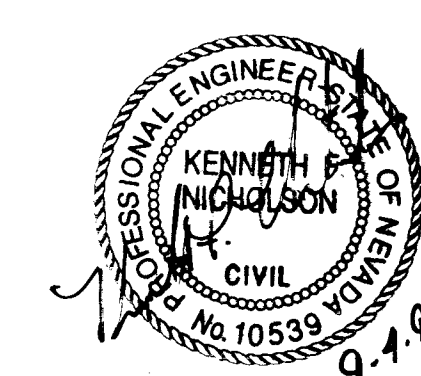

9-4-98
Revision 7 only

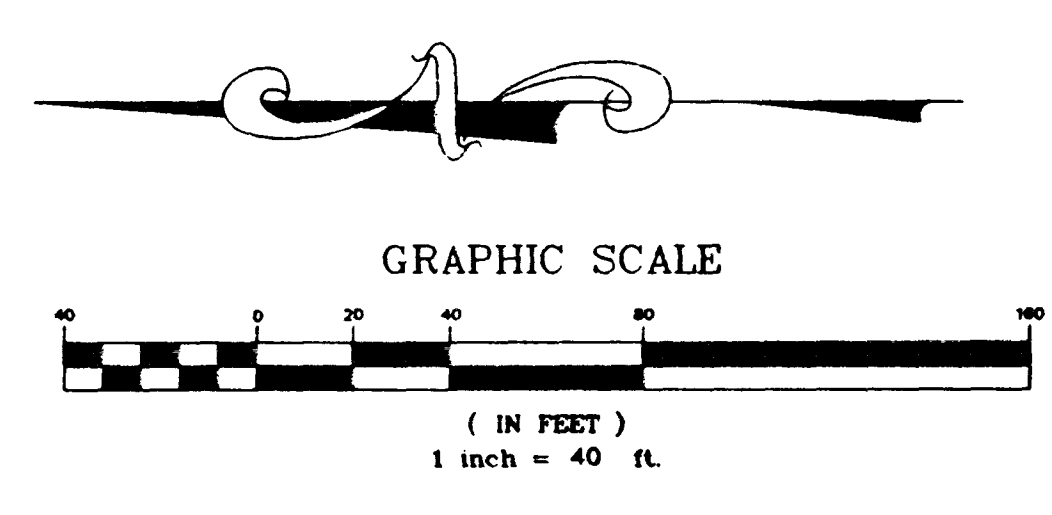

GRAPHIC SCALE
(IN FEET)
1 inch = 40 ft.

STREET/SEWER PLAN & PROFILE

SONGLIGHT STREET

MOUNTAIN SHADOWS IV

PROJECT

SEAL

16 OCT. '98


NO. 5063

BY CZP


DATE JULY 1996

SCALE HORIZ. 1"=40'
VERT. 1"=4'

SHEET 6 OF 7 SHEETS

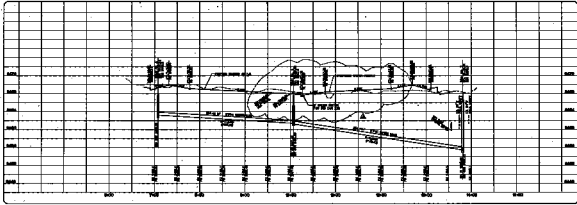


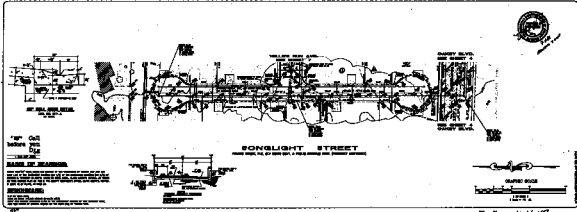

STREET/SEWER PLAN & PROFILES
 SONGLIGHT STREET
 MOUNTAIN SHADOWS IV
