

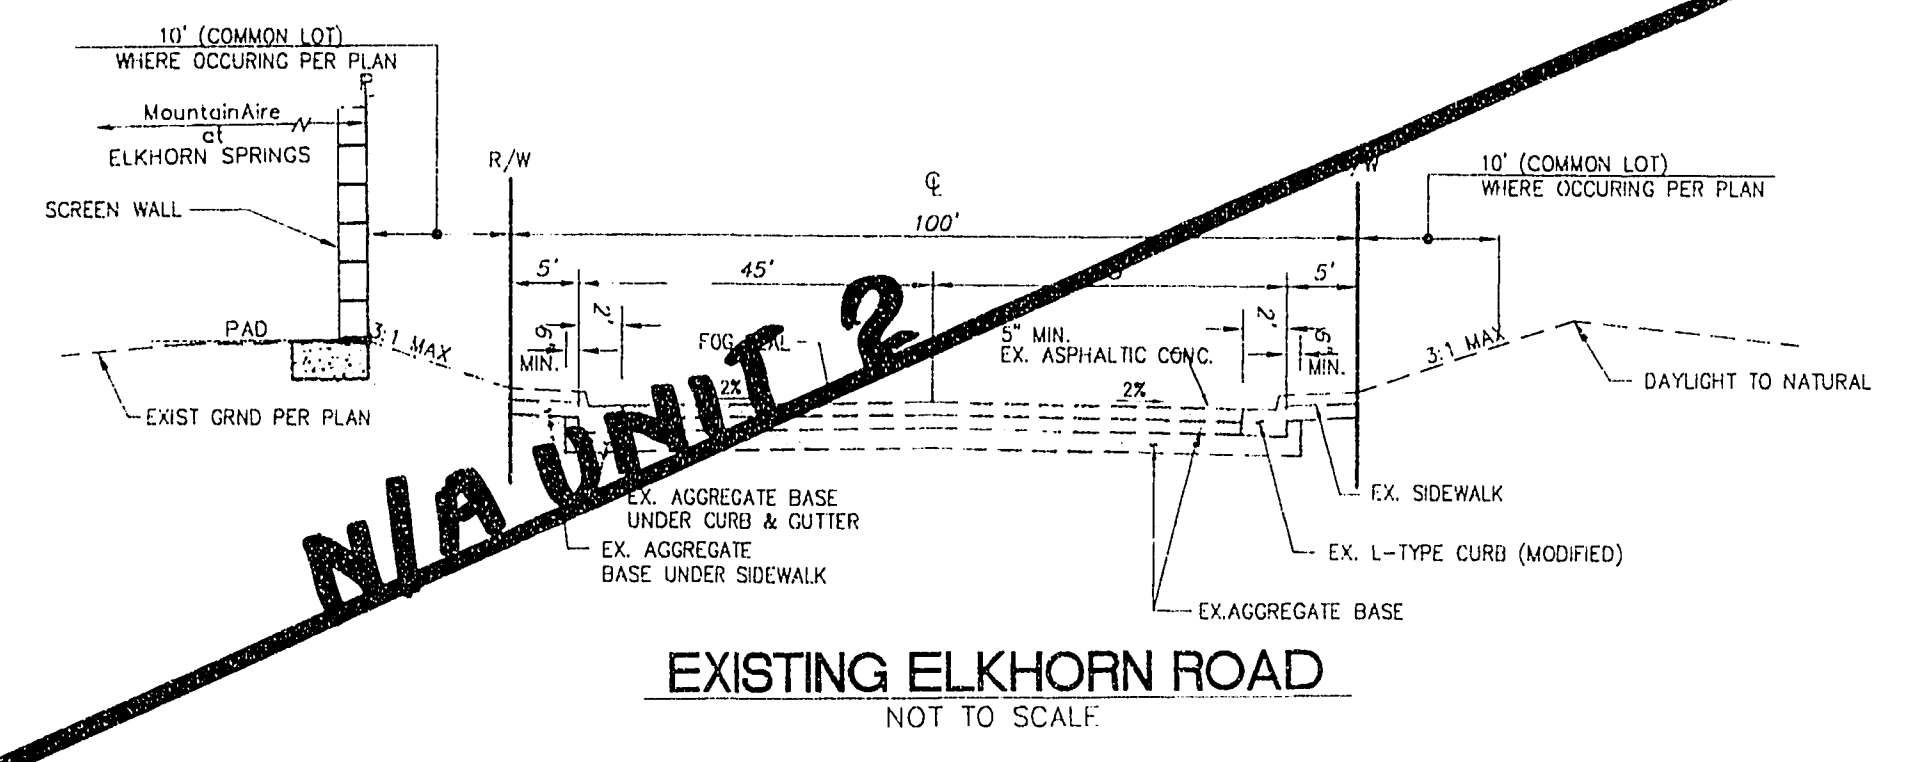
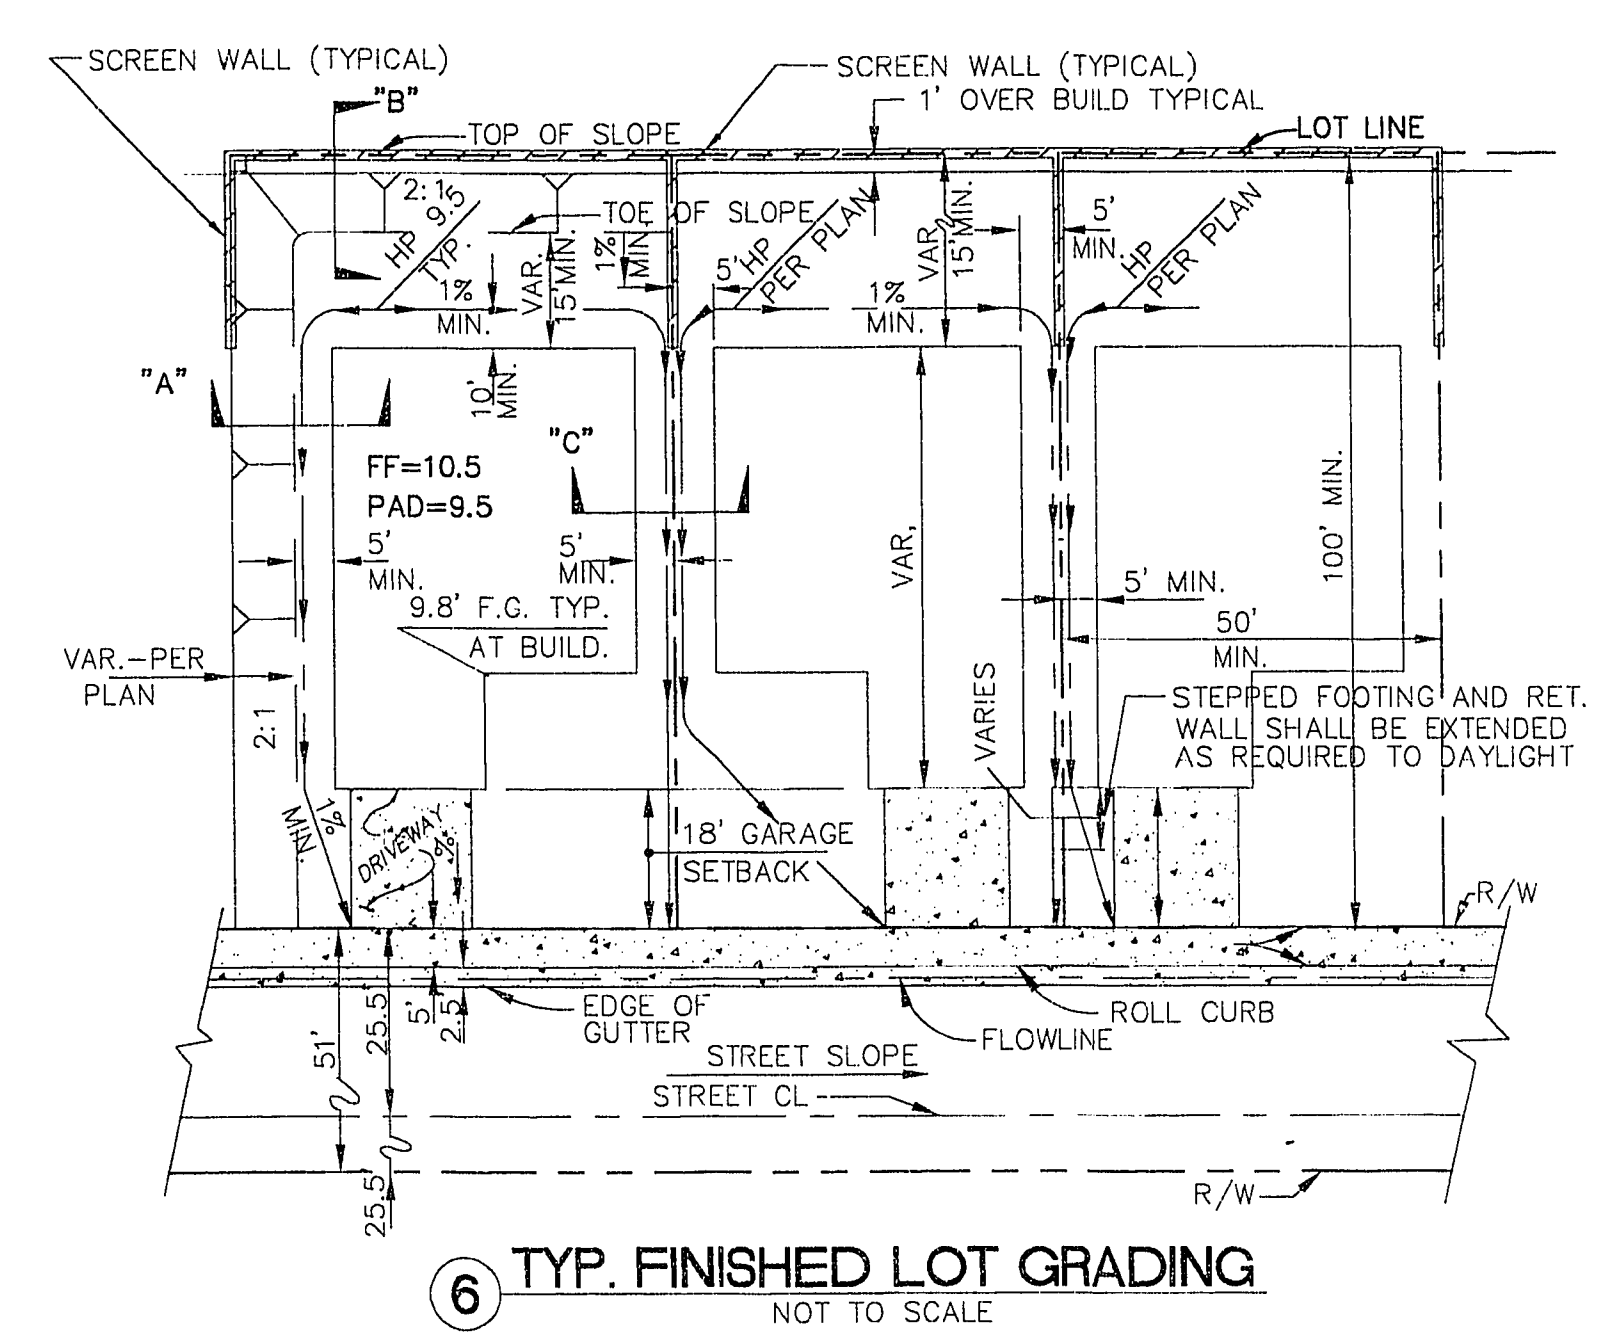








2. 150655/655021.dwg, July 2, 10, 45, 54, 1995 COLOR 555C 566-5042
 HP Des: gdr: 255C C:\ACAD\2\DRW\H66\2\TKN1.DWG !! HP-GL/2 AD1, 4.2 Ver. 1.3 BY HEWLETT-PACKARD

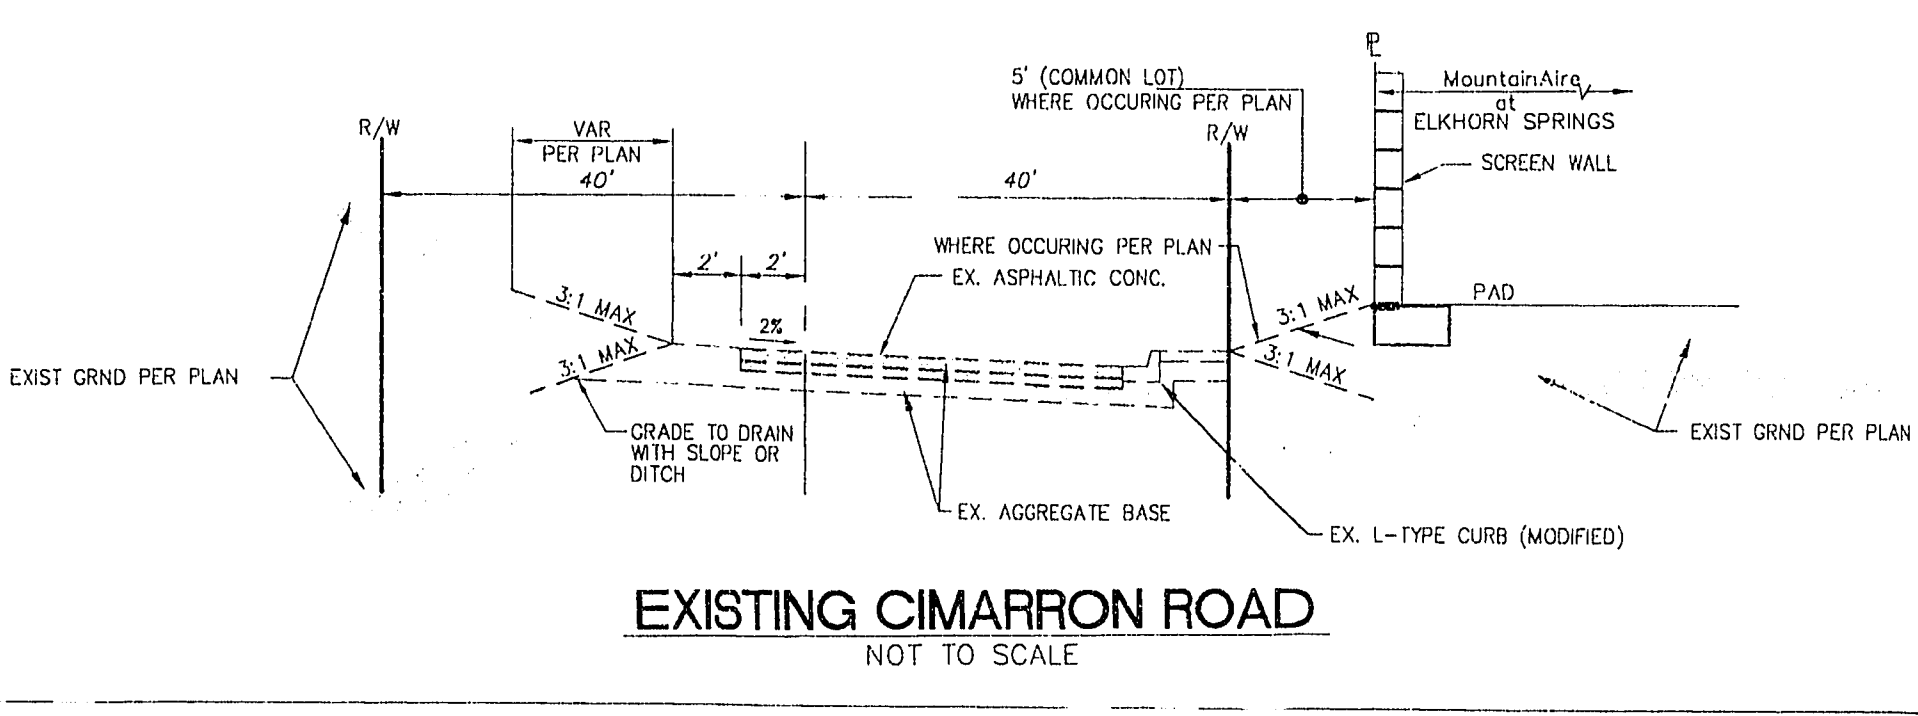

(E) TYPICAL SIDE LOT RETAINING
NOT TO SCALE

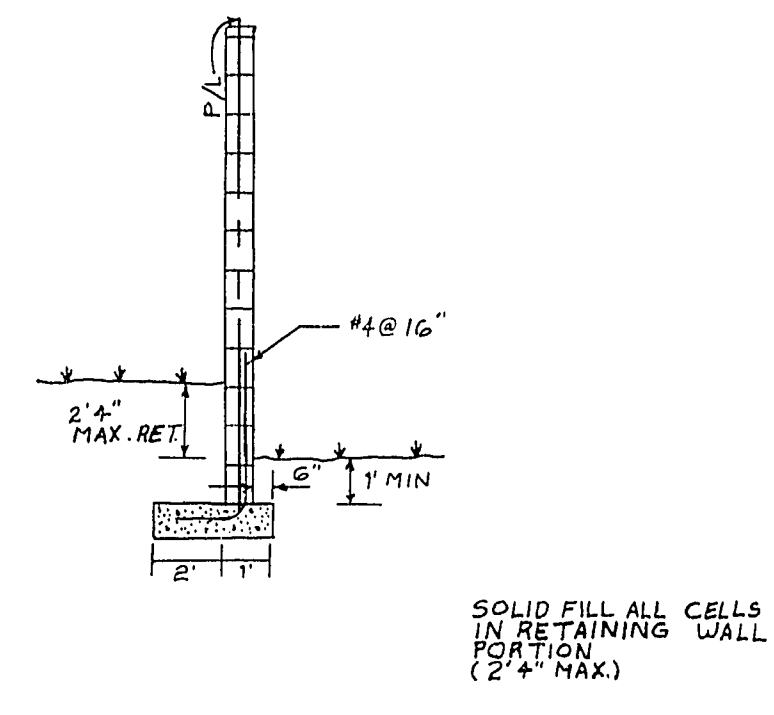

(D) OFF-SITE GRADING DETAIL
NOT TO SCALE

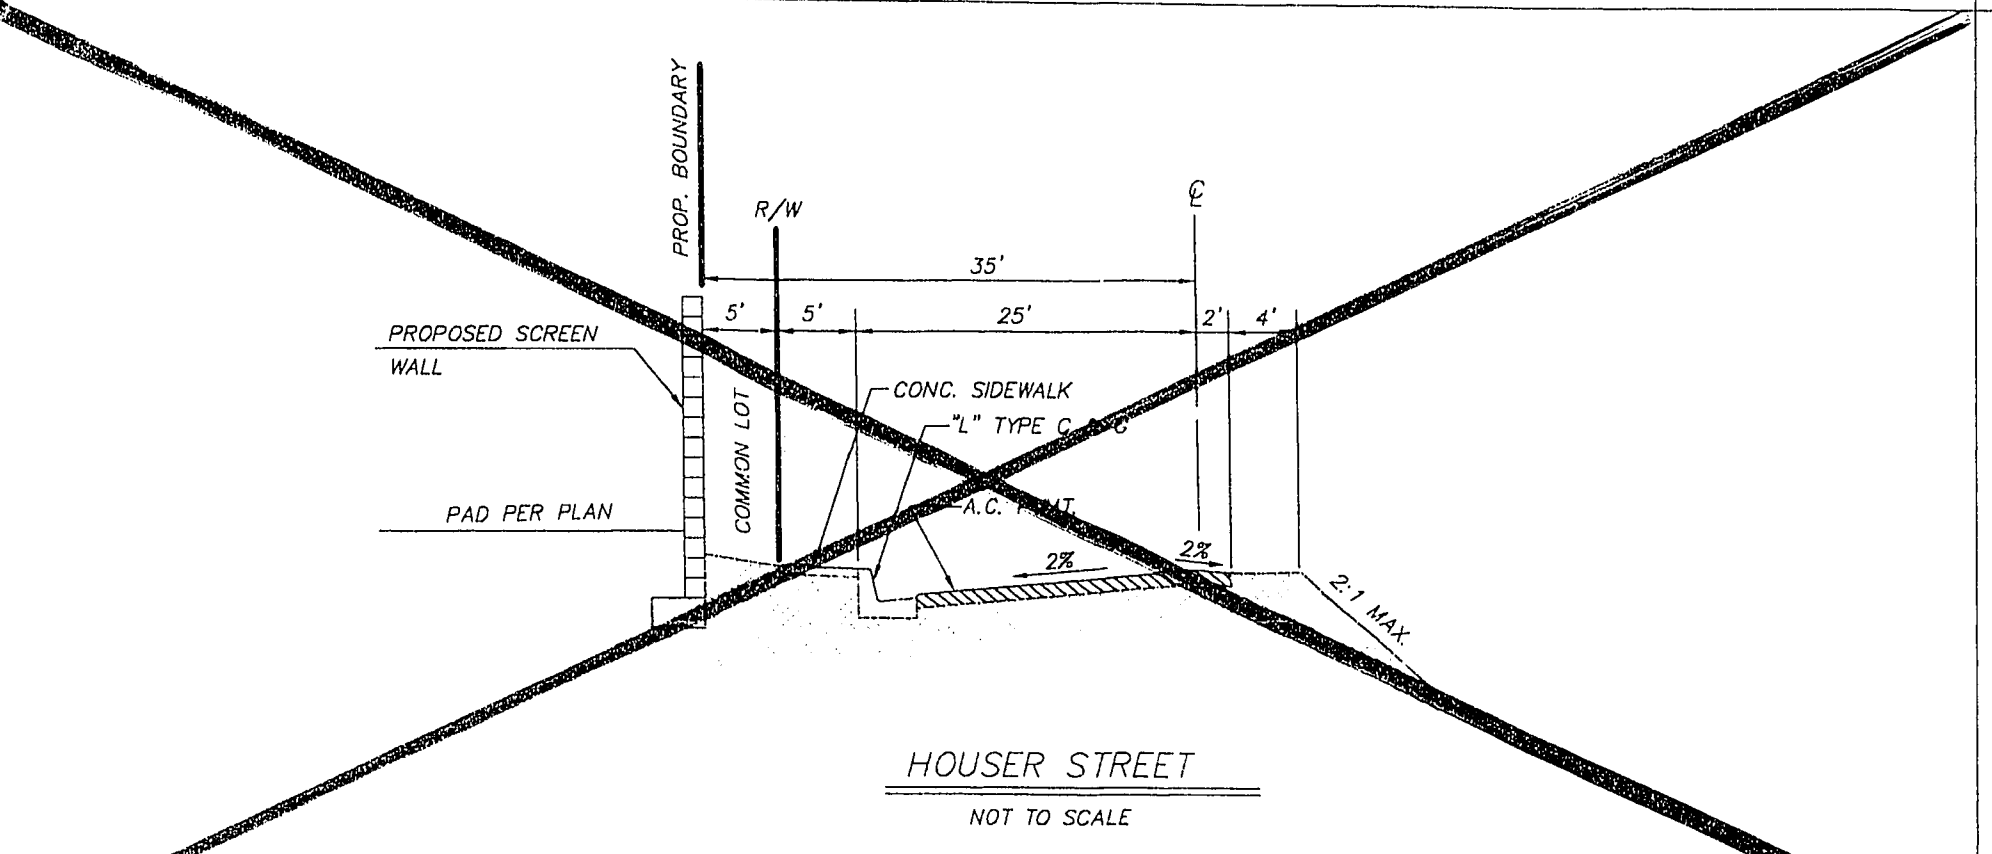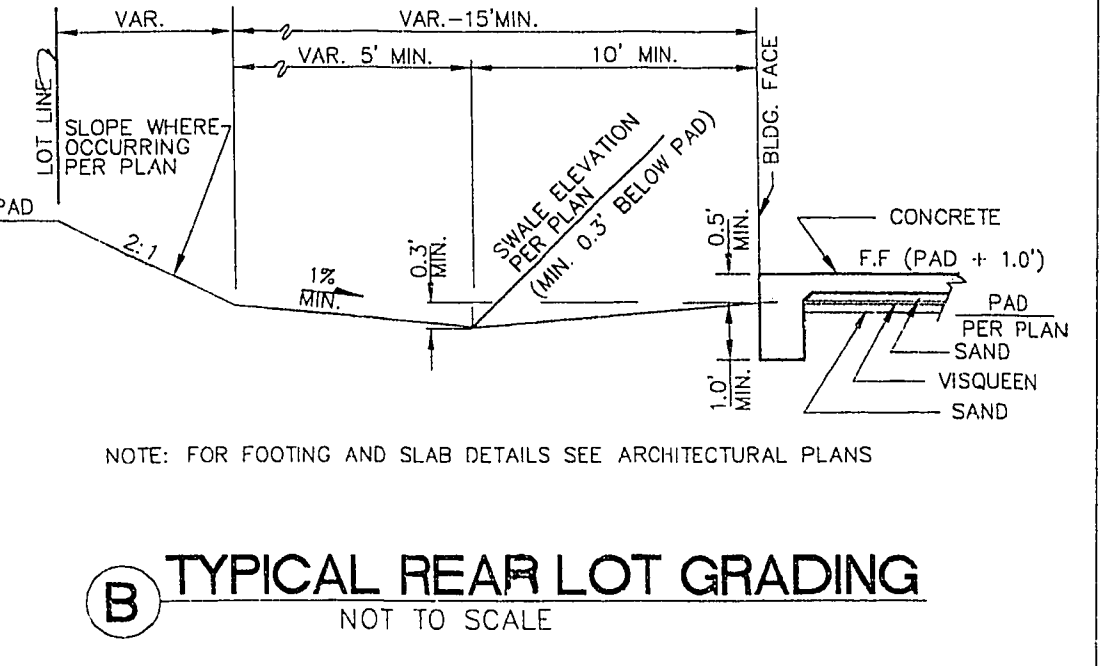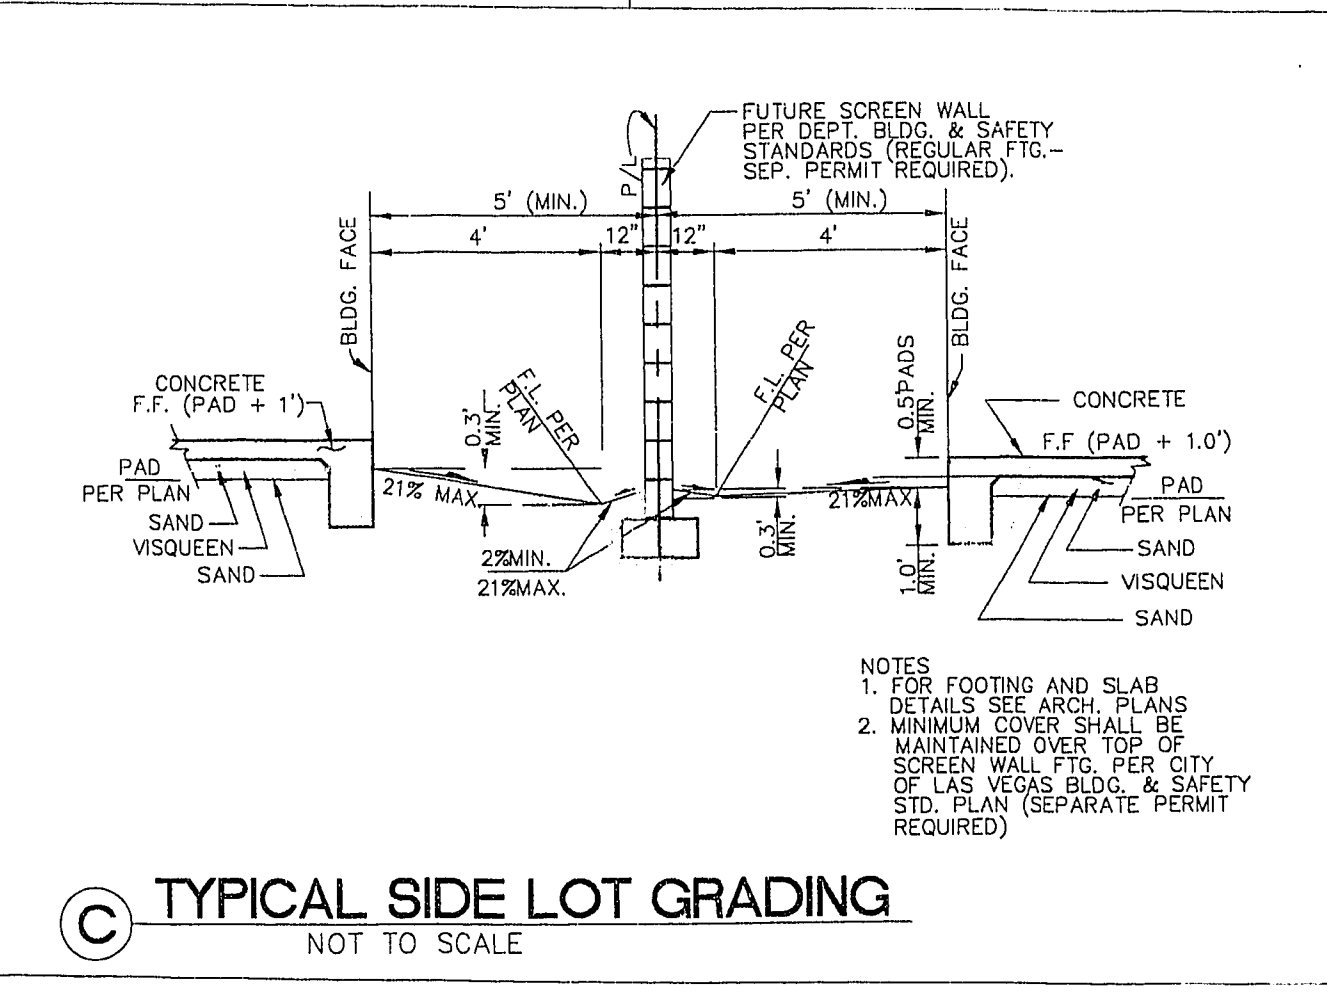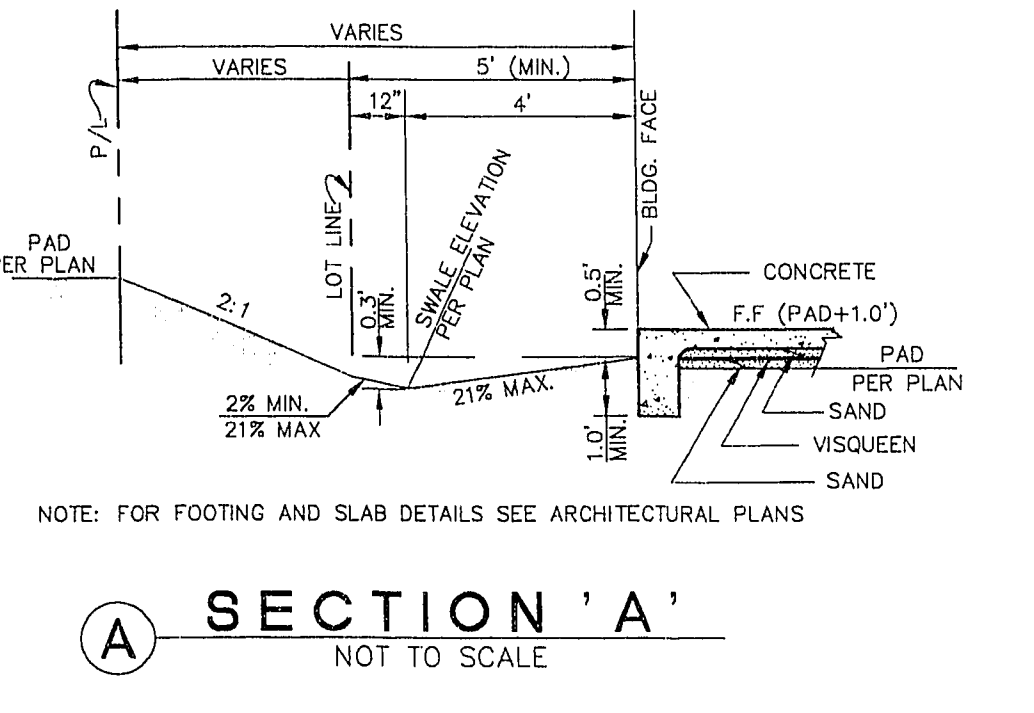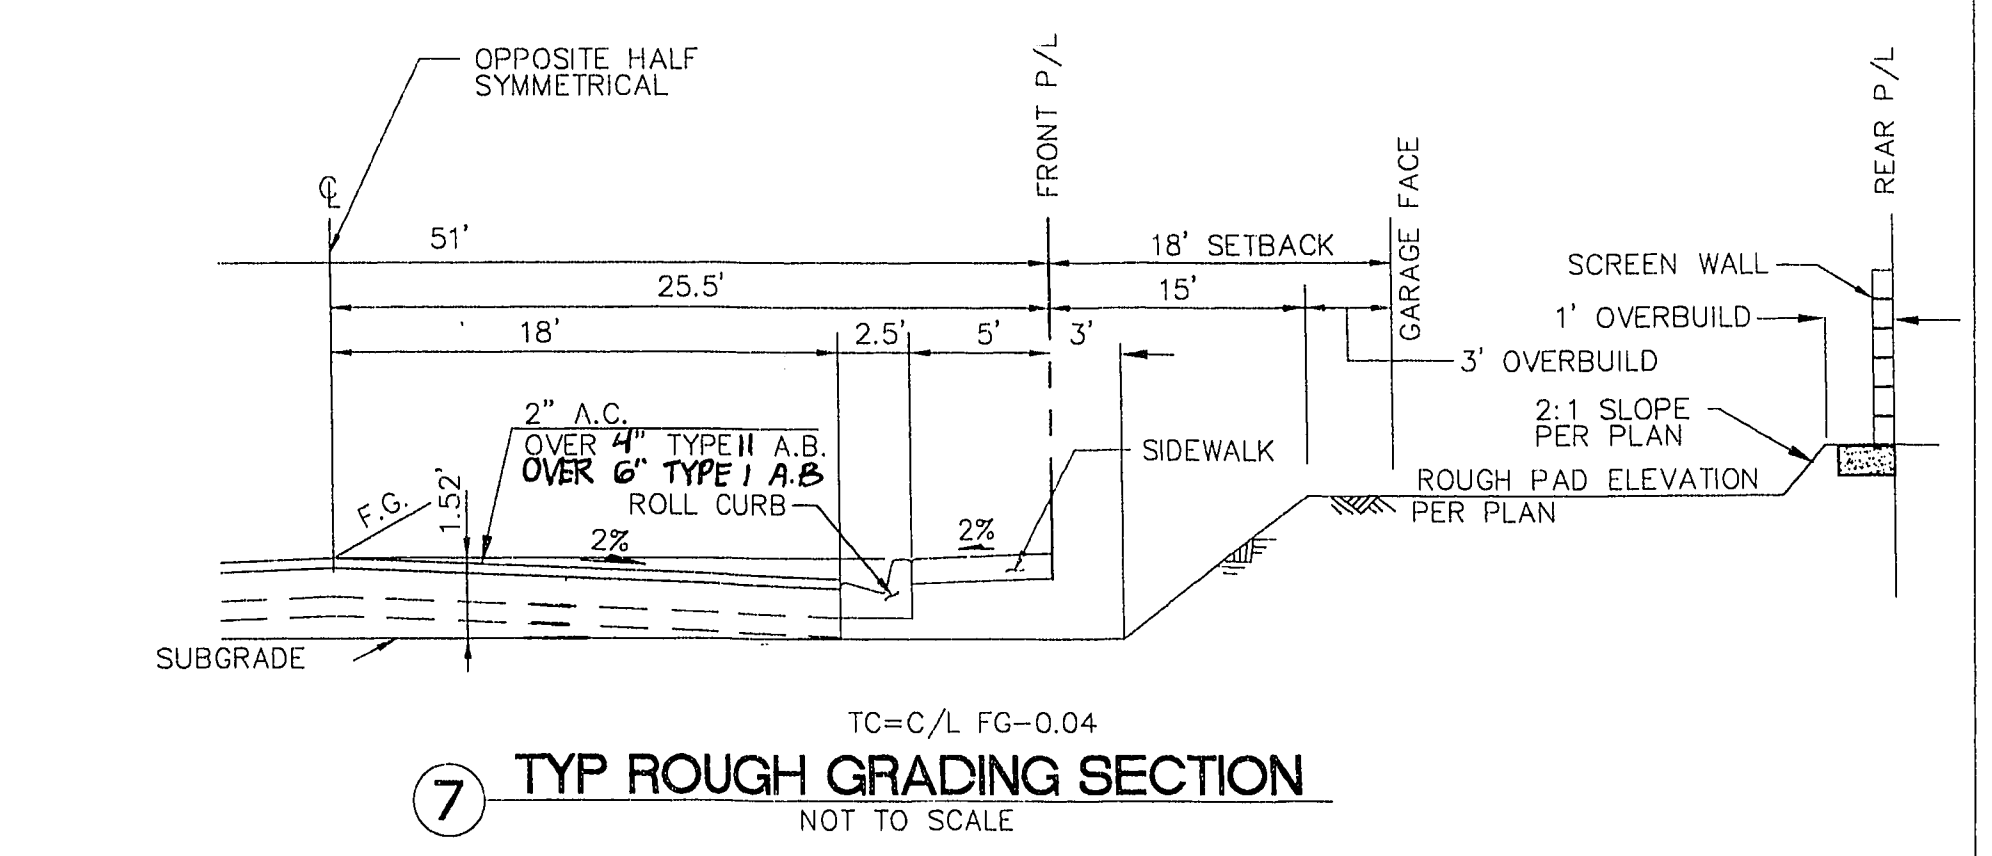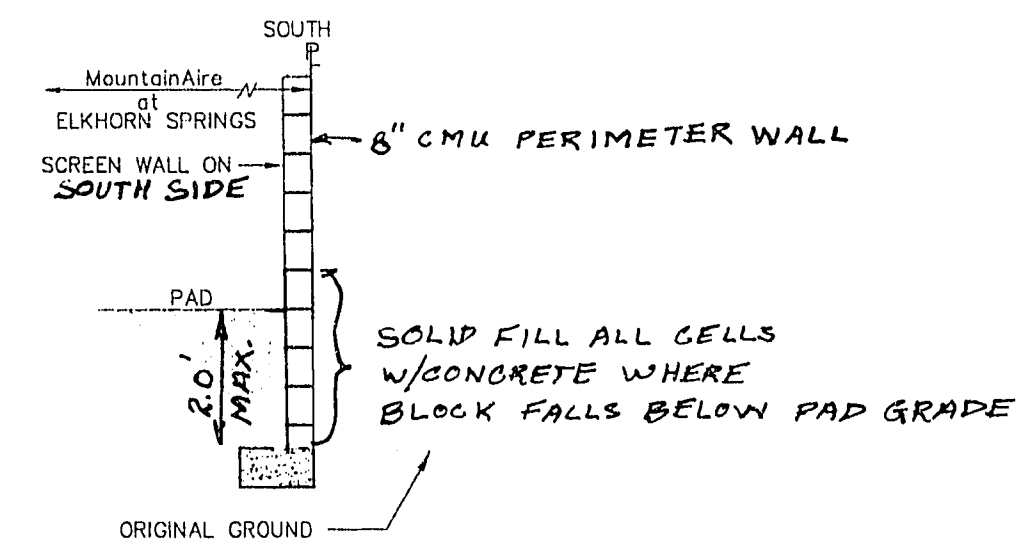

"I CERTIFY THAT THIS GRADING PLAN IS IN CONFORMANCE WITH THE APPROVED DRAINAGE STUDY ON FILE AT THE CITY OF LAS VEGAS FOR THIS PROJECT."
James H. Knapack 12/2/95
 DATE 7/13/96

ENGINEER
THE KEITH COMPANIES, NEVADA
 444 EAST WARM SPRINGS DRIVE, SUITE 110, LAS VEGAS, NV 89119 (702)263-8286 FAX (702)263-8282

PLANNING
 CIVIL ENGINEERING
 ENVIRONMENTAL SERVICES
 LAND SURVEYING
 SURVEYING
 PUBLIC WORKS
 WATER RESOURCES

TC JOB NO.: 50552
 CHECKED BY: MM
 DESIGNED BY: J.K.P.
 DRAWN BY: J.K.P.
 DATE: 8-2-95

REVISIONS
 REV. DATE DESCRIPTION
 1 12/2/95
 2 7/13/96

DUNMORE HOMES INC.
MountainAire AT ELKHORN SPRINGS
 GRADING DETAILS

SHEET NO.: **9**
 9 OF 11 SHEETS

11-28-121 1071-4443-2