
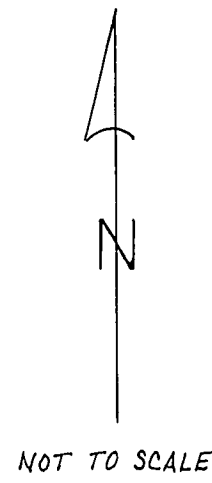


MONUMENTATION PLAN

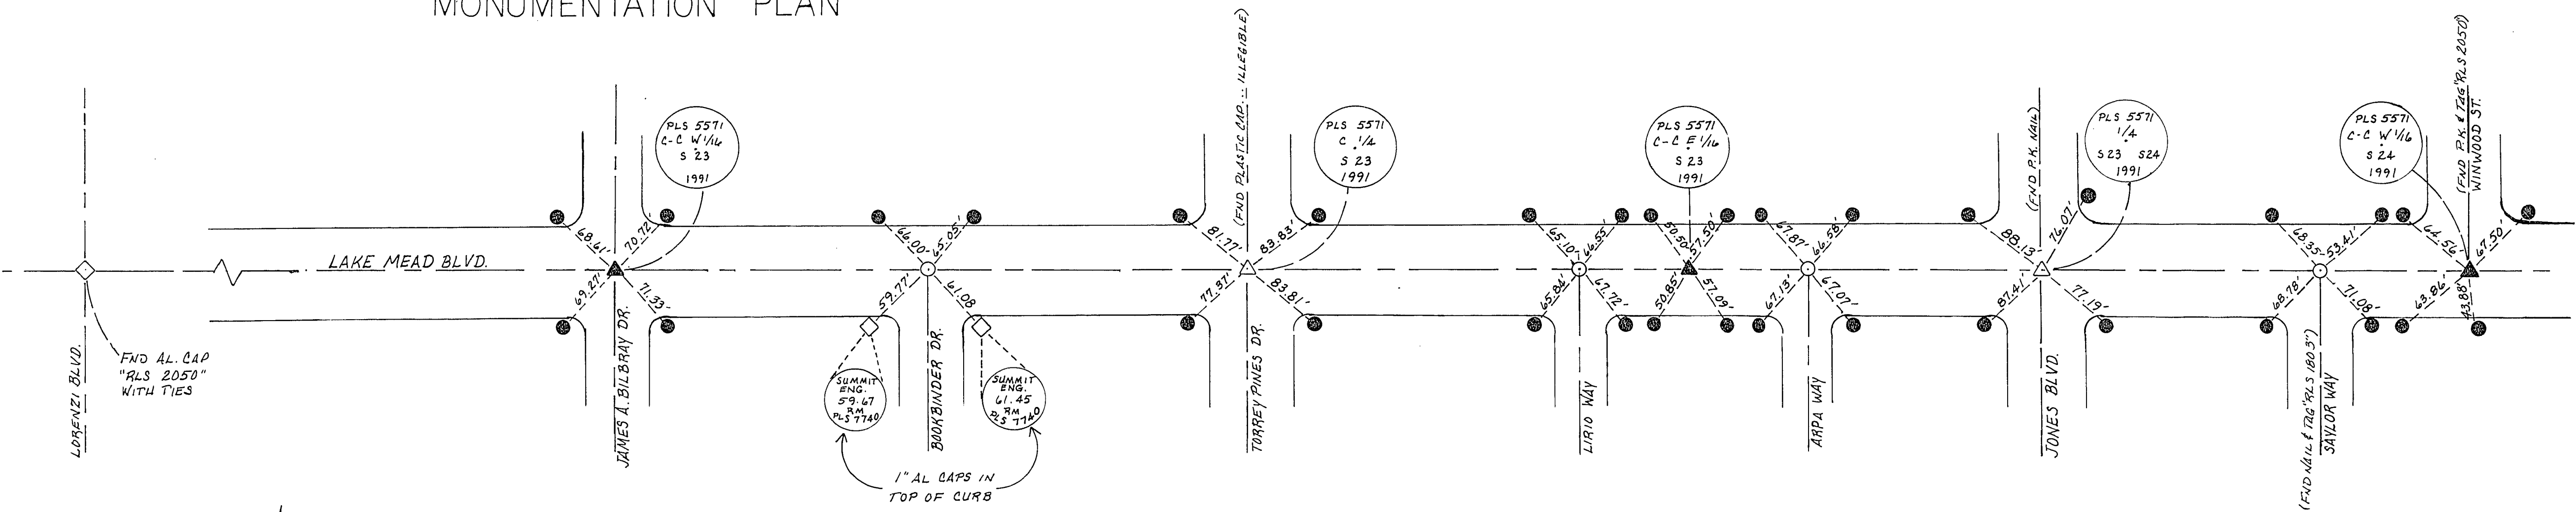

LEGEND

- △ SET TYPE I MONUMENT (MARKED AS NOTED)
- ▲ SET TYPE II MONUMENT (MARKED AS NOTED)
- SET TYPE III (S) MONUMENT (MARKED AS NOTED)
- SET TYPE III MONUMENT IN TOP OF CURB (TIE DISTANCES ARE AS NOTED)
- ◇ MONUMENT FOUND AS NOTED

THESE REPLACE MONUMENTS DESTROYED DURING CONSTRUCTION
PREVIOUS MONUMENTS SHOWN AS ()

I, WILLIAM T. AVERY, A REGISTERED PROFESSIONAL LAND SURVEYOR
IN THE STATE OF NEVADA, AND AS AGENT FOR
WESCO SURVEYS, INC., DO HEREBY CERTIFY THAT
THE MONUMENTS HAVE BEEN SET AND THE TIE DISTANCES
ESTABLISHED AS SHOWN HEREON. THIS SURVEY WAS
COMPLETED ON OCTOBER 2, 1991.

William T. Avery
WILLIAM T. AVERY
PLS 5571

10-22-91

MONUMENTATION PLAN
A PORTION OF THE
SECTION 23 AND WEST 1/2 SECTION 24
TOWNSHIP 20 SOUTH, RANGE 60 EAST, M.D.M.
CLARK COUNTY NEVADA
WESCO SURVEYS, INC.
3305 WEST SPRING MOUNTAIN ROAD
SUITE 60
LAS VEGAS, NEVADA 89102
(702) 367-0588

107-V1609
9-3-92