


MONUMENTATION TIE MAP

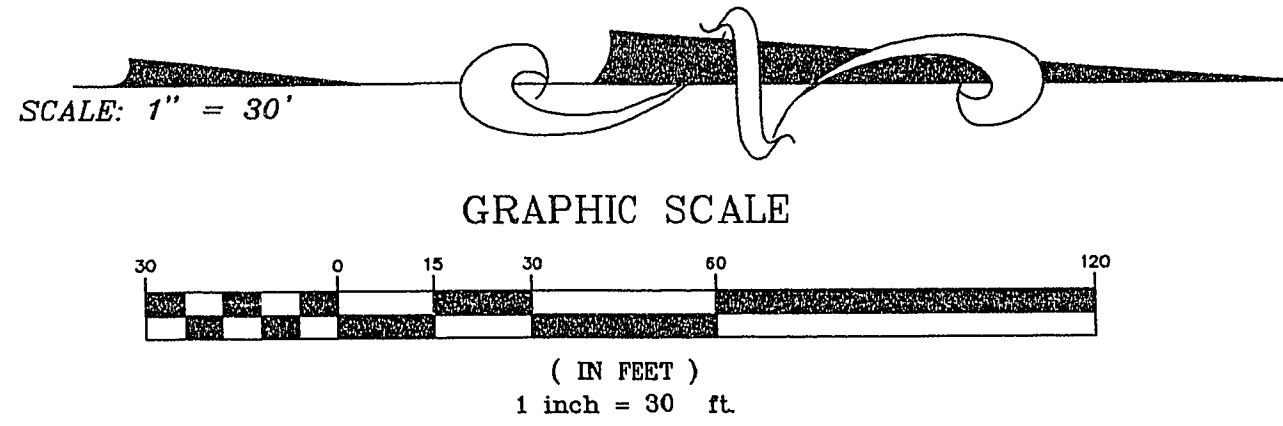

LEGEND

- SET 1-1/2" BRASS CAP
IN BACK OF CURB
- SET ALUMINUM CAP
PLS 10053
- FND POINT AS NOTED



LOT C
56,541 S.F.
1.30 ACRES

LOT D
45,492 S.F.
1.04 ACRES

LOT E
56,358 S.F.
1.29 ACRES

LOT F
42,020 S.F.
0.96 ACRES

LOT A
54,956 S.F.
1.26 ACRES

BUSINESS PARK COURT

TENAYA WAY

FND BRASS TIE CAP
P.L.S. 6015



JOHN E. FORSMAN
PROFESSIONAL LAND SURVEYOR
NEVADA CERTIFICAT NO. 10053

HORIZON SURVEYS
7320 SMOKE RANCH ROAD, SUITE D
LAS VEGAS, NEVADA 89128
(702) 228-5066 FAX: 228-0677

MONUMENTATION TIE MAP
RECORD OF SURVEY
FILE 75, PAGE 86

CITY OF LAS VEGAS NEVADA

JOB TITLE
JOB NO.
SHEET 1 OF 1