


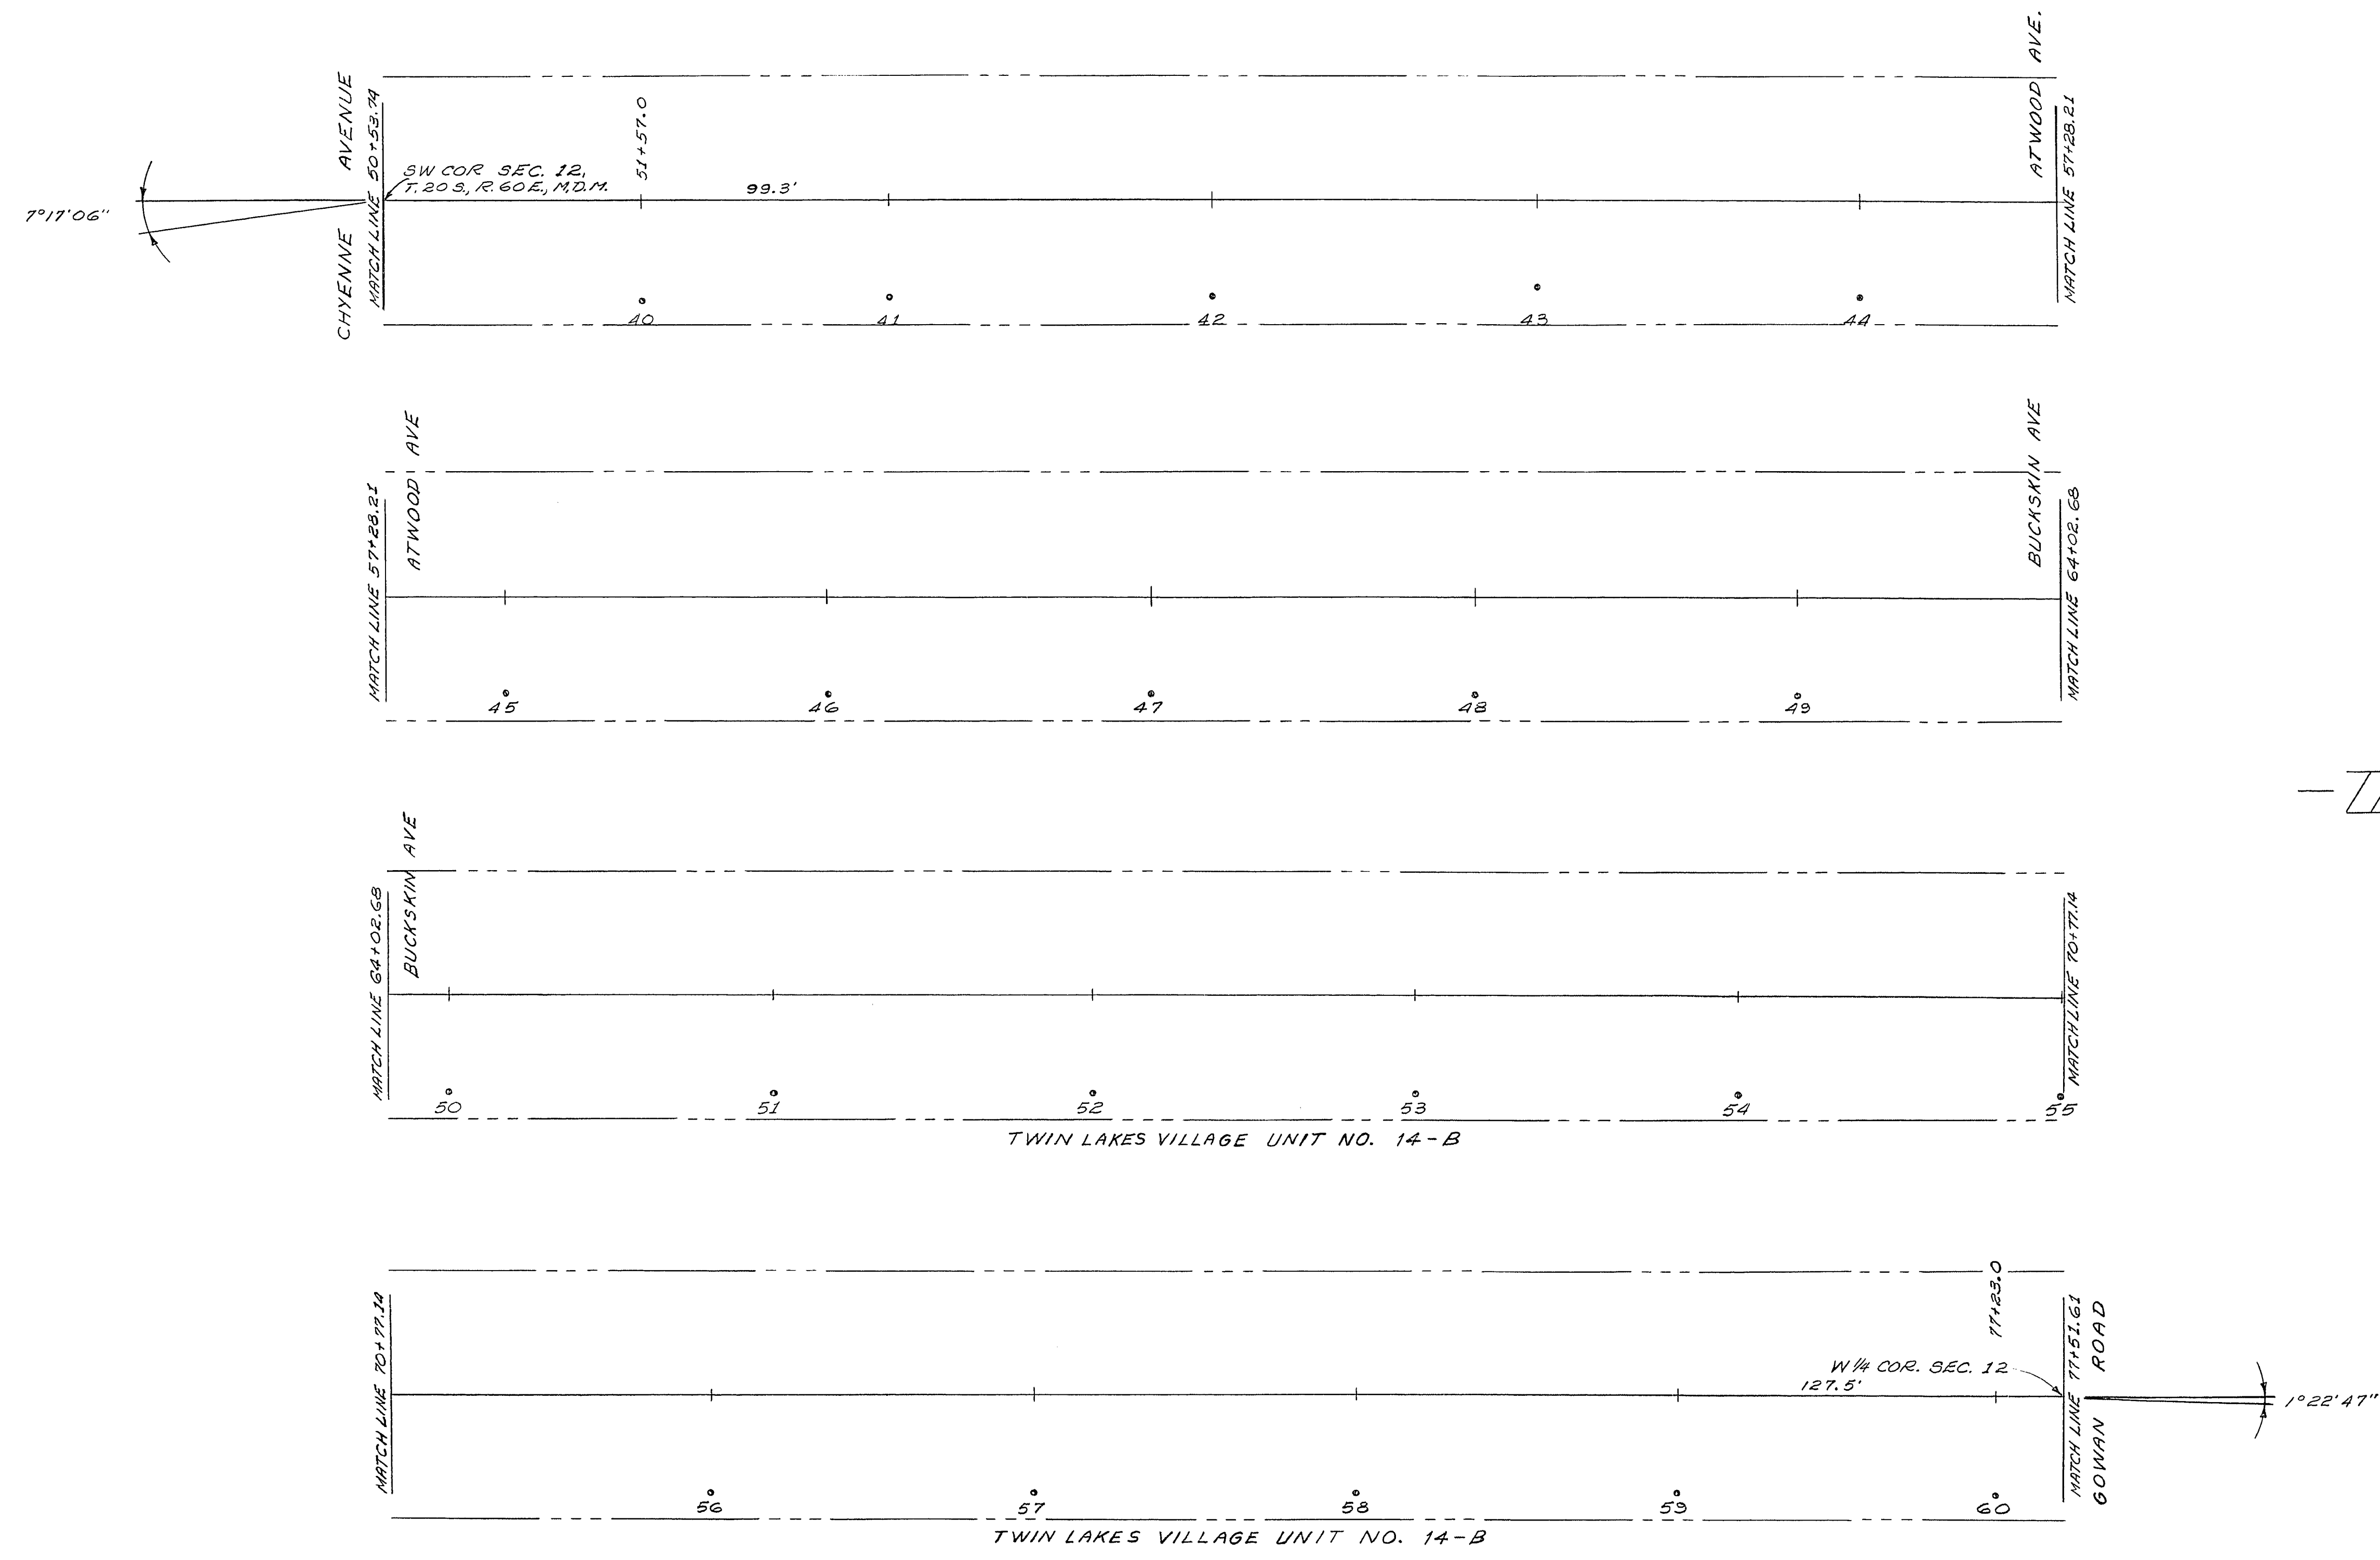

NOTES:
1. POLES SPACED 130 FT. ± EXCEPT AS SHOWN.
2. POLES OFFSET 38.4 FT. TO 40.1 FT.



Department of Public Works
Engineering Division

NEVADA BELL
POLE LINE
IN THE
SOUTHWEST QUARTER,
SECTION 12, T.20S, R.60E, M.D.M.

scale (h)	1" = 40'	scale (v)	-	drawing no.
w.o.no.		f.bk.no.	77-7X	
design by		drawn by	66	date 9-21-78
approved by Director of Public Works				sht. 2 of 3