


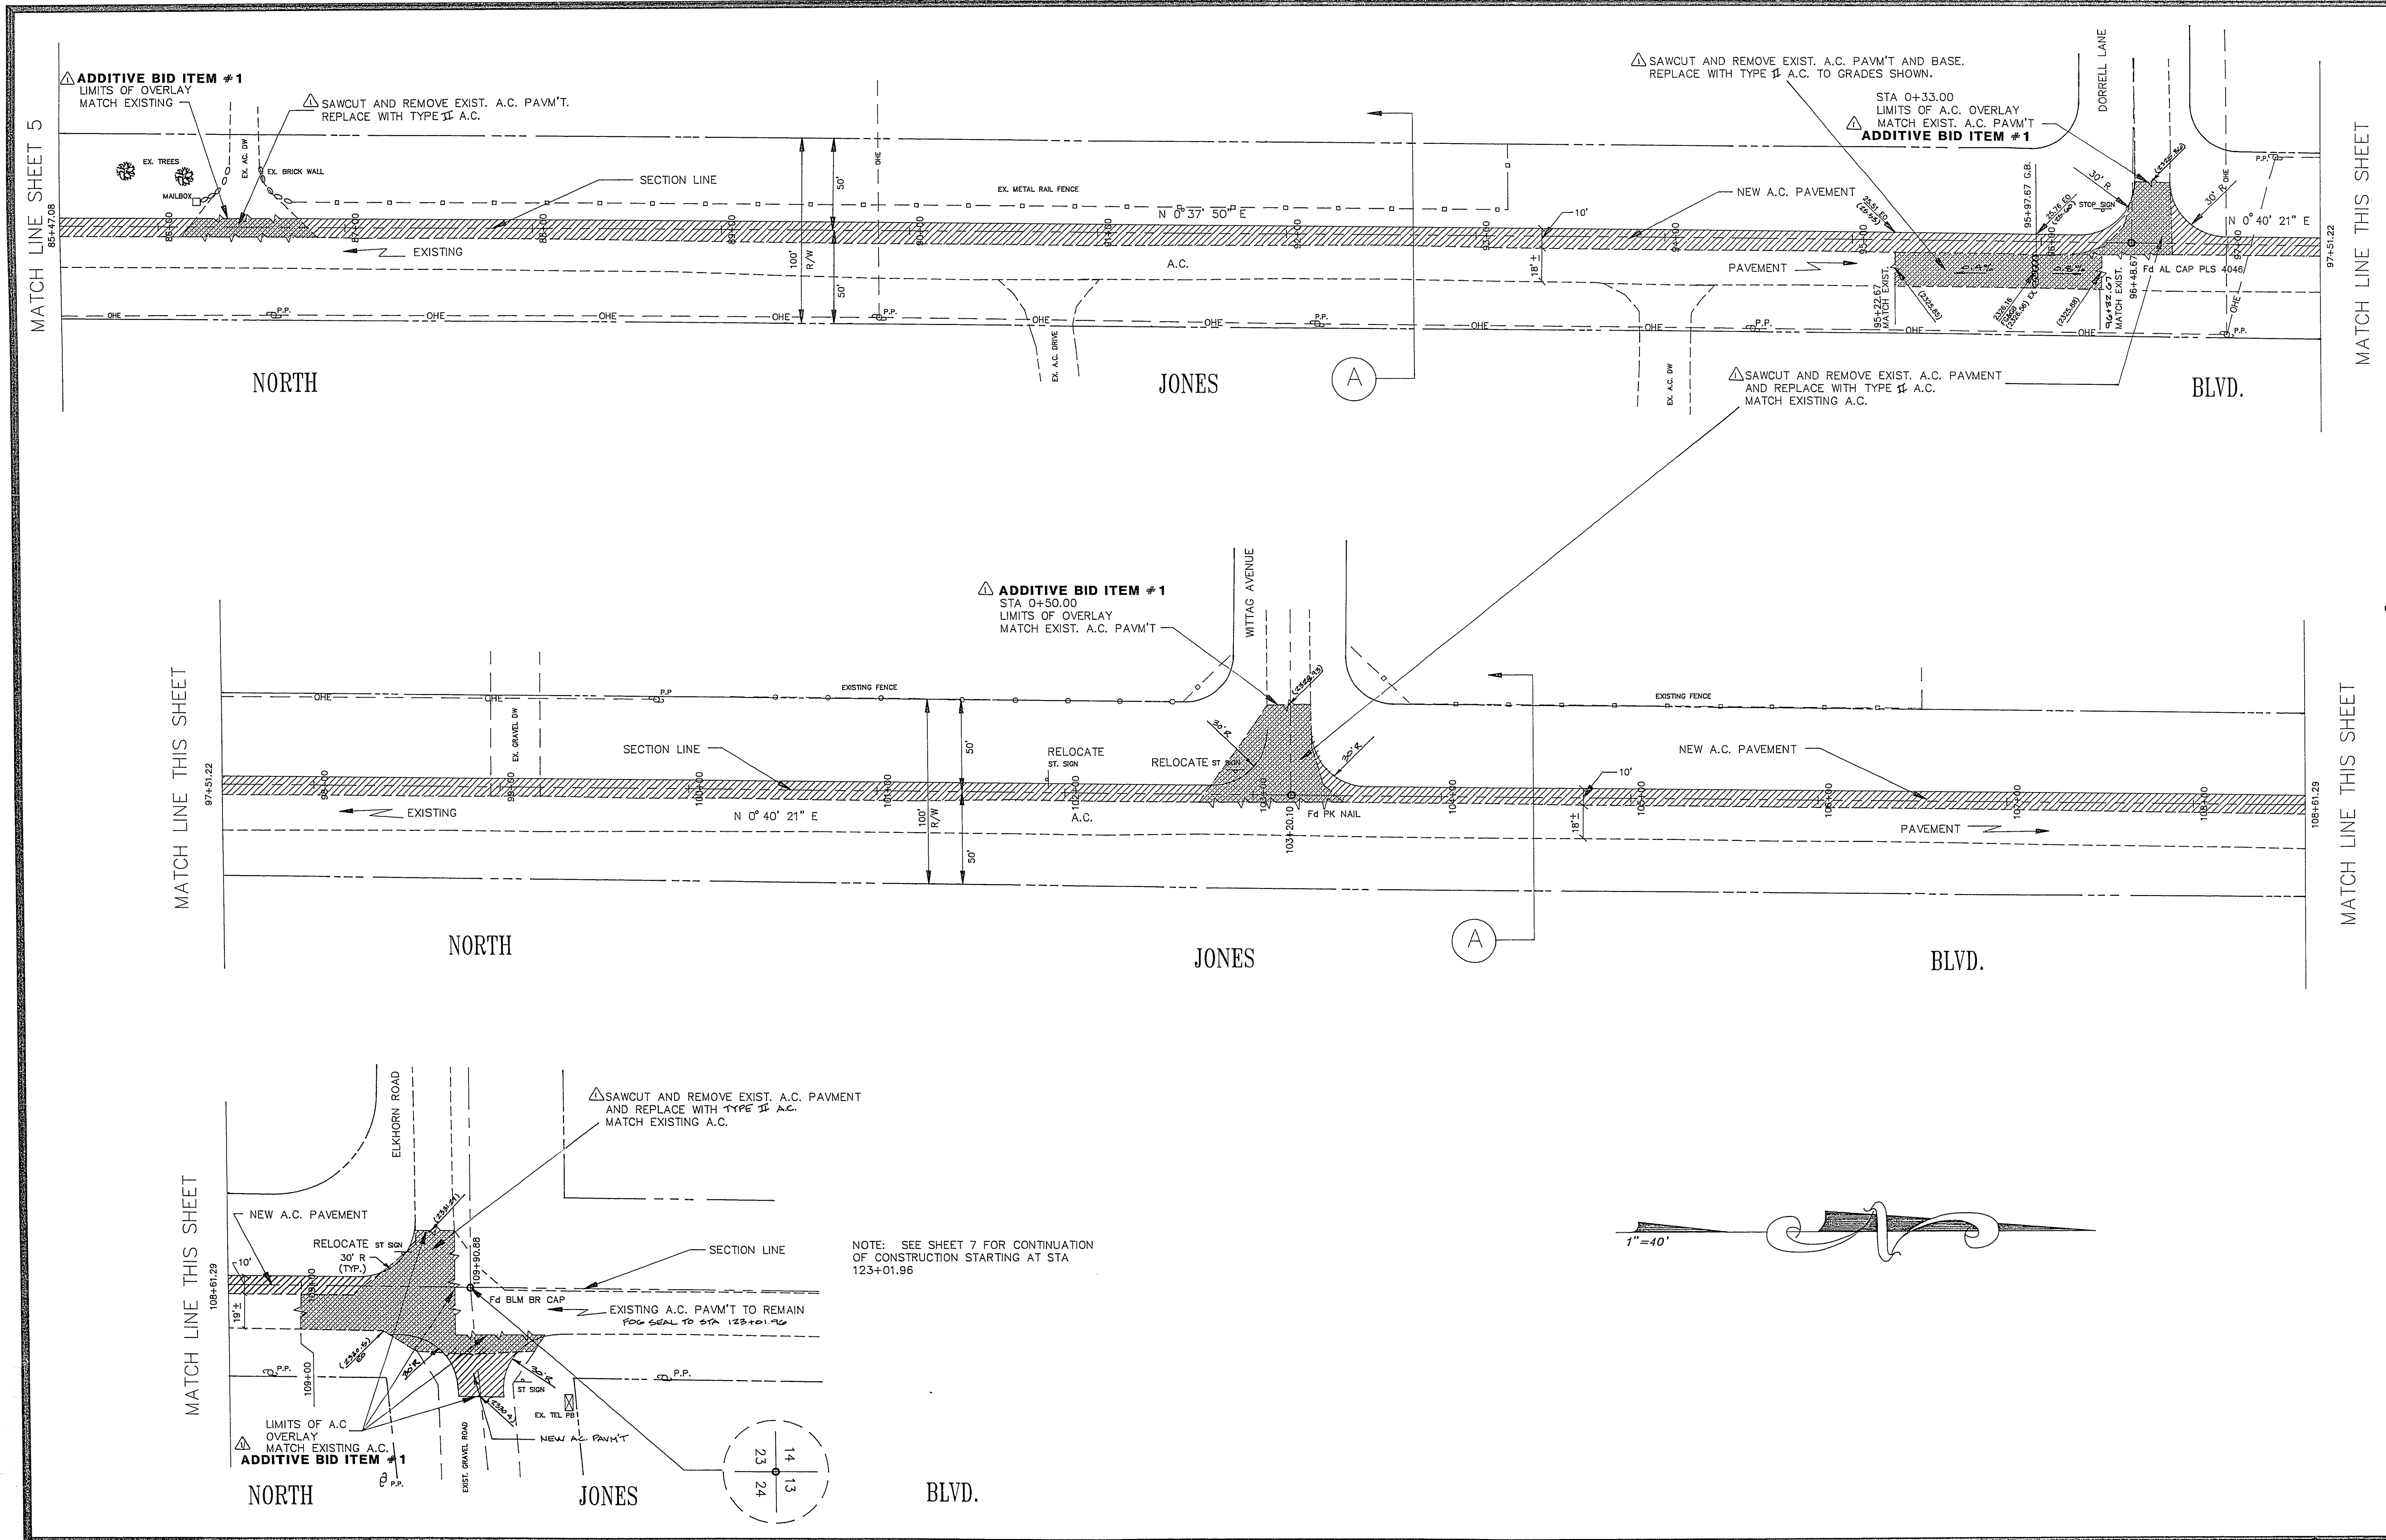

	DRAWING NO. 107-V1860	SHEET 6	PROJECT STREET PLAN STA 85+47.08 TO 109+90.88	PROJECT NORTH JONES BLVD. ANN RD. TO RACEL ST.	DEPARTMENT OF PUBLIC WORKS
	ENGINEERING DESIGN DIVISION CITY ENGINEER: GARY A. PRESSWOOD, P.E. SECTION CHIEF: BRIAN P. WALSH, P.E. DESIGN ENGINEER: EDWARD C. NETTENSTROM, P.E.				
	SCALE (H) 1"=40' FLD. BK. #	SCALE (V) N/A DATE 4/91	DATE 4/91 DESIGN BY EON	REVISIONS 1. 4/91	DATE 4/91
	MATCH LINE THIS SHEET				

25-3-110