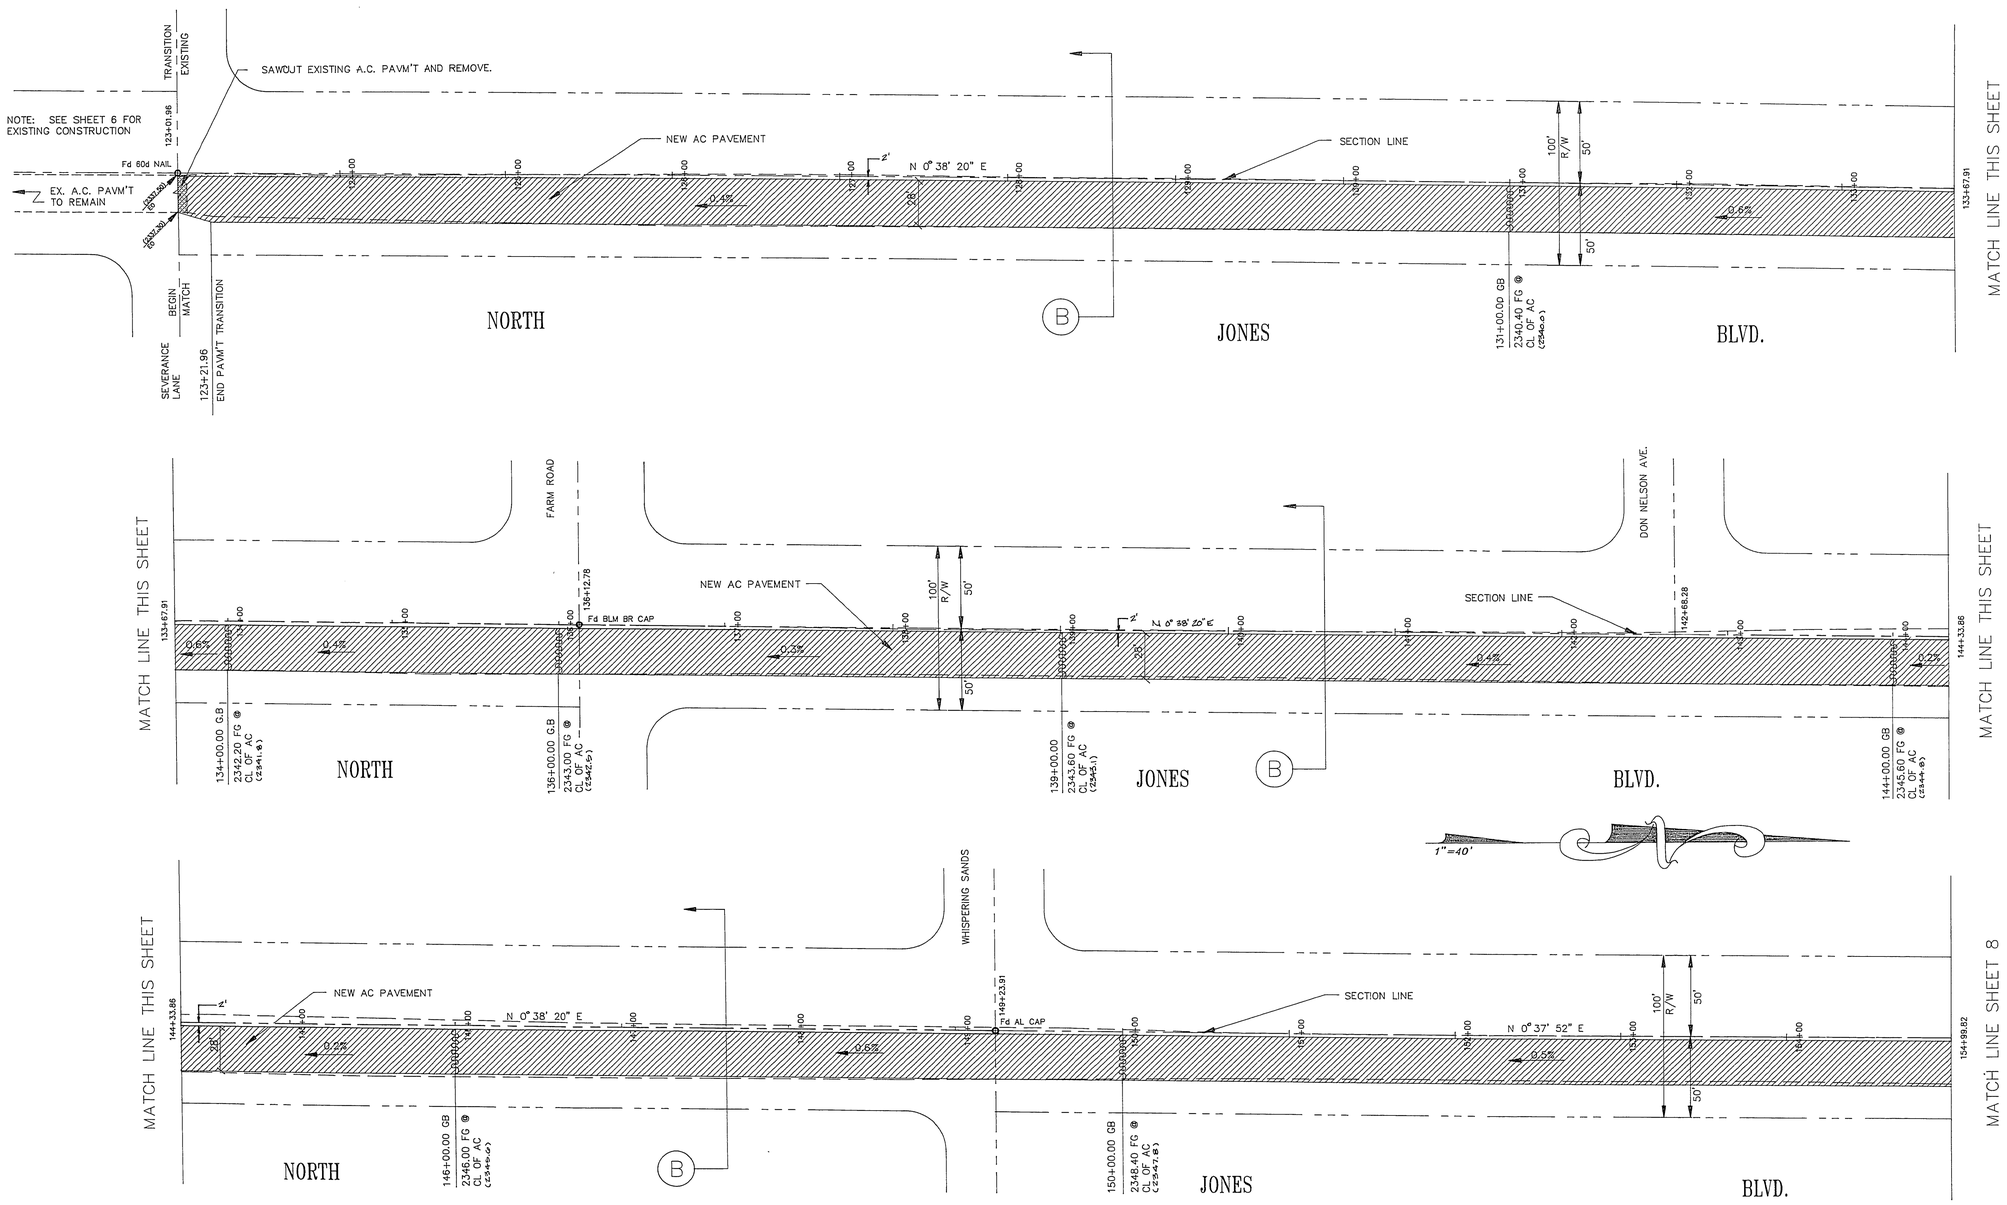

REVISIONS	DATE

SCALE (H) 1"=40' | SCALE (V) N/A | W.A. # WU9178
FLD. BK- # | DATE 4/91 | DESIGN BY ECN

ENGINEERING DESIGN DIVISION

CITY ENGINEER: GARY A. PRESSWOOD, P.E.
SECTION CHIEF: BRIAN P. WALSH, P.E.
DESIGN ENGINEER: EDWARD C. NETTENSTROM, P.E.

4-17-91

DEPARTMENT OF PUBLIC WORKS

PROJECT: NORTH JONES BLVD. ANN RD. TO RACEL ST.

SHEET: STREET PLAN STA 123+01.96 TO 154+99.82

CITY OF LAS VEGAS NEVADA

DRAWING NO. 107-V1860 | 7/8

25-3-11