

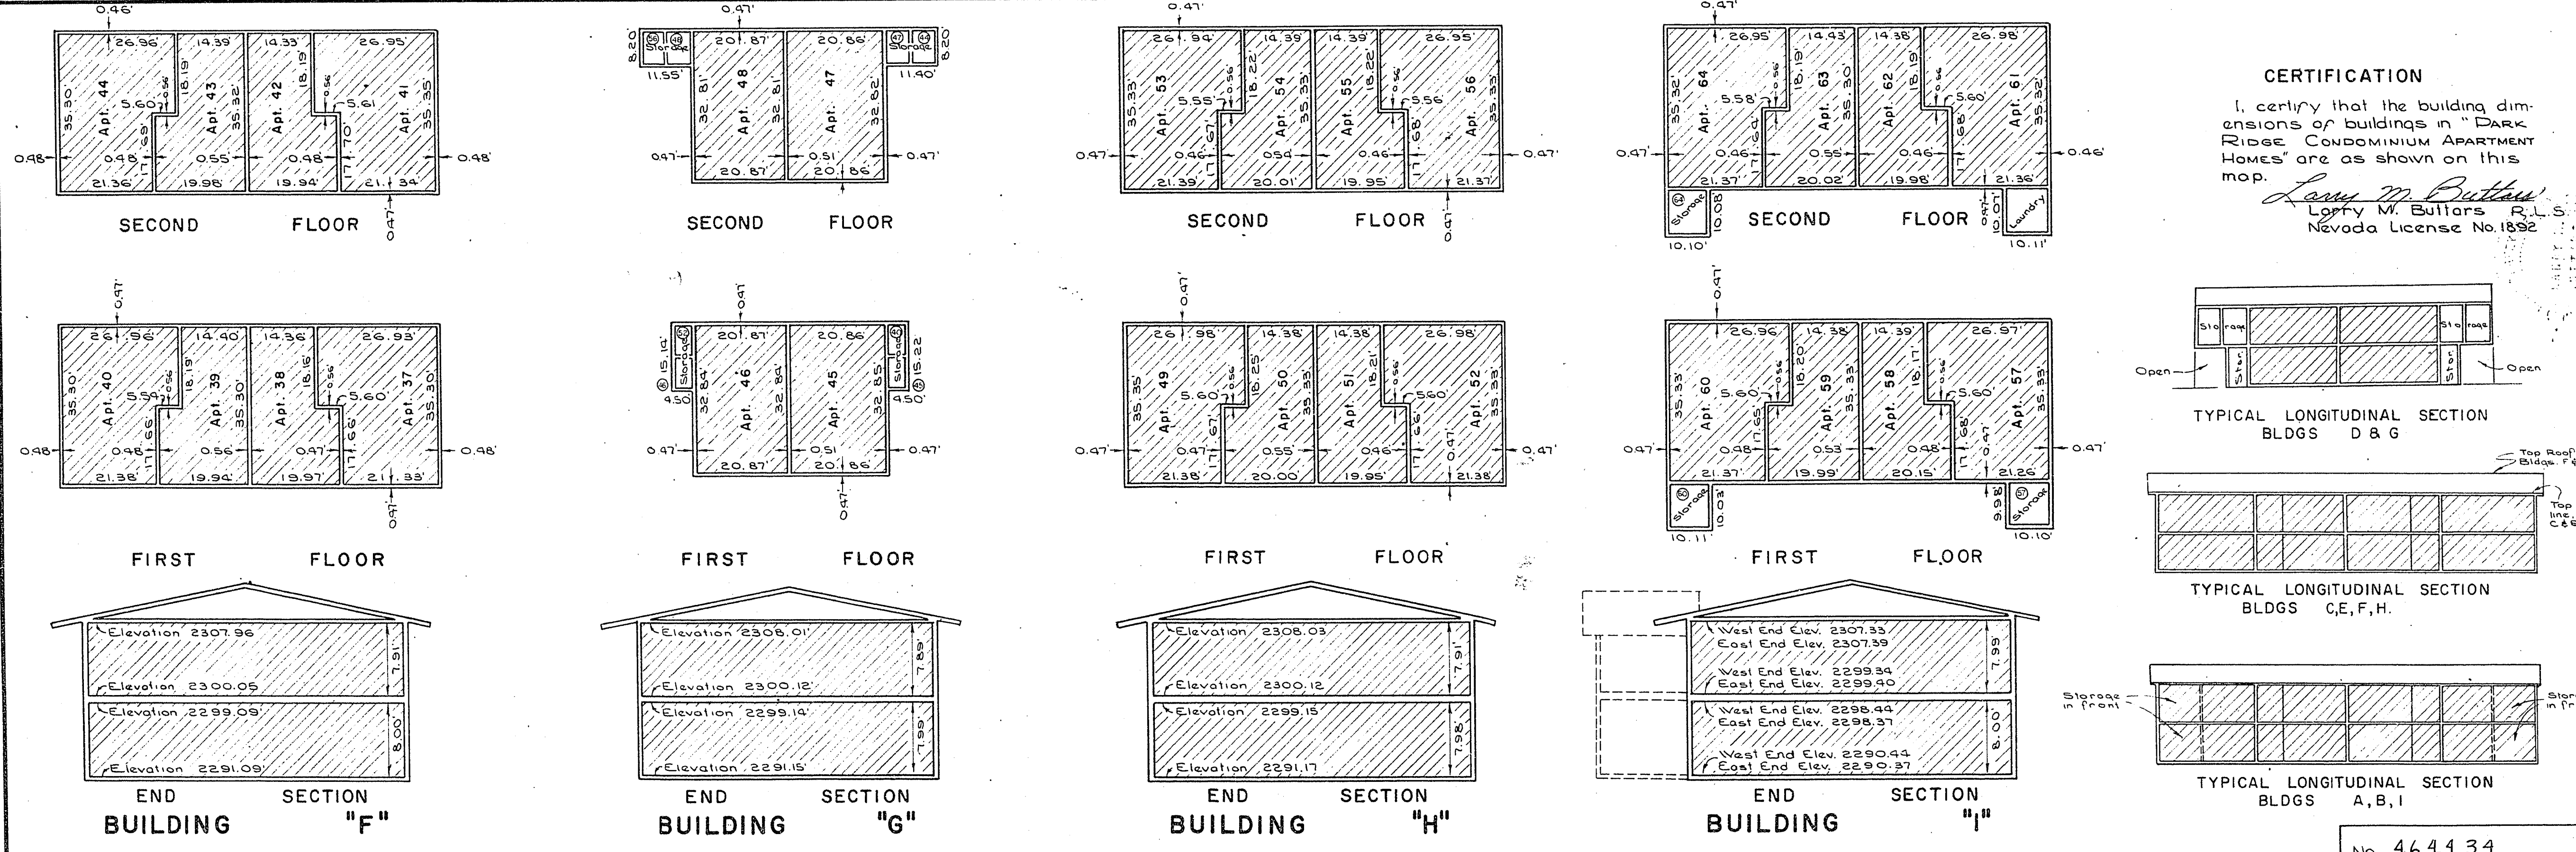


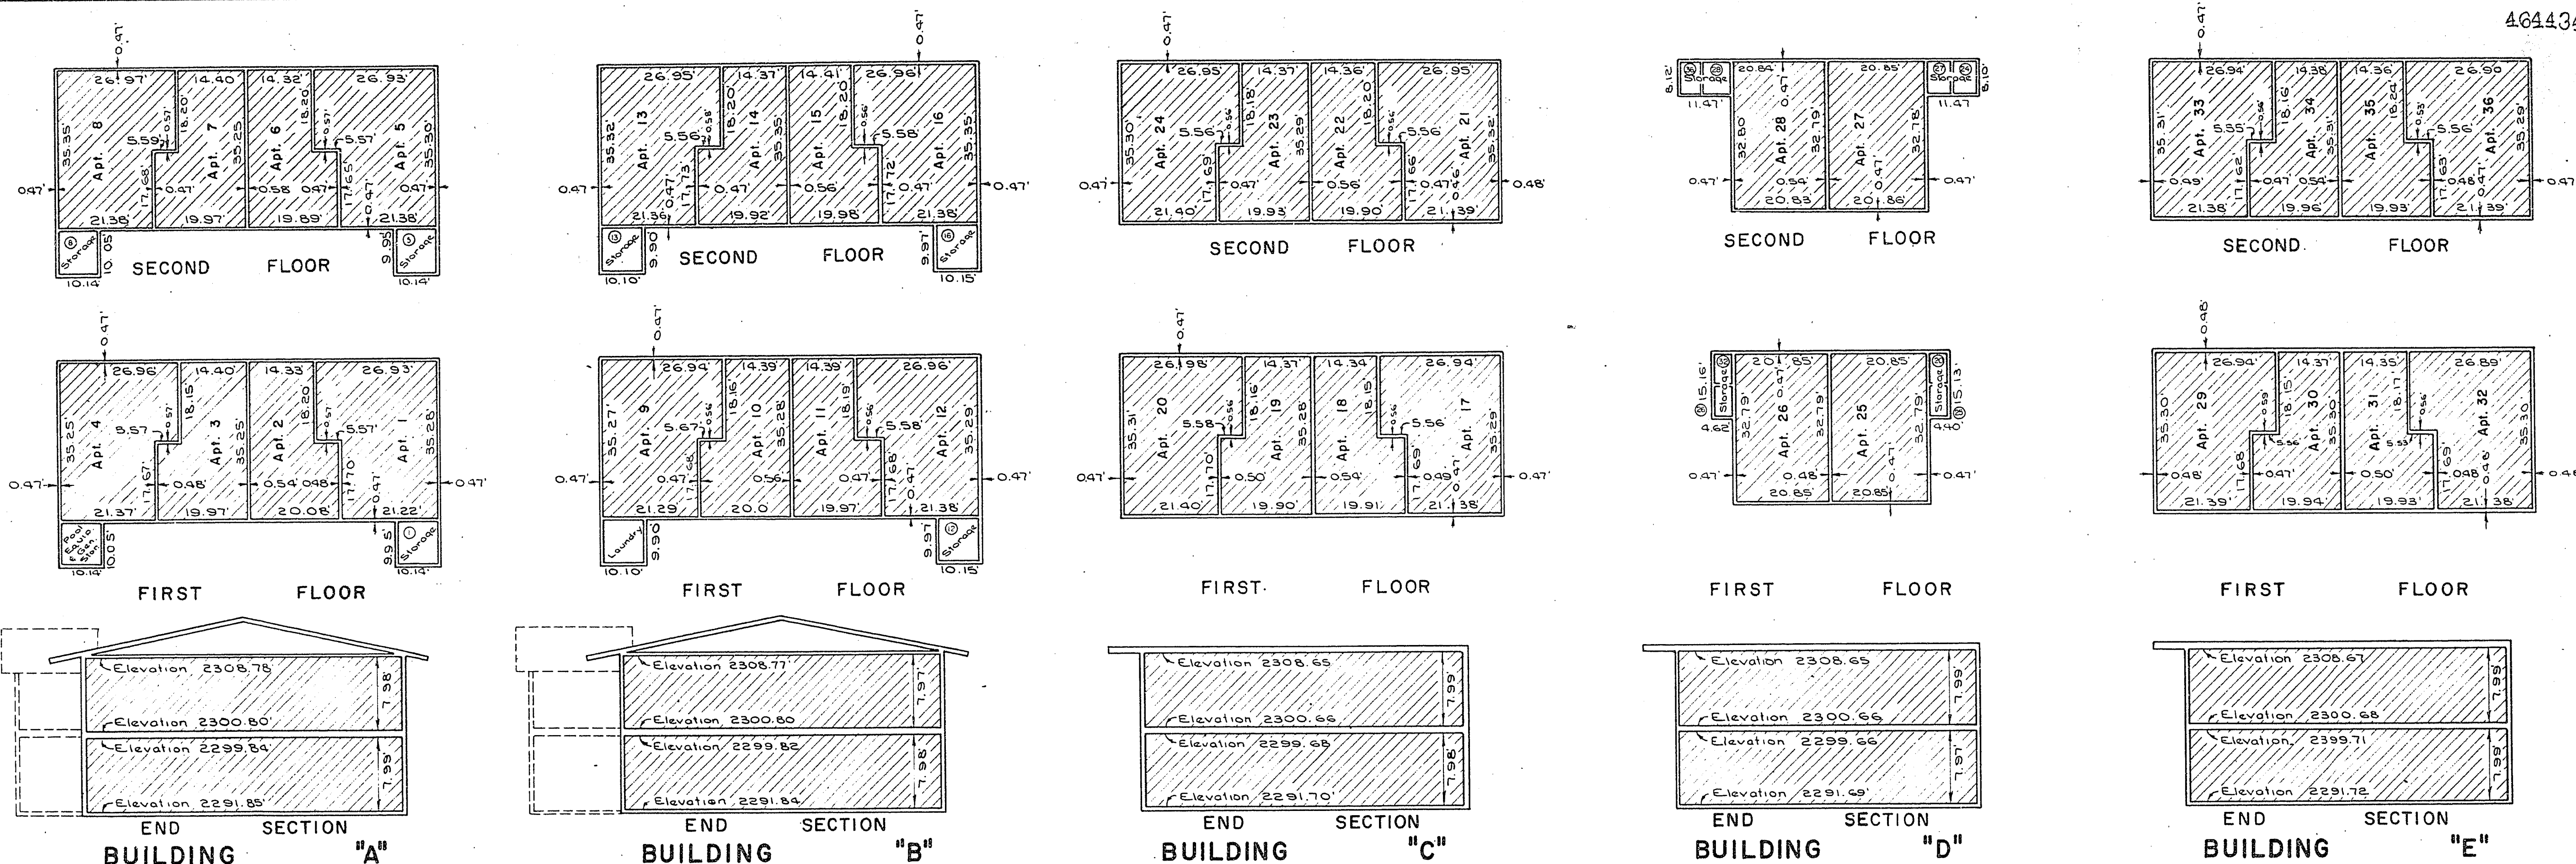


**CERTIFICATION**

I, certify that the building dimensions of buildings in "PARK RIDGE CONDOMINIUM APARTMENT HOMES" are as shown on this map.


*Larry M. Buttar*  
Larry M. Buttar, R.L.S.  
Nevada License No. 1892

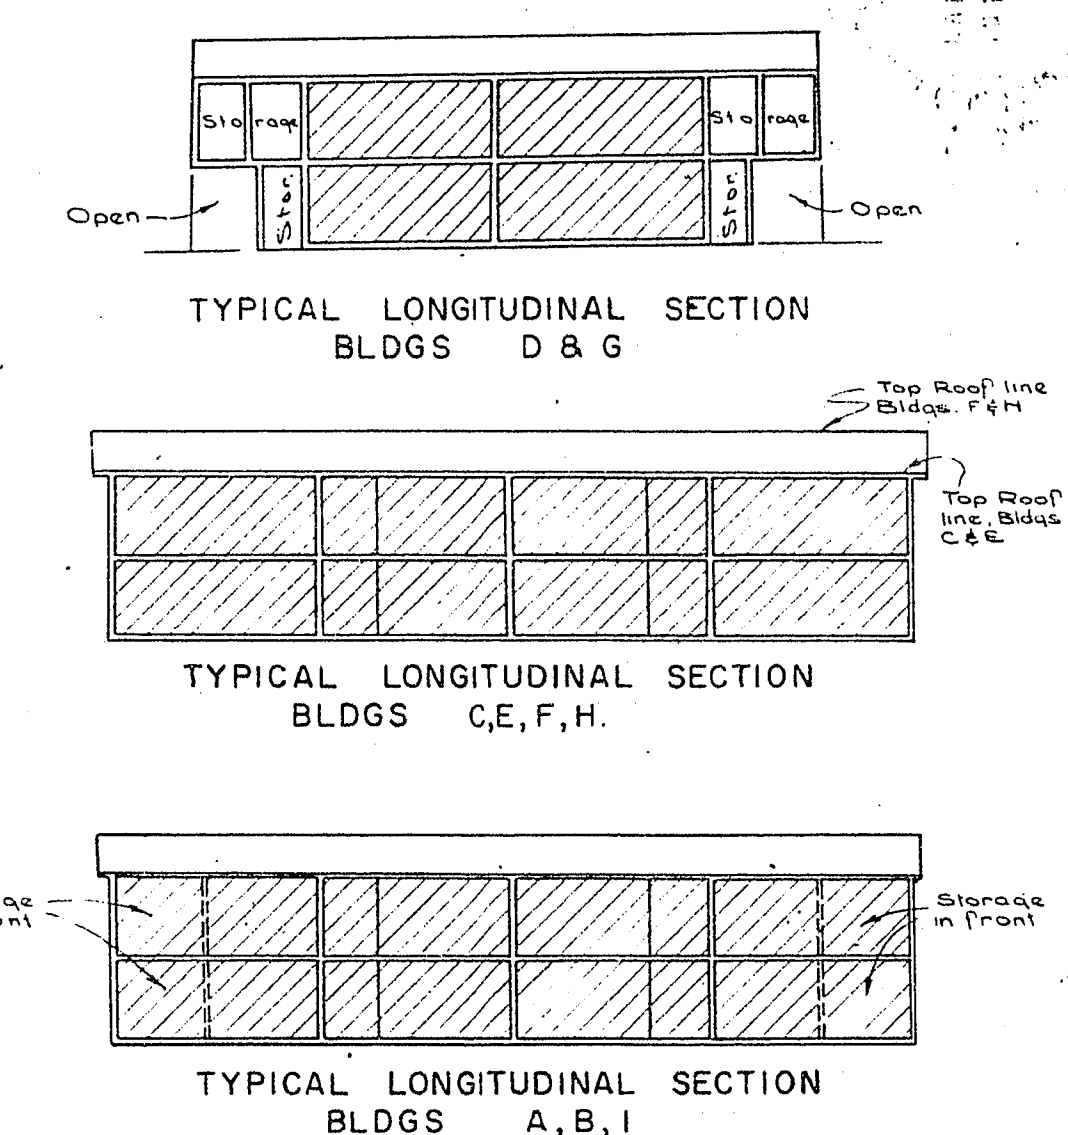

**UTILITY & STORAGE BUILDING ①**

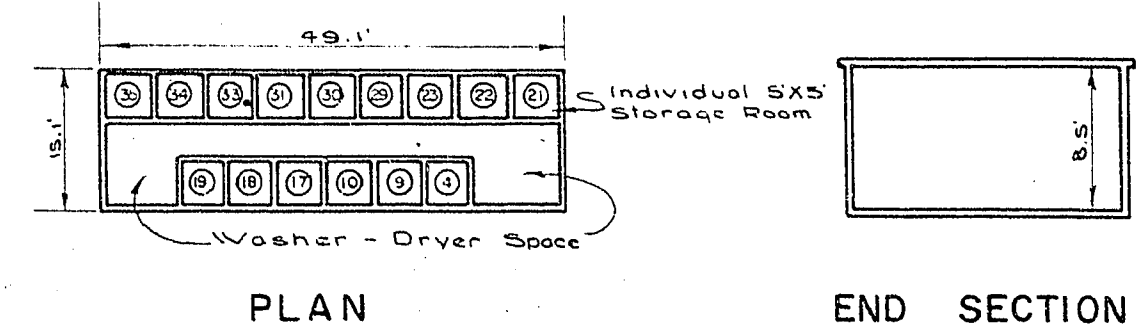

**UTILITY & STORAGE BUILDING ②**

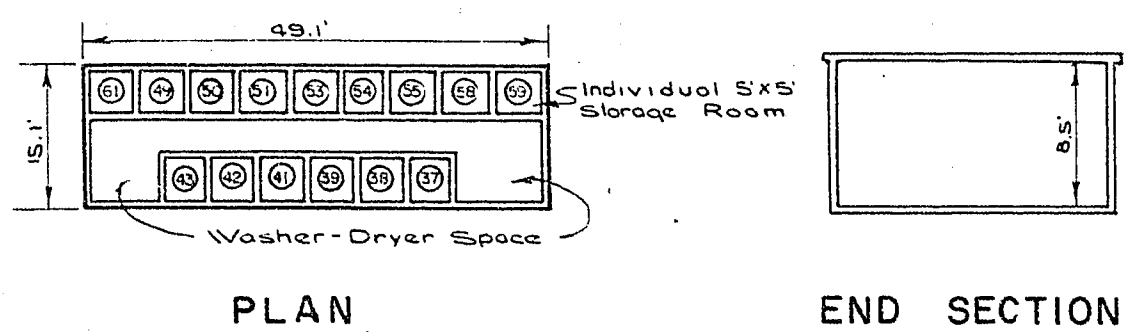

**NOTES**

1. All plan views to scale 1"=10'
2. End section to scale 1"=10'
3. Longitudinal sections to scale 1"=20'
4. All interior dimensions are to finished surfaces.
5. Pipes, ducts, flues & other utility installations within the unit are to be common ownership.

**NORTHRIDGE UNIT NO. 1-A**  
RE-SUBDIVISION OF LOTS 14-20 INCLUSIVE, BLOCK 3  
A SUBDIVISION MAP FOR CONDOMINIUM PURPOSES

**PARK RIDGE CONDOMINIUM APARTMENT HOMES**  
PART OF THE SW 1/4 OF SECTION 25, T20S, R60E, MDB&M  
CITY OF LAS VEGAS, CLARK COUNTY, NEVADA

SHEET 2 OF 2

No. 464434  
Recorded at the request of  
Pioneer Title Insurance  
Co. of Nevada  
Date 10-13-64 at 9:33 AM  
Book 10 Page 43  
of Plats  
Official Record Book No. 577  
Clark County, Nevada records  
Paul E. Horn, Recorder  
Fee \$17.00 m.s. Deputy