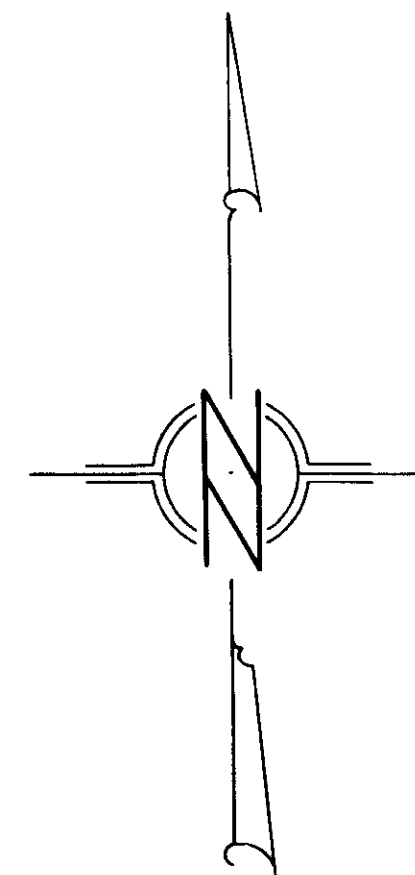
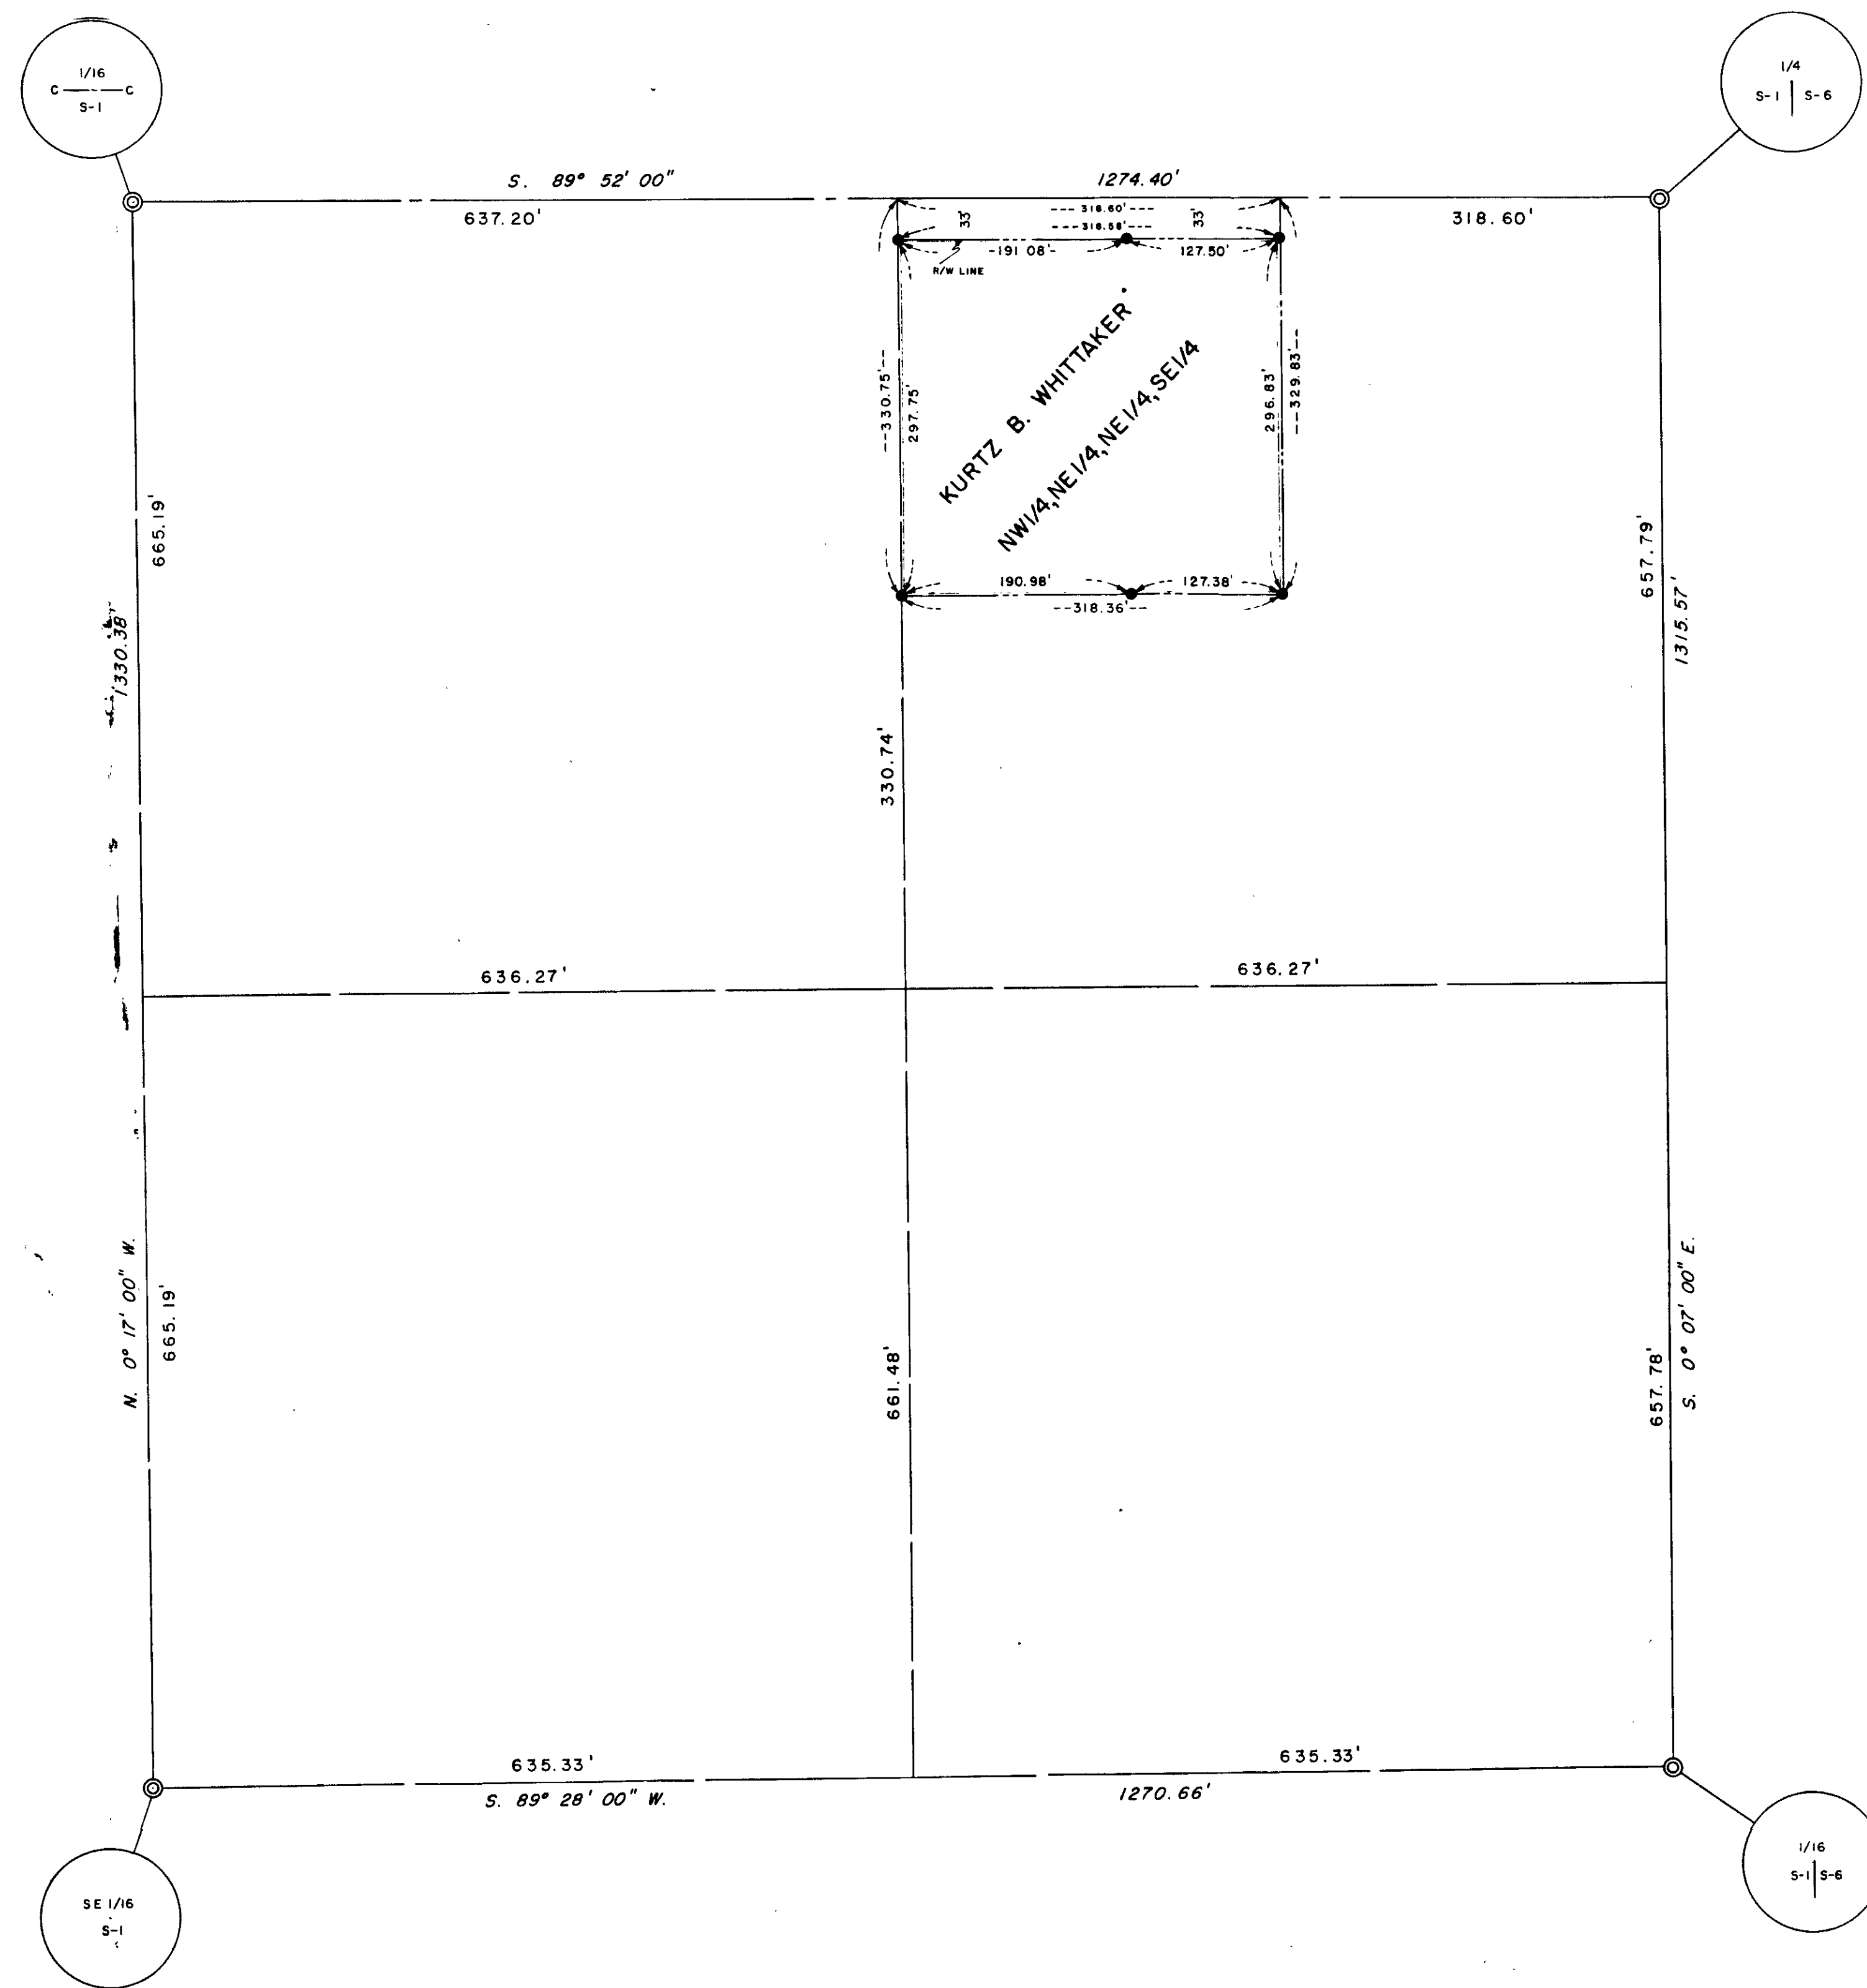


— L E G E N D —

BASIS OF BEARING: DEPENDENT RESURVEY OF SEC. 1 T.21S. R.60E. M.D.B. & M.  
UNITED STATES DEPARTMENT OF THE INTERIOR, BUREAU LAND MANAGEMENT

● = INDICATES 2X2 HUB WITH TAG MARKED R.E. 560, SET AS SHOWN HEREON

**ENGINEER'S CERTIFICATE**

I, L. E. TYSON, REGISTERED CIVIL ENGINEER AND LAND SURVEYOR NEVADA NO. 560  
DO HEREBY CERTIFY THAT THIS MAP IS A TRUE AND CORRECT PLAT OF THE LAND  
SURVEYED BY ME AT THE INSTANCE OF KURTZ B. WHITTAKER, AND LOCATED IN  
THE SE 1/4 SEC. 1, T.21S. R.60E. M.D.B. & M. CLARK COUNTY, NEVADA. AND THIS  
SURVEY WAS COMPLETED ON THIS 14TH DAY OF DECEMBER, 1954.

*L. E. Tyson*  
L. E. TYSON REG. CIVIL ENG. & LAND SURVEYOR NEV. 560

31091  
L. E. Tyson  
1-11-55 1:52 P  
3 96  
2<sup>nd</sup> bn


MAP FOR RECORD OF SURVEY  
FOR  
KURTZ B. WHITTAKER  
SE 1/4, SEC. 1, T.21S, R.60 E.  
M.D.B. & M.  
CLARK COUNTY, NEVADA  
055-86