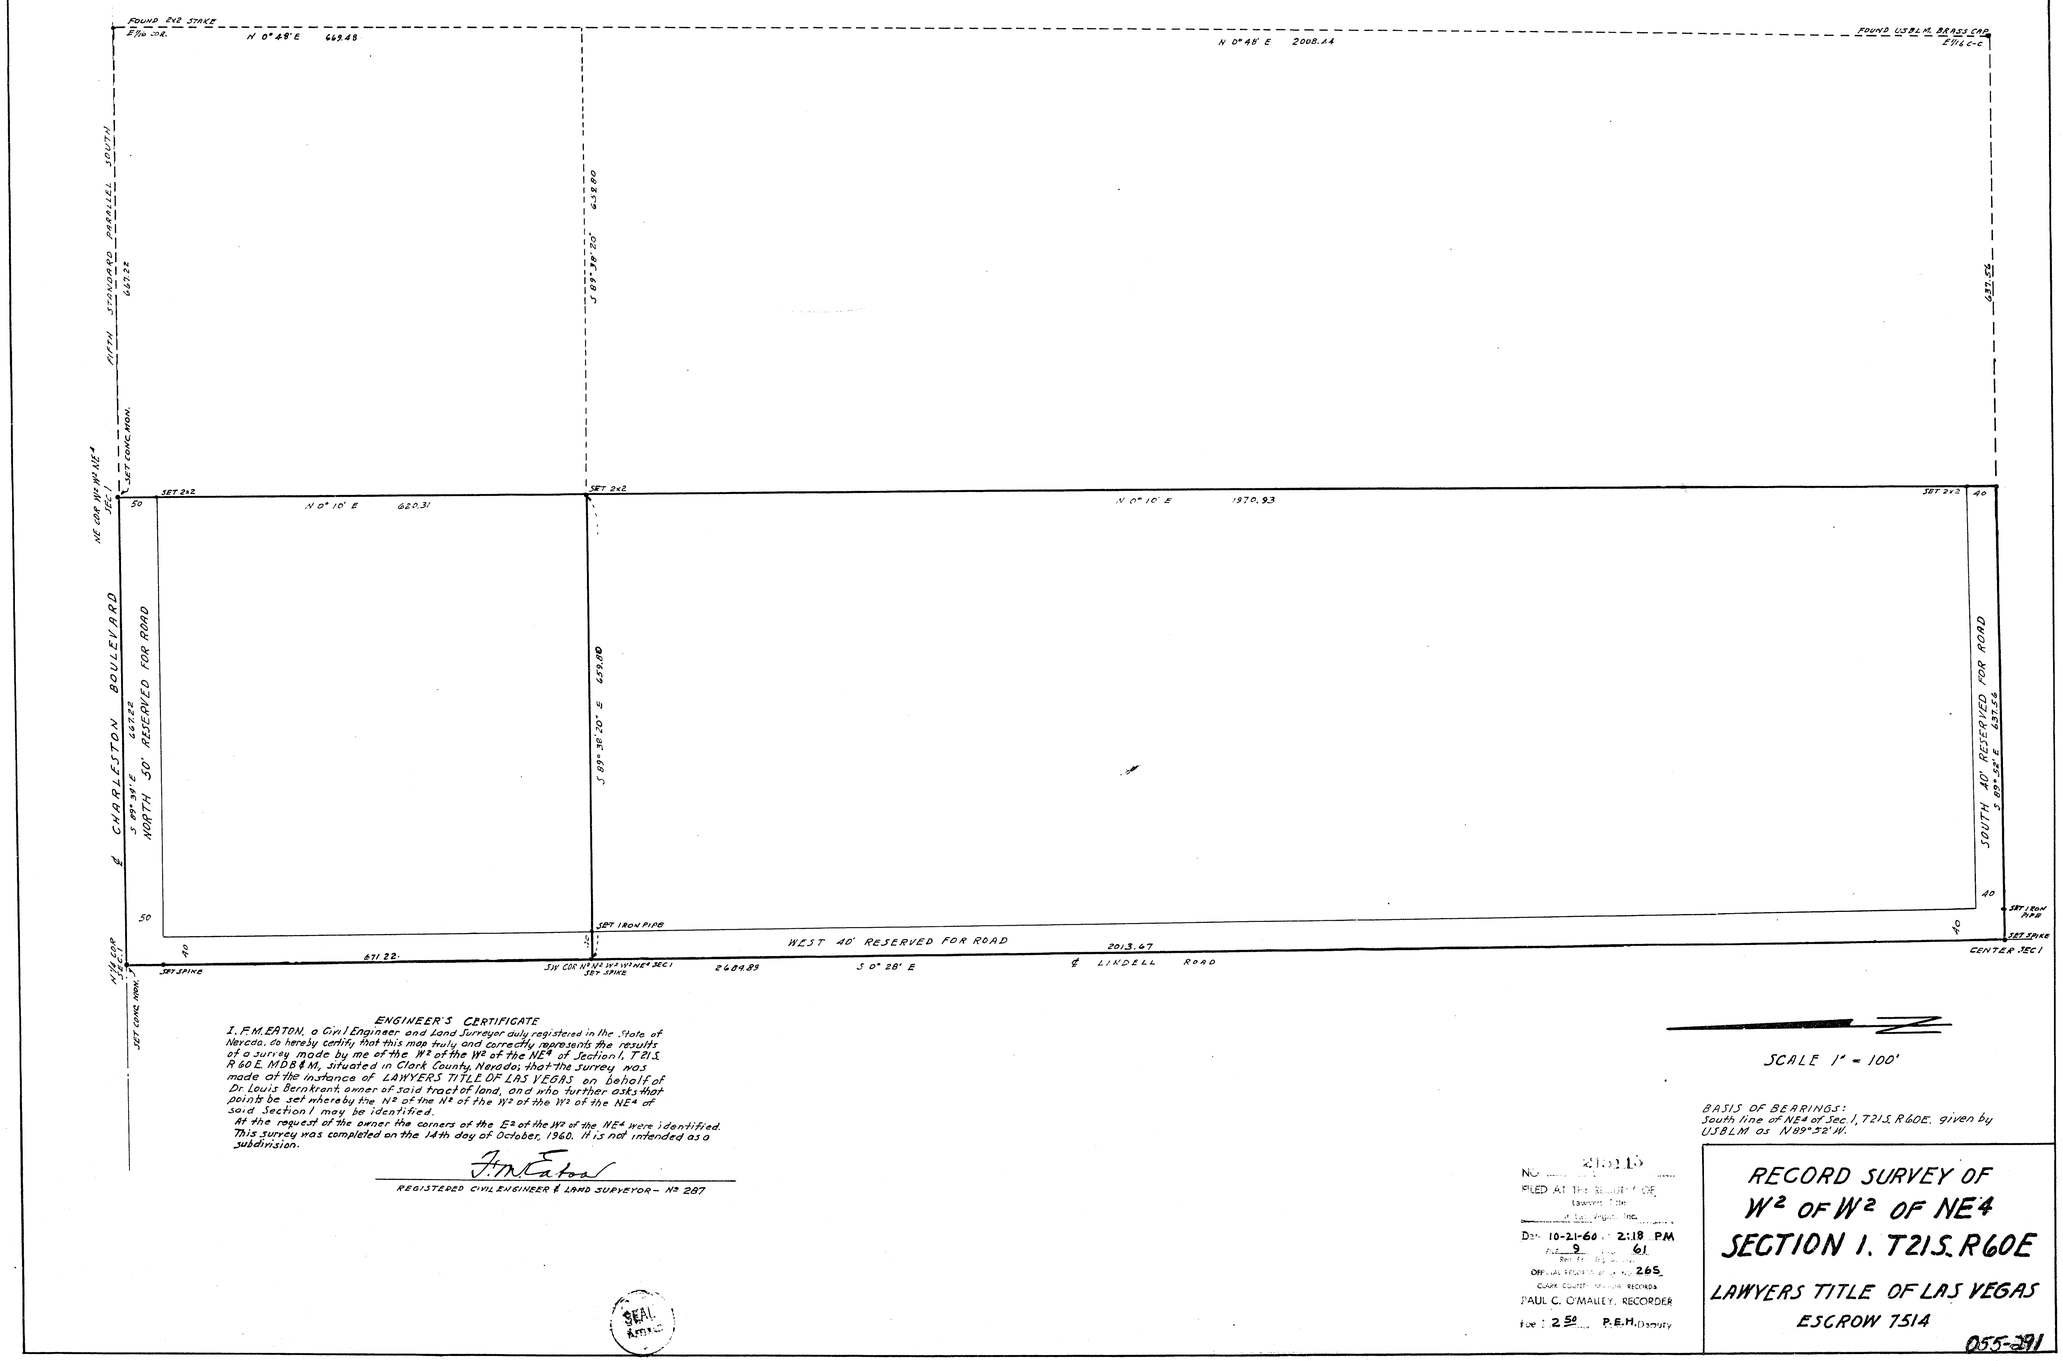

SCALE 1" = 100'

BASIS OF BEARINGS:
South line of NE¼ of Sec 1, T21S. R60E. given by USBLM as N89°32'W.

ENGINEER'S CERTIFICATE

I, F. M. EATON, a Civil Engineer and Land Surveyor duly registered in the State of Nevada, do hereby certify that this map truly and correctly represents the results of a survey made by me of the W½ of the W½ of the NE¼ of Section 1, T21S R60E. M.D.B.&M., situated in Clark County, Nevada; that the survey was made at the instance of LAWYERS TITLE OF LAS VEGAS on behalf of Dr. Louis Bernkrant, owner of said tract of land, and who further asks that points be set whereby the N½ of the N½ of the W½ of the W½ of the NE¼ of said Section 1 may be identified.

At the request of the owner the corners of the E½ of the W½ of the NE¼ were identified.

This survey was completed on the 14th day of October, 1960. It is not intended as a subdivision.

F. M. Eaton

REGISTERED CIVIL ENGINEER & LAND SURVEYOR— No 287

SEAL

No. 21015
FILED AT THE REQUEST OF
Lawyers Title
of Las Vegas, Inc.
Date 10-21-60 2:18 P.M.
File 9 Page 61
Records Clark County, Nevada
OFFICIAL FEE(S) $ 265
CLARK COUNTY, NEVADA RECORDS
PAUL C. O'MALLEY, RECORDER
Fee: 2.50 P.E.H. Deputy

RECORD SURVEY OF W² OF W² OF NE¼ SECTION 1. T21S. R60E

LAWYERS TITLE OF LAS VEGAS
ESCROW 7514

055-291