PLUMBING SYMBOL SCHEDULE

PIPING			
	SOIL, WASTE OR LEADER - ABOVE GRADE	S	SINK
	SOIL, WASTE OR LEADER - BELOW GRADE	SA	SHOCK ABSORBER
	VENT	SCO	SURFACE CLEANOUT
	COLD WATER	SH	SHOWER
	HOT WATER	SS	SERVICE SINK
	HOT WATER RETURN	UR	URINAL
	GAS	VTR	VENT THRU ROOF
ACD	ACID WASTE	VCP	VITRIFIED CLAY PIPE
A	COMPRESSED AIR	WC	WATER CLOSET
V	VACUUM LINE	WCO	WALL CLEAN OUT
	CHILLED DRINKING WATER SUPPLY	WM	WASHING MACHINE
	CHILLED DRINKING WATER RETURN	FITTINGS	
F	FUEL OIL		BLIND FLANGE
WSP	WATER SANITARY		FLEXIBLE
CSP	CHILL STANDPIPE		REDUCER, CONCENTRIC
	LOW PRESSURE STEAM		REDUCER, ECCENTRIC
	LOW PRESSURE STEAM RETURN		TEE, OUTLET DOWN
	HIGH PRESSURE STEAM RETURN		TEE, OUTLET UP
	HIGH PRESSURE STEAM SUPPLY	PIPE	END CAP
	HIGH PRESSURE STEAM RETURN	VALVES	
	CONDENSATE PUMP DISCHARGE		GATE
	FEEDER FOR PUMP DISCHARGE		GLOBE
ABBREVIATIONS			DELAY
AC	AREA DRAIN		ANGLE GATE ELEVATION
ACP	ASBESTOS CEMENT PIPE		ANGLE GAGE PLAN
BT	BATHTUB		
C	CAST IRON		MALE THREAD
CO	CLEANOUT		FEMALE THREAD
CDI	CLOTHY WASHER		CHECK VALVE
CU	CURB		
DF	DRINKING FOUNTAIN		
DW	DISHWASHER		
FD	FLOOR DRAIN		
F	FUEL		
FD	FLOOR DRAIN		
FH	FIRE HOSE CABINET		PRESSURE GAGE
	FLOOR SINK		FLOW METER
	GREASE TRAP		
	HOSE BIBB		
	INSERT ANCHOR		
	LAVATORY		
YH	YARD HYDRANT		

NOTES:

1. PLUMBING CONTRACTOR SHALL VERIFY LOCATION OF AND DISTANCE TO EXISTING WATER AND SEWAGE LINES.
2. SEWAGE LINES SHALL CONFORM TO SPECIFICATIONS OF THE CITY OF LAS VEGAS ENGINEERING DEPARTMENT.
3. WATER LINES SHALL CONFORM TO SPECIFICATIONS OF THE LAS VEGAS VALLEY WATER DISTRICT.
4. WATER METER; METER MANIFOLDS AND METER BOX BY OWNER. 45 GPM MAXIMUM DEMAND AT 40 P.S.I. ON BLDG. SIDE OF METER.
5. FIRE HYDRANT AND ASSOCIATED PIPING SHALL CONFORM TO AND BE INSTALLED ACCORDING TO SPECIFICATIONS OF THE CITY OF LAS VEGAS ENGINEERING AND FIRE DEPARTMENTS.

NOTE:
PARKING LOT LIGHTING INCLUDING FIXTURES, POLES, WIRE, & CONDUIT TO BE BID AS AN ALTERNATE "1" SEE SPECIFICATIONS. IN EVENT THAT ALTERNATE "1" IS REJECTED PROVIDE STUB OUT AT MECH. RM. WALL FOR PARKING LOT LIGHT'G

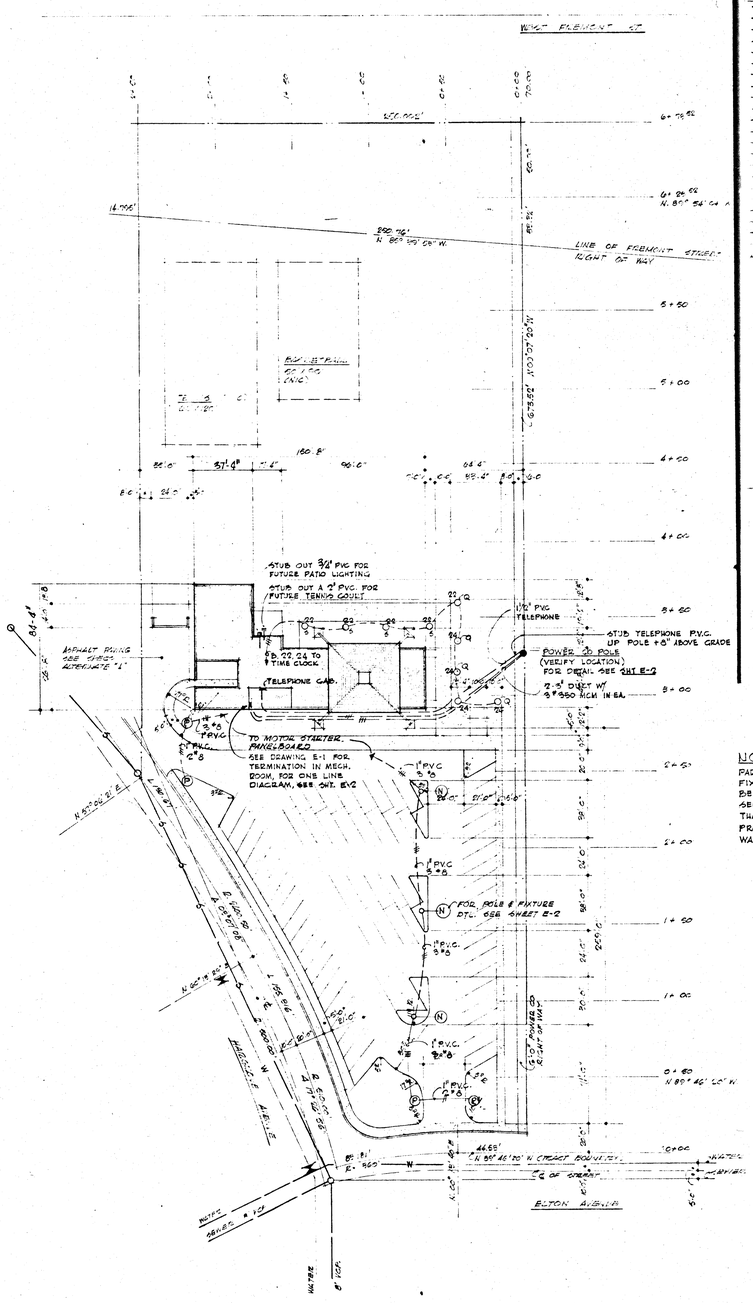

PLOT PLAN – ELECTRICAL
SCALE 1" = 40'-0"

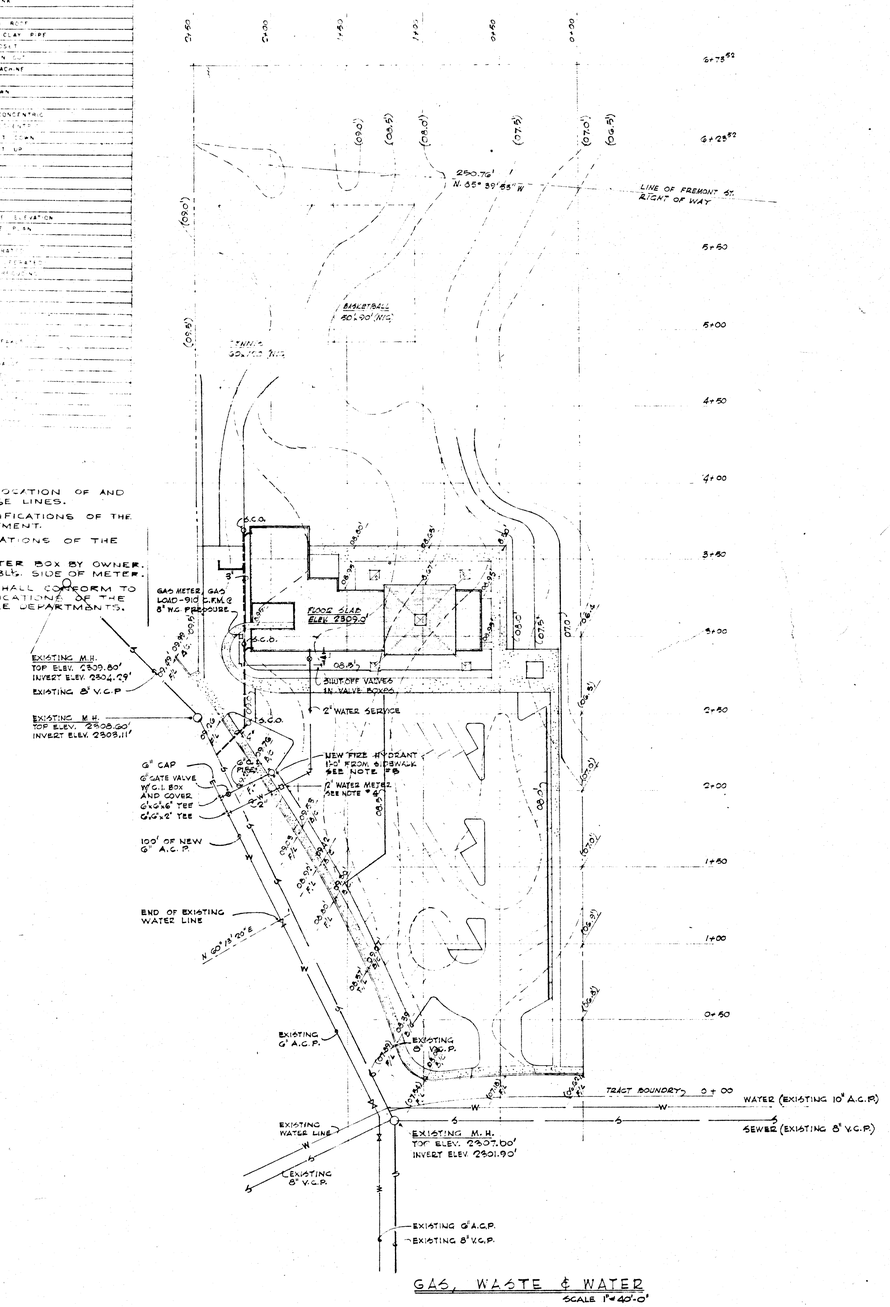

GAS, WASTE & WATER
SCALE 1" = 40'-0"

j | m
aia | james brooks mcdaniel · architect

job title ▷ RECREATION CENTER
CITY OF LAS VEGAS
LAS VEGAS, NEVADA.

drawn by	G.L.A. ROSC.
checked by	H.D.W.
job number	GG-16
scale	AS NOTED
date	MARCH 5 1965

no.	date	revision	by	chk
1				
2				
3				

513-27B
PLOT PLAN
AS-BUILT DRAWINGS MAY 5 1966

sheet title
sheet number EP-1
of