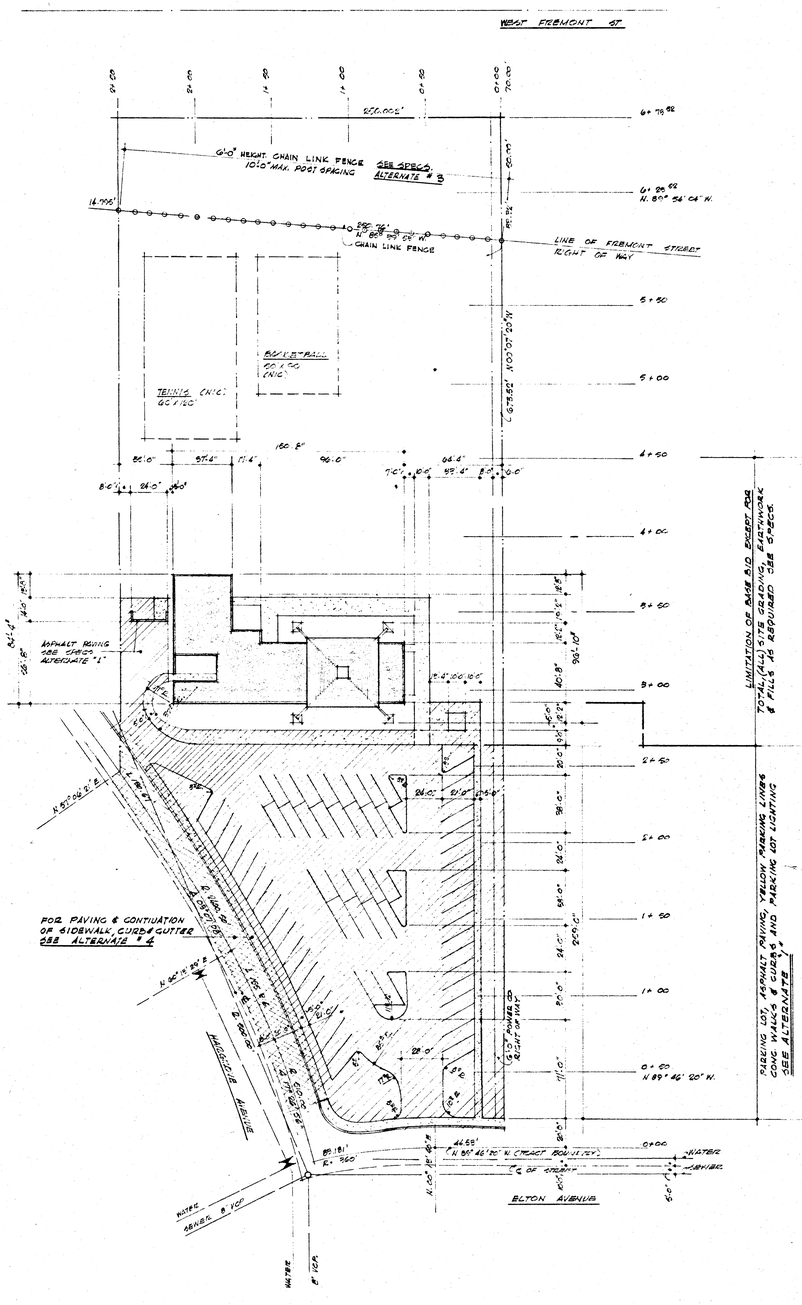

SITE PLAN
SCALE 1" = 40'-0"

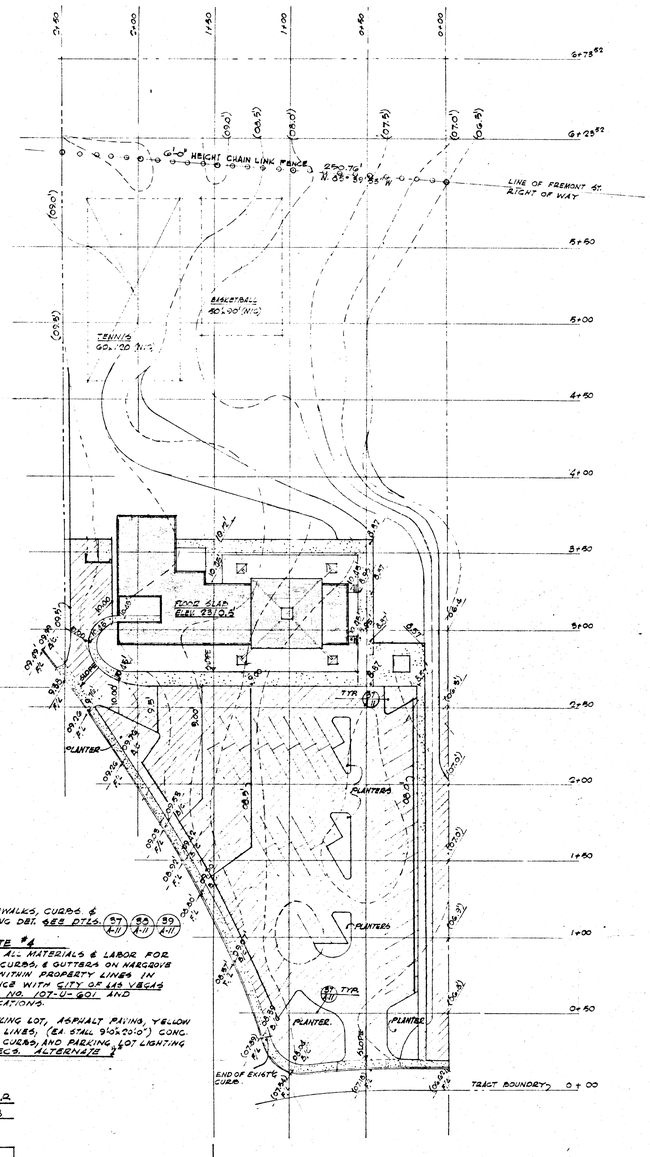

NOTE:
FOR SIDEWALKS, CURBS & AND PAVING DET. SEE DTLS. 5-7 4-11, 5-8 4-11, 5-9 4-11

ALTERNATE #4
PROVIDE ALL MATERIALS & LABOR FOR PAVING, CURBS, & GUTTERS ON NARCOVIS STREET WITHIN PROPERTY LINES IN ACCORDANCE WITH CITY OF LAS VEGAS DRAWING NO. 107-U-601 AND SPECIFICATIONS.

FOR PARKING LOT, ASPHALT PAVING, YELLOW PARKING LINES, (EA STALL 9'0x20'0") CONC. WALKS & CURBS, AND PARKING LOT LIGHTING SEE SPECS. ALTERNATE #4

CITY APPROVALS FOR
JOB NO 65-14 CITY CONTRACT NO CLV - 213

DEPT'S	SIGNED BY	DATE
DIRECTOR OF PUBLIC WORKS	[illegible]	1-25-65
PLANNING	[illegible]	[illegible]
FIRE	[illegible]	[illegible]
RECREATION	[illegible]	[illegible]
BUILDING		

NORTH

LEGEND
- - - - EXISTING GRADE LINES
——— FINISH GRADE LINES
( ) EXISTING ELEVATIONS
C.L.V. B.M. #469 ELEV. 2301.45
ALTERNATE #1
ALTERNATE #4

GRADING PLAN
SCALE 1" = 40'-0"

aia
james brooks mcdaniel · architect

Job title: RECREATION CENTER, CITY OF LAS VEGAS, LAS VEGAS NEVADA

drawn by W.W.M. & B.C.
checked by J.B.M.
job number 64-16
scale 1" = 40'-0"
date MARCH 5-65

no.	date	revision	by	chk
1	1-20-65	BLDG. LOCATION ON SITE	B.B.C.	
2	APRIL 26-65	POOL ELEV.	B.B.C.	
3				

513-27D 513-27D
SITE & GRADING PLAN
AS-BUILT DRAWINGS MAY 5 1966
sheet title
sheet number A-1
AS BUILT
of 13