


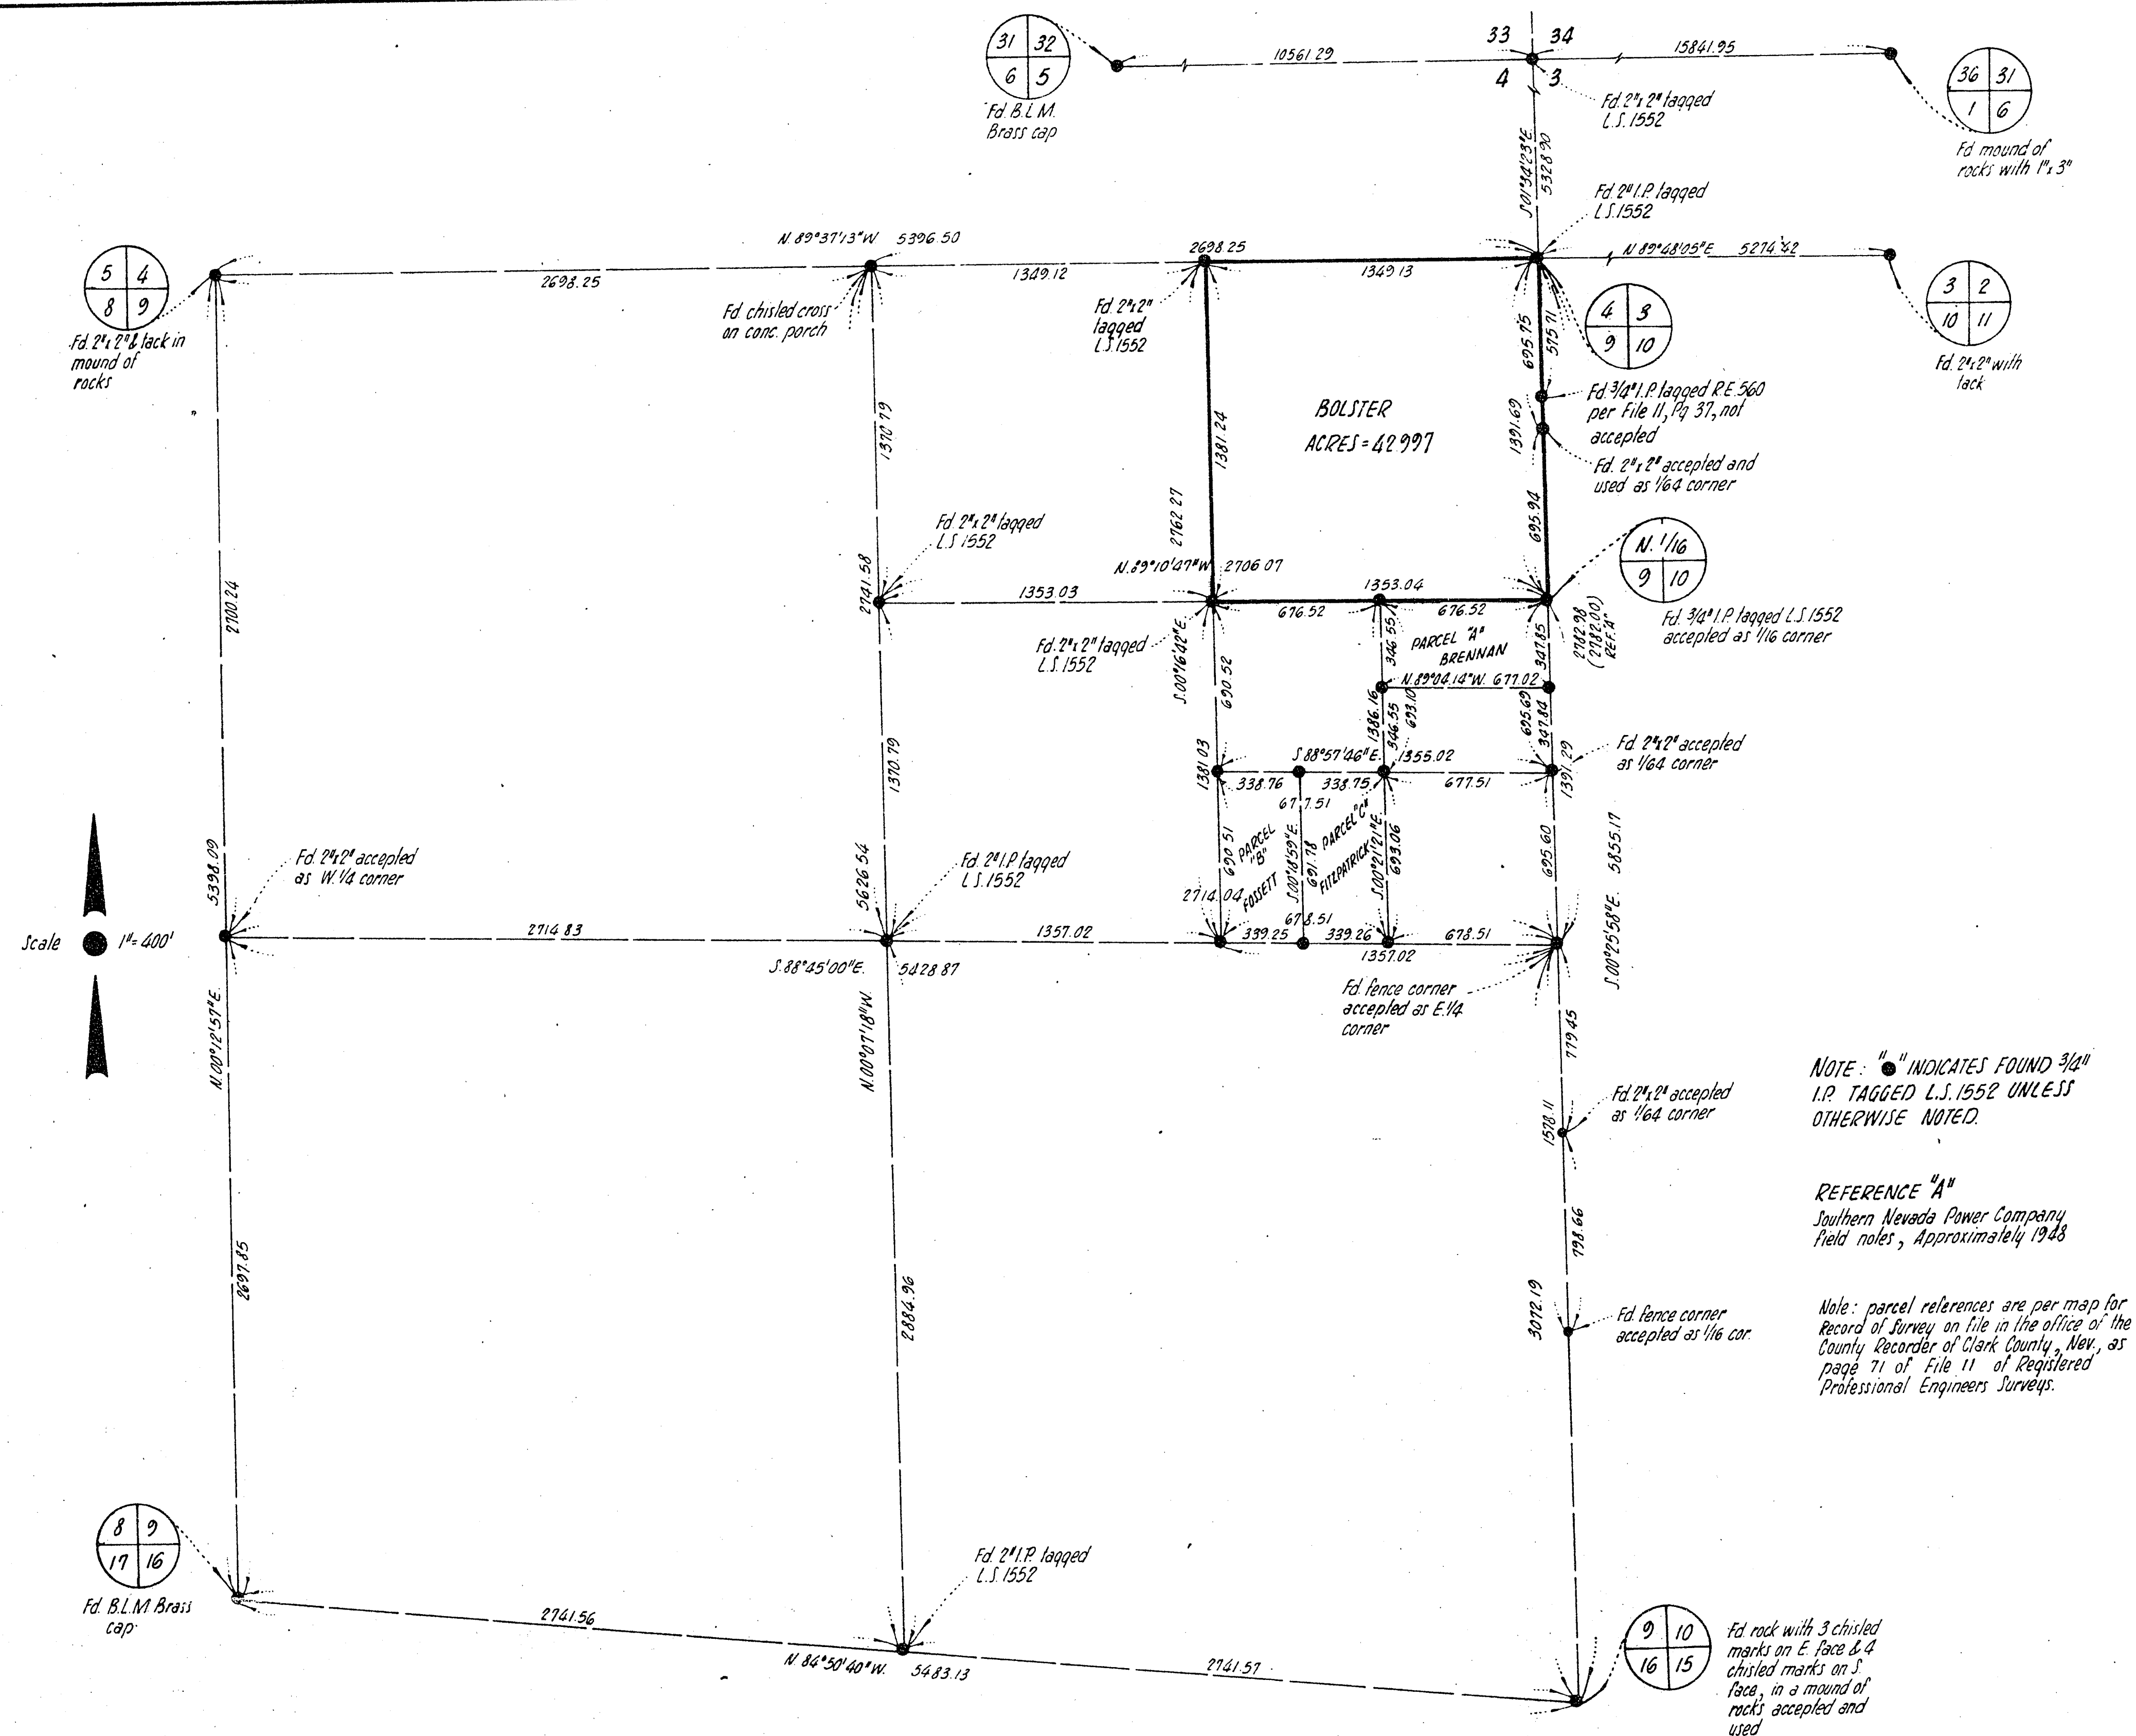

LEGAL DESCRIPTION

The N.E. 1/4 of the N.E. 1/4 of Section 9, T.19S., R.60E., M.D.M., Nevada, all within the County of Clark, State of Nevada.

BASIS OF BEARINGS

S.00°12'57\"/>

NOTE: "•" INDICATES FOUND 3/4\"/>

REFERENCE "A"
Southern Nevada Power Company
Field notes, Approximately 1948

Note: parcel references are per map for Record of Survey on file in the office of the County Recorder of Clark County, Nev., as page 71 of File 11 of Registered Professional Engineers Surveys.

SURVEYOR'S CERTIFICATE

I, James V. OLM, a duly Registered Land Surveyor in the State of Nevada, do hereby certify that the Survey of the land shown hereon was made under my direct supervision at the instance of Robert Bolster, owner of said parcel; the survey was completed on January 21, 1963 and that the points found and set are correctly shown hereon; this plat is not intended to be a subdivision.

James V. OLM
Registered Land Surveyor
Nevada, Certificate No. 1552

VOORHEIS-TRINDLE COMPANY OF NEVADA

1128 FREMONT, LAS VEGAS, NEVADA, EV53566

PORTION OF THE N.E. 1/4 OF THE N.E. 1/4 OF SECTION 9, T.19S., R.60E., M.D.M., NEV.

SCALE
1" = 400'

DRAWN BY
L. duLuard

MAP FOR RECORD OF SURVEY FOR ROBERT BOLSTER

DATE
JAN. 21, 1963

DRAWING NO.
W.O. 192

JAMES V. OLM
1-24-63 H. 23P
12 30