

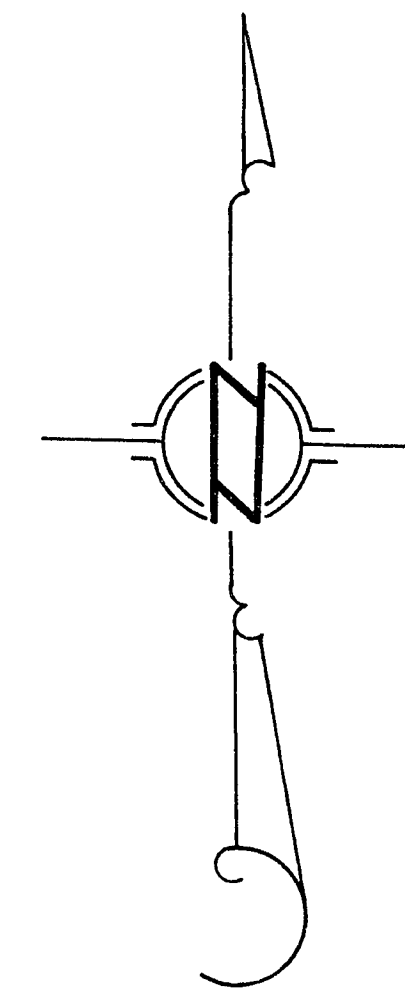


PORTION N.W. 1/4 OF SEC. 2, T.20S., R.60E., M.D.B.&M.
CLARK COUNTY, NEVADA

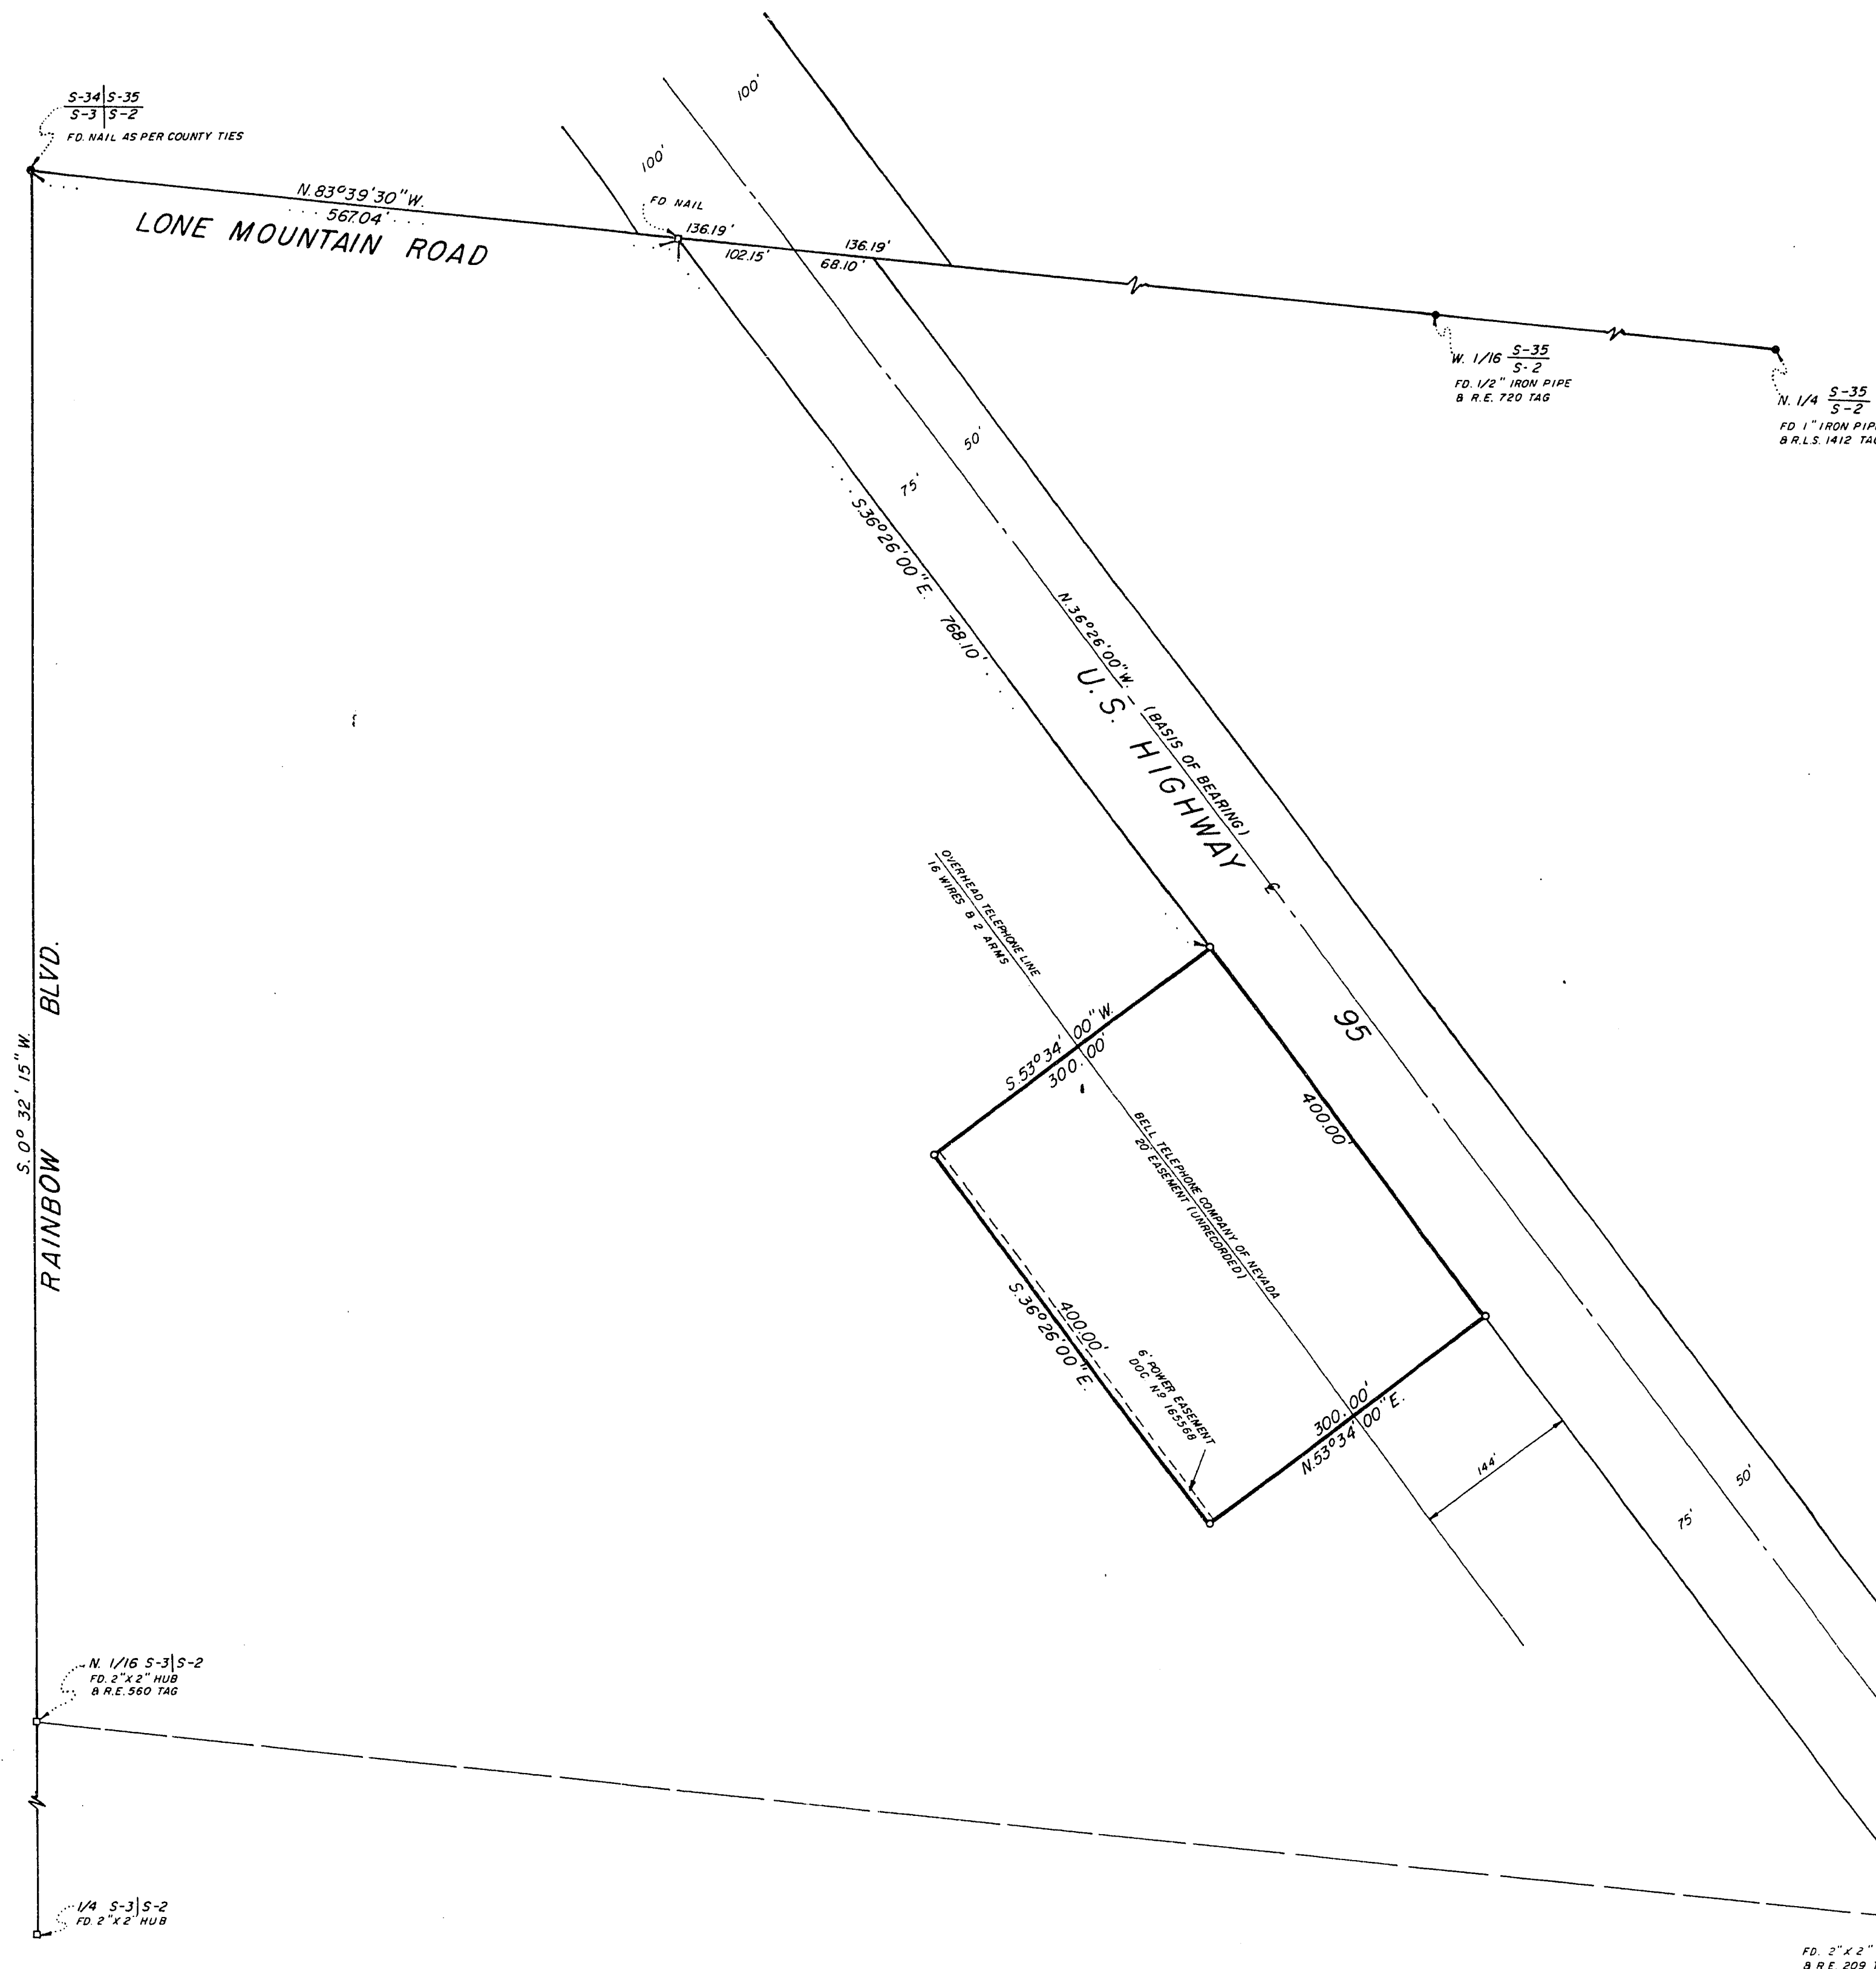

-SCALE: 1"=100'-

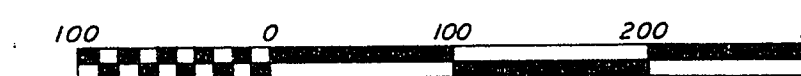

- NOTE -

BASIS OF BEARING ($N 36^{\circ}26'00'' W$) CENTER LINE OF HIGHWAY 93-95
RECORDED FILE 1, PAGE 46, OFFICE OF THE COUNTY RECORDER, CLARK
COUNTY, NEVADA.

-LEGEND-

○ INDICATES 3/4" IRON PIPE WITH R.C.E. 1586 TAG, SET AS SHOWN HEREON.

-ENGINEER'S CERTIFICATE-

I, BENNETT J. VASEY, A DULY REGISTERED PROFESSIONAL CIVIL ENGINEER AND
LICENSED LAND SURVEYOR, NEVADA N°1586, AS AGENT FOR TYSON ENGINEERING
COMPANY, DO HEREBY CERTIFY THAT THIS MAP IS A TRUE AND CORRECT PLAT OF
THE LAND SURVEYED BY ME AT THE INSTANCE OF MC RENOCK INC. AND DESCRIBED
AS A PORTION OF GOVERNMENT LOT 4 IN SECTION 2, T.20S., R.60E., M.D.B.&M., CLARK
COUNTY, NEVADA AND COMPLETED ON THIS 10TH DAY OF JULY, 1963.

Bennett J. Vasey
BENNETT J. VASEY, REG. PROF. CIVIL ENG. & LICENSED LAND SURVEYOR NEVADA N°1586

376647
L. E. Tyson
8-9-63 1:24 P.
13 52
467
250 J.S.

MAP FOR RECORD OF SURVEY
FOR
MC RENOCK INC.
PORTION OF GOVERNMENT LOT 4, SEC. 2, T.20S., R.60E.
M. D. B. & M.
CLARK COUNTY, NEVADA