


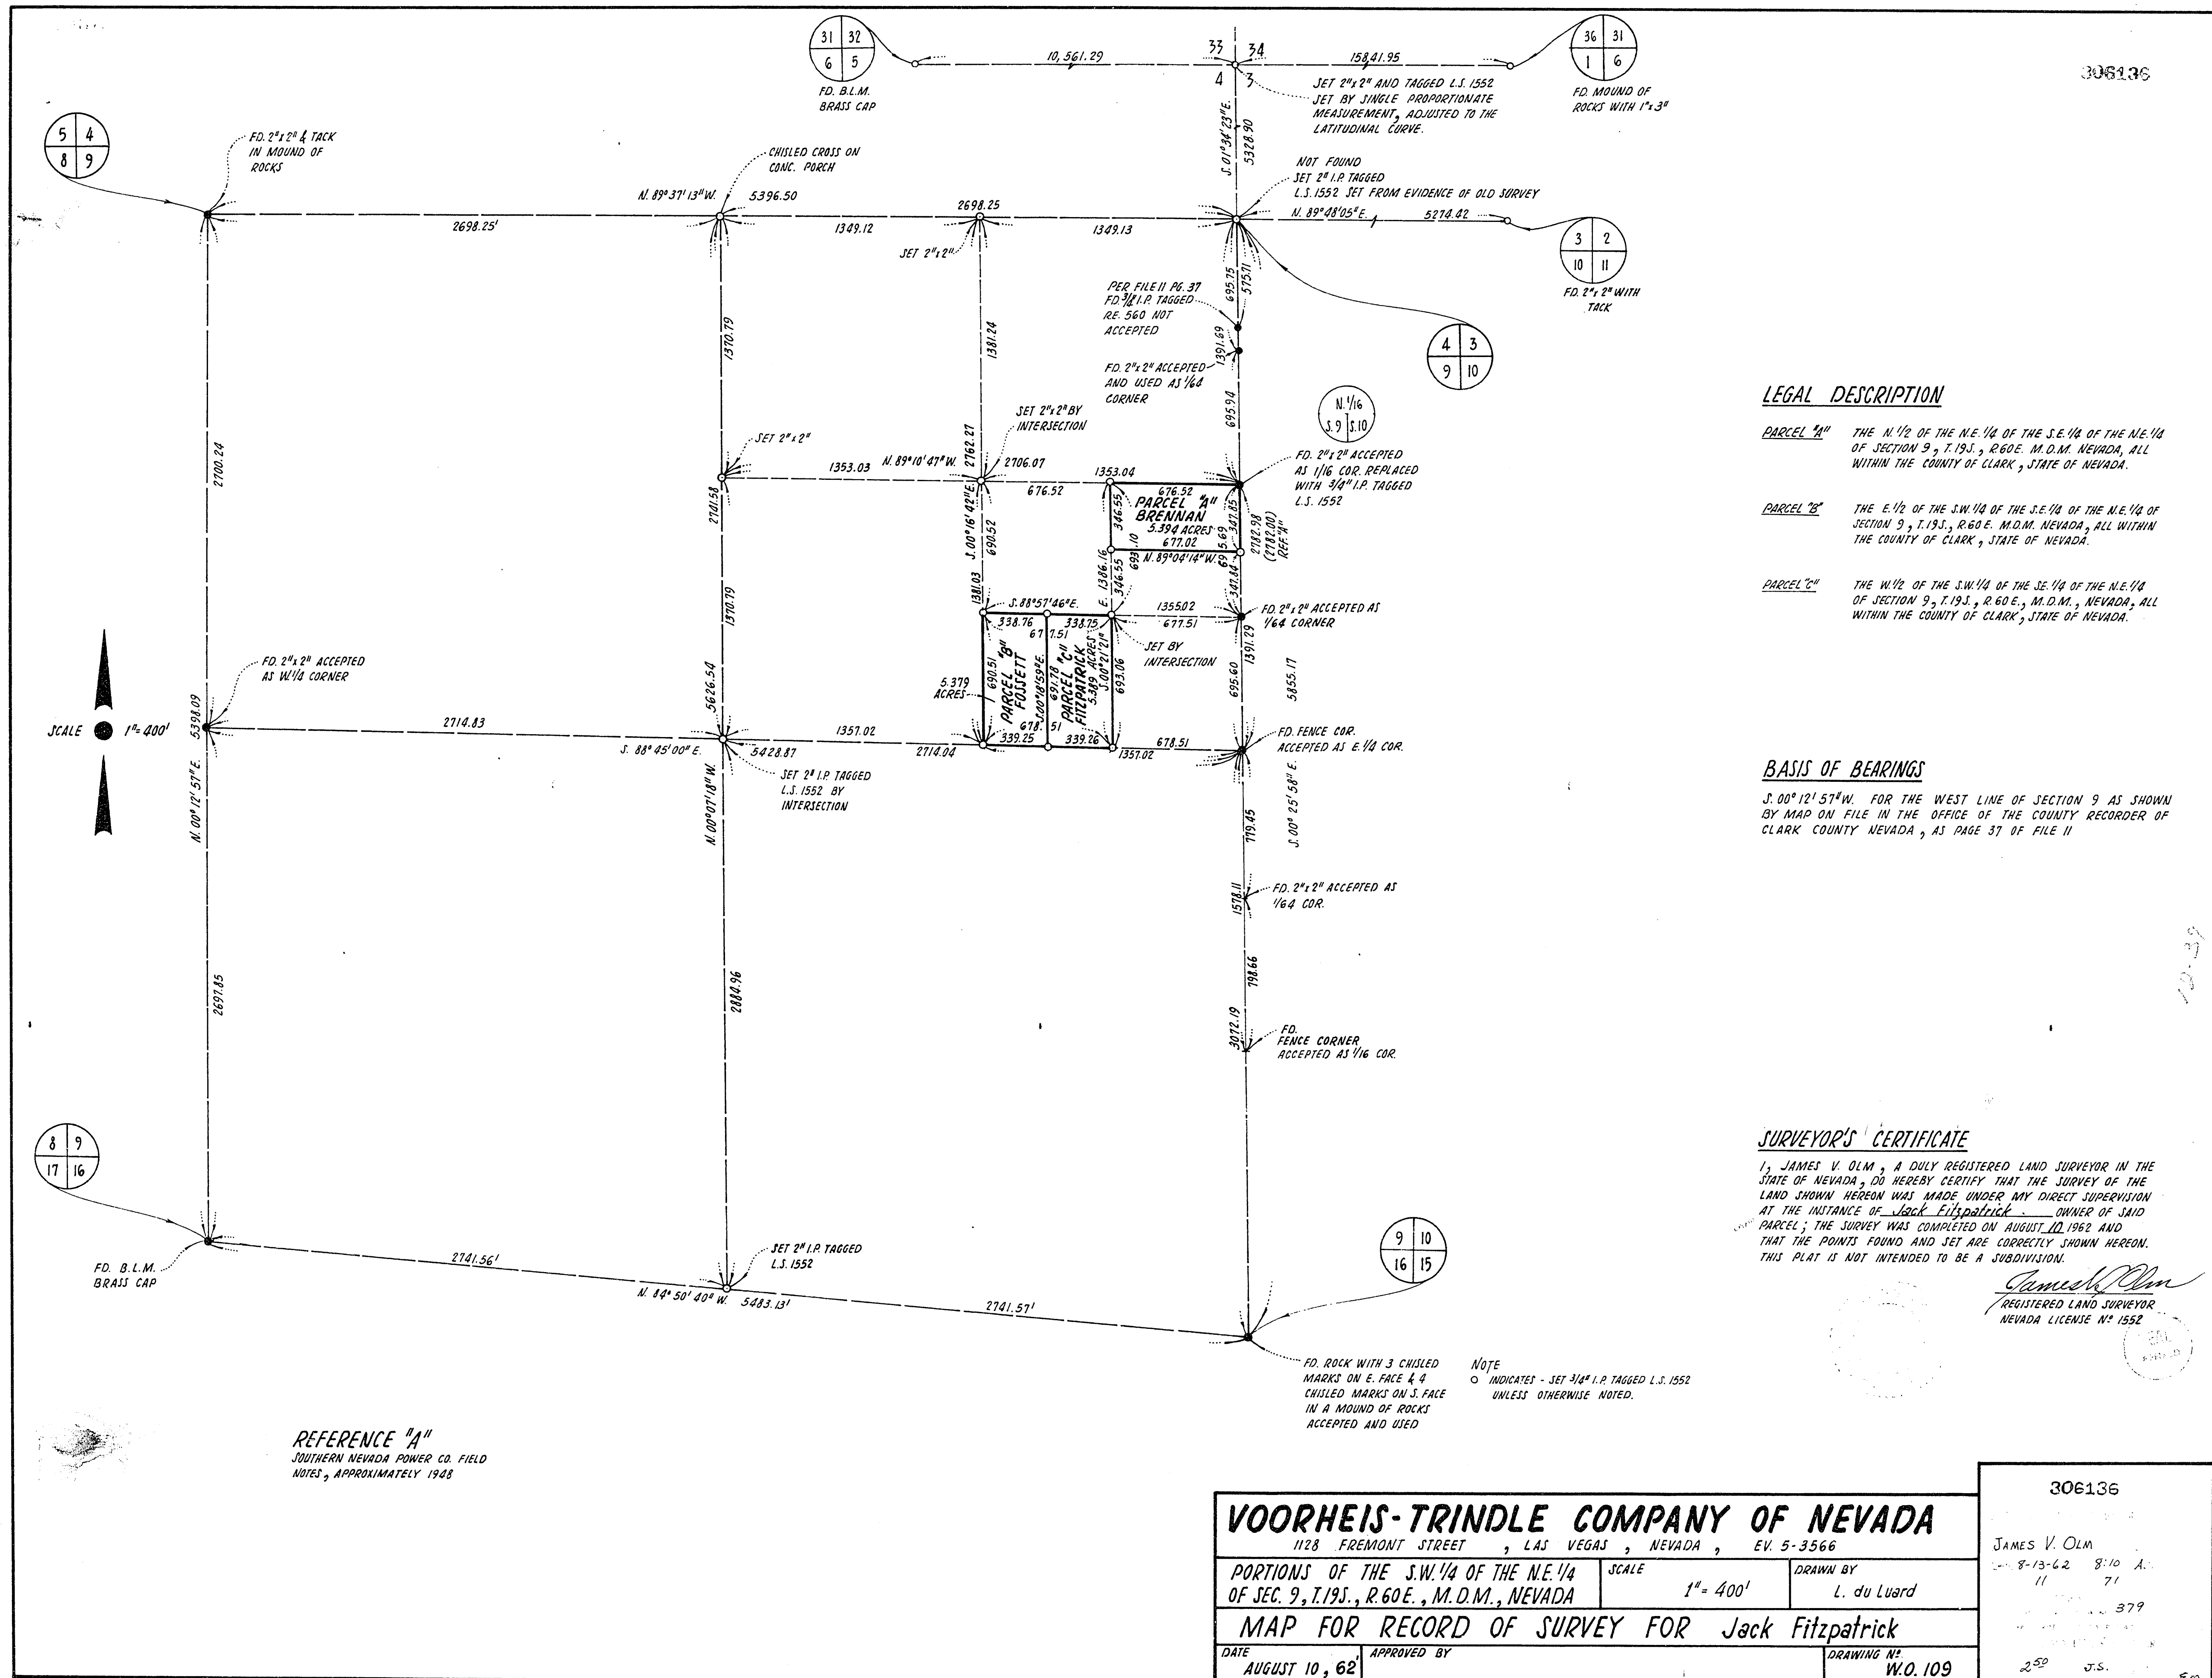

LEGAL DESCRIPTION

PARCEL "A" THE N. 1/2 OF THE N.E. 1/4 OF THE S.E. 1/4 OF THE N.E. 1/4 OF SECTION 9, T. 19S., R. 60E., M.D.M., NEVADA, ALL WITHIN THE COUNTY OF CLARK, STATE OF NEVADA.

PARCEL "B" THE E. 1/2 OF THE S.W. 1/4 OF THE S.E. 1/4 OF THE N.E. 1/4 OF SECTION 9, T. 19S., R. 60E., M.D.M., NEVADA, ALL WITHIN THE COUNTY OF CLARK, STATE OF NEVADA.

PARCEL "C" THE W. 1/2 OF THE S.W. 1/4 OF THE S.E. 1/4 OF THE N.E. 1/4 OF SECTION 9, T. 19S., R. 60E., M.D.M., NEVADA, ALL WITHIN THE COUNTY OF CLARK, STATE OF NEVADA.

BASIS OF BEARINGS

S. 00° 12' 57" W. FOR THE WEST LINE OF SECTION 9 AS SHOWN BY MAP ON FILE IN THE OFFICE OF THE COUNTY RECORDER OF CLARK COUNTY NEVADA, AS PAGE 37 OF FILE 11

SURVEYOR'S CERTIFICATE

I, JAMES V. OLM, A DULY REGISTERED LAND SURVEYOR IN THE STATE OF NEVADA, DO HEREBY CERTIFY THAT THE SURVEY OF THE LAND SHOWN HEREON WAS MADE UNDER MY DIRECT SUPERVISION AT THE INSTANCE OF Jack Fitzpatrick, OWNER OF SAID PARCEL; THE SURVEY WAS COMPLETED ON AUGUST 10, 1962 AND THAT THE POINTS FOUND AND SET ARE CORRECTLY SHOWN HEREON. THIS PLAT IS NOT INTENDED TO BE A SUBDIVISION.

James V. Olm
REGISTERED LAND SURVEYOR
NEVADA LICENSE NO. 1552

NOTE
O INDICATES - SET 3/4" I.P. TAGGED L.S. 1552
UNLESS OTHERWISE NOTED.

VOORHEIS-TRINDLE COMPANY OF NEVADA

1128 FREMONT STREET, LAS VEGAS, NEVADA, EV. 5-3566

PORTIONS OF THE S.W. 1/4 OF THE N.E. 1/4 OF SEC. 9, T. 19S., R. 60E., M.D.M., NEVADA

SCALE
1" = 400'

DRAWN BY
L. du Luard

MAP FOR RECORD OF SURVEY FOR Jack Fitzpatrick

DATE
AUGUST 10, 62

APPROVED BY

DRAWING NO.
W.O. 109

306136

JAMES V. OLM

8-13-62 8:10 A.
11 71

379

250 J.S. Em

FILE 11 PAGE 71

055-34