
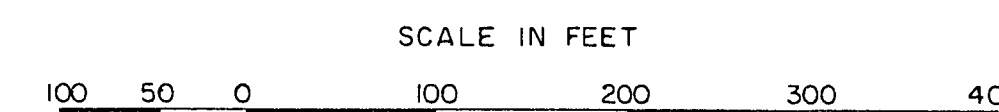
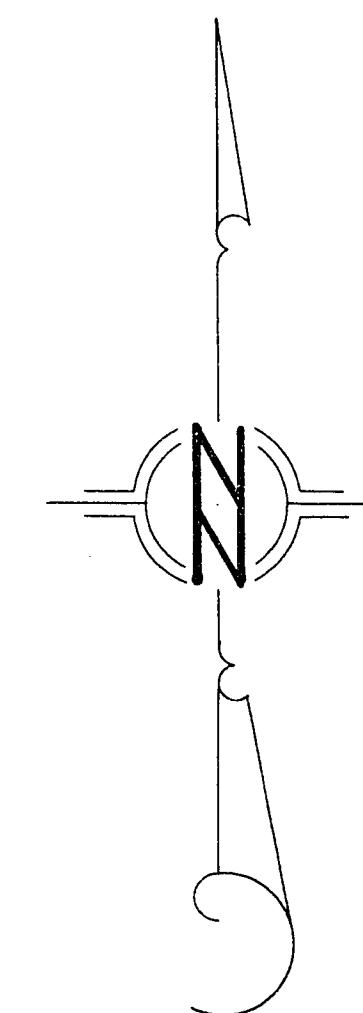


N.E. 1/4, N.W. 1/4, SEC. 18, T. 19 S., R. 60 E.

M.D.B. & M.

CLARK COUNTY, NEVADA

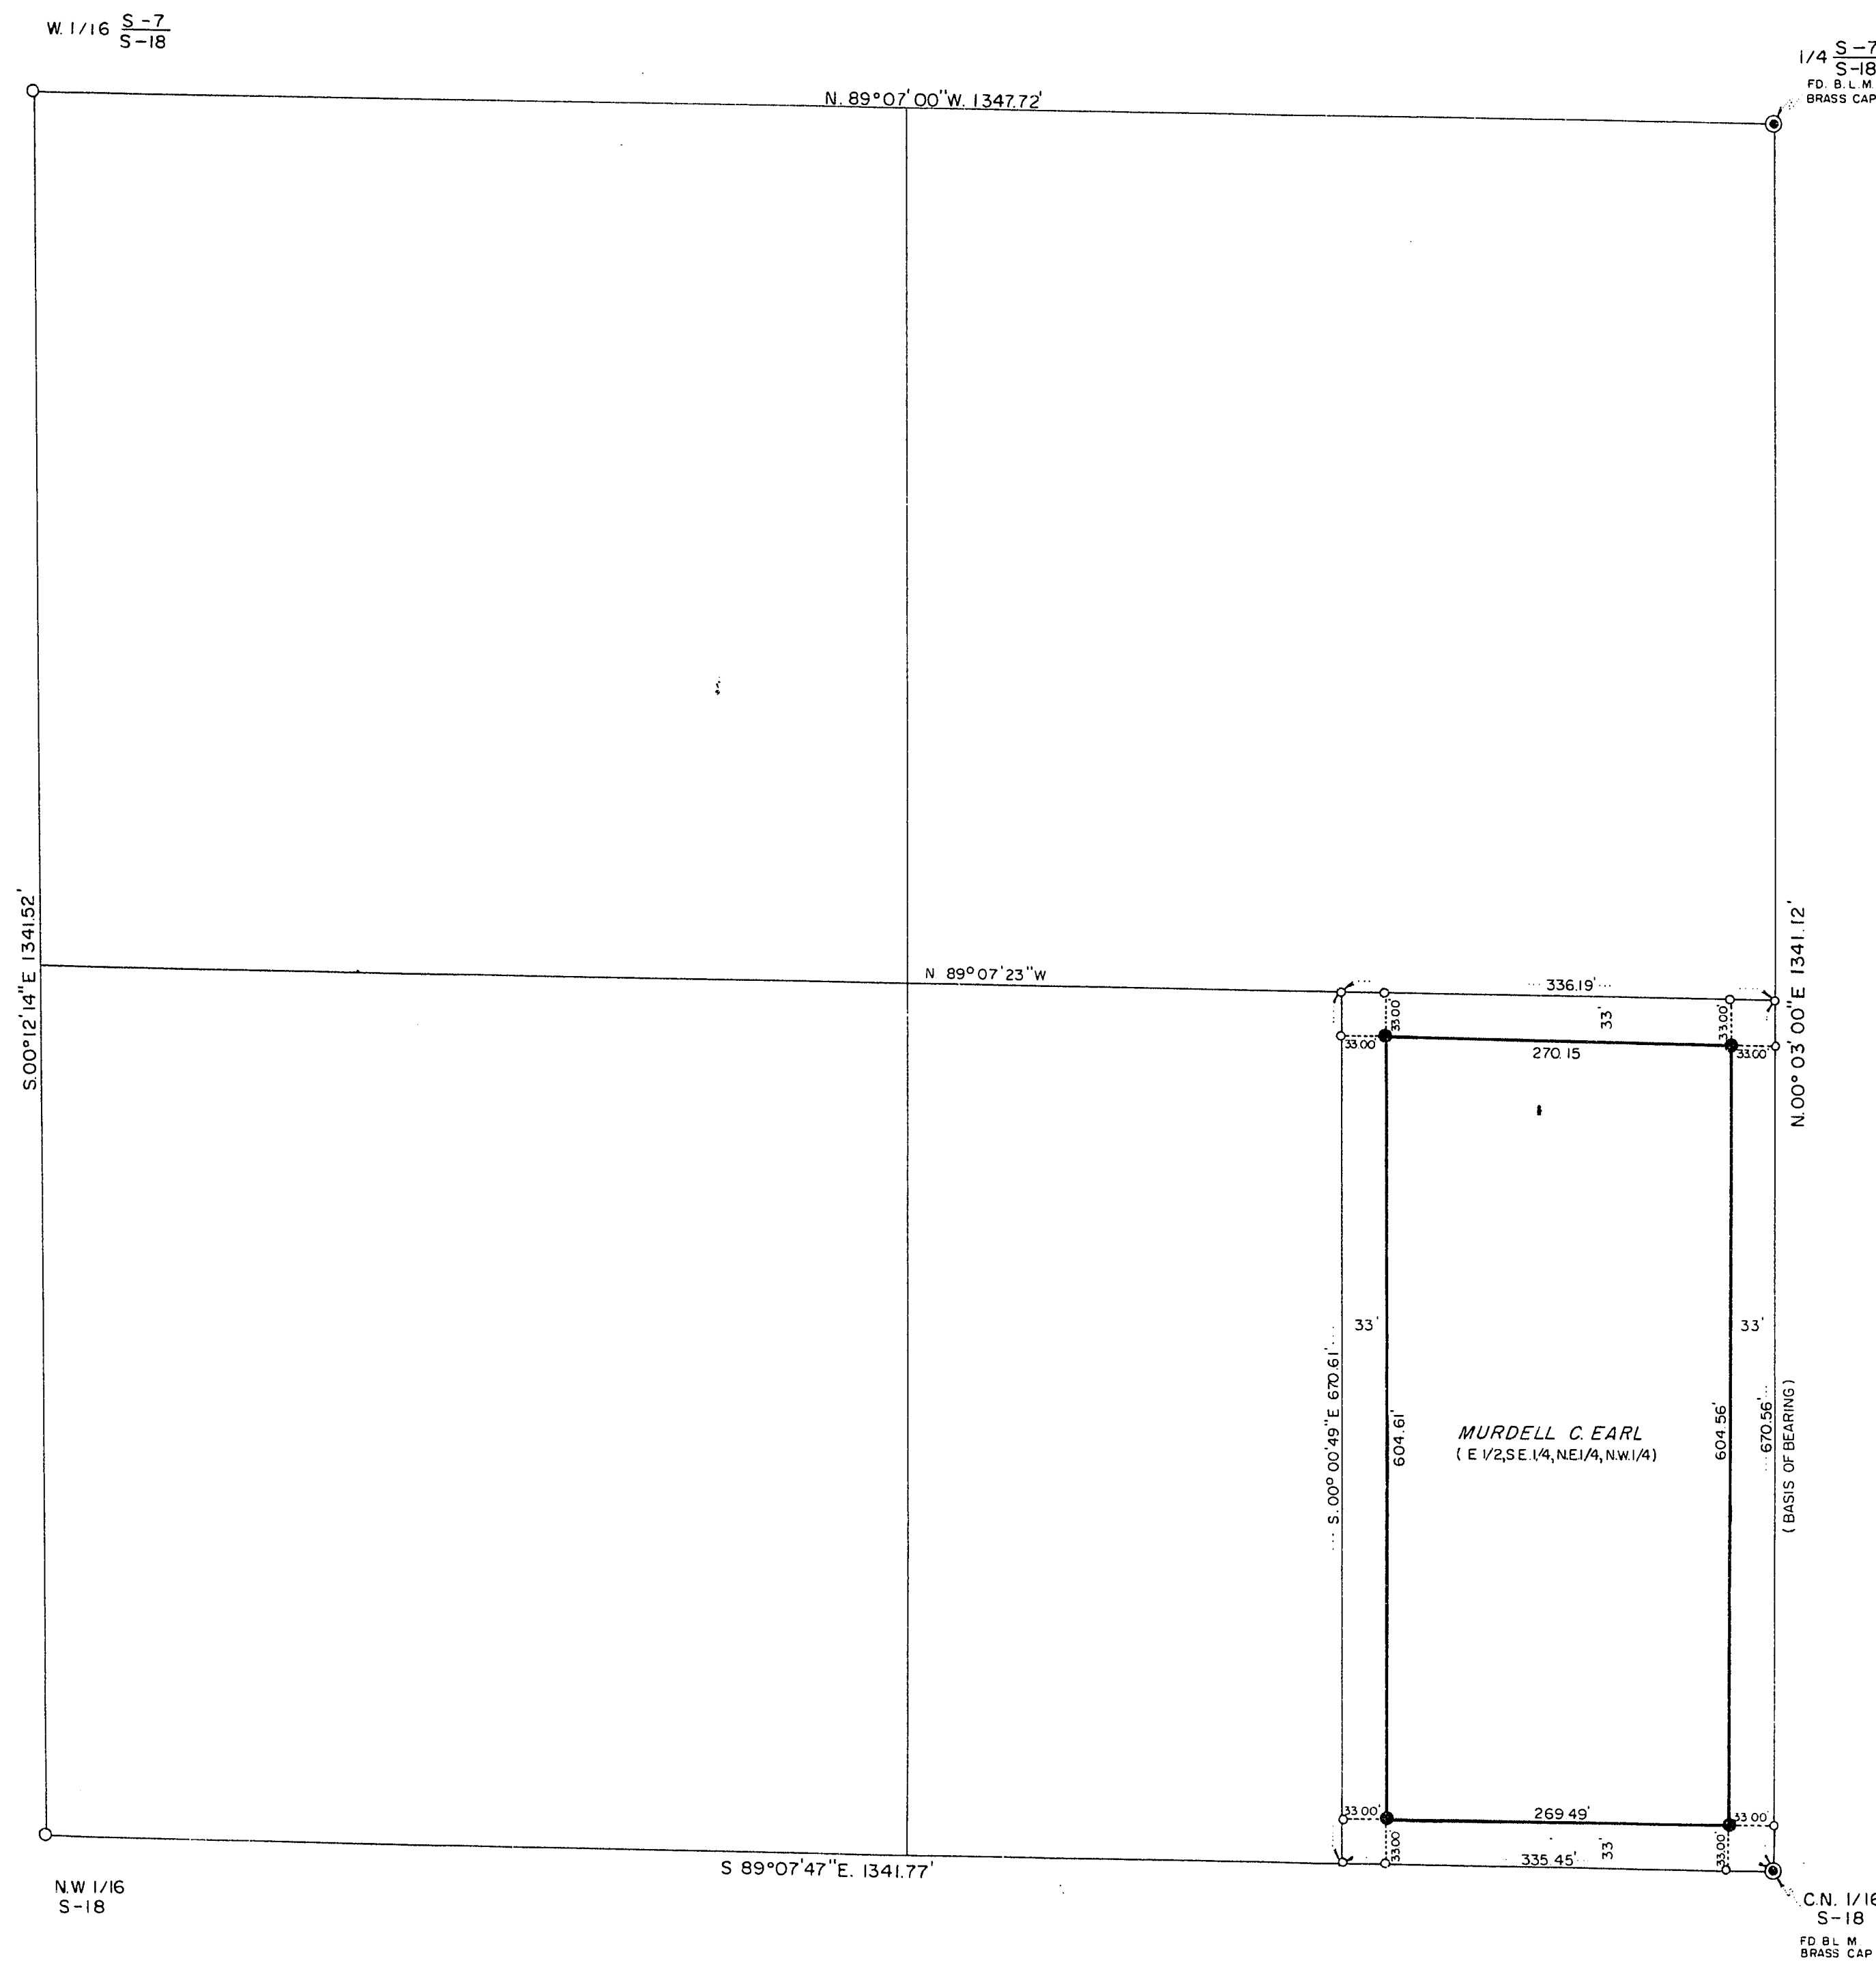

NOTE

BASIS OF BEARING: (N. 00° 03' 00\" E.) EAST LINE OF N.E. 1/4, N.W. 1/4, SEC. 18, T. 19 S., R. 60 E. M.D.B. & M. DEPENDENT RESURVEY OF SEC. 18, BY UNITED STATES DEPARTMENT OF THE INTERIOR, BUREAU OF LAND MANAGEMENT.


LEGEND

- INDICATES 3/4\" IRON PIPE TAGGED R.E. 560, SET AS SHOWN HEREON.
- INDICATES 2\" X 2\" HUB & TACK, SET AS SHOWN HEREON.

ENGINEER'S CERTIFICATE

I, L. E. TYSON, A DULY REGISTERED PROFESSIONAL CIVIL ENGINEER AND LICENSED LAND SURVEYOR, NEVADA NO. 560, DO HEREBY CERTIFY THAT THIS MAP IS A TRUE AND CORRECT PLAT OF THE LAND SURVEYED BY ME AT THE INSTANCE OF MURDELL C. EARL AND DESCRIBED AS A PORTION OF THE N.E. 1/4 OF THE NW 1/4, OF SEC. 18, T. 19 S., R. 60 E., M.D.B. & M., CLARK COUNTY, NEVADA, AND THIS SURVEY WAS COMPLETED THIS 26 TH. DAY OF JUNE, 1963. THIS SURVEY IS NOT A SUBDIVISION AS DEFINED IN THE PLANNING & ZONING LAW AS SHOWN IN 1943-49 SUPP. NEVADA COMPILED LAWS.

L. E. TYSON, REG. PROF. CIV. ENG. & LICENSED LAND SURVEYOR, NEV. NO. 560

 

374557

MURDELL C. EARL
7-31-63 1:30 P.
13 48
465
250 J.S.

MAP FOR RECORD OF SURVEY
FOR
MURDELL C. EARL
POR. N.E. 1/4, N.W. 1/4 SEC. 18, T. 19 S., R. 60 E.
M.D.B. & M.
CLARK COUNTY, NEVADA