
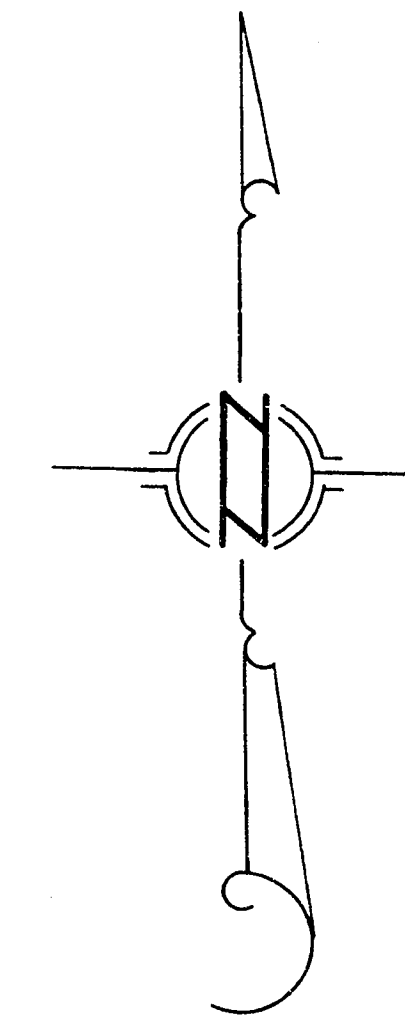


N.W. 1/4, S.E. 1/4 OF SECTION 31, T.19S., R.60E., M.D.B. & M.
CLARK COUNTY, NEVADA

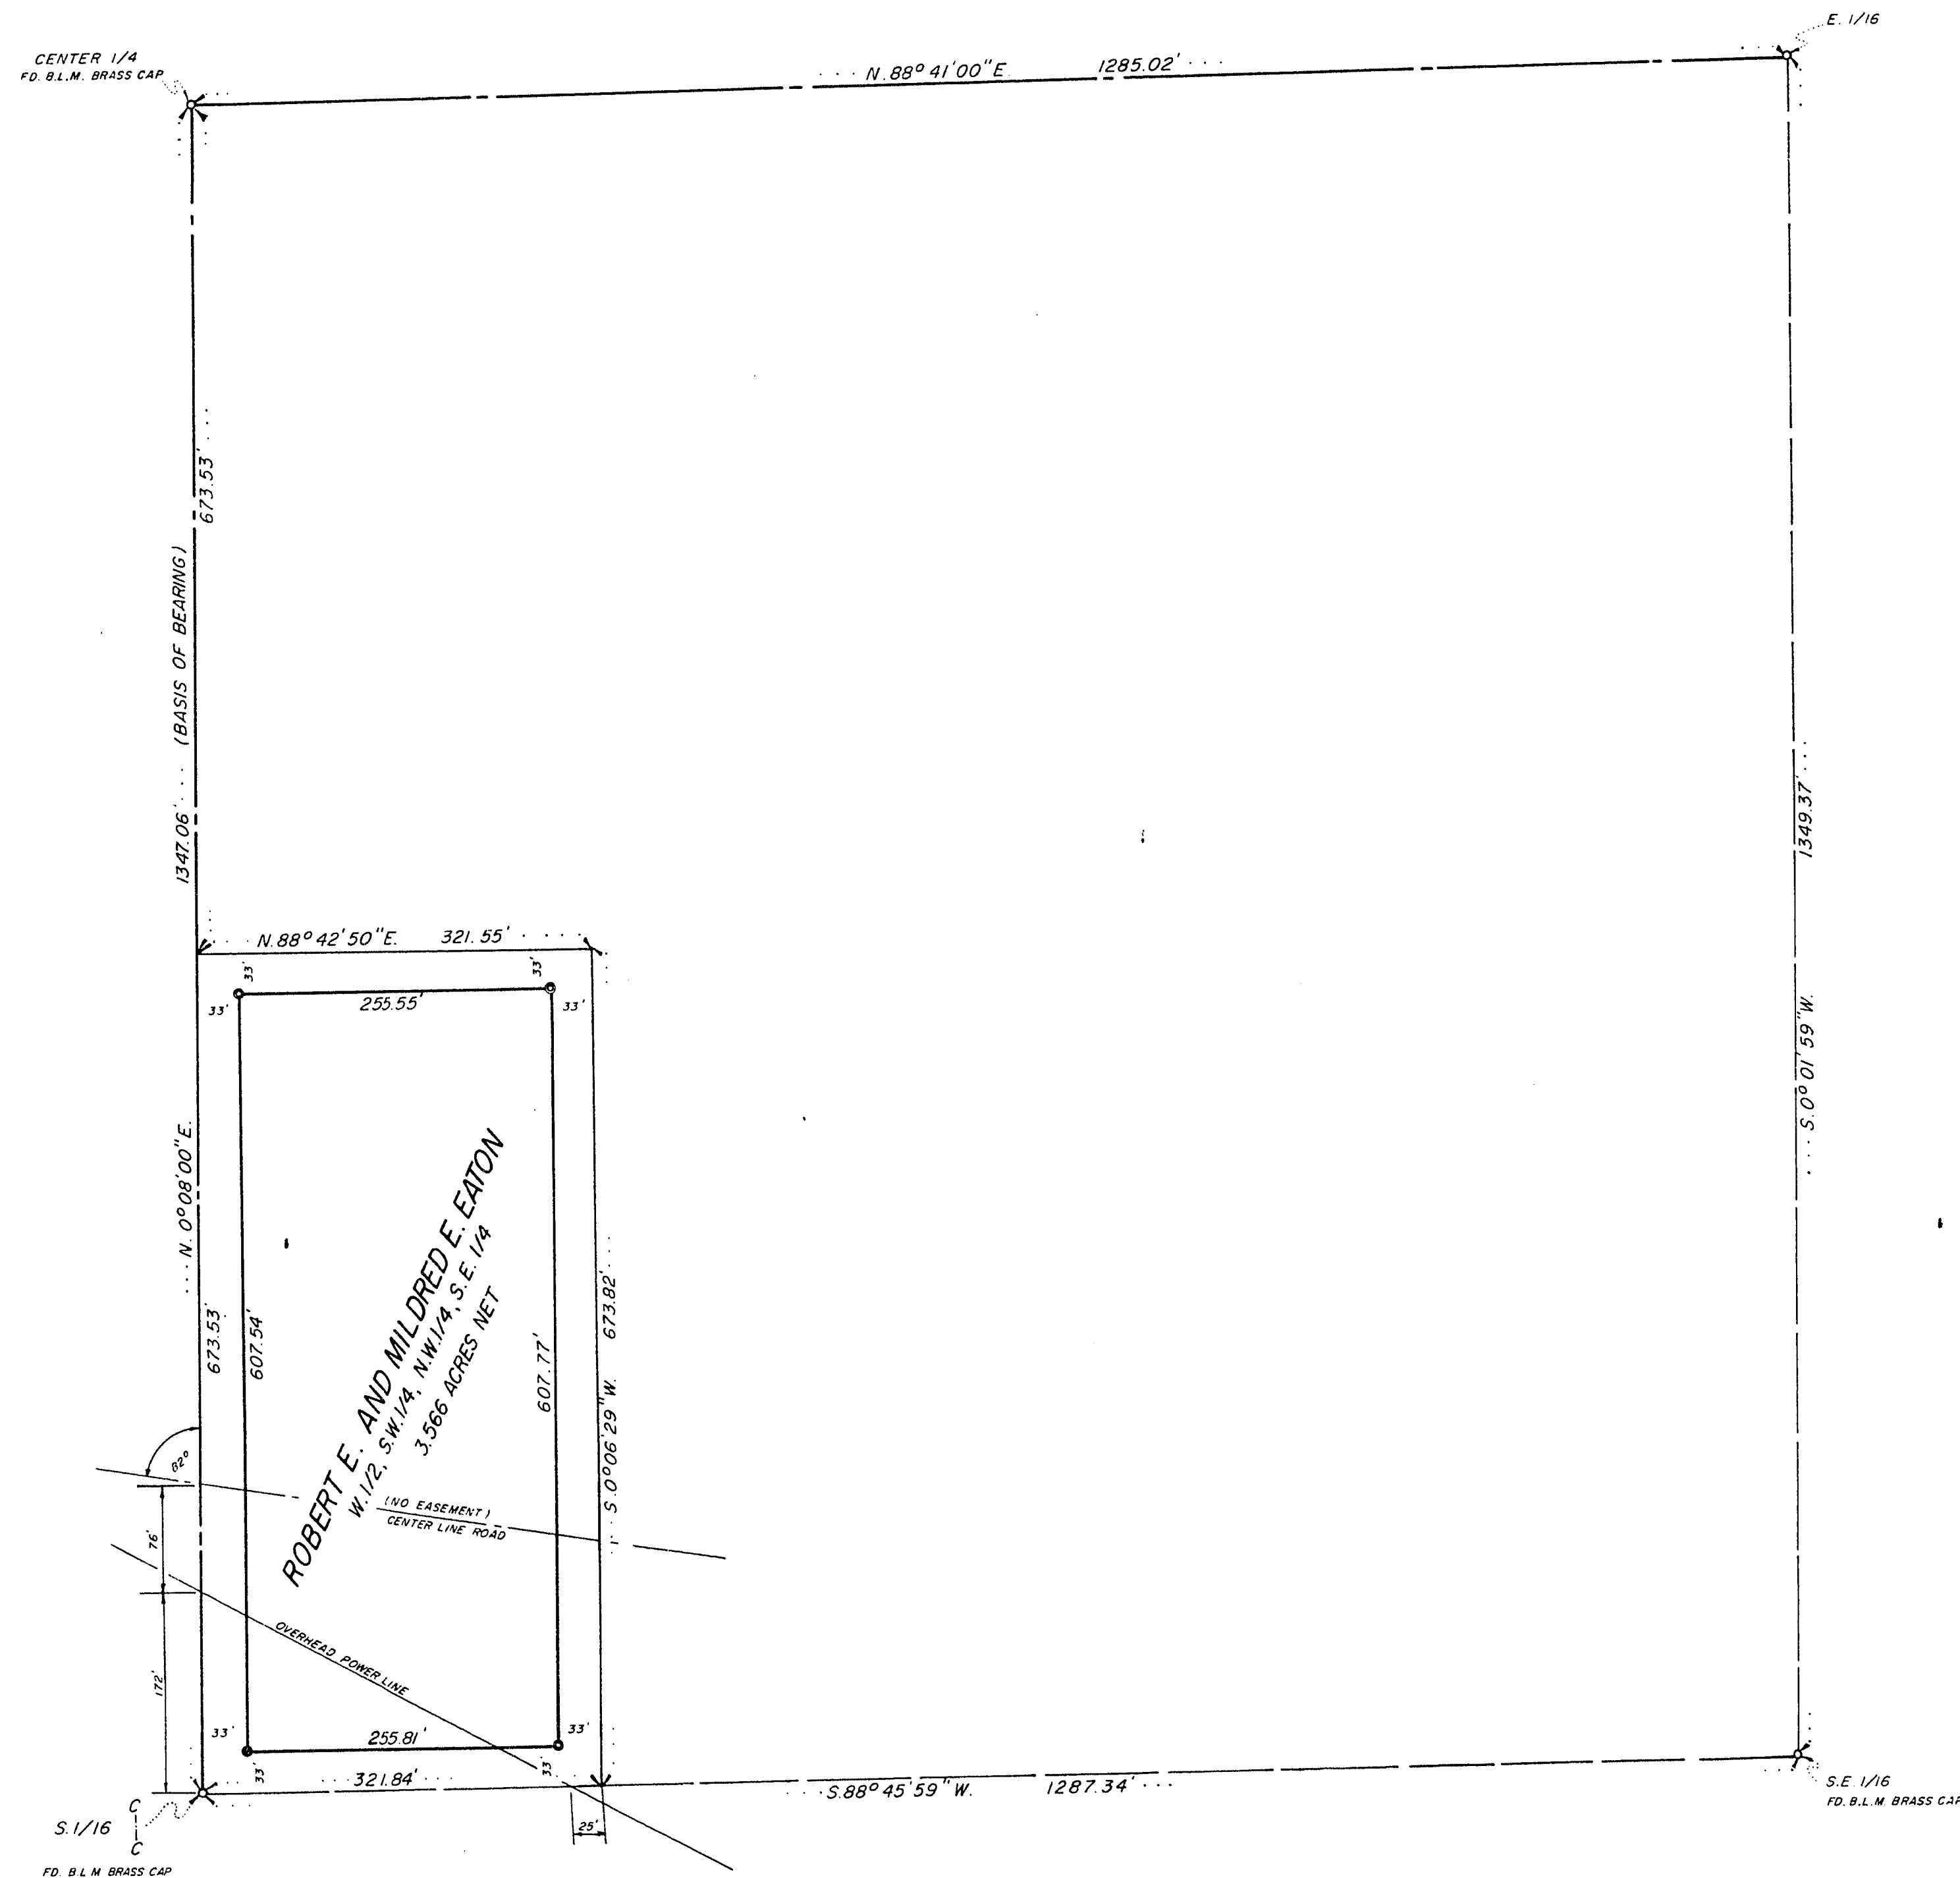

-SCALE: 1"=100'-

- NOTES -
BASIS OF BEARING: (N. 0° 08' 00" E.) WEST LINE OF S.E. 1/4 OF SEC. 31, T.19S., R.60E., M.D.B. & M., CLARK COUNTY, NEVADA. SUBDIVISION OF SECTIONS, UNITED STATES DEPARTMENT OF THE INTERIOR, BUREAU OF LAND MANAGEMENT.

-LEGEND-
⊙ = INDICATES 3/4" IRON PIPE WITH TAG MARKED R.C.E. 1586, SET AS SHOWN HEREON.
● = INDICATES 1/2" IRON PIPE WITH TAG MARKED R.C.E. 1586, SET AS SHOWN HEREON.

-ENGINEER'S CERTIFICATE-
I, BENNETT J. VASEY, A DULY REGISTERED PROFESSIONAL CIVIL ENGINEER AND LICENSED LAND SURVEYOR, NEVADA N° 1586, AS AGENT FOR TYSON ENGINEERING COMPANY, DO HEREBY CERTIFY THAT THIS MAP IS A TRUE AND CORRECT PLAT OF THE LAND SURVEYED BY ME AT THE INSTANCE OF ROBERT E. AND MILDRED E. EATON AND DESCRIBED AS THE W. 1/2, S.W. 1/4, N.W. 1/4, S.E. 1/4 OF SEC. 31, T.19S., R.60E., M.D.B. & M., CLARK COUNTY, NEVADA AND COMPLETED ON THIS 2ND DAY OF SEPTEMBER, 1963.

Bennett J. Vasey
BENNETT J. VASEY, REG. PROF. CIVIL ENG. & LICENSED LAND SURVEYOR NEVADA N° 1586



393345

Tyson Engineering Co.
10-29-63 8:19 AM
FILE 13 92
488
2 50 ms

MAP FOR RECORD OF SURVEY
FOR
ROBERT E. AND MILDRED E. EATON
PORTION N.W. 1/4, S.E. 1/4 OF SEC. 31, T.19S., R.60E.
M.D.B. & M.
CLARK COUNTY, NEVADA