



POR. NW 1/4 S.W. 1/4, SEC. 32, T. 19 S., R. 60 E.
M.D.B. & M.
CLARK COUNTY, NEVADA

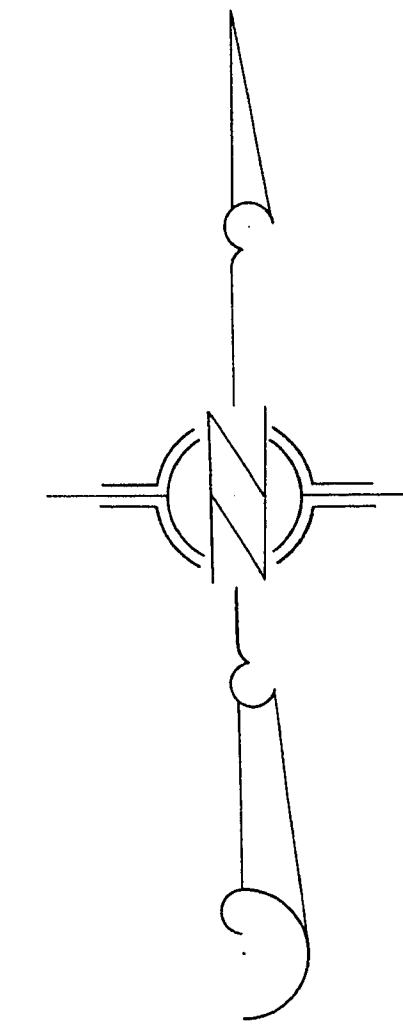

—SCALE IN FEET—

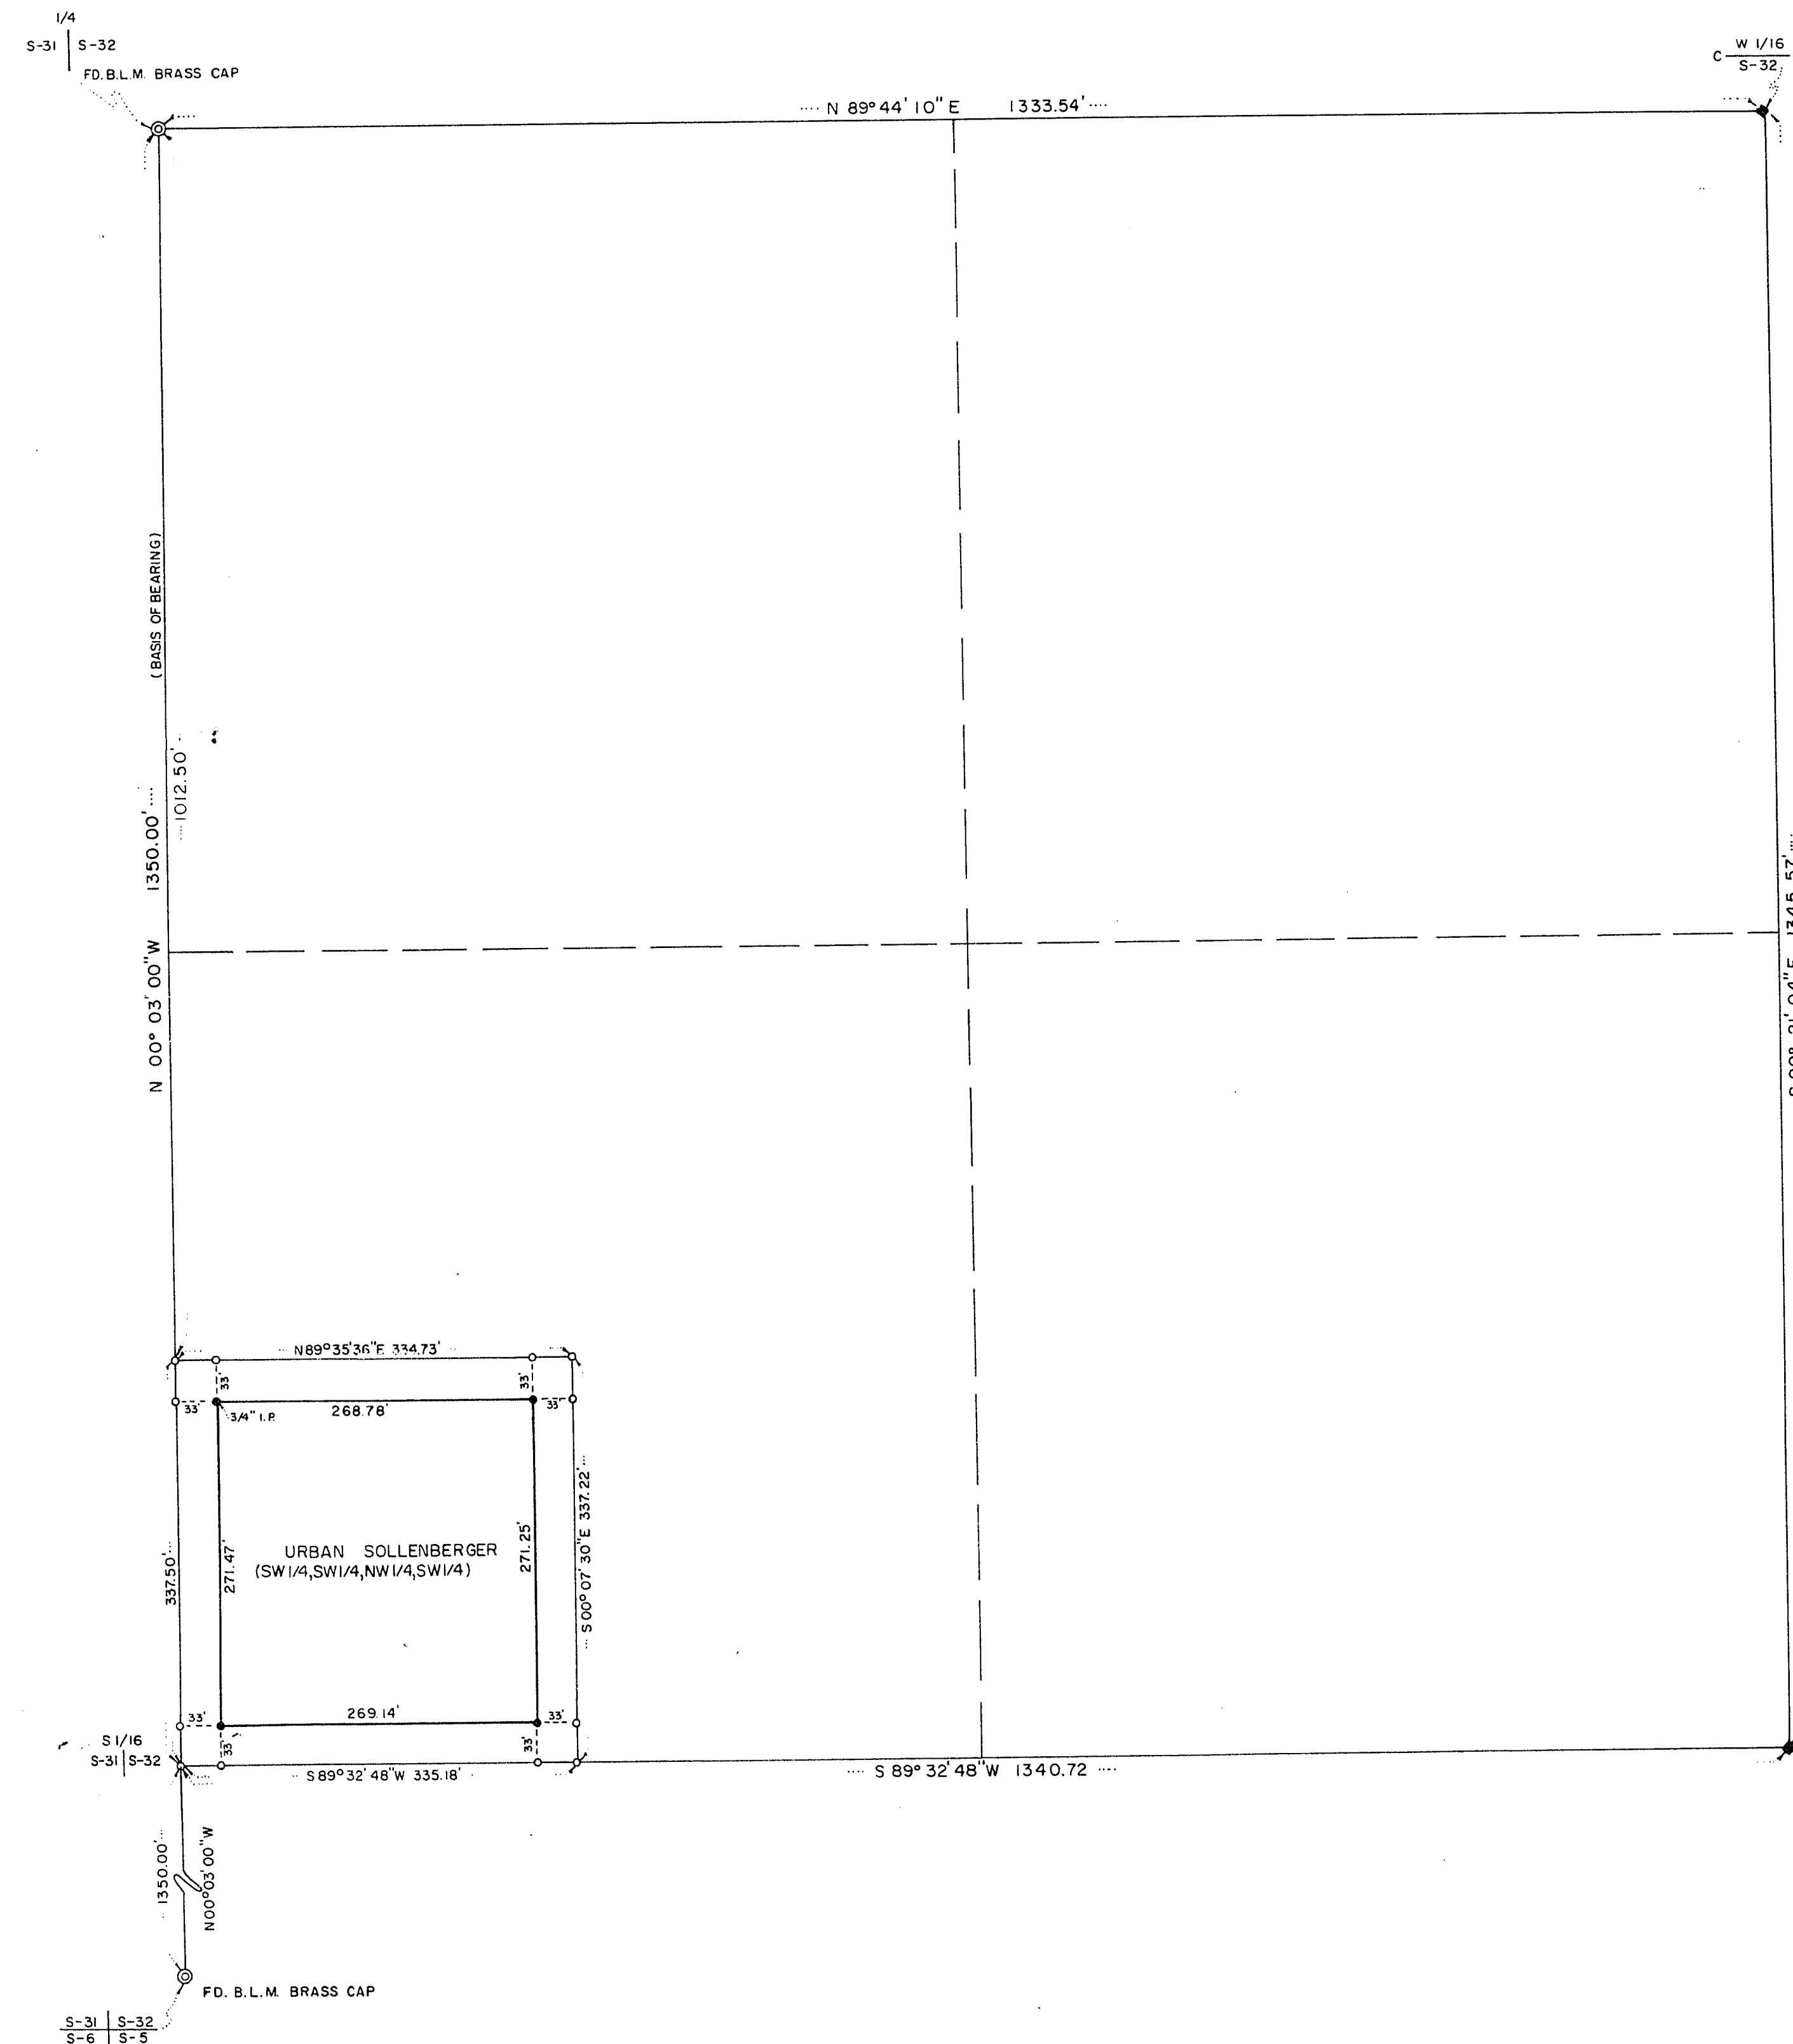

—NOTE—

BASIS OF BEARING: (N 00° 03' 00\" W) WEST LINE OF SECTION 32, T. 19 S., R. 60 E. M.D.B. & M. FROM RECORDS OF U.S. BUREAU OF LAND MANAGEMENT

—LEGEND—

- INDICATES 1/2\" IRON PIPE WITH TAG MARKED RE. N° 560 SET AS SHOWN HEREON
- ⊙ INDICATES B.L.M. BRASS CAP
- INDICATES 2\" X 2\" HUB & TACK SET AS SHOWN HEREON

—ENGINEER'S CERTIFICATE—

I, L. E. TYSON, REGISTERED CIVIL ENGINEER AND LAND SURVEYOR NEVADA N° 560, DO HEREBY CERTIFY THAT THIS MAP IS A TRUE AND CORRECT PLAT OF THE LAND SURVEYED BY ME AT THE INSTANCE OF URBAN SOLLENBERGER AND DESCRIBED AS A PORTION OF THE S.W. 1/4 OF SECTION 32, T. 19 S., R. 60 E. M.D.B. & M. CLARK COUNTY, NEVADA, AND THIS SURVEY WAS COMPLETED ON THIS 12TH DAY OF SEPTEMBER, 1961. THIS SURVEY IS NOT A SUBDIVISION AS DEFINED IN THE PLANNING & ZONING LAW AS SHOWN IN 1943-1949 SUPP. NEVADA COMPILED LAWS.

L. E. Tyson
L. E. TYSON, REG. CIVIL ENG. & LAND SURVEYOR NEV. N° 560

MAP FOR RECORD OF SURVEY
FOR
URBAN SOLLENBERGER
PORTION OF S.W. 1/4 SEC. 32, T. 19 S., R. 60 E.
M. D.B. & M.
CLARK COUNTY, NEVADA

NO. 260134
FILED AT THE DISTRICT CLERK'S OFFICE
L. E. TYSON
Date 10-9-61 2:47 P.
10 56
OFFICIAL NOTARY PUBLIC 322
CLARK COUNTY, NEVADA
PAUL C. O'MALLEY
Fee \$ 2.50 J.S.

055-334

FILE 11-10-61