


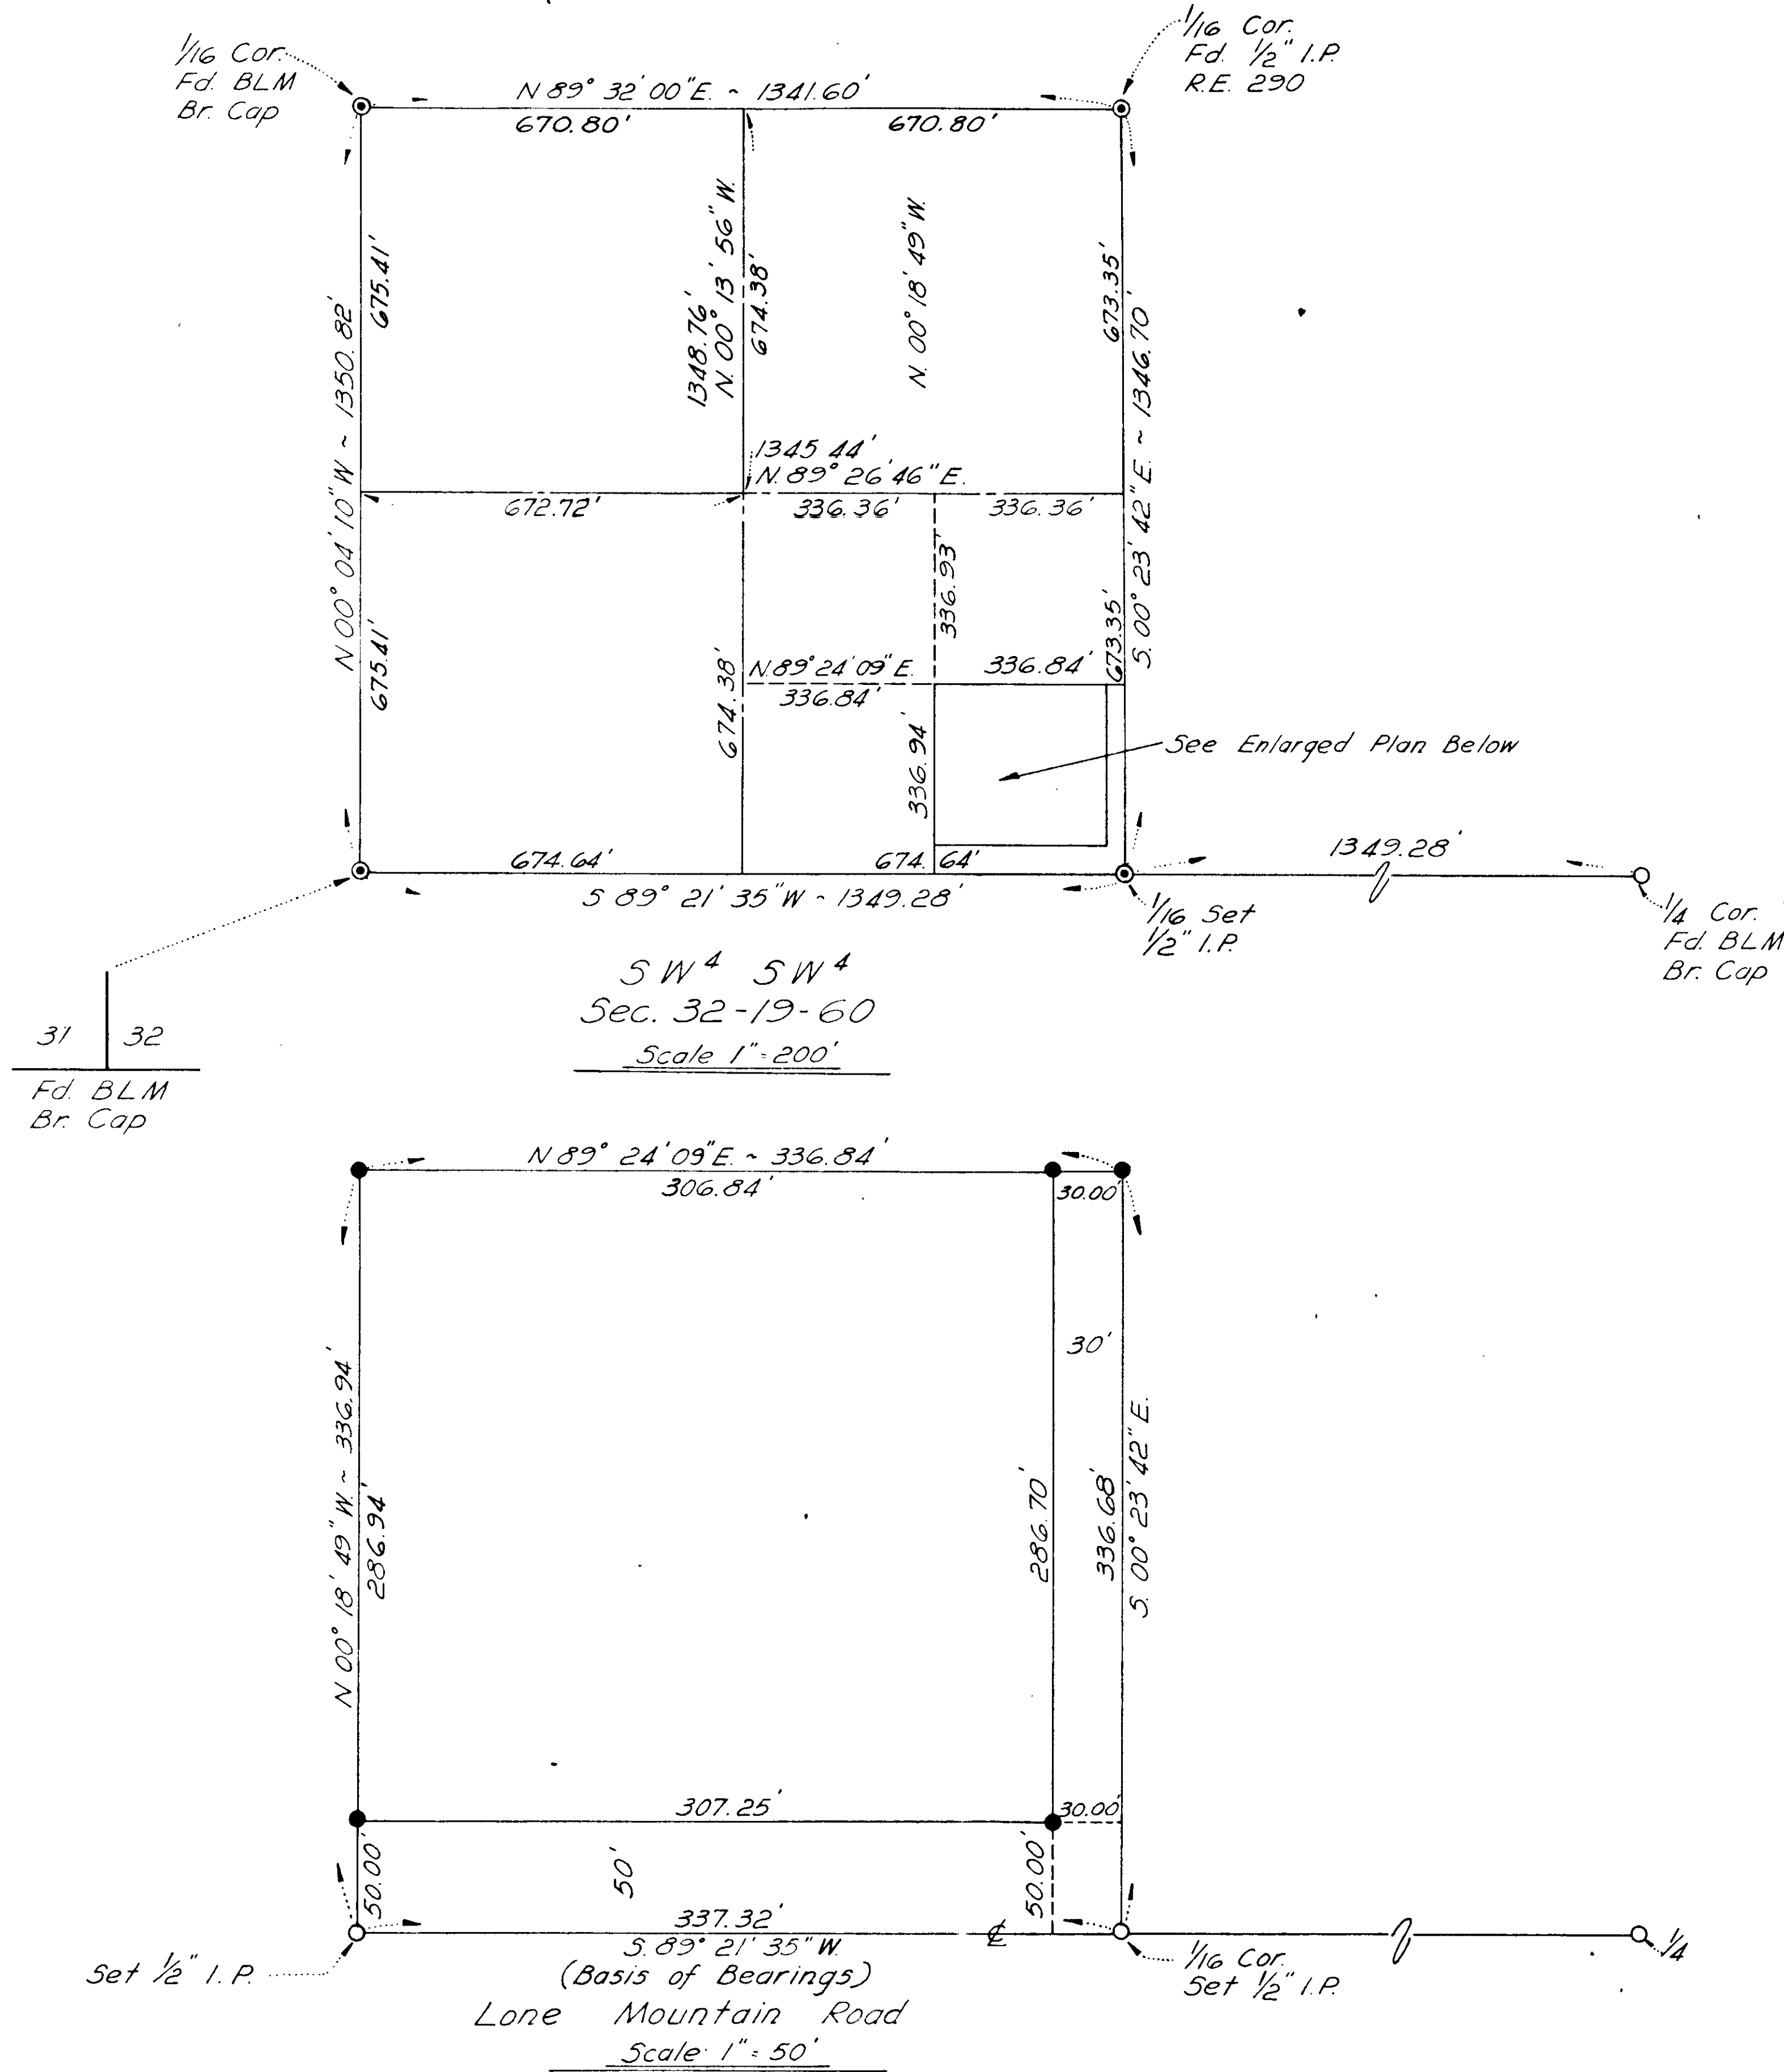


BASIS OF BEARINGS:

(S 89°-21'-35"W) South Line of Southwest Quarter Section 32, Township 19 South, Range 60 East, M.D.B. & M. as shown by Map Thereof Recorded on File 7 Page 24 in the Office of The County Recorder, Clark County Nevada.

CERTIFICATE

I, Warren L. Jaubert, a duly Licensed Land Surveyor do hereby Certify that this Map is a True and Accurate Representation of the Lands Shown hereon. All Points found or Set are Correctly Designated. This Survey was Completed on January 6, 1973 at the Instance of Phil Effinger, And does not constitute a Subdivision as Defined by Nevada State Law.

Warren L. Jaubert
Warren L. Jaubert Nevada L.S. No. 2052

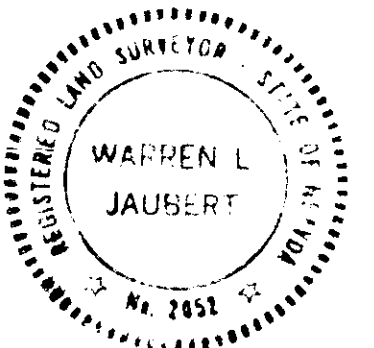

Legend

●..... Set 3/4" I.P. Tagged L.S. 2052

Document No. 256965
Recorded at the request of
WARREN L. JAUBERT
Dated 1-30-73 at 10:48 AM.
File 24, Page 39
OF SURVEYS
Official Records Book 297
Clark County, Nevada records
Paul E. Horn
Recorder
Fee \$250 Deputy

MAP FOR RECORD OF SURVEY
for
PHIL EFFINGER
FOR SW 1/4, SW 1/4, SEC. 32, T. 19 S. R. 60 E.
M.D.B. & M. CLARK COUNTY, NEVADA