


55-81

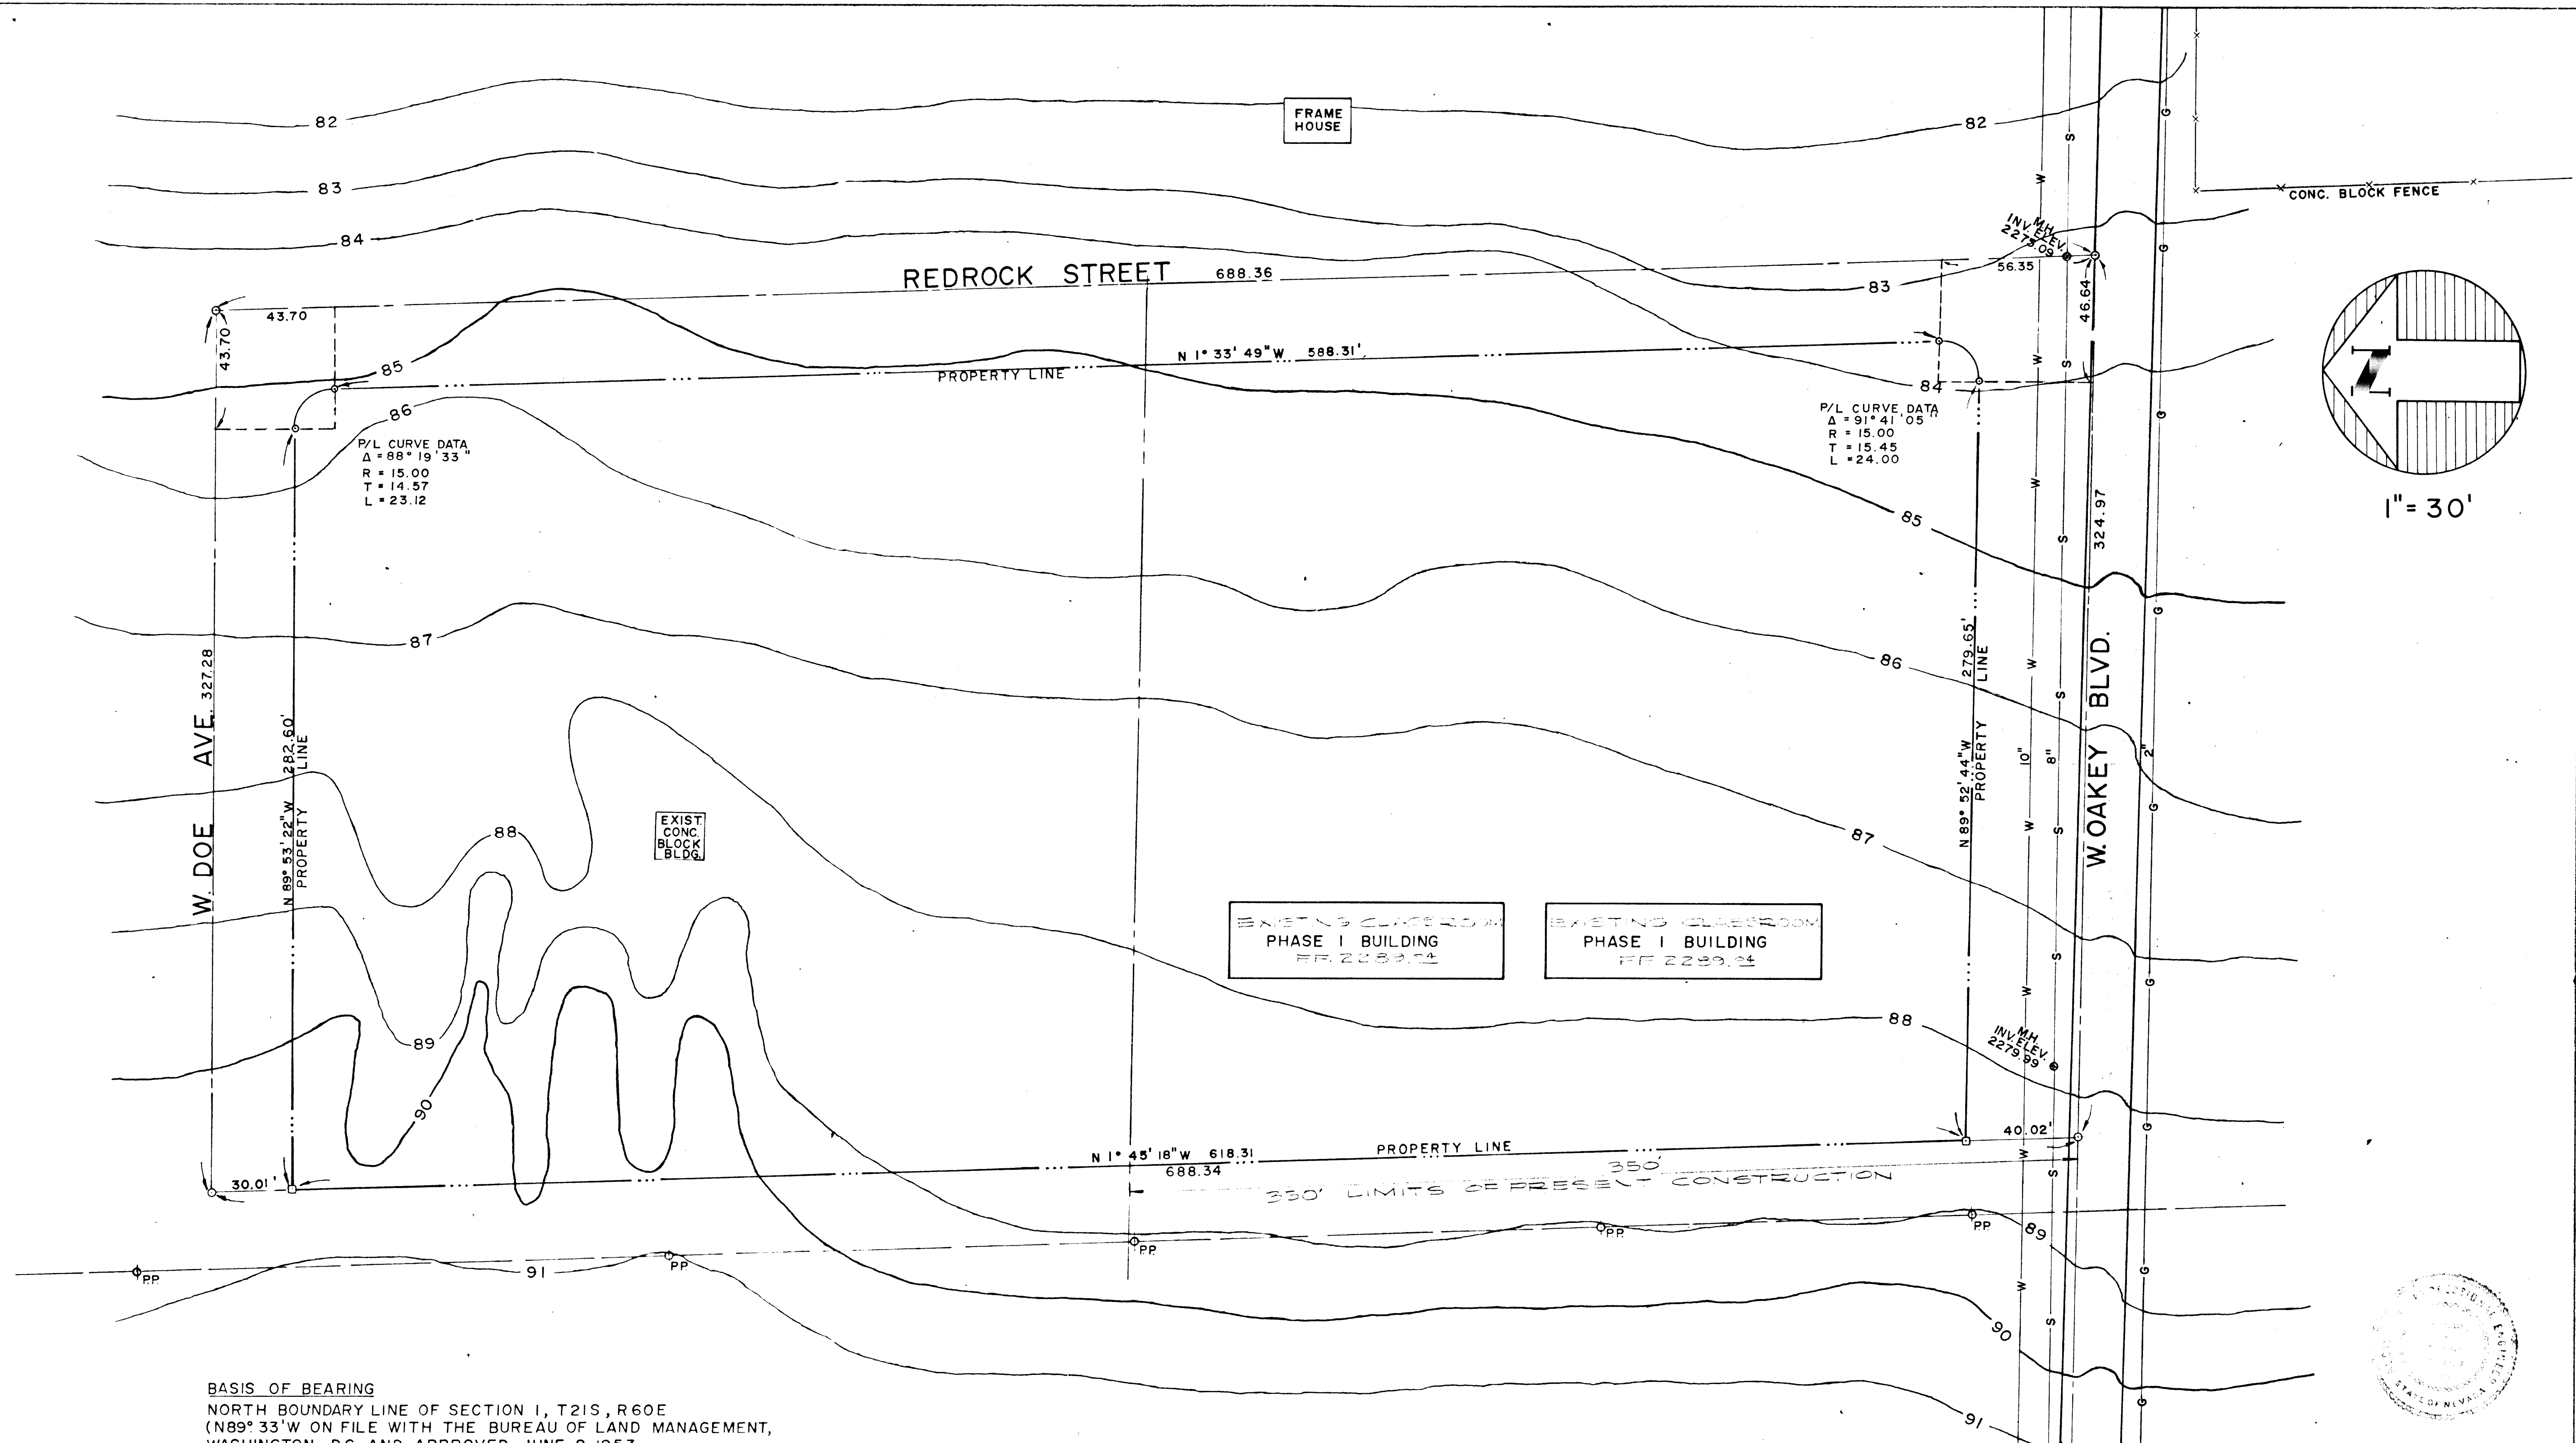

BASIS OF BEARING
NORTH BOUNDARY LINE OF SECTION 1, T21S, R60E
(N89° 33' W ON FILE WITH THE BUREAU OF LAND MANAGEMENT,
WASHINGTON, DC. AND APPROVED JUNE 8, 1953
AS SHOWN ON RECORD OF SURVEY FILE 19 PAGE 52 NO. 795565

James Schell 1/26/13

NO.		DATE		REVISIONS		BY	CKD.	APP'D
ALCA ENGINEERING INC.								
DESIGNED		W.S.						
DRAWN		F. CAPEL						
CHECKED		J. S.						
PROJ. ENGR.		J. S.						
DATE:		NOV 1, 1972						
4625 BOULDER HIGHWAY		DRAWING NO.		001				
LAS VEGAS, NEVADA #89109		SHEET		1 OF 14				
TEL 451-5859								

3633

12-C-7 20F14

7/5-59