
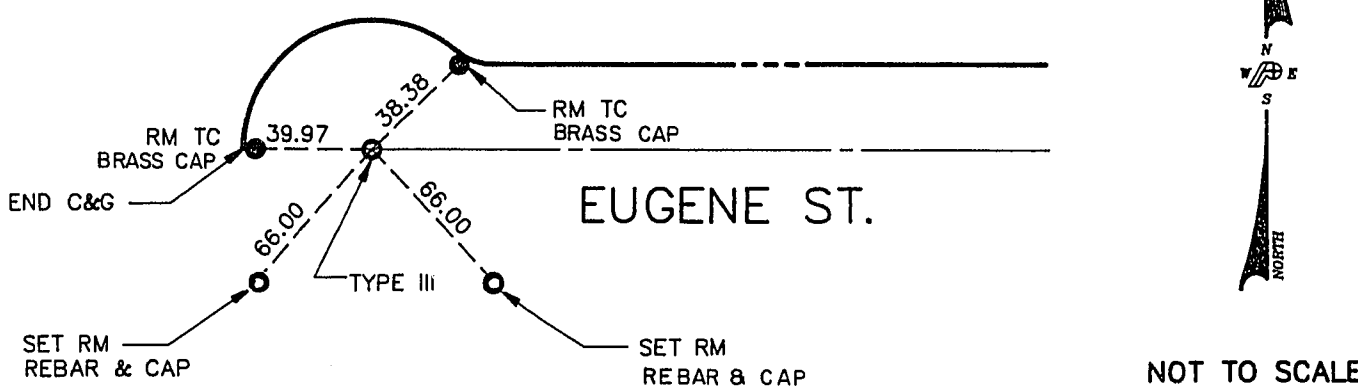
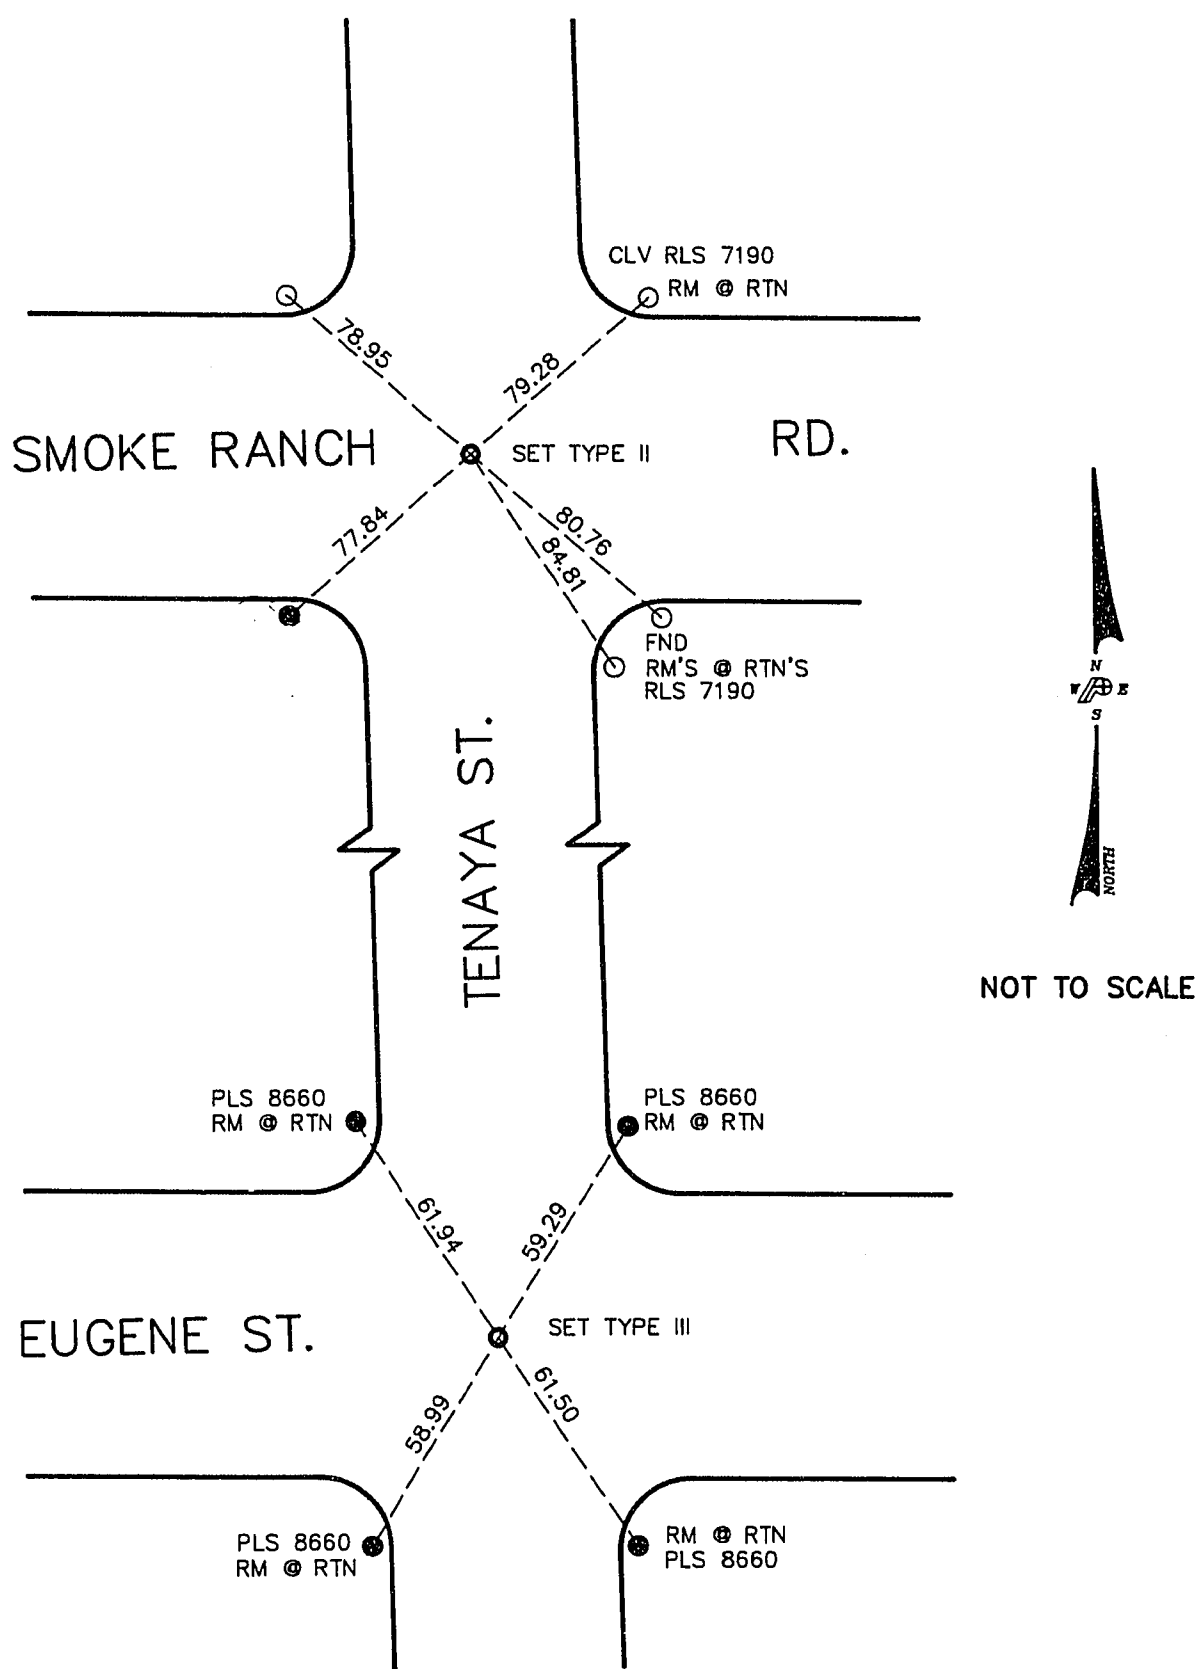


MEMORIAL SENIOR HIGH SCHOOL

A PORTION OF THE NW 1/4 OF SEC. 22, T. 20 S., R. 60 E., M.D.M.
CLARK COUNTY, NEVADA

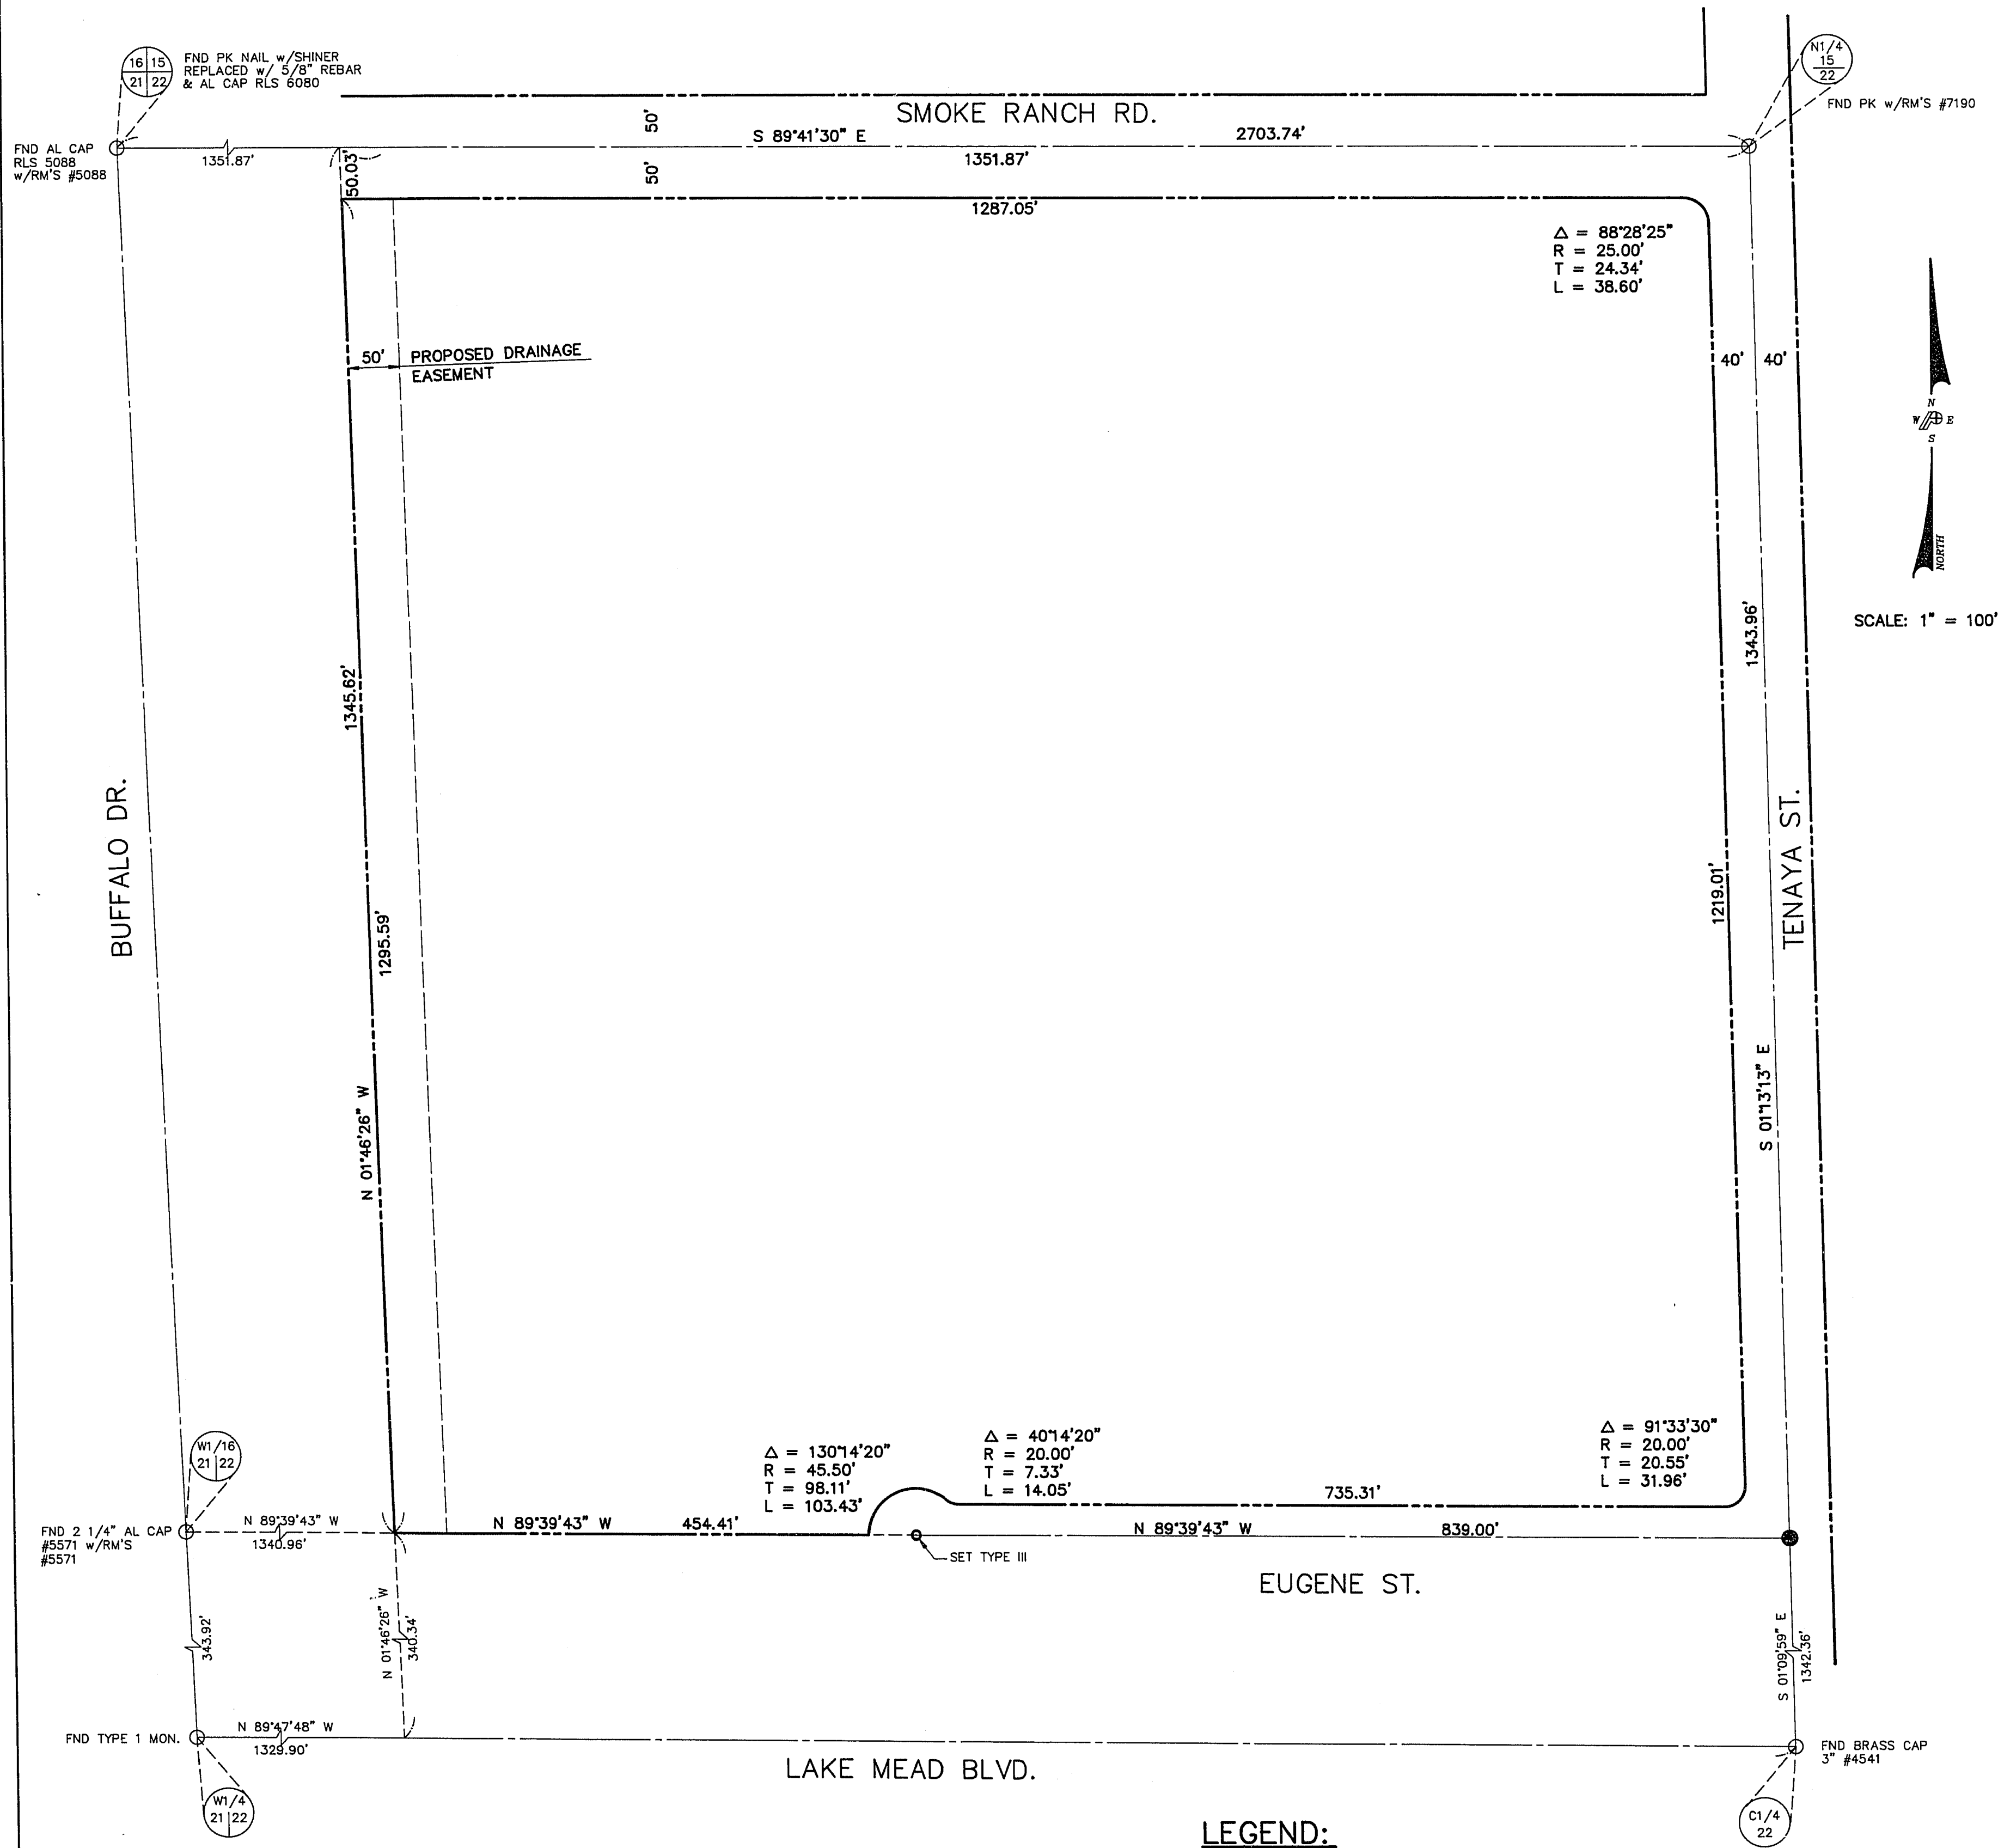


BASIS OF BEARING:

S 02°14'24" E BEING THE WEST LINE OF THE NW 1/4 OF SECTION 22, T. 20 S., R. 60 E., M.D.M., PER RECORD OF SURVEY FILE 52, PAGE 88 OFFICIAL RECORDS, CLARK COUNTY, NEVADA


MONUMENTATION CERTIFICATE:

I, PAUL B. CHANDLER, A PROFESSIONAL LAND SURVEYOR DULY REGISTERED IN THE STATE OF NEVADA DO HEREBY CERTIFY THAT THE MONUMENTS HAVE BEEN SET BY ME OR UNDER MY DIRECT SUPERVISION AND THE TIE DISTANCES ESTABLISHED ARE AS SHOWN HEREON. THIS SURVEY WAS COMPLETED ON OR PRIOR TO THIS 28TH DAY OF AUGUST, 1992.

PAUL B. CHANDLER, PLS
NEVADA CERTIFICATE NO. 8660

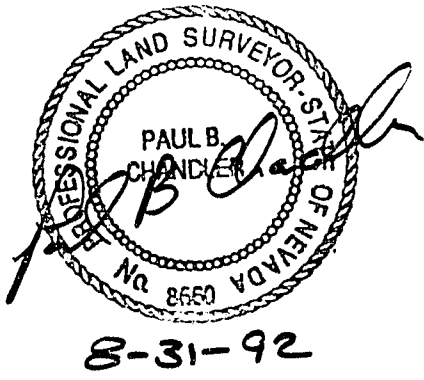

DATE	REVISION

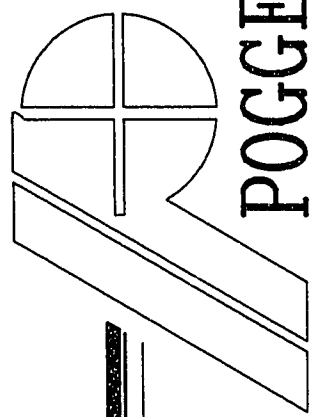

POGGENMEYER DESIGN GROUP
ENGINEERS PLANNERS SURVEYORS

1140 ALMOND TREE LANE, SUITE 306 LAS VEGAS, NEVADA 89004 (702) 735-5108

MONUMENTATION LOCATION MAP

MEMORIAL SENIOR HIGH SCHOOL
CLARK COUNTY SCHOOL DISTRICT

JOB NUMBER	92063
DESIGNED BY	
DRAWN BY	RAP
CHECKED BY	PBC
DATE	8-28-92

SHEET NUMBER
1