PROJECT
PROJECT MANAGER J.R.D.
DESIGNED BY M.L.H.
DRAWN BY R.D.Y.
JOB NO. 1029
SHEET NO.

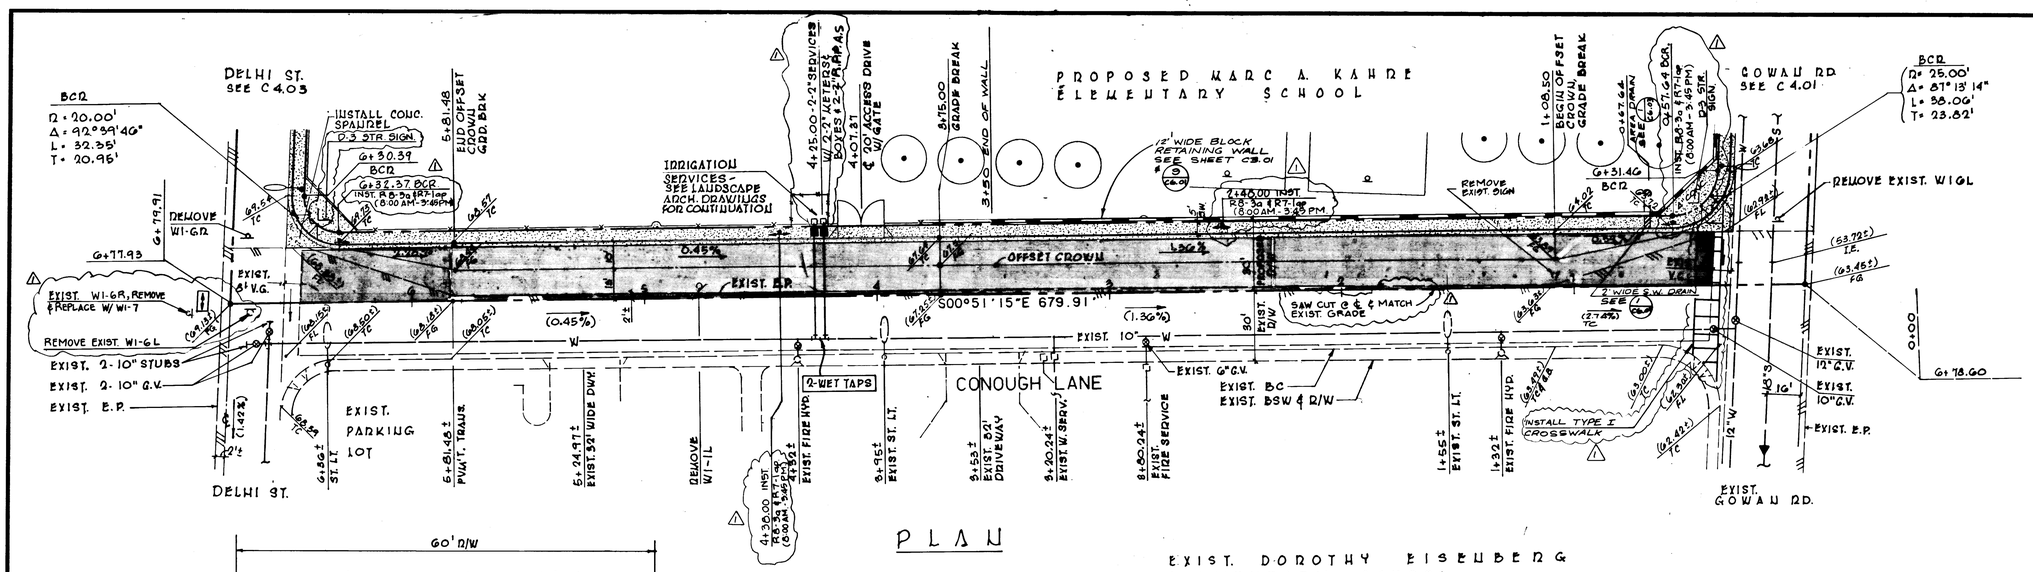

PLAN

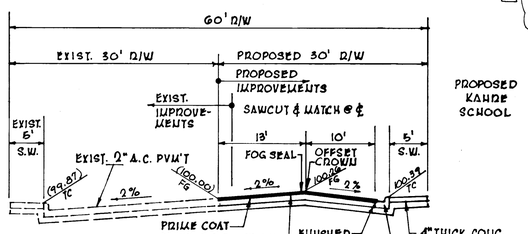

CONOUGH LANE (OFFSET CROWN)
STREET SECTION - N.T.S.

C4.02

QUANTITIES (THIS SHEET ONLY)

	(EST.)	
2" THICK A.C. PVM'T	1469	SY.
TYPE I AGG BASE	266	CY.
TYPE II AGG BASE	213	CY.
"L" TYPE C & G	574	LF.
SPANDREL CONC.	310	SF.
4" THICK SIDEWALK	2870	SF.

MARTIN & MARTIN assumes no responsibility for utility locations. The utilities shown on this drawing have been plotted from the best available information. It is, however, the contractors responsibility to field verify the location of all utilities prior to the commencement of any construction.

12-28-90
I.V.V. W.D. DATE

N
30 15 0 30 60
SCALE 1" = 30' HORIZ.
1" = 5' VERT.

Avoid cutting underground utility lines. It's costly.
Call before you Dig.
1-800-227-2600

REV	DESCRIPTION	DATE	BY
1	GEN REV (CCPW)	12/1990	MJF

THESE DRAWINGS AS INSTRUMENTS OF SERVICES ARE AND SHALL REMAIN THE PROPERTY OF THE ARCHITECT

THESE DRAWINGS ARE NOT TO BE SCALED

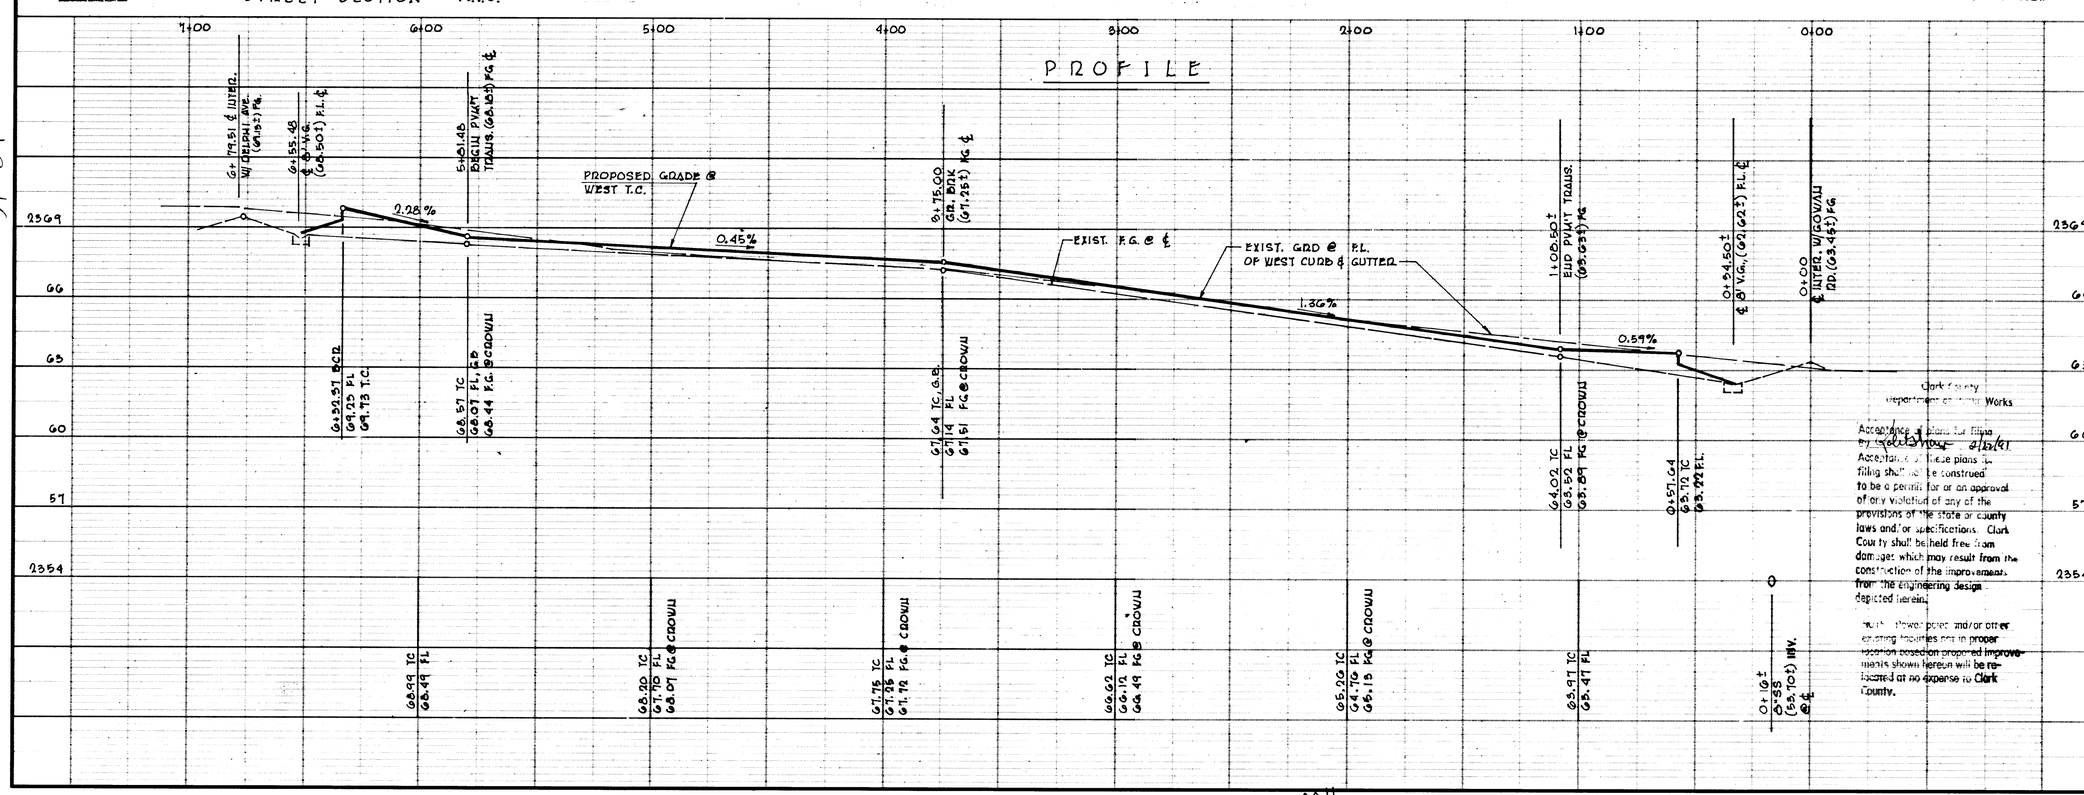

Clark County
Department of Public Works
Acceptance of plans for filing by [illegible] 2/15/91
Acceptance of these plans for filing shall not be construed to be a permit for or an approval of any violation of any of the provisions of the state or county laws and/or specifications. Clark County shall be held free from damages which may result from the construction of the improvements from the engineering design depicted herein.
Note: Power poles and/or other existing facilities not in proper location based on proposed improvements shown hereon will be relocated at no expense to Clark County.

REGISTERED PROFESSIONAL ENGINEER MARK L. HEDGE CIVIL No. 8445 STATE OF NEVADA
12-28-90

MARTIN & MARTIN
CIVIL ENGINEERS
1701 W. CHARLESTON BLVD.
SUITE 620
LAS VEGAS, NEVADA 89102
PHONE (702) 386-8005

ACA ARCHITECTS
ARTURO CAMBEIRO A.I.A.

CLARK COUNTY SCHOOL DISTRICT
SPECIAL PROJECTS 4280 EUCALYPTUS ANNEX 799-5025 LAS VEGAS, NEVADA 89121

PROJECT: MARC A. KAHRE ELEMENTARY SCHOOL
DRAWING TITLE: CONOUGH LANE - STREET IMPROVEMENTS

PROJ. MGR.	J.R.D.
CCSD REVIEW	
APPROVED BY	
DATE	
DRAWN BY	R.D.Y.
CHECKED BY	J.R.D.
SUBMITTAL	
A/E PROJECT NO.	1029
DATE	9-13-90

SHEET NO. C4.02
7/5-74

81-61

2941

 

 

CLARK COUNTY SCHOOL DISTRICT

MARC A. KAHRE ELEMENTARY SCHOOL

CONOUGH LANE - STREET IMPROVEMENTS

C4.02

81-18