



Call before you Dig.
1-800-227-2600

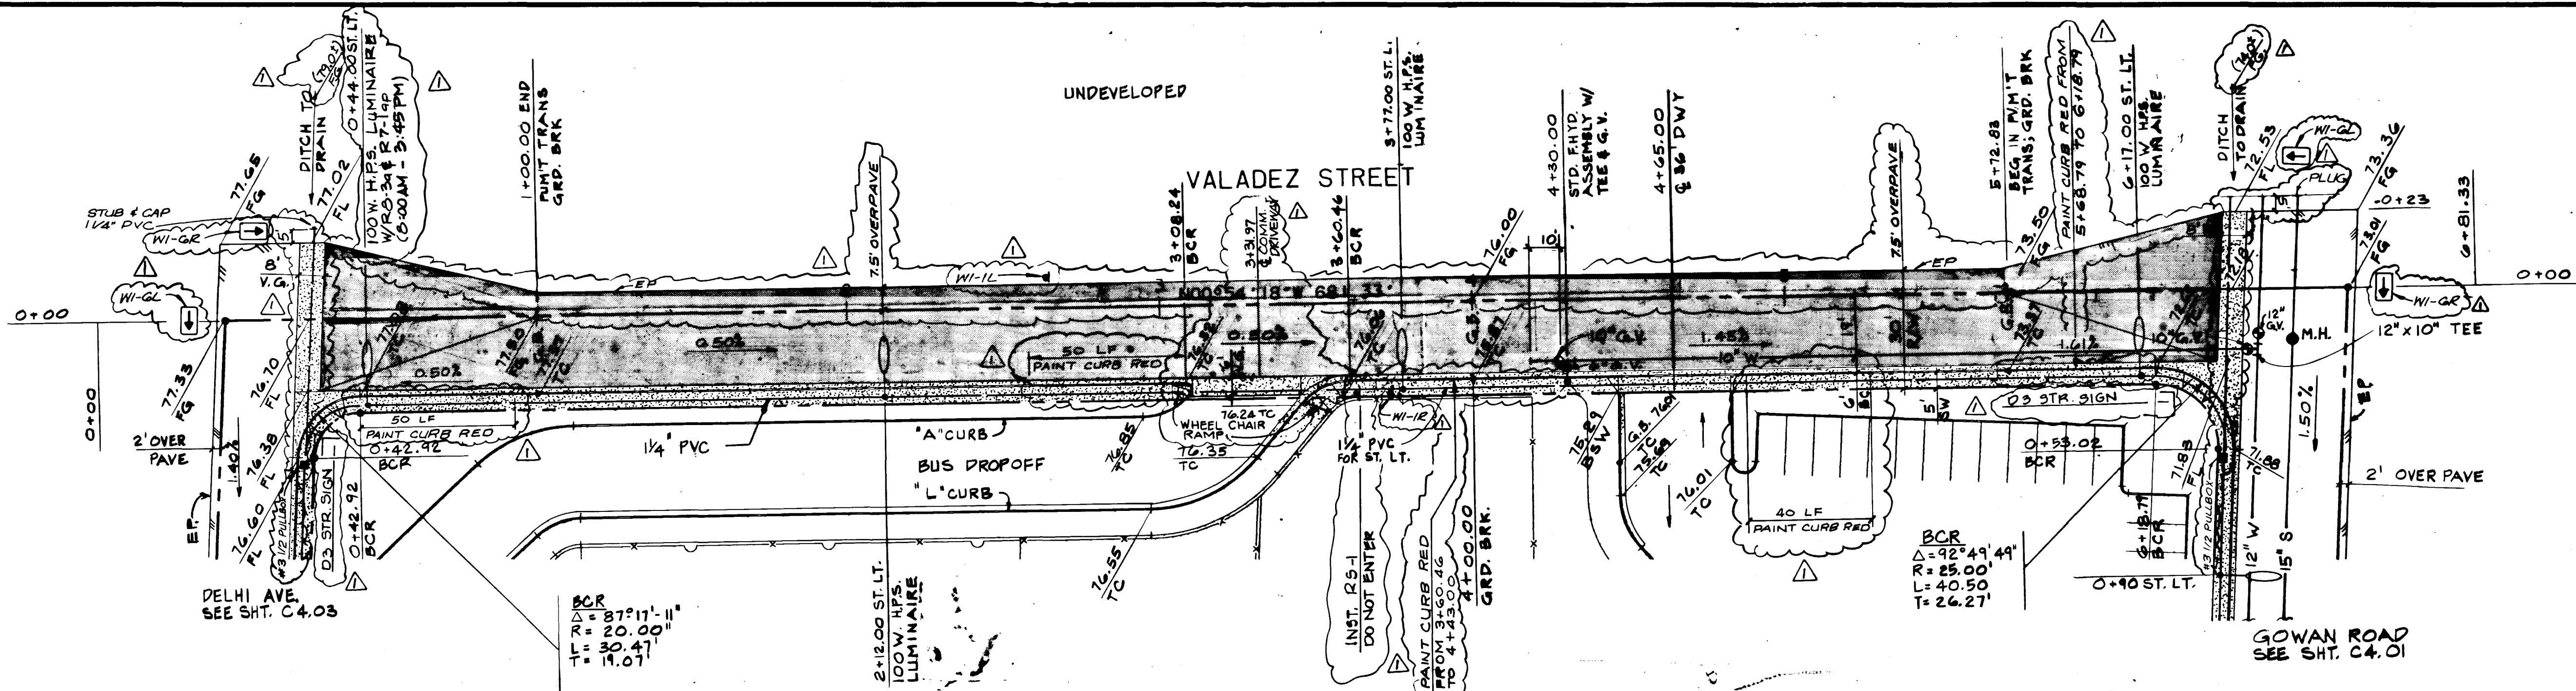


PLAN

QUANTITIES (THIS SHEET ONLY)	EST.	
2" THICK AC P.V.M.T.	2115	SY.
TYPE I AGG. BASE	395	CY.
TYPE II AGG. BASE	345	CY.
TYPE C & G	578	LF.
4" THICK SIDEWALK	2880	SF.
100 W.H.P.S.	4	EA.
10" WATER P.V.C.	411	LF.
STD. FIRE HYD. ASSEMBLY	1	EA.
10" GATE VALVE	1	EA.


MARTIN & MARTIN assumes no responsibility for utility locations. The utilities shown on this drawing have been plotted from the best available information. It is, however, the contractor's responsibility to field verify the location of all utilities prior to the commencement of any construction.

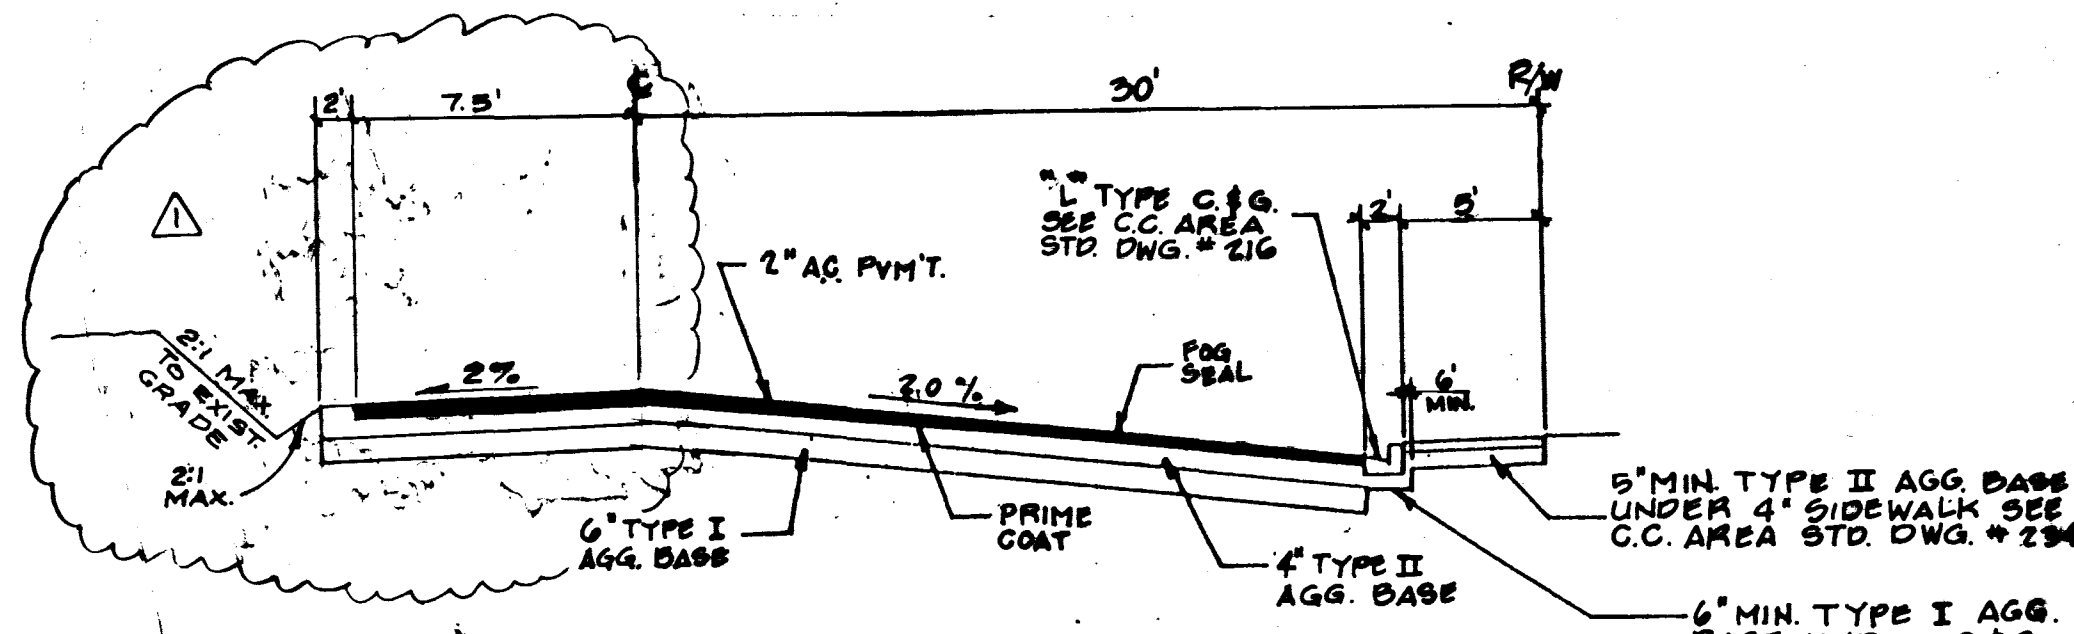

HALF STREET IMPROVEMENTS (VALADEZ STREET) - N.T.S.

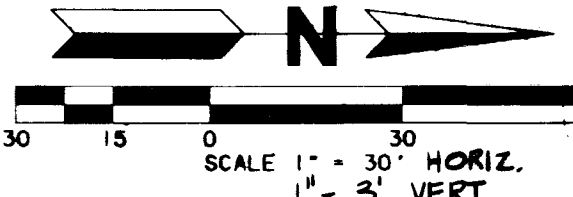


PROFILE

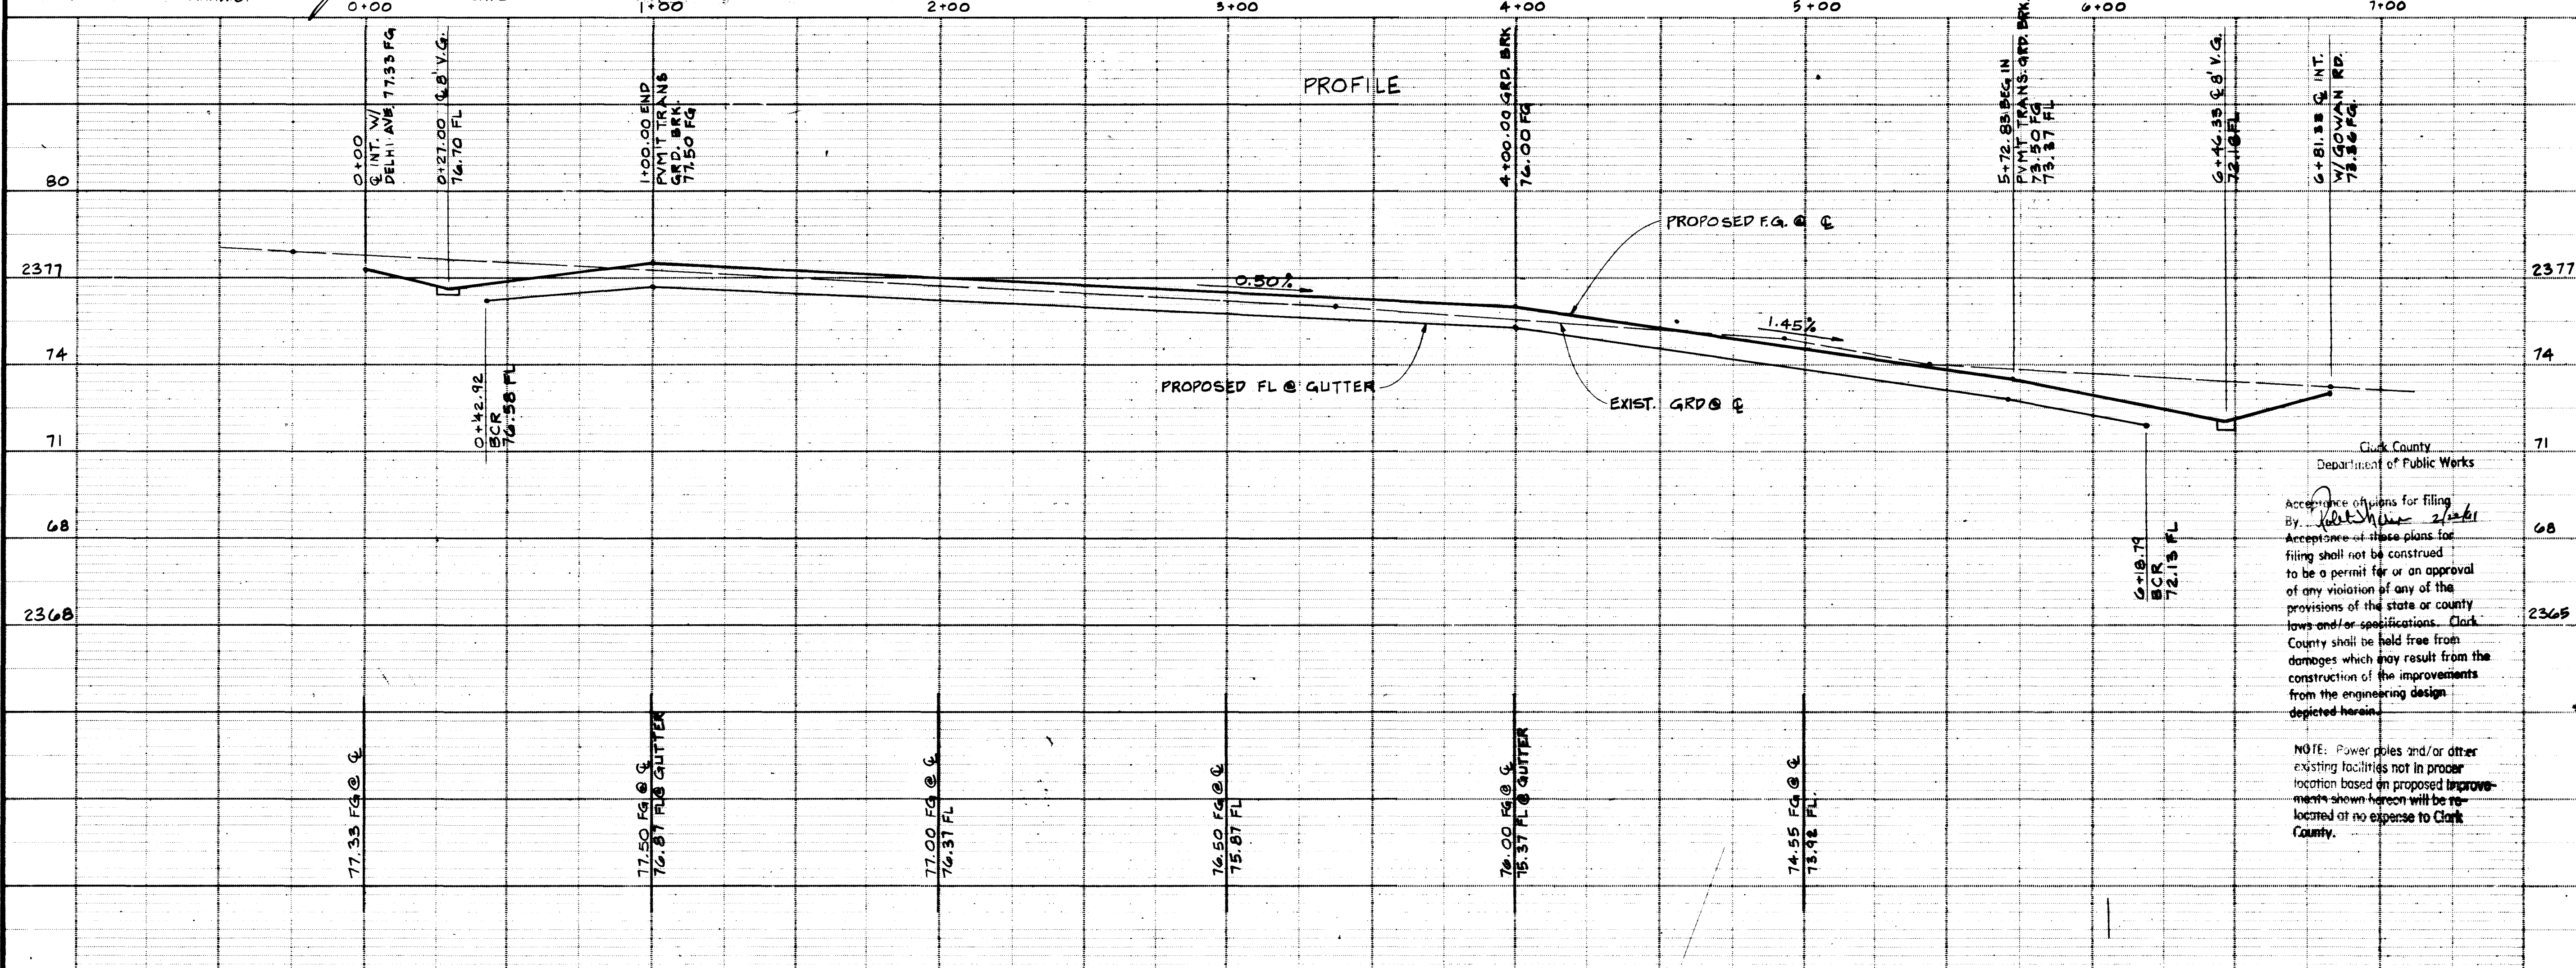

REV	DESCRIPTION	DATE	BY
1	GEN. REV. (CCPW)	12-28-90	NUE

THESE DRAWINGS AS INSTRUMENTS OF SERVICES ARE AND SHALL REMAIN THE PROPERTY OF THE ARCHITECT

THESE DRAWINGS ARE NOT TO BE SCALED

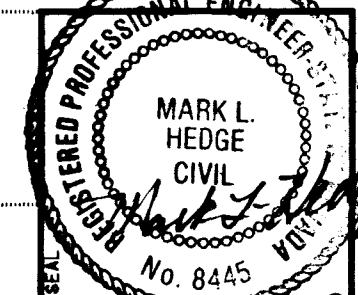

MARTIN & MARTIN
CIVIL ENGINEERS
701 N. CHARLESTON BLVD.
SUITE 200
LAS VEGAS, NEVADA 89101
PHONE (702) 386-8005



ARCHITECTS
ARTURO CAMBEIRO A.I.A.

CLARK COUNTY SCHOOL DISTRICT
SPECIAL PROJECTS 4280 EUCALYPTUS ANNEX 789-5025 LAS VEGAS, NEVADA 89121
PROJECT: MARC A. KAHRE ELEMENTARY SCHOOL
DRAWING TITLE: VALADEZ STREET - STREET IMPROVEMENTS

SHEET NO. C4.04

Clark County
Department of Public Works
Acceptance of plans for filing
By: [Signature] 2/26/91
Acceptance of these plans for filing shall not be construed to be a permit for or an approval of any violation of any of the provisions of the state or county laws and/or specifications. Clark County shall be held free from damages which may result from the construction of the improvements from the engineering design depicted herein.
NOTE: Power poles and/or other existing facilities not in proper location based on proposed improvements shown hereon will be re-located at no expense to Clark County.

100' 0" 200' 0" 300' 0" 400' 0" 500' 0" 600' 0" 700' 0" 800' 0" 900' 0" 1000' 0"

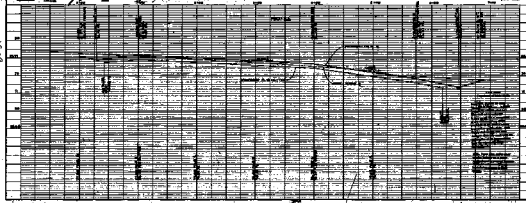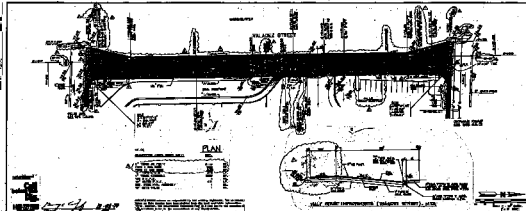

