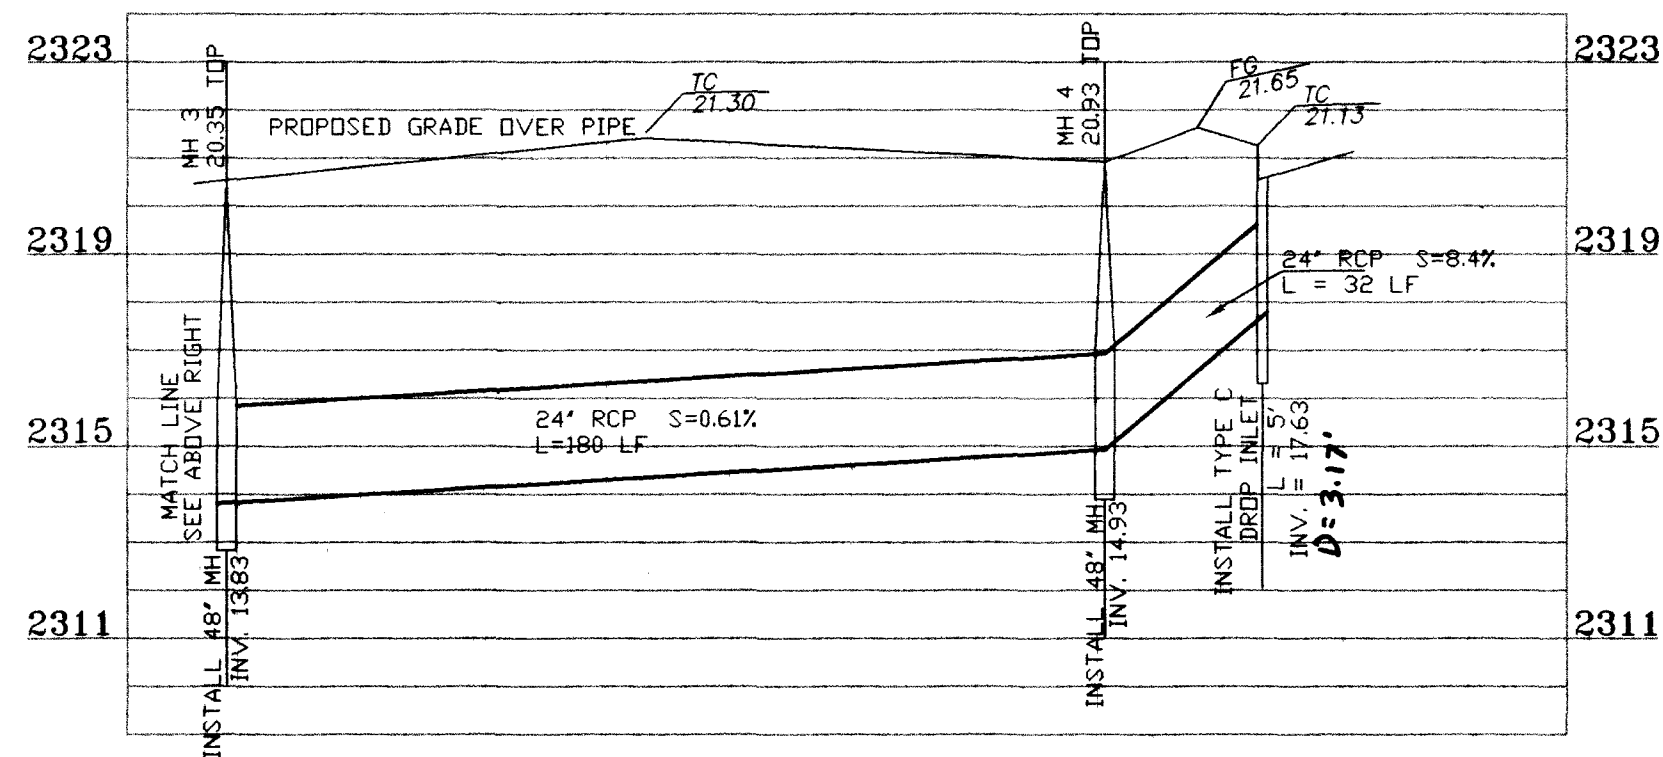
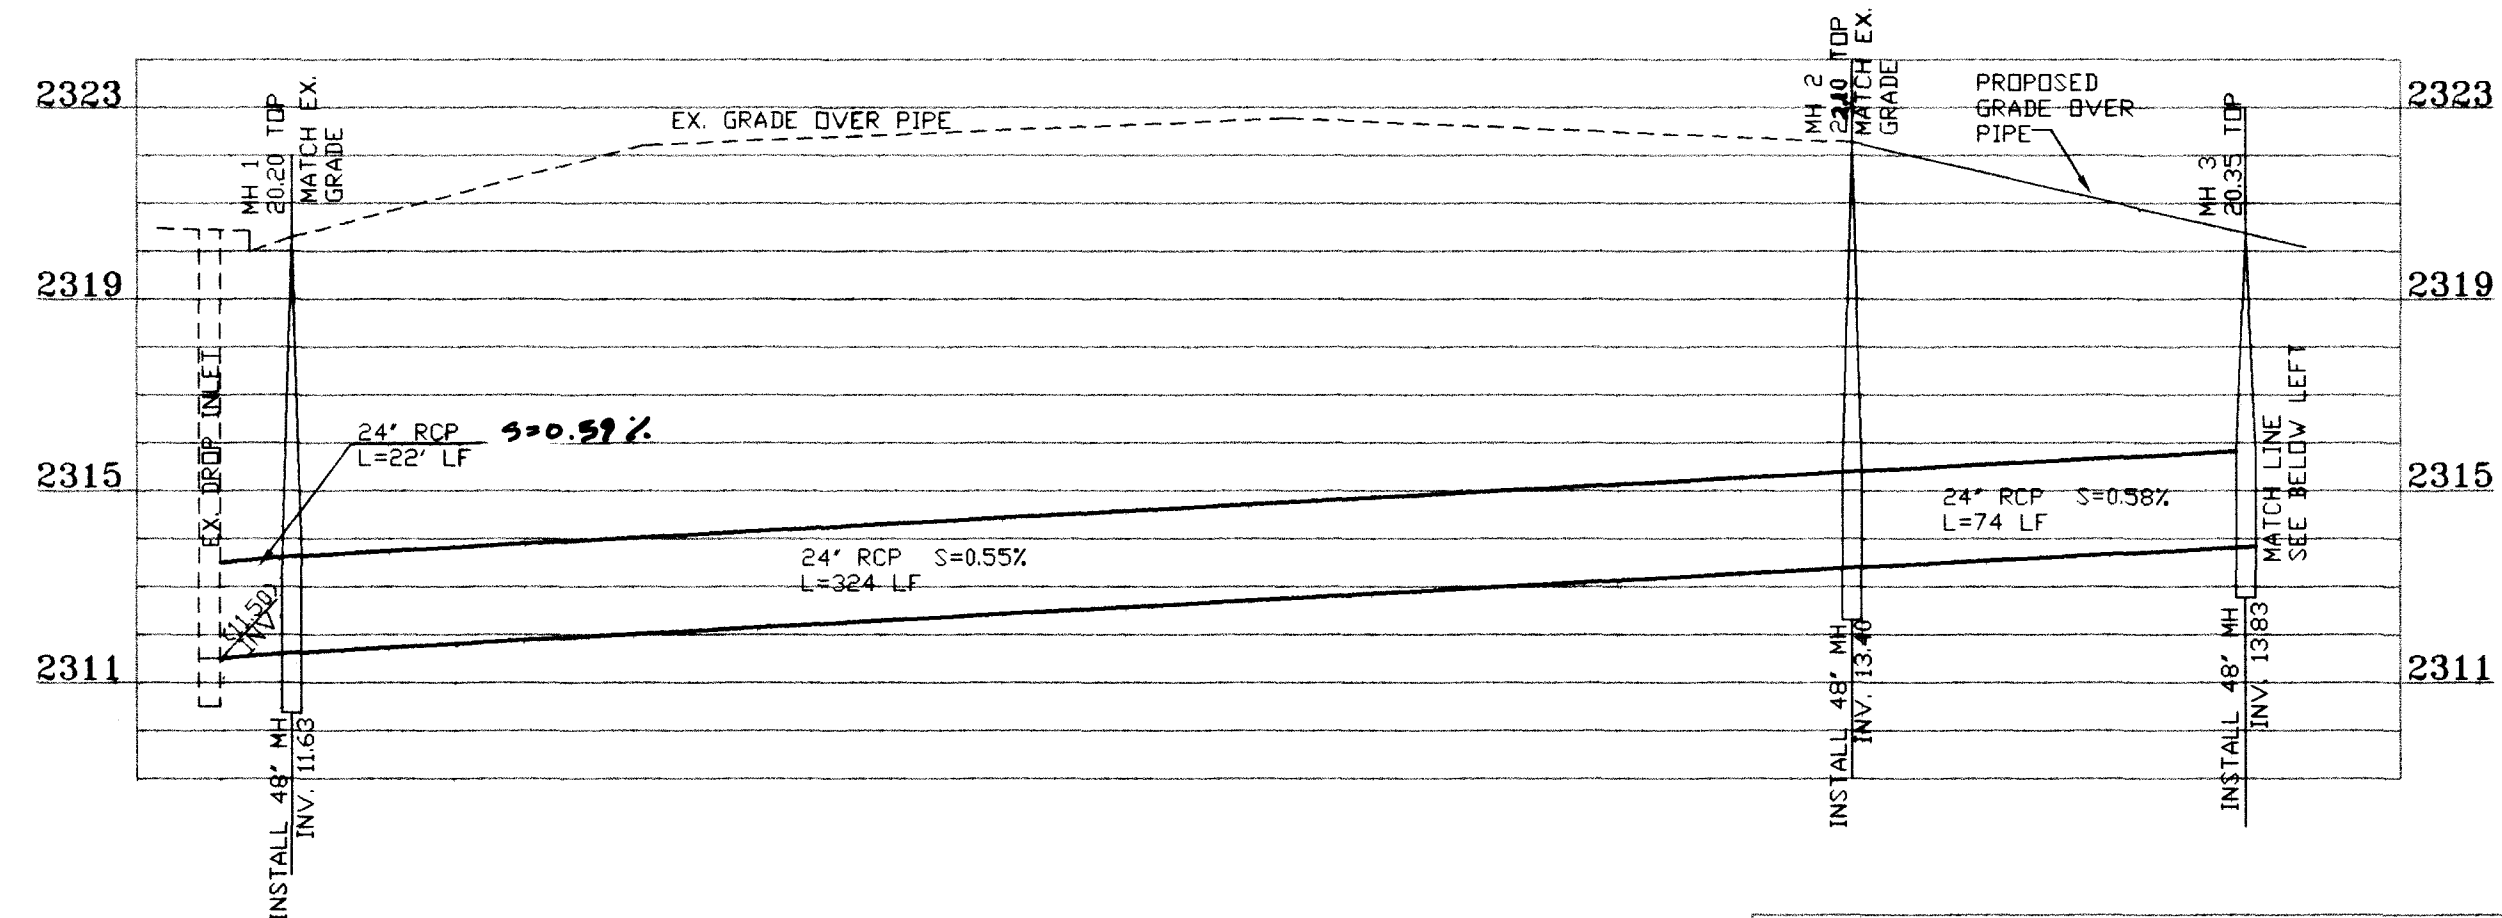
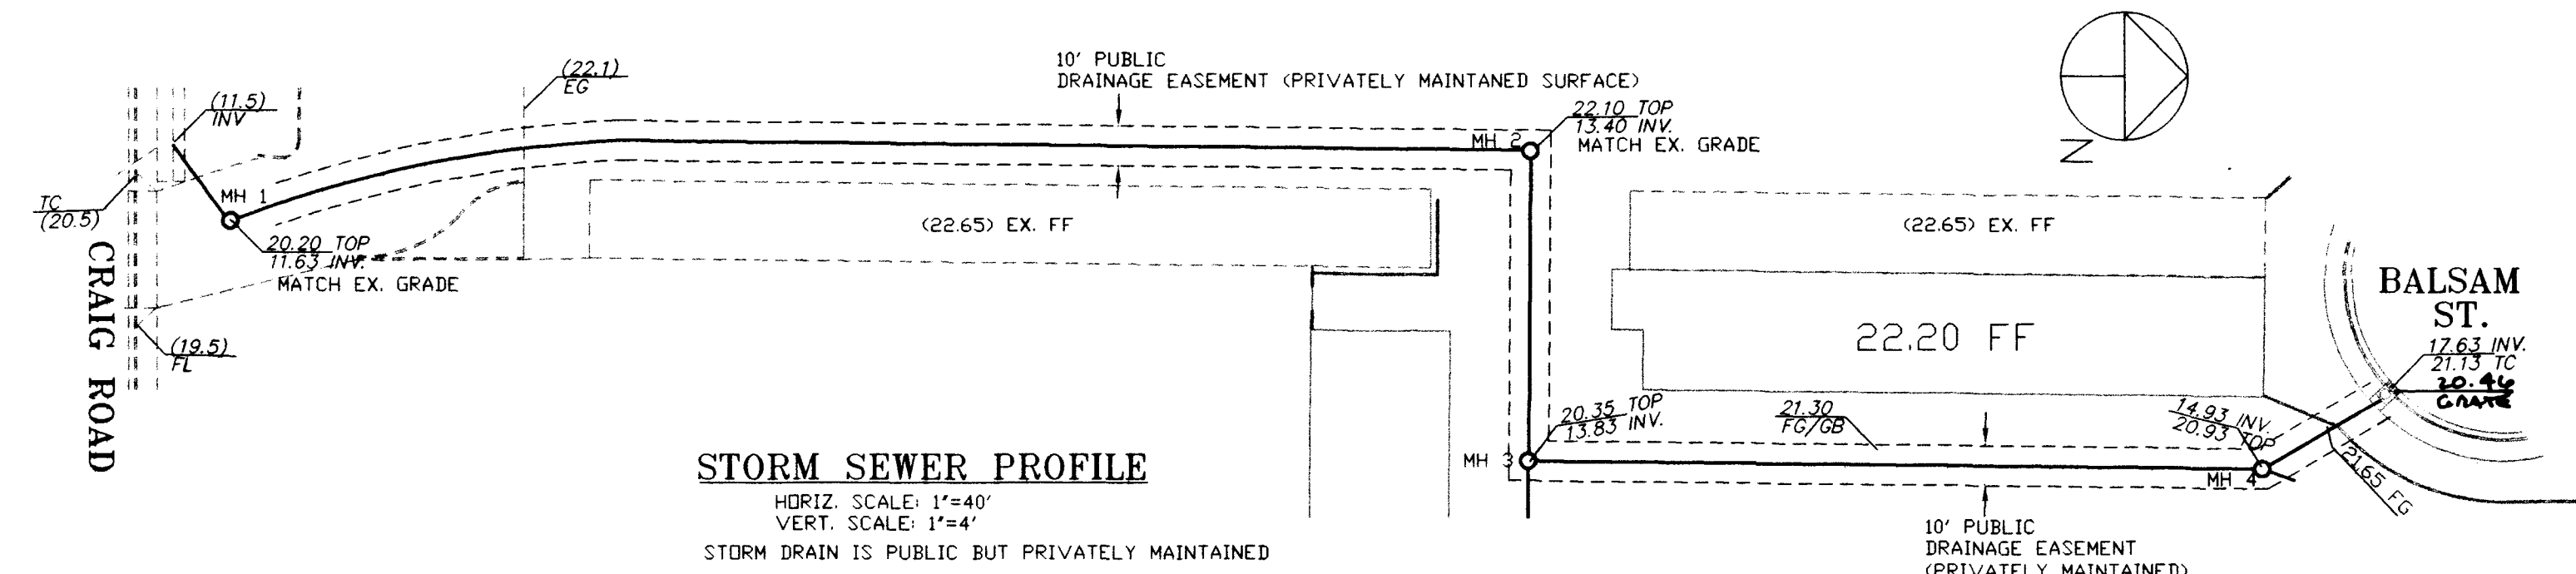


BENCHMARK
ILV00 2W4
RIVET & PLATE IN TOP OF CURB, NORTHEAST RETURN
OF RAINBOW BLVD. AND CRAIG ROAD
2316.68 FEET
706.1261 METERS
NAVD83

ANY INFORMATION OR DATA ON THIS DRAWING IS NOT INTENDED TO BE SUITABLE FOR REUSE BY ANY PERSON, FIRM, CORPORATION, OR ANY OTHERS ON EXTENSIONS OF THIS PROJECT OR FOR ANY USE ON ANY OTHER PROJECT. ANY REUSE WITHOUT WRITTEN VERIFICATION AND ADOPTION BY THE ENGINEER FOR THE SPECIFIC PURPOSE INTENDED WILL BE AT THE USER'S SOLE RISK AND WITHOUT LIABILITY OR LEGAL EXPOSURE TO THE ENGINEER.

NOTE:
EXISTING UTILITIES AND IMPROVEMENTS SHOWN ON THESE PLANS WERE LOCATED FROM THE BEST INFORMATION AVAILABLE AT THE TIME. THE ENGINEER BEARS NO RESPONSIBILITY FOR EXISTING UTILITIES AND IMPROVEMENTS NOT SHOWN OR FOR UTILITIES AND IMPROVEMENTS NOT IN THE LOCATION SHOWN ON THESE PLANS. THE CONTRACTOR SHALL BEAR FULL RESPONSIBILITY FOR NOTIFYING ALL UTILITY COMPANIES BEFORE STARTING CONSTRUCTION, AND PHYSICALLY LOCATING ALL UTILITIES AND IMPROVEMENTS PRIOR TO COMMENCING CONSTRUCTION.

AVOID OVERHEAD POWER LINE CONTACT
CALL BEFORE YOU OVERHEAD
1-702-593-6111
NEVADA POWER ENVIRONMENT AND SAFETY SERVICE DEPARTMENT

AVOID CUTTING UNDERGROUND UTILITY LINES. IT'S COSTLY!
CALL BEFORE YOU DIG
1-800-227-2600
UNDERGROUND SERVICE ORGANIZATION

CIVIL ENGINEERING
LAND DEVELOPMENT
CONSTRUCTION SERVICES

P.R.E. ENGINEERING
PHILIP W. REGESKI
P.O. BOX 13438
LAS VEGAS, NEVADA 89112
(702) 434-8515

PROFESSIONAL ENGINEER - STATE OF NEVADA
PHILIP W. REGESKI
No. 11278
10/23/97


10/23/97
DRAWN BY: PWR
DESIGNED BY: PWR
CHECKED BY: KEM
SCALE: 1"=40'
FILE: 4006-SD

**McFADDEN MINI STORAGE
STORM DRAIN PROFILE**

PREPARED FOR: MINI MASTERS

REVISIONS		APPROVAL
NO.	DATE	BY

SHEET
4
SHT 4 OF 4

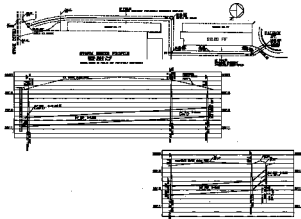

Scale 1" = 40 ft





**CALL
BEFORE YOU
OVER-HEAD**

**CALL
BIG**

4

**McFADEN MINI STORAGE
STORM DRAIN PROFILE**








