



CURVE	LENGTH	DELTA	RADIUS	TANGENT
C1	39.27'	90°00'00"	25.00'	25.00'
C2	23.56'	90°00'00"	15.00'	15.00'

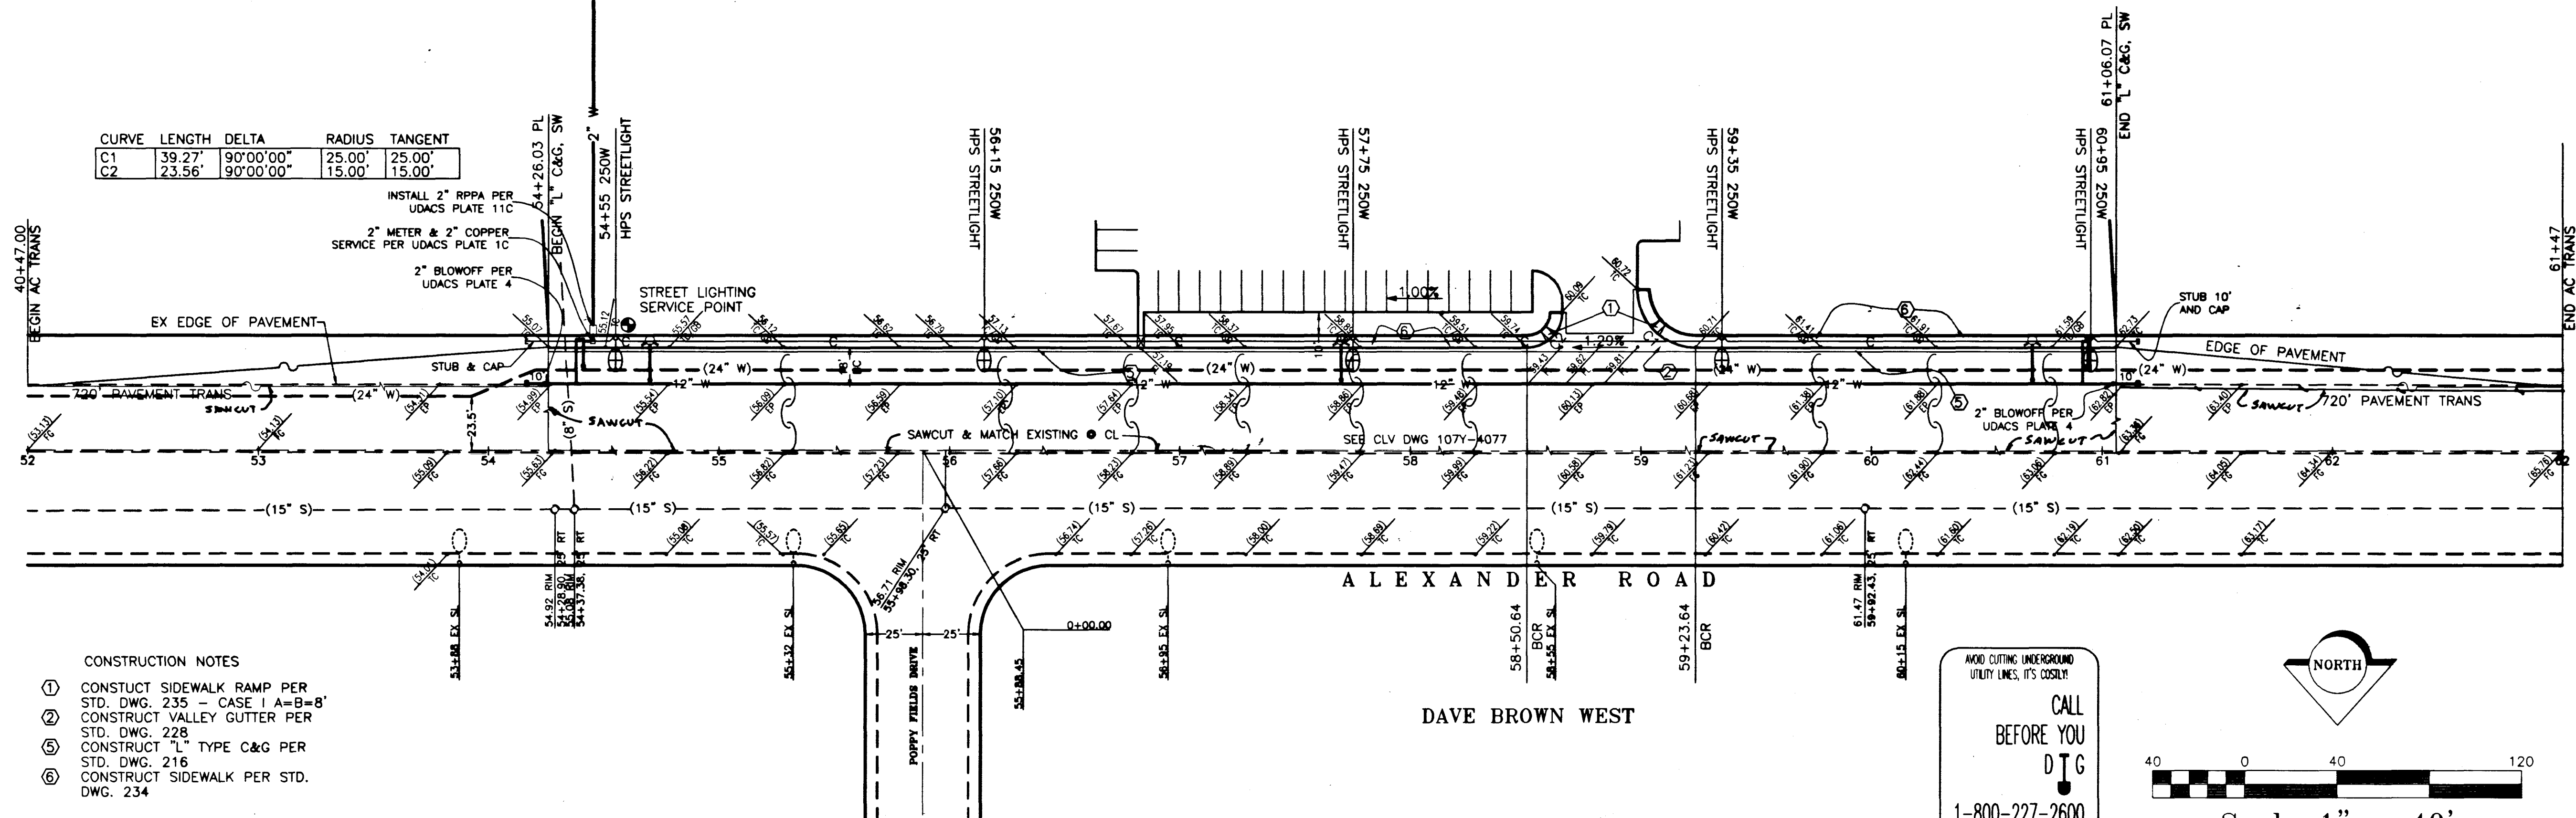


- CONSTRUCTION NOTES
1. CONSTRUCT SIDEWALK RAMP PER STD. DWG. 235 - CASE 1 A=B=8'
 2. CONSTRUCT VALLEY GUTTER PER STD. DWG. 228
 3. CONSTRUCT "L" TYPE C&G PER STD. DWG. 216
 4. CONSTRUCT SIDEWALK PER STD. DWG. 234

DESIGN = STC

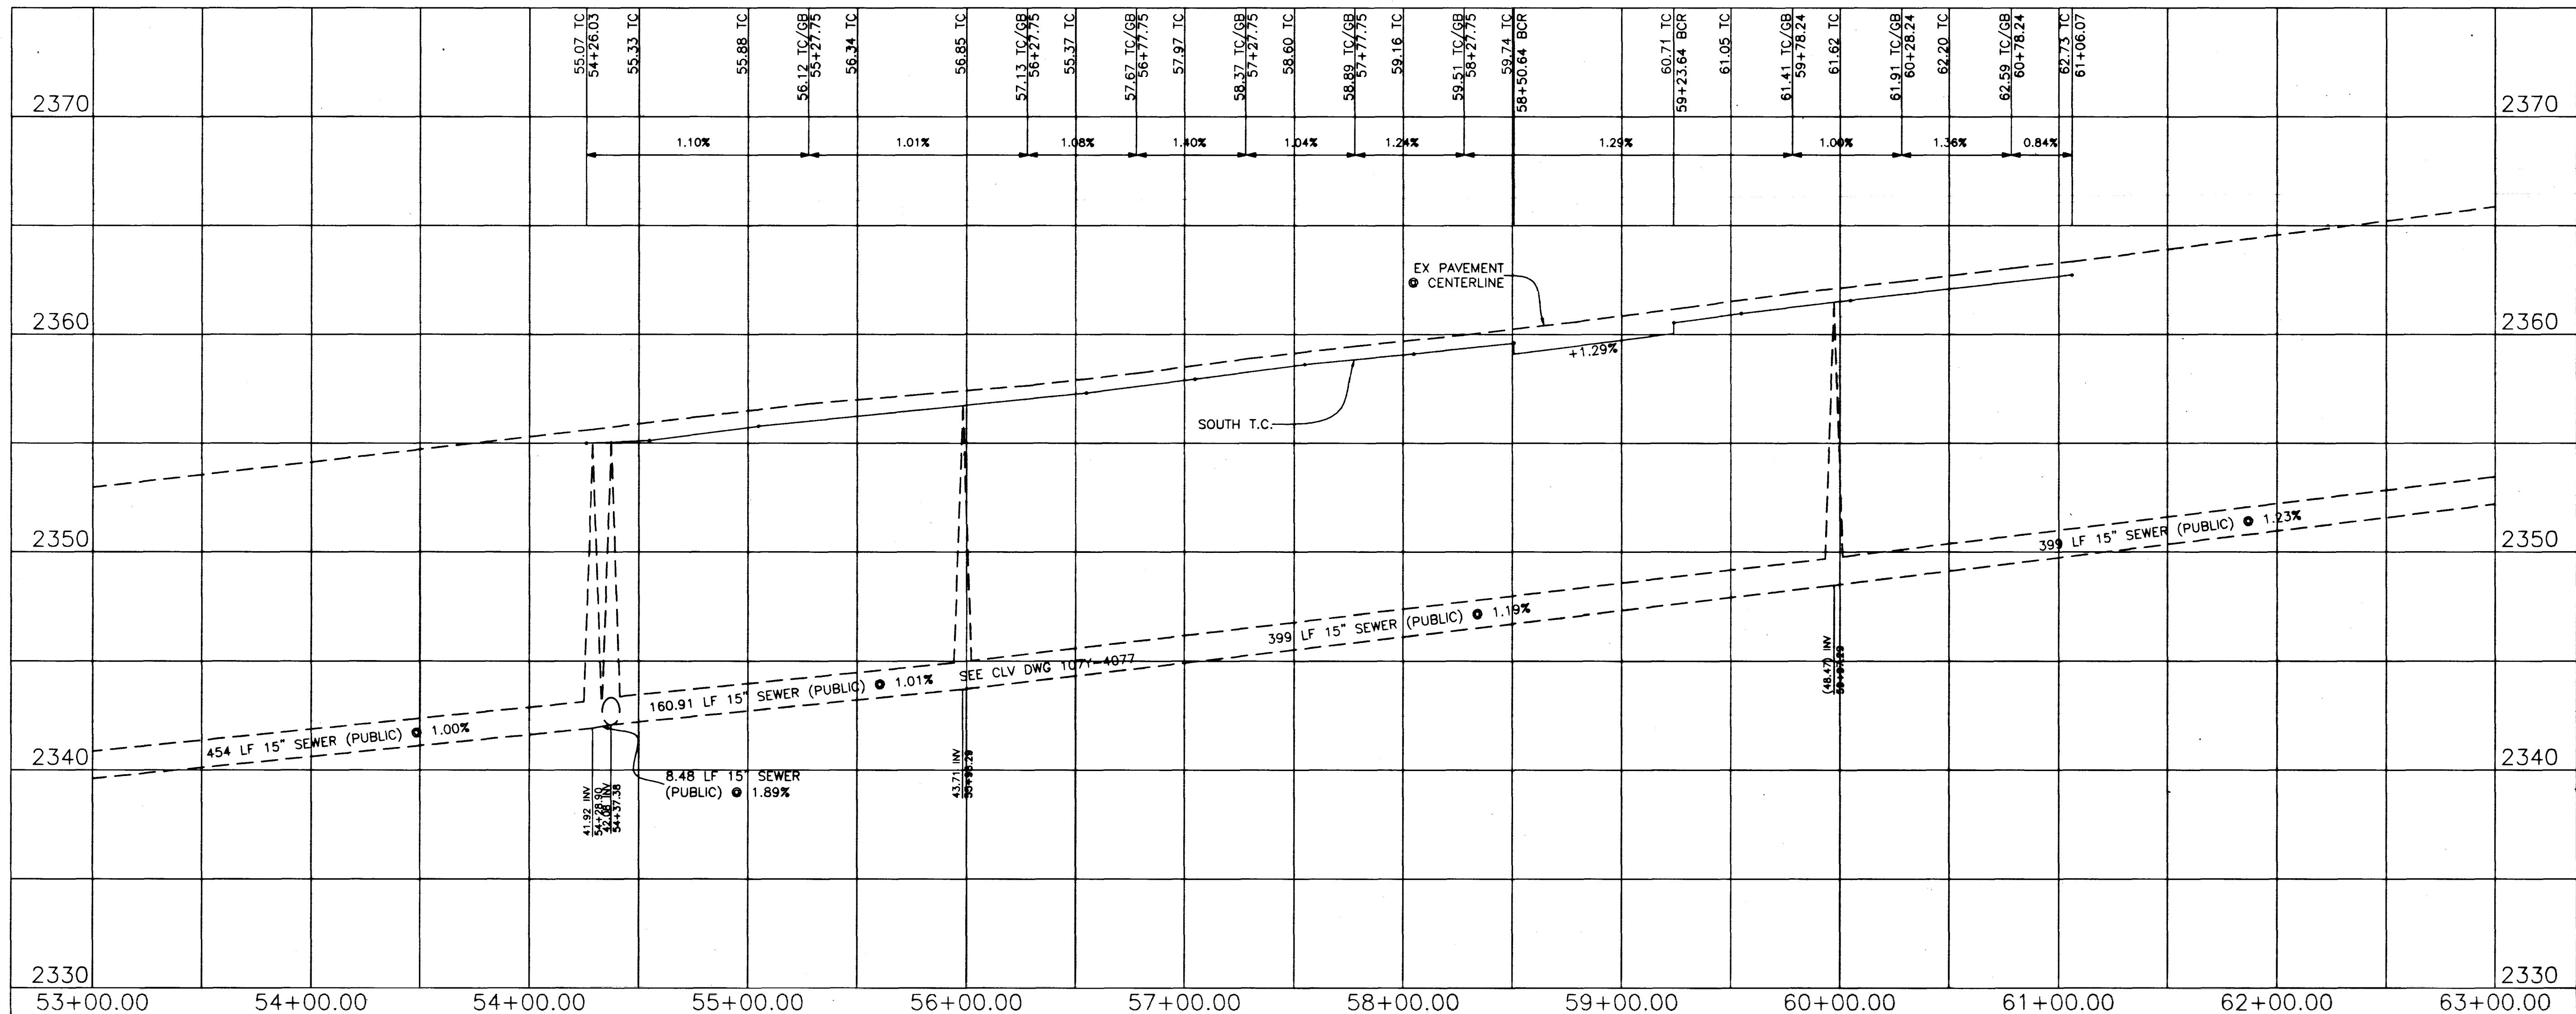

NO.	DATE	BY	REVISION	APPROVAL

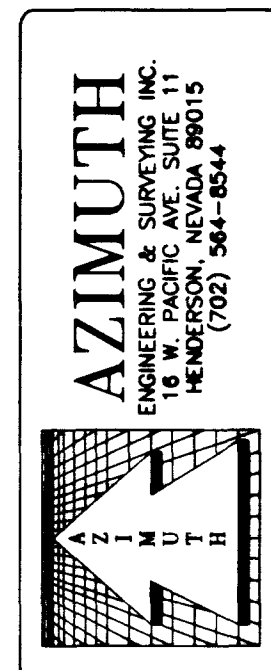

MEADOWS FELLOWSHIP CHURCH
ALEXANDER ROAD
PLAN & PROFILE

LAS VEGAS NEVADA

JOB NO:	96-005	DRAWN:	J.A.S.	CHECKED:	G.H.B.
DATE:	13 MAR 98				

