


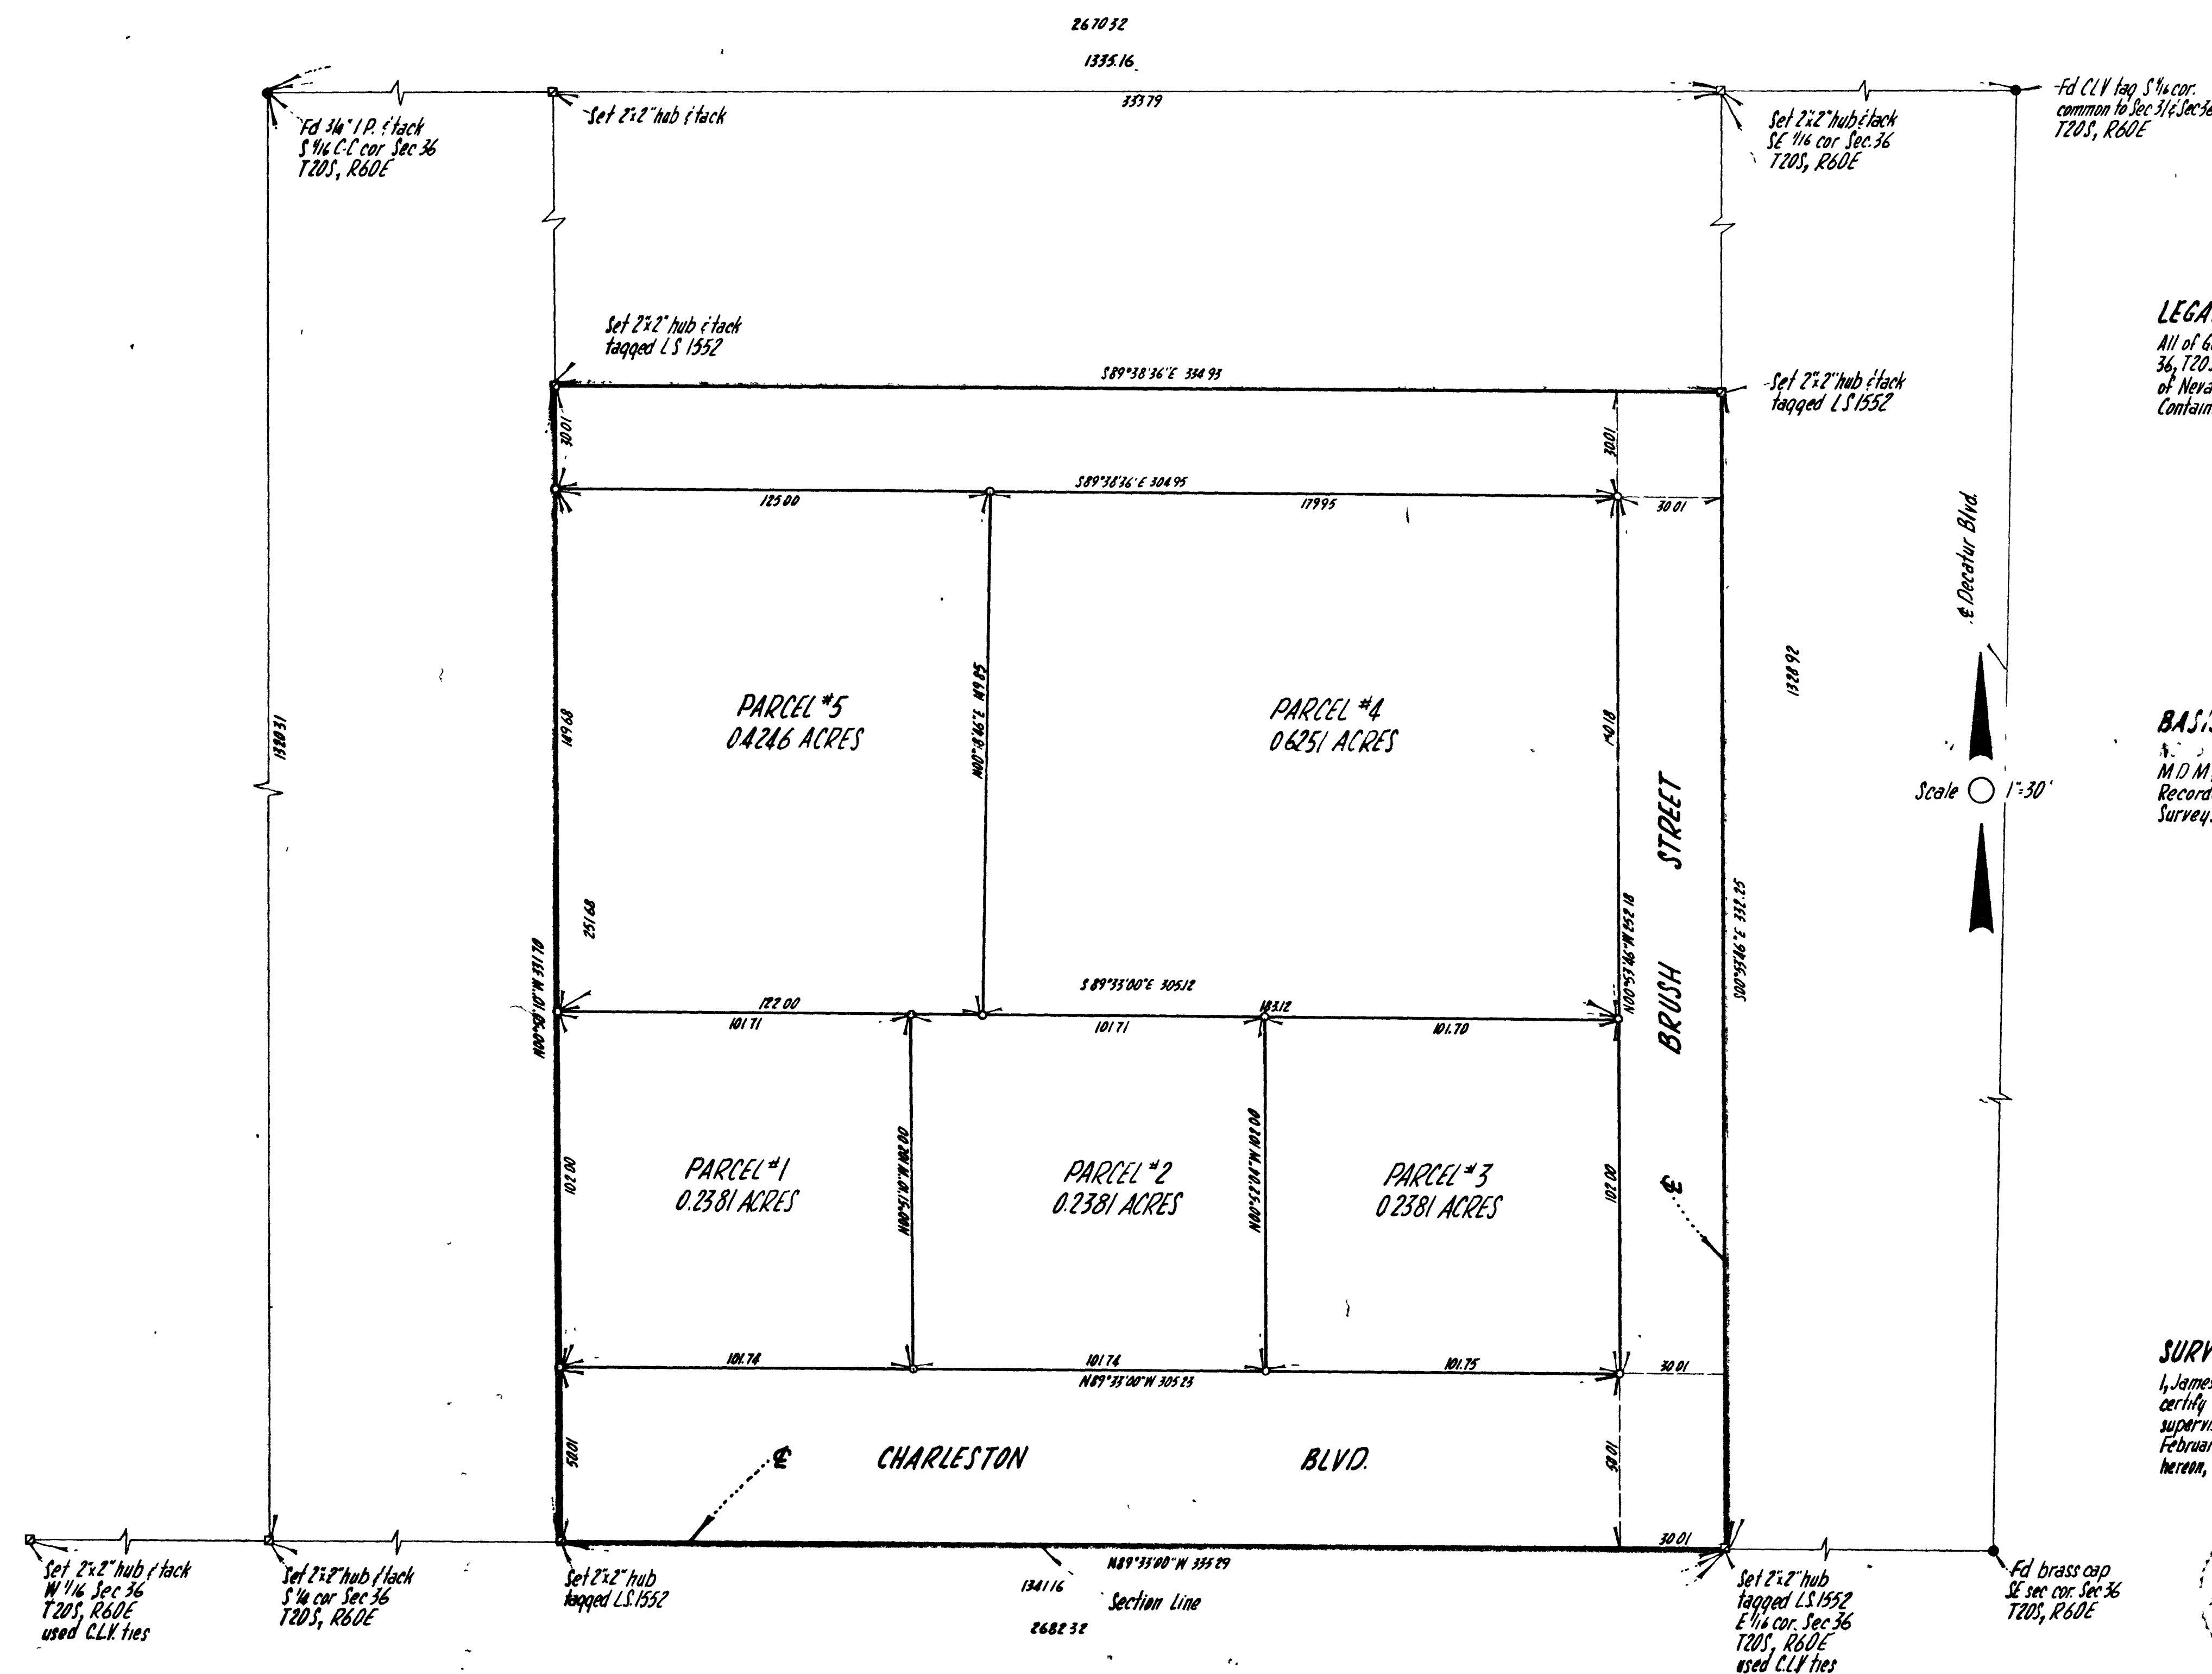

LEGAL DESCRIPTION

All of Government Lot 60 wholly within the SW 1/4 of the SE 1/4 of Section 36, T20S, R60E, M.D.M., Nevada, City of Las Vegas, County of Clark, State of Nevada
Containing 2.5533 Acres more or less

BASIS OF BEARING

A being the south line of the SE 1/4 of Section 36, T20S, R60E, M.D.M., Nevada as shown by map on file in the office of the County Recorder as Page 99 of File 8 of Registered Professional Engineers' Surveys.

SURVEYOR'S CERTIFICATE

I, James V. OLM, a duly Registered Land Surveyor in the State of Nevada, do hereby certify that the survey of the land shown hereon was made under my direct supervision at the instance of Ron Rudin; the survey was completed on February 27, 1963 and that the points found and set are correctly shown hereon; this plat is not intended to be a subdivision.

James V. OLM
Registered Land Surveyor
Nevada Certificate No. 1552

LEGEND
○ indicates 3/4" I.P. set
tagged L.S. 1552

VOORHEIS-TRINDLE COMPANY OF NEVADA

1125 FREMONT LAS VEGAS, NEVADA 89103

GOVERNMENT LOT 60, SECTION 36,
T20S, R60E, M.D.M., NEVADA

SCALE:
1" = 30'

DRAWN BY:
F. Huber

MAP FOR RECORD OF SURVEY FOR RON RUDIN

DATE
Feb. 27, 1963

DRAWING NO.
WD 201

NO. 343991

FILED AT THE REQUEST OF

JAMES V. OLM

Date 3-7-63 at 8:52 AM

FILE, 122, PAGE 65

of Survey

OFFICIAL RECORDS BOOK NO. 426

CLARK COUNTY, NEVADA, RECORDS

PAUL E. HORN, RECORDER

Fee \$22.50 J.S.L. Deputy

055-380

FILE 12 MAR 65

055-380

