
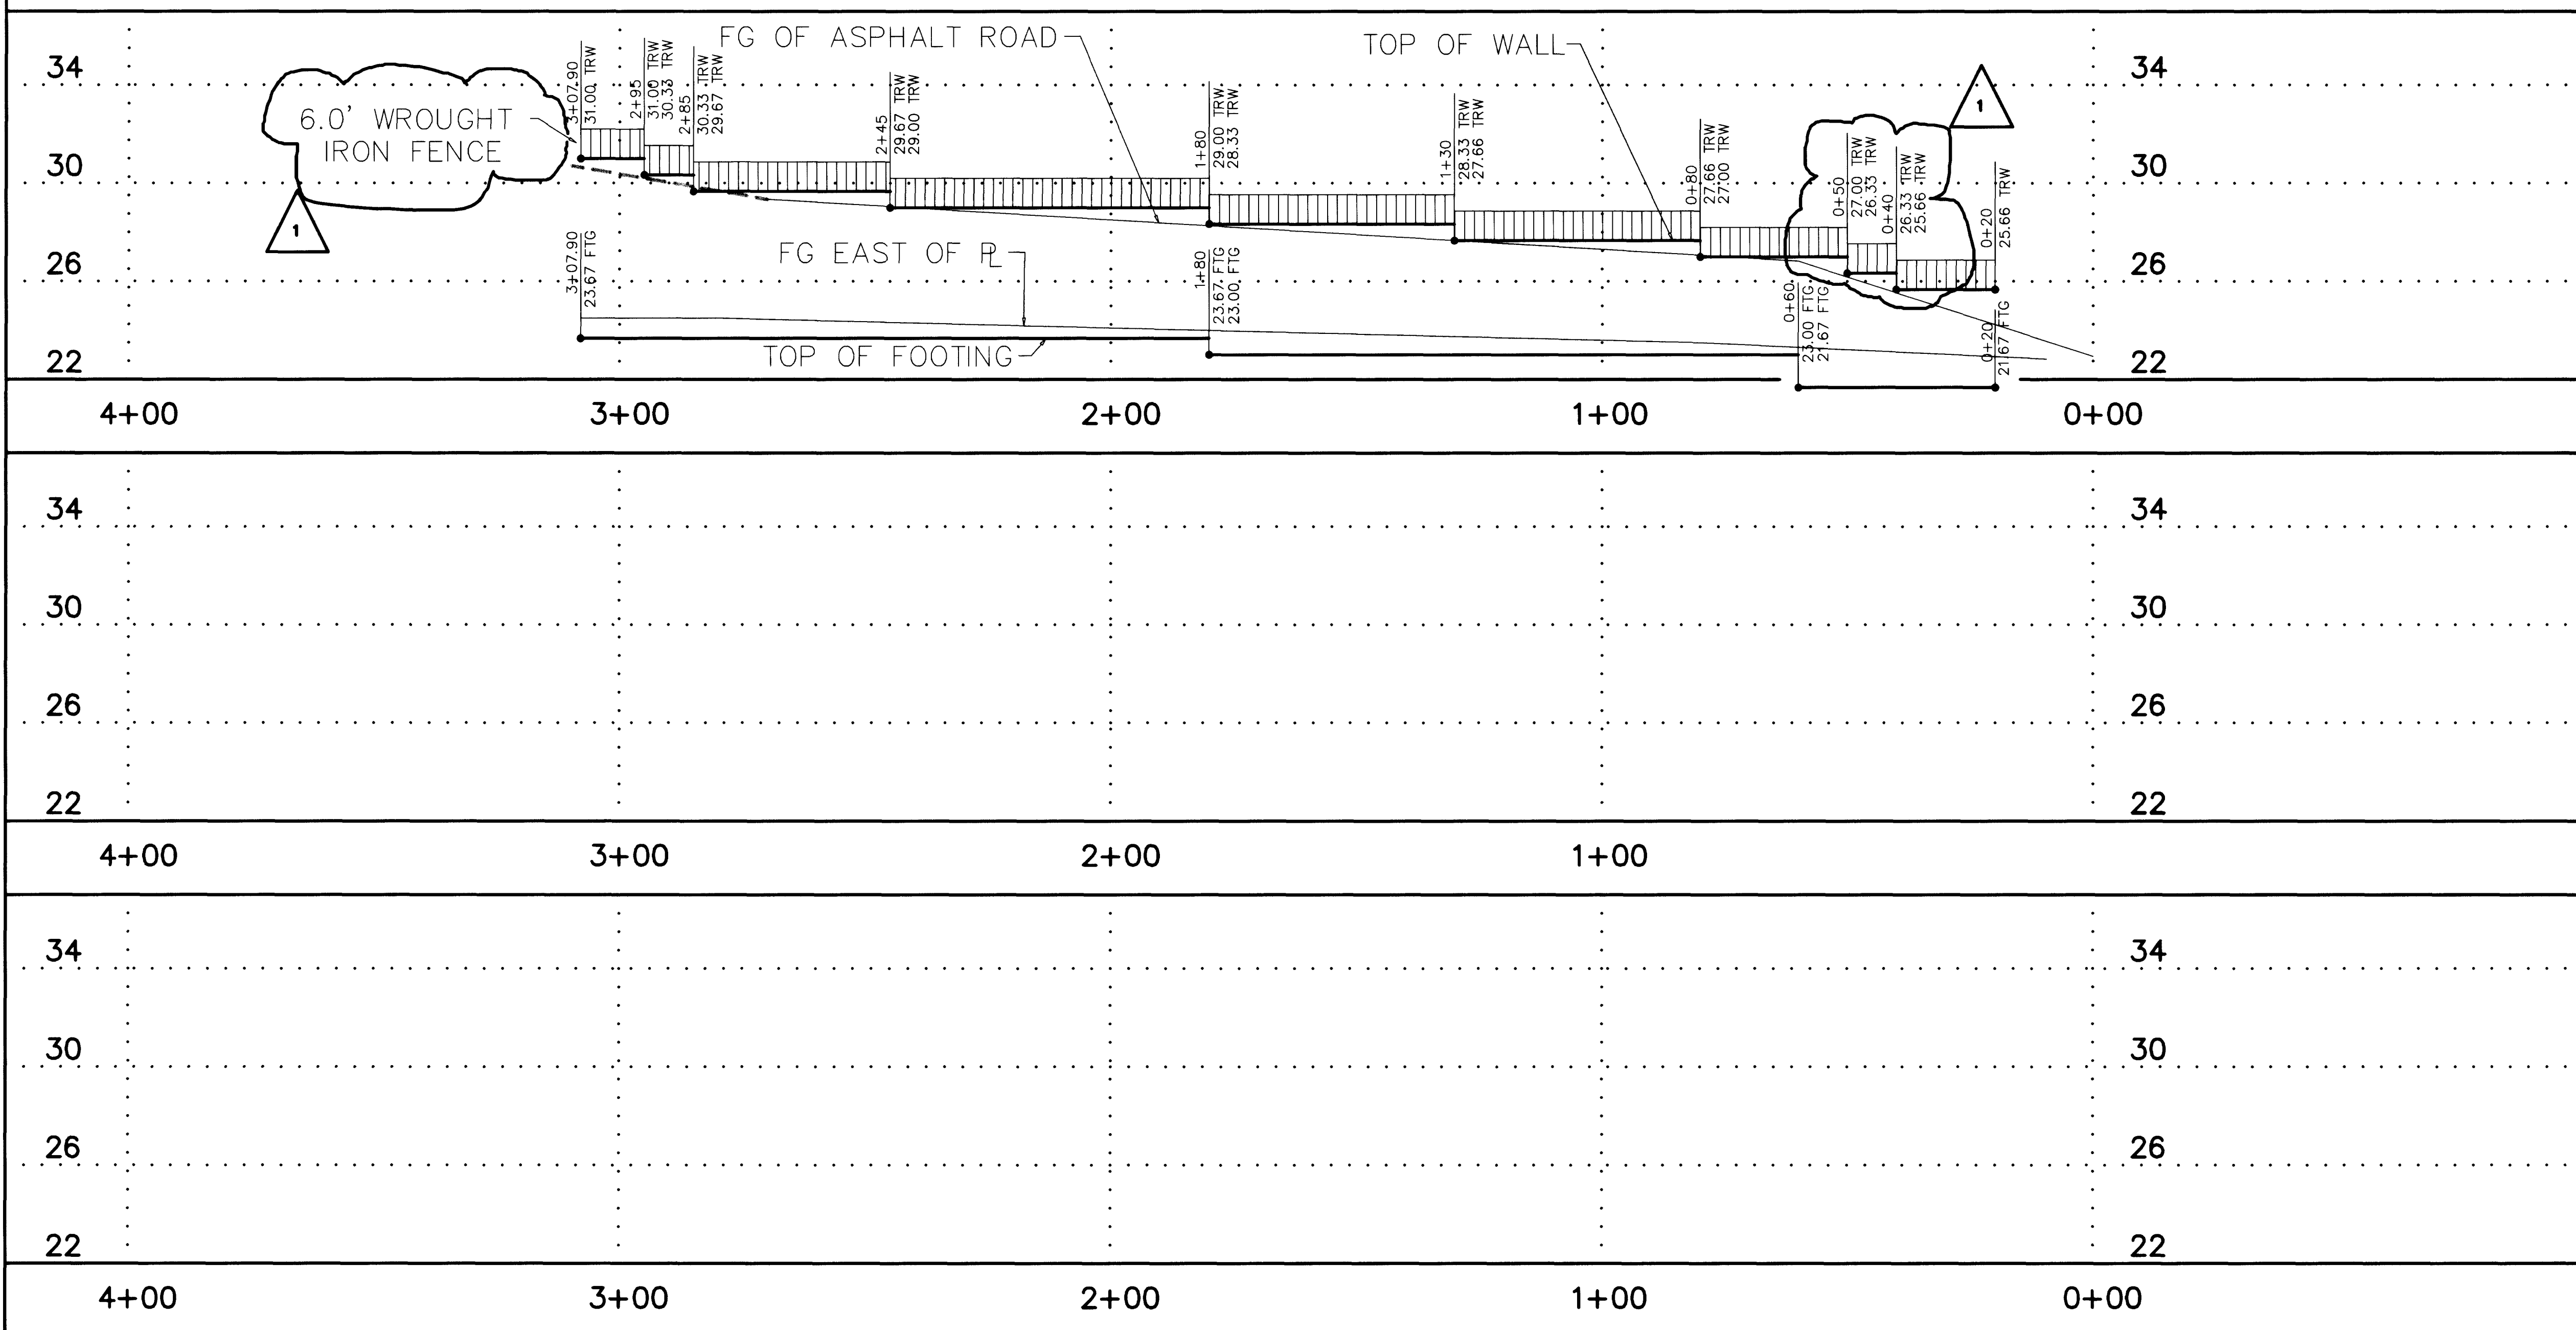
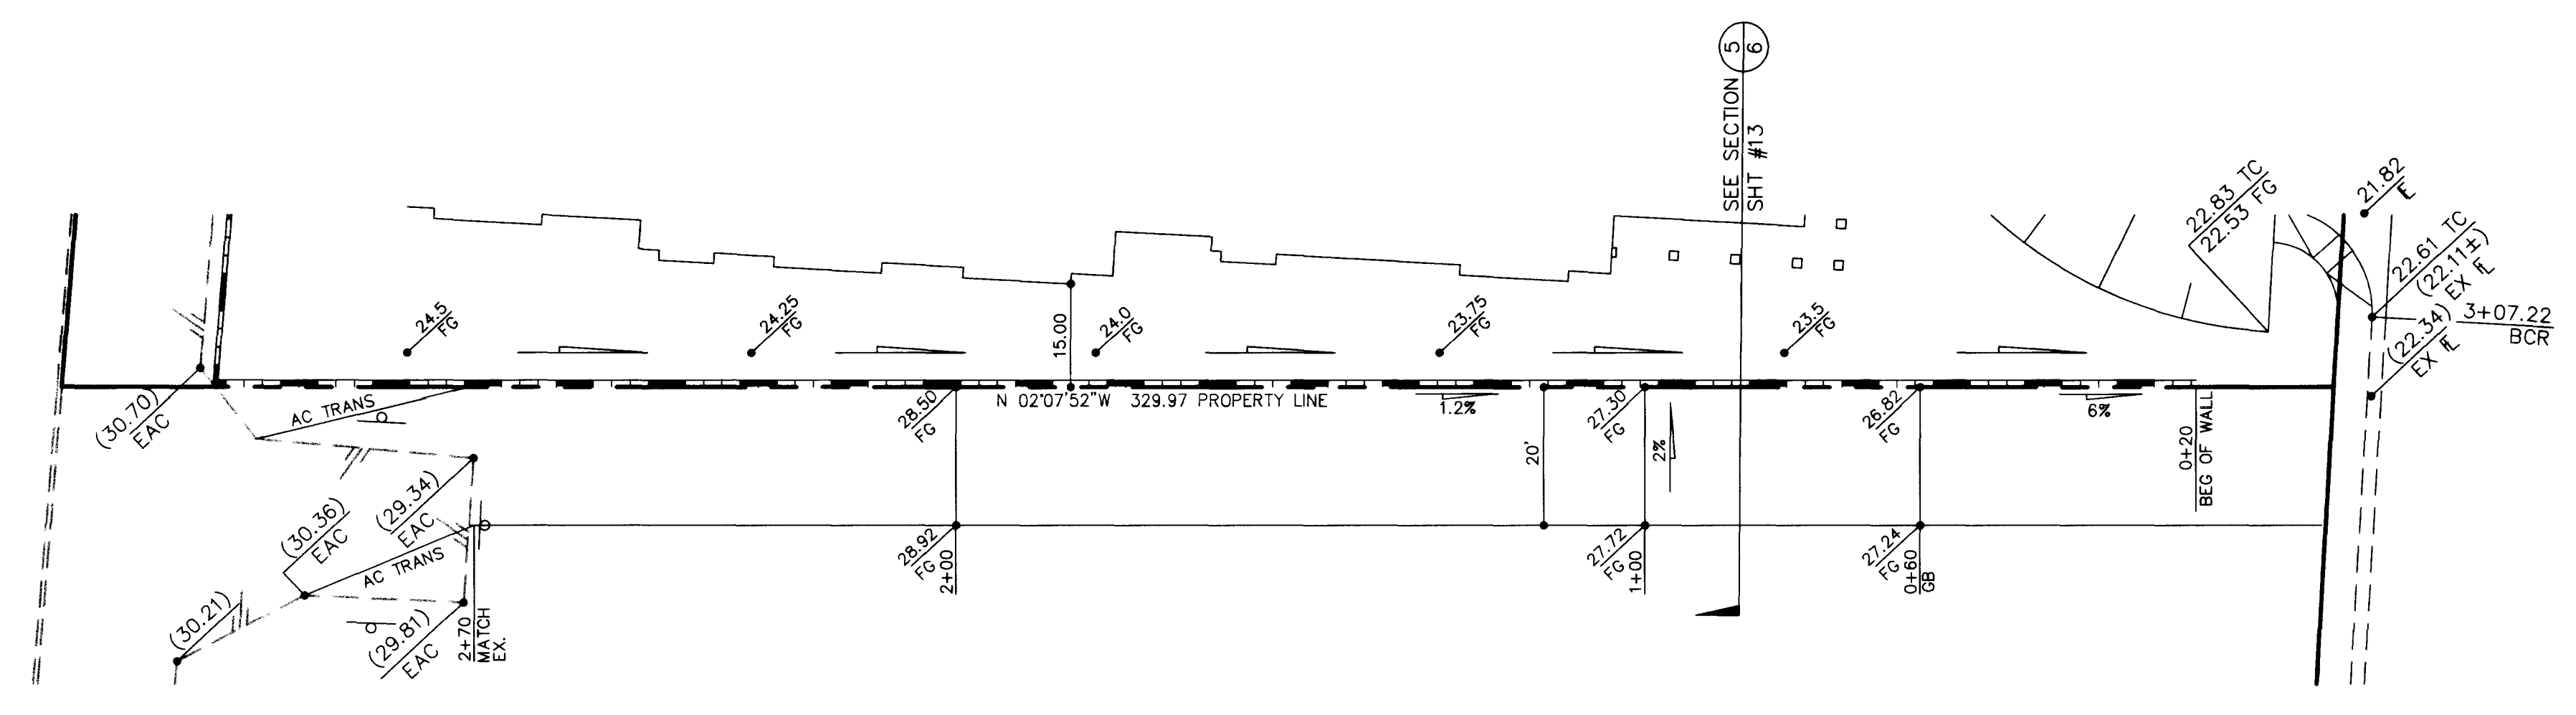


Avoid cutting underground utility lines. It's costly.
 Call before you Dig.
 1-800-227-2600

BASIS OF BEARINGS
 S 88 51'13" E, BEING THE SOUTH LINE OF THE SW 1/4 SECTION 8, T.21S., R.60E., M.D.M., AS SHOWN IN BOOK 73, PAGE 90, OF PLATS.

BENCHMARK
 CITY OF LAS VEGAS BENCH MARK # 1LV10 7SES BEING A RIVET AND PLATE IN THE TOP OF CURB NW RETURN OF DESERT INN ROAD AND FORT APACHE ROAD. ELEV=832.1847 METERS (2730.26 FEET) NAVD 88

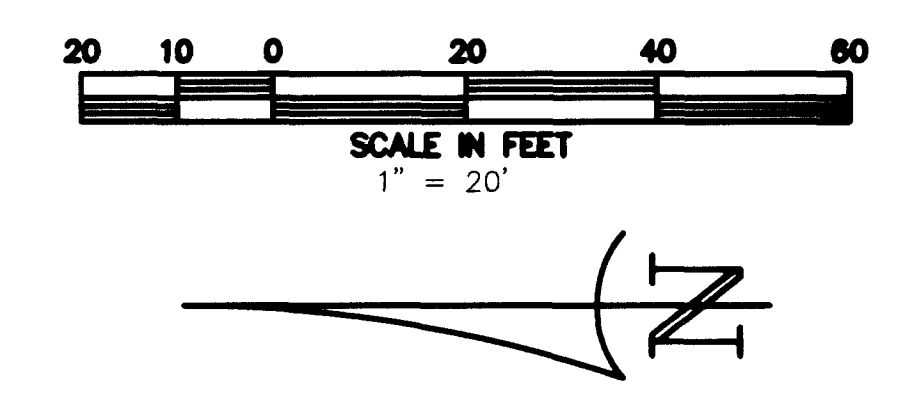

GALLAHER CONSTRUCTION, INC. 9066 BROOKS ROAD SOUTH WINDSOR, CA, 95492 (707) 836-0473		ADD WROUGHT IRON FENCE REV'D DATE BY
DUNNAM CIVIL ENGINEERS 3305 SPRING MOUNTAIN ROAD SUITE B2 LAS VEGAS, NV 89102 (702) 367-0588 (702) 367-8145 FAX		REV'D DATE BY
SHEET: RETAINING WALL PLAN & PROFILE TITLE: OAKMONT RETIREMENT COMMUNITY #4		SCALE: 1" = 20' HOR. 1" = 4' VERT.
DRAWN BY:	DESIGNED BY:	CHECKED BY:
PROJECT NO.: GALL.D3C		
SHEET SD3 11 OF 13 SHEETS DRAWING NO. 107-V2893		

14654




GALL 3SD3
 1" = 20'

Re-plot




BASIS OF BEARINGS

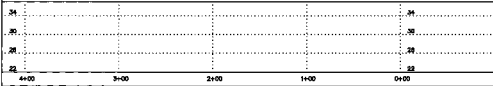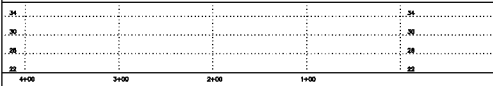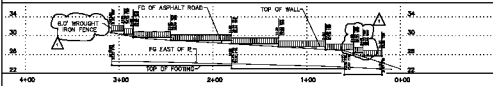

