OESTE VILLAS – UNIT 4

A PORTION OF THE W. 1/2 OF THE W. 1/2 OF THE SE. 1/4 OF SEC. 24,T. 20 S.,R. 60 E.,M.D.M., CITY OF LAS VEGAS,CLARK COUNTY,NEVADA

MONUMENT TIE MAP

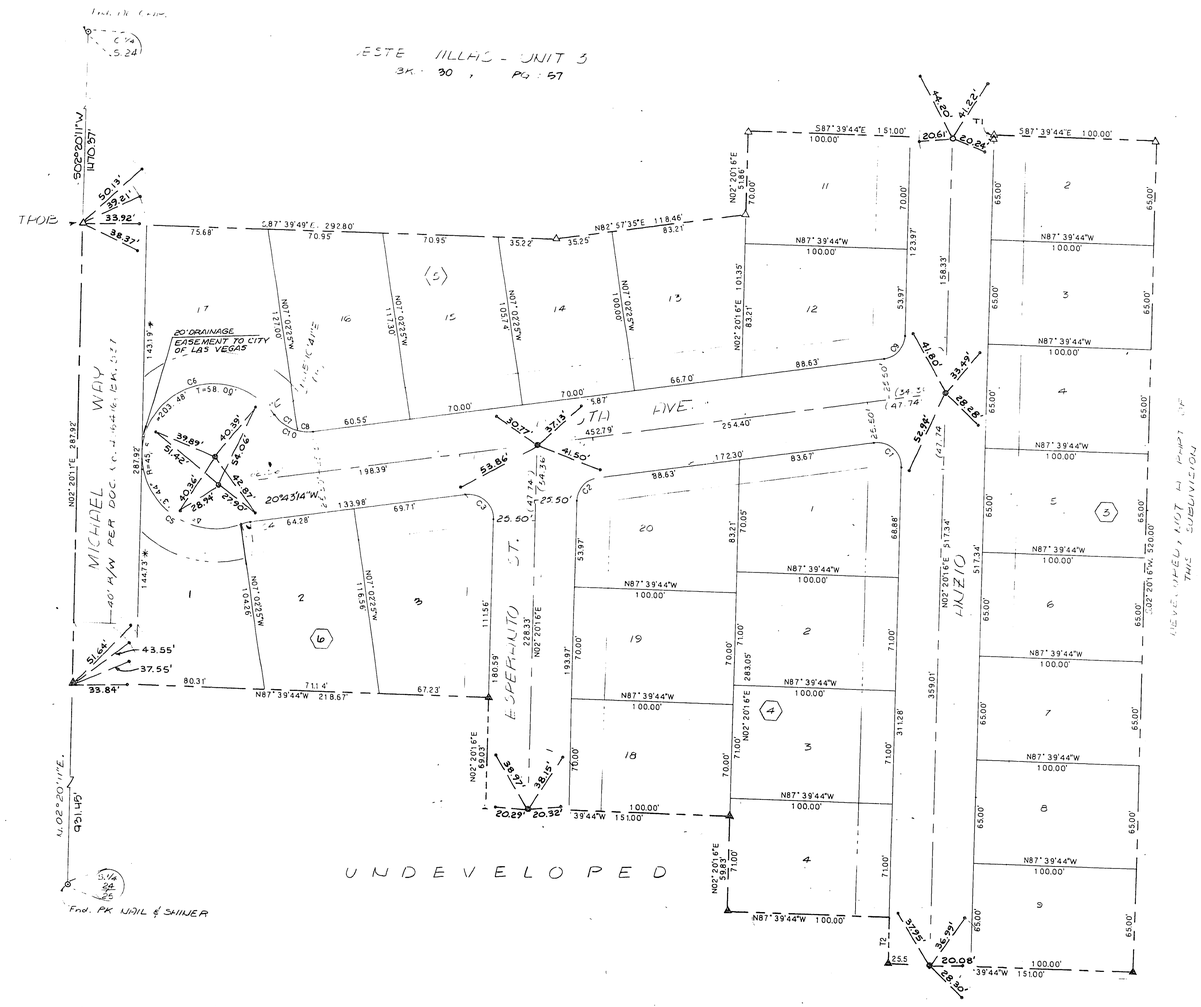

LEGEND

- ⊙ FOUND MONUMENT AS NOTED
- △ FOUND 1/2" REBAR
- ▲ SET 5/8" REBAR W/ CAP STAMPED "RCE 6201"
- ○ FOUND 5/8" REBAR W/ CAP STAMPED "RCE 4146"
- • SET 5/8" REBAR W/ CAP STAMPED "RCE 6201"
- 15 LOT NUMBER
- (5) BLOCK NUMBER
- C-6 CURVE NUMBER
- T-1 TIE NUMBER
- (M) [illegible]
- ← TIE- SET BRASS CAP IN T.C.

CURVE DATA

NO	DELTA	RADIUS	LENGTH	TAN
C1	99°12'41"	15.00'	26.02'	17.68'
C2	80°37'19"	15.00'	21.10'	12.41'
C3	99°22'41"	15.00'	26.01'	17.68'
C4	13°40'49"	75.00'	17.91'	9.00'
C5	113°03'25"	45.00'	88.78'	68.83'
C6	143°10'19"	45.00'	112.40'	136.67'
C7	40°19'49"	75.00'	52.80'	27.58'
C8	22°13'06"	75.00'	29.09'	14.71'
C9	80°37'19"	15.00'	21.10'	12.41'
C10	62°32'56"	25.00'	27.28'	15.18'

LINE DATA

NO	BEARING	DISTANCE
T1	N02°20'16"E	20.61'
T2	N02°20'16"E	19.41'
T3	N07°02'25"W	18.00'

* NOTE: THERE SHALL BE A PRIVATE ACCESS TO MICHEL WAY FOR LOT 17, BLOCK 5, AND LOT 1, BLOCK 6.

SURVEYOR'S CERTIFICATE

I, GENE KRAMETBAUER, A DULY REGISTERED LAND SURVEYOR IN THE STATE OF NEVADA, DO HEREBY CERTIFY THAT THE MONUMENTS HAVE BEEN SET AND THE TIE DISTANCE ESTABLISHED AS SHOWN HEREON. THIS SURVEY WAS COMPLETED ON FEBRUARY 25,1987

Gene D. Krametbauer

GENE D. KRAMETBAUER, R.L.S.
NEVADA CERTIFICATION NO.: 6201

3/11/87

SHEET 2 OF 2
W.O № 2721-4

OESTE VILLAS-UNIT4 Bk. 31, Pg. 20
05E-2303-4