

4-6-161

# PAINTED DESERT

## A PLANNED RESIDENTIAL DEVELOPMENT

A PORTION OF THE N1/2 AND THE SE1/4 OF SECTION 34 AND A PORTION OF THE N1/2 OF SECTION 33, T 19 S, R 60 E, M.D.M., CITY OF LAS VEGAS, CLARK COUNTY, NEVADA.


**SURVEYOR'S CERTIFICATE**  
 THIS IS TO CERTIFY THAT THE MONUMENTS HAVE BEEN SET AND TIES ESTABLISHED AS SHOWN HEREON.

KAY L. ADAMS  
 REGISTERED LAND SURVEYOR  
 NEVADA CERTIFICATE NO. 2050

*Kay L. Adams*  
 2/6/89

### LEGEND

- ◆ SET BRASS CAP & CONC. IN WELL (TYPE I)
- ▲ SET BRASS CAP & CONC. (TYPE II)
- ⊙ SET REBAR & AL. CAP
- X SET CHISELED 'X' IN TOP OF ROCK
- SET BRASS CAP IN TOP OF CURB (TYPE III A)

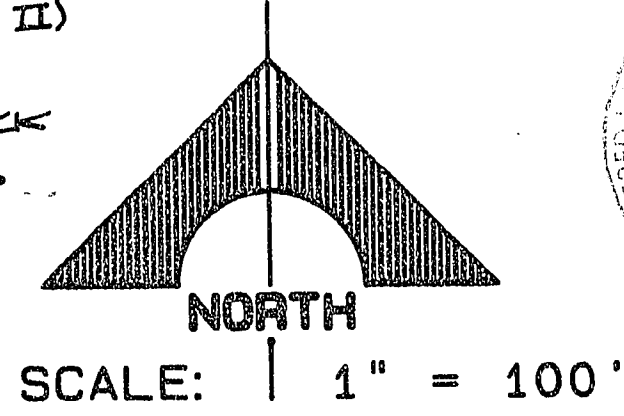

LINE	BEARING	DISTANCE
1	S 05°58'47"E	70.00
2	S 01°00'13"W	140.00
3	N 37°30'13"E	60.00
4	S 00°30'22"W	30.00
5	S 00°30'22"W	15.00

CURVE	DELTA	ARC	RADIUS	TANGENT
1	89°59'59"	23.58	15.00	15.00
2	12°02'54"	111.78	534.58	56.10
3	13°02'54"	184.51	722.38	82.64
4	4°09'35"	10.00	137.69	5.00
5	4°09'35"	10.00	137.69	5.00
6	12°02'54"	127.34	605.58	63.91
7	13°02'54"	147.66	848.38	74.15
8	88°30'59"	220.92	143.00	139.34
9	4°09'35"	10.00	137.69	5.00
10	4°09'35"	10.00	137.69	5.00
11	48°11'40"	12.62	15.00	6.71
12	26°31'19"	188.64	380.00	84.64
13	12°02'54"	119.56	568.56	60.00
14	13°02'54"	156.09	685.38	78.38
15	2°40'23"	10.23	249.31	5.12
16	2°15'36"	9.80	248.49	4.90
17	2°40'23"	10.00	244.31	5.00
18	2°15'36"	10.00	253.49	5.00
19	55°00'00"	345.58	360.00	187.40
20	55°00'00"	321.58	335.00	174.39
21	55°00'00"	297.58	310.00	161.38
22	28°28'41"	178.93	360.00	91.18
23	41°48'19"	10.94	15.00	5.73

