


00895

PALISADES ESTATES PHASE II

MONUMENTATION PLAN

THE E. 1/2 OF THE S.W. 1/4 OF THE N.E. 1/4 OF SECTION 4, T. 21 S., R. 60 E., M.D.B. & M., CITY OF LAS VEGAS, STATE OF NEVADA

J. JOHN R. RINALDI, A duly registered land surveyor in the State of Nevada, do hereby certify that the monumentations shown hereon, and was completed on September 30, 1988.

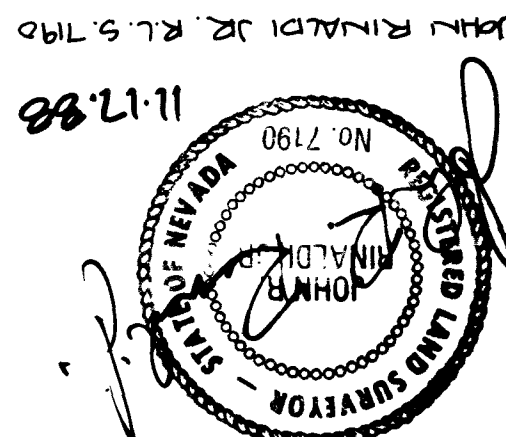



CURVE TABLE:

STATION	DELTA	RADIUS	TAN LENGTH
32.00	1.00	80.00	81.84
33.00	1.00	80.00	81.84
LINE TABLE:

LINE NUMBER	BEARING	DISTANCE
1	N 4° 05' 34" E	30.18
2	N 4° 05' 34" E	30.18
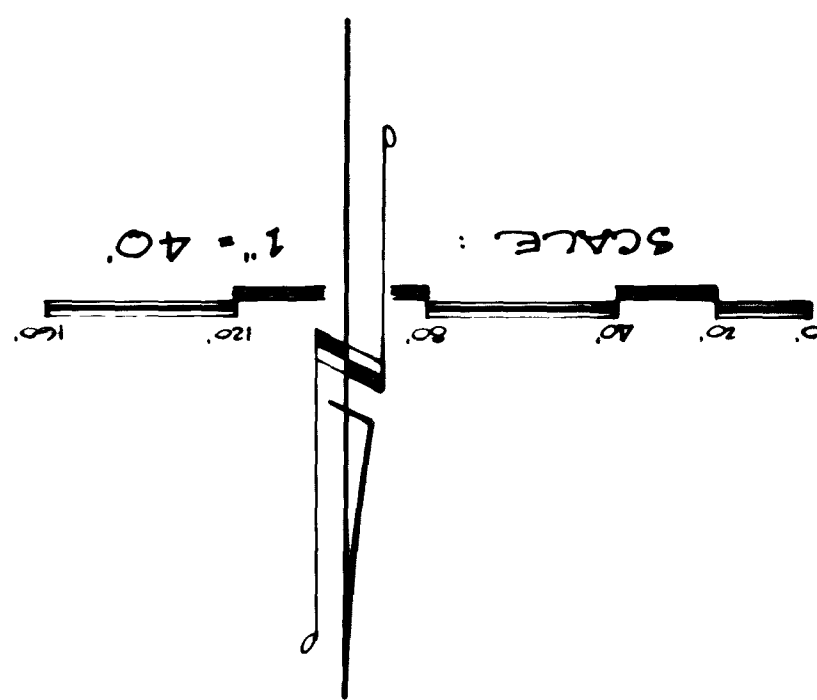

- LEGEND:
- MONUMENTS FOUND AS NOTED
 - SET RECORDED & ALL CAP R.L.S. 7180 WITH BEARS CAP THIS
 - RECORD INFORMATION PER SOURCE INDICATED
 - () RECORD OF SURVEY FILE 23, PAGE 80
 - R-3 PLACED MAP FILE 47, PAGE 19
 - BOUNDARY SET BACK LINE
 - TYPICAL LOT NUMBER
 - CURVE DATA (SEE TABLE)
 - CURVE DATA (SEE TABLE)
 - PUBLIC UTILITY & SEWER EASEMENT
 - SET BEARS CAP THE MON. IN TOP OF CURB
 - BEARS CAP THE MON. IN TOP OF CURB

BASIS OF BEARINGS: THE SOUTH LINE OF THE N.E. 1/4 OF THE S.W. 1/4 OF SECTION 4, T. 21 S., R. 60 E., M.D.B. & M., CITY OF LAS VEGAS, STATE OF NEVADA, BEING ALSO THE CENTERLINE OF O'BANNON AVE. AND NOTED AS N. 88° 47' 33" W. ON THAT FINAL MAP OF PALISADES ESTATES PER BK. 21 PG. 11

