


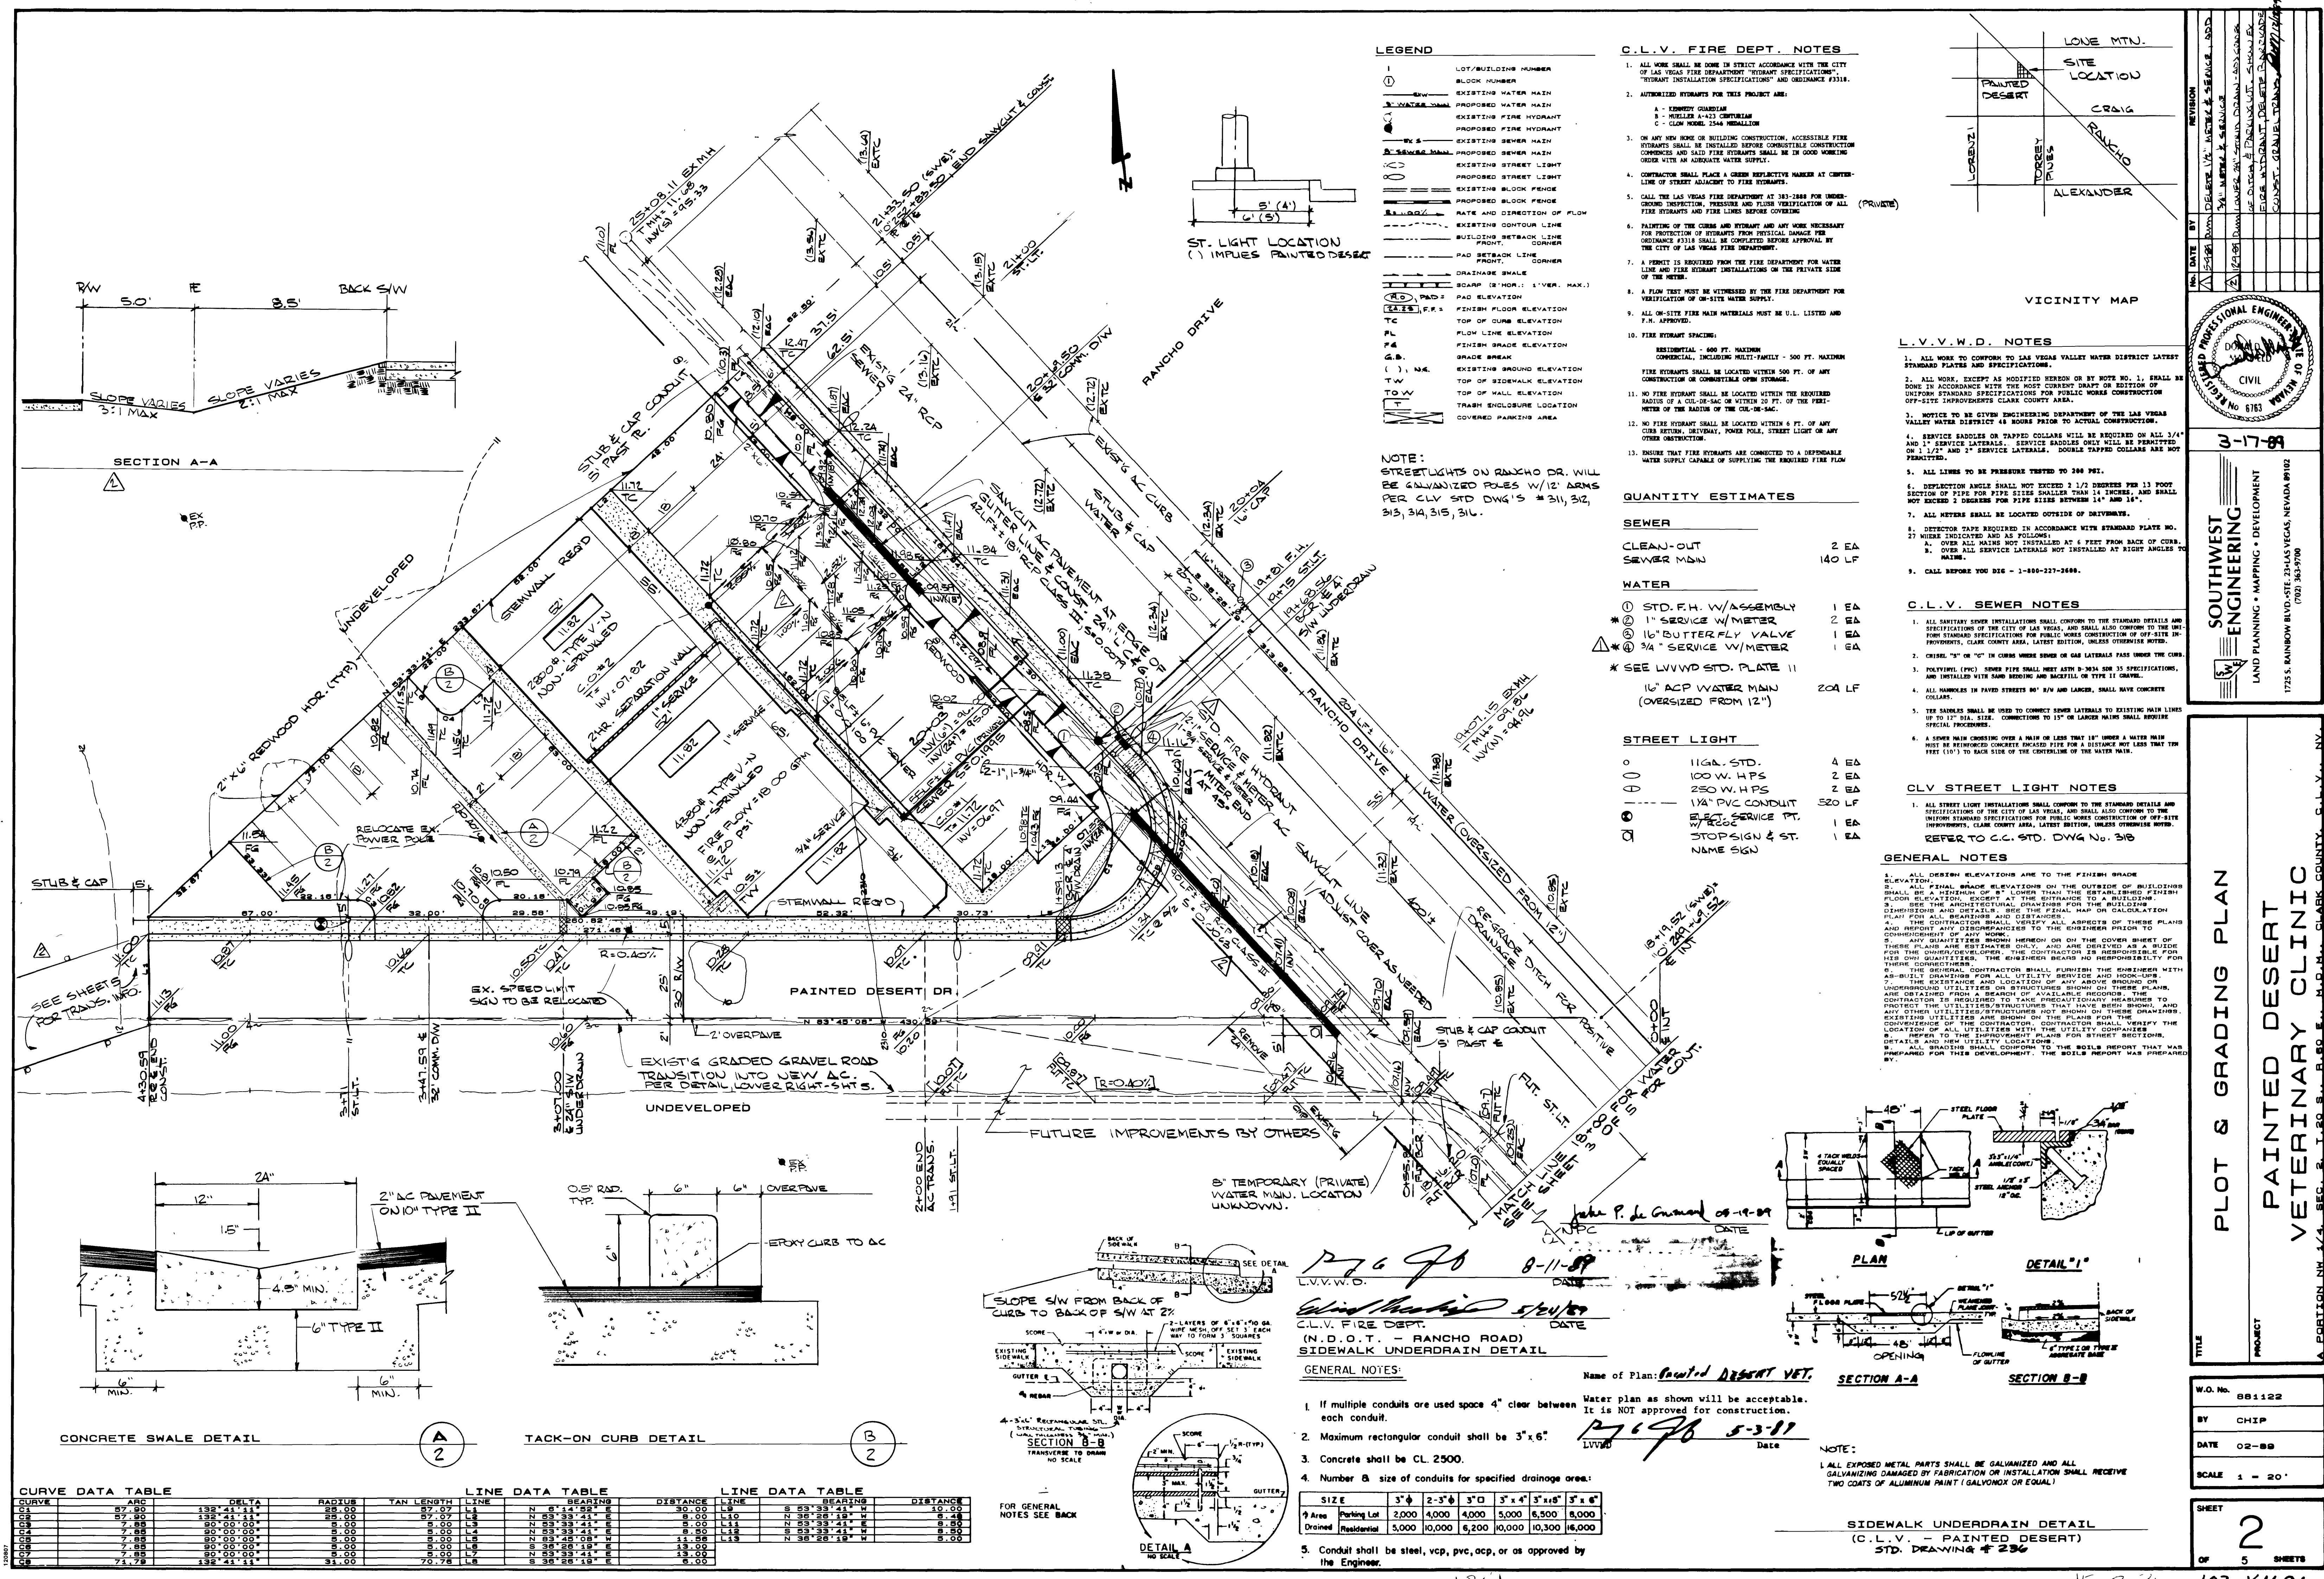


SIDEWALK UNDERDRAIN DETAIL						

PROFESSIONAL ENGINEER
CLARK COUNTY, NEVADA
3-17-89

SOUTHWEST ENGINEERING
LAND PLANNING • GRADING • DEVELOPMENT
1725 S. RAINBOW BLVD. STE. 200 LAS VEGAS, NEVADA 89102
(702) 363-9700

PLOT & GRADING PLAN
PAINTED DESERT VETERINARY CLINIC
A PORTION NW 1/4, SEC. 2, T.20 S., R.40 E., N.M.M., CLARK COUNTY, N.V.

W.O. No. 881122
BY CHIP
DATE 02-89
SCALE 1" = 20'
SHEET 2 OF 5 SHEETS

