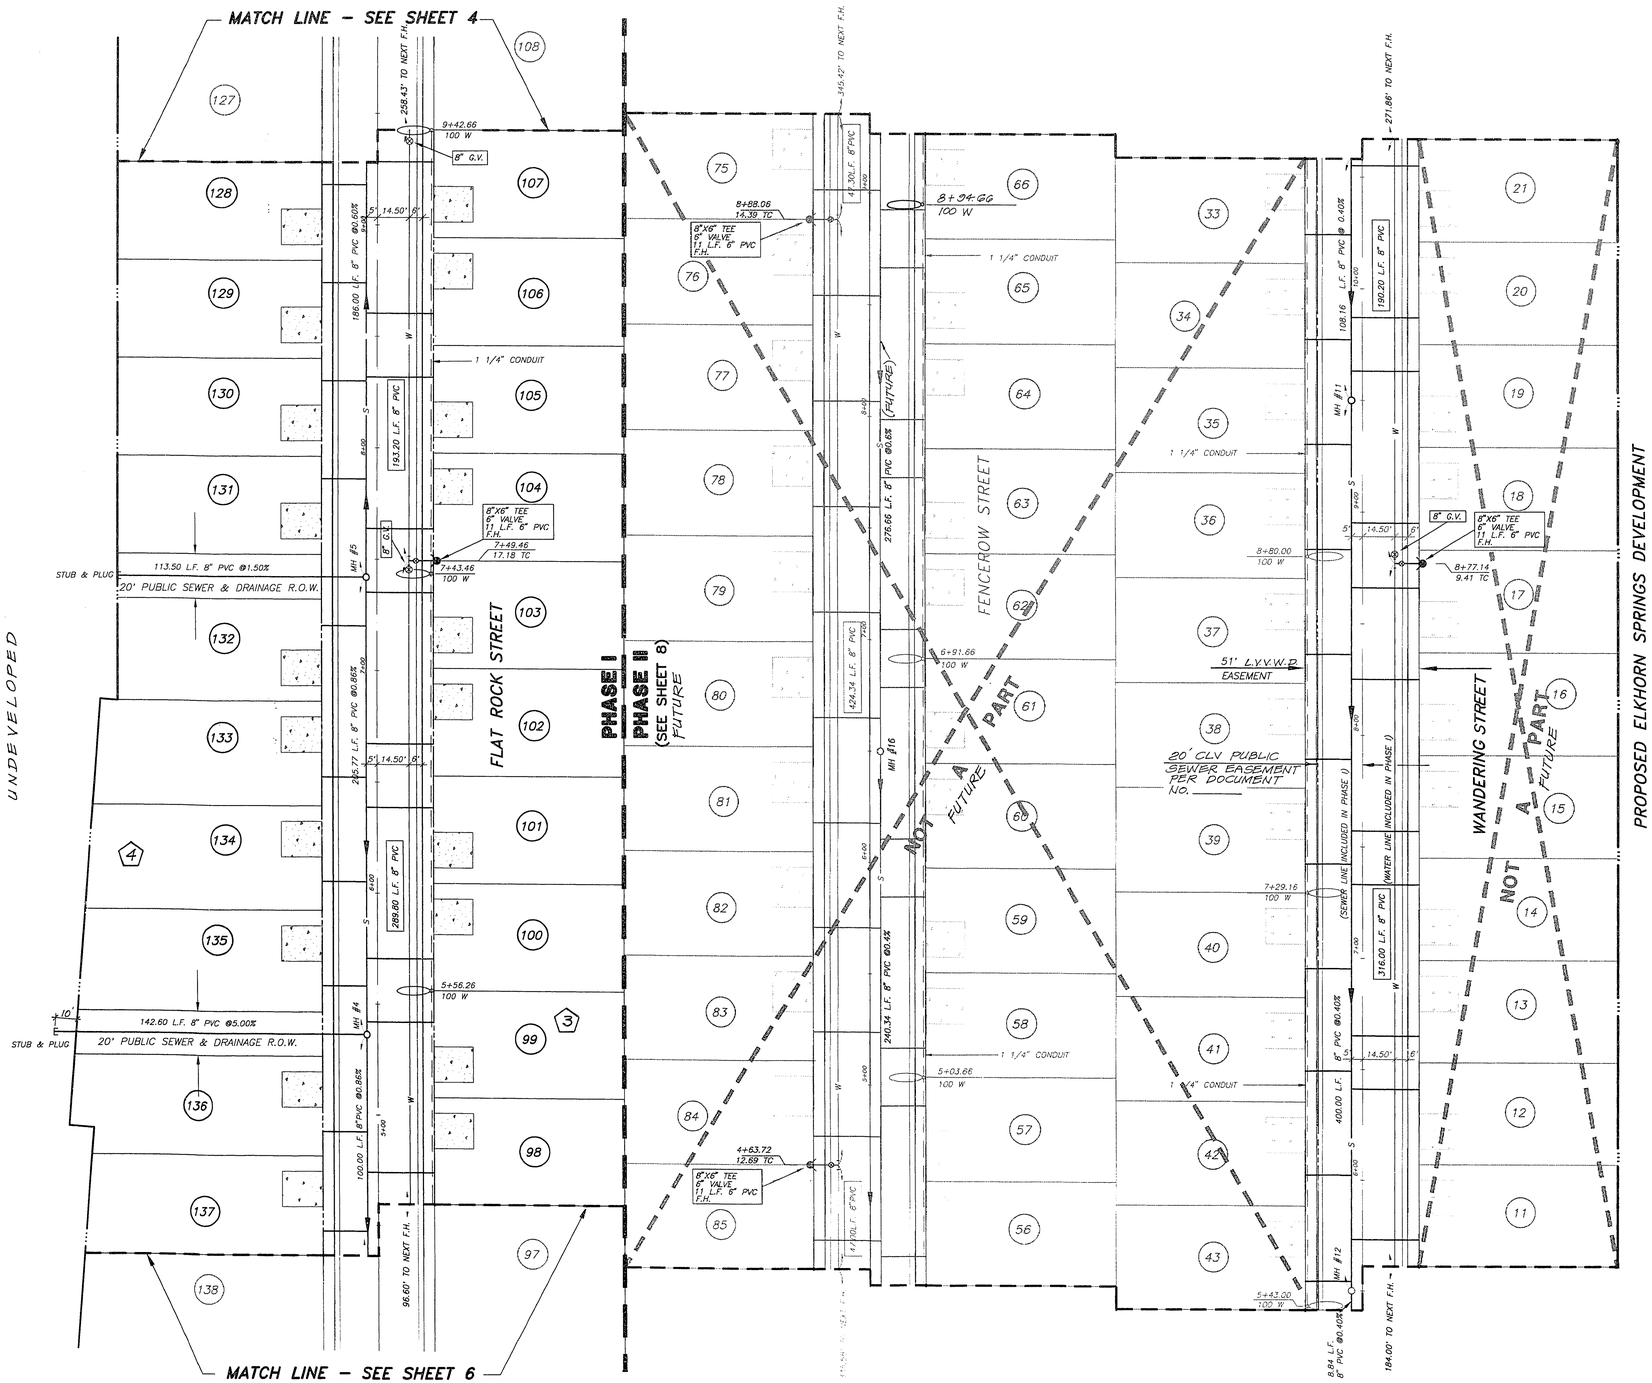

NORTH
SCALE: 1" = 30'

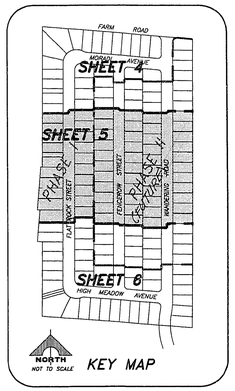

APPROVED FOR CONSTRUCTION

LAS VEGAS VALLEY WATER DISTRICT — DATE 4/25/95

REV	DATE	DESCRIPTION	C.L.V.	DATE

RECOMMENDED FOR APPROVAL — SONNY WALLACE, P.E. No. 10118 — DATE 1-25-95

G.C. WALLACE, INC.
Engineering/Architecture
1555 SOUTH RAINBOW BLVD/LAS VEGAS, NEVADA 89102

STANPARK HOMES OF NEVADA
ORCHARD VALLEY PHASE I
UTILITY PLAN II – PHASE I

SHEET 5 OF 24 SHEETS

JOB NO. 727.018 PLOTTED: 12/14/94 DV-5.DWG RRS

11-20-46

307Y-4391-1