
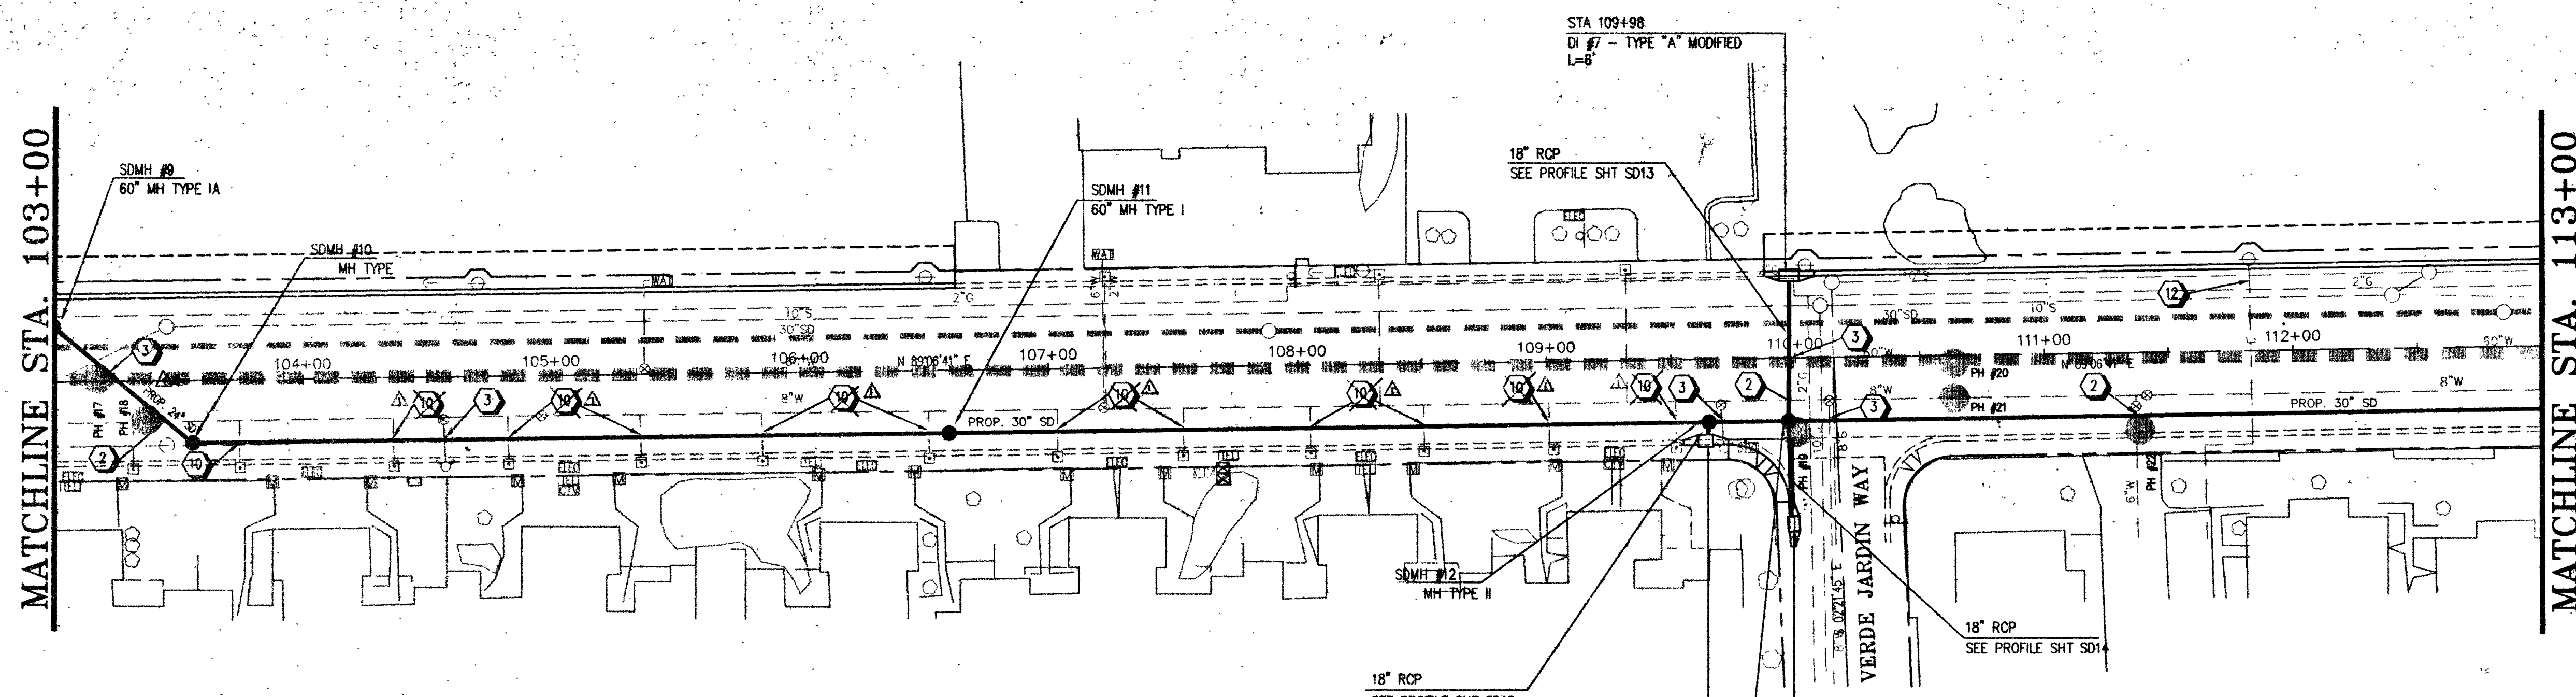


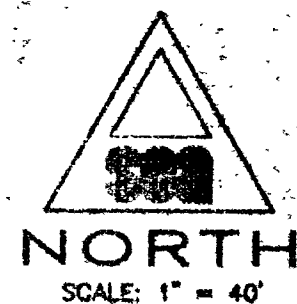

CONSTRUCTION NOTES


- SEE SANITARY SEWER (SS) SHEETS FOR WATERLINE RELOCATION.
- DEPRESS WATERLINE. SEE DETAIL SHEET D2.
- ENCASE SD WITH 4" MIN. CONCRETE ENCASUREMENT TO 10" MIN. EACH SIDE OF WATERLINE. SEE SHEET D2.
- SEE SANITARY SEWER (SS) SHEETS FOR GAS RELOCATION BY SW. GAS.
- PLUG AND ABANDON STORM SEWER.
- 2" GAS LINE TO BE RELOCATED BY S/W GAS CORP FROM APPROXIMATELY STA 66+45 TO 76+25, STA 101+00 TO STA 101+60, STA 109+70 TO STA 110+30 AND STA 115+30 TO STA 115+90.
- CONNECT TO EXISTING MANHOLE (NO EXISTING STUBOUT) RECONSTRUCT MANHOLE AS REQUIRED.
- REMOVE EXISTING INLET.
- PLUG AND CAP EXISTING CULVERT.
- RELOCATE WATER SERVING LATERAL:
A. IF POLYETHYLENE, REMOVE AND REPLACE PER SPEC'S
B. IF COPPER, REPAIR AND ADJUST
- REMOVE & REPLACE L-TYPE CURB & GUTTER (STD. DWG. NO.216)
- CAUTION: THESE ARE ENERGIZED CABLES. A NPC QUALIFIED REPRESENTATIVE MUST BE PRESENT DURING CONSTRUCTION IN OR AROUND THIS EQUIPMENT. CALL 657-4117 FOR AN APPOINTMENT 48 HOURS PRIOR.

NOTE:
1. REFERENCE POTHOLE TABLE ON SHEET 2.
2. SEE CORRESPONDING S.S. SHEET.

OAKLEY BOULEVARD

HORIZONTAL SCALE 1"=40'
VERTICAL SCALE 1"=10'

Call before you Dig.
1-800-227-2800

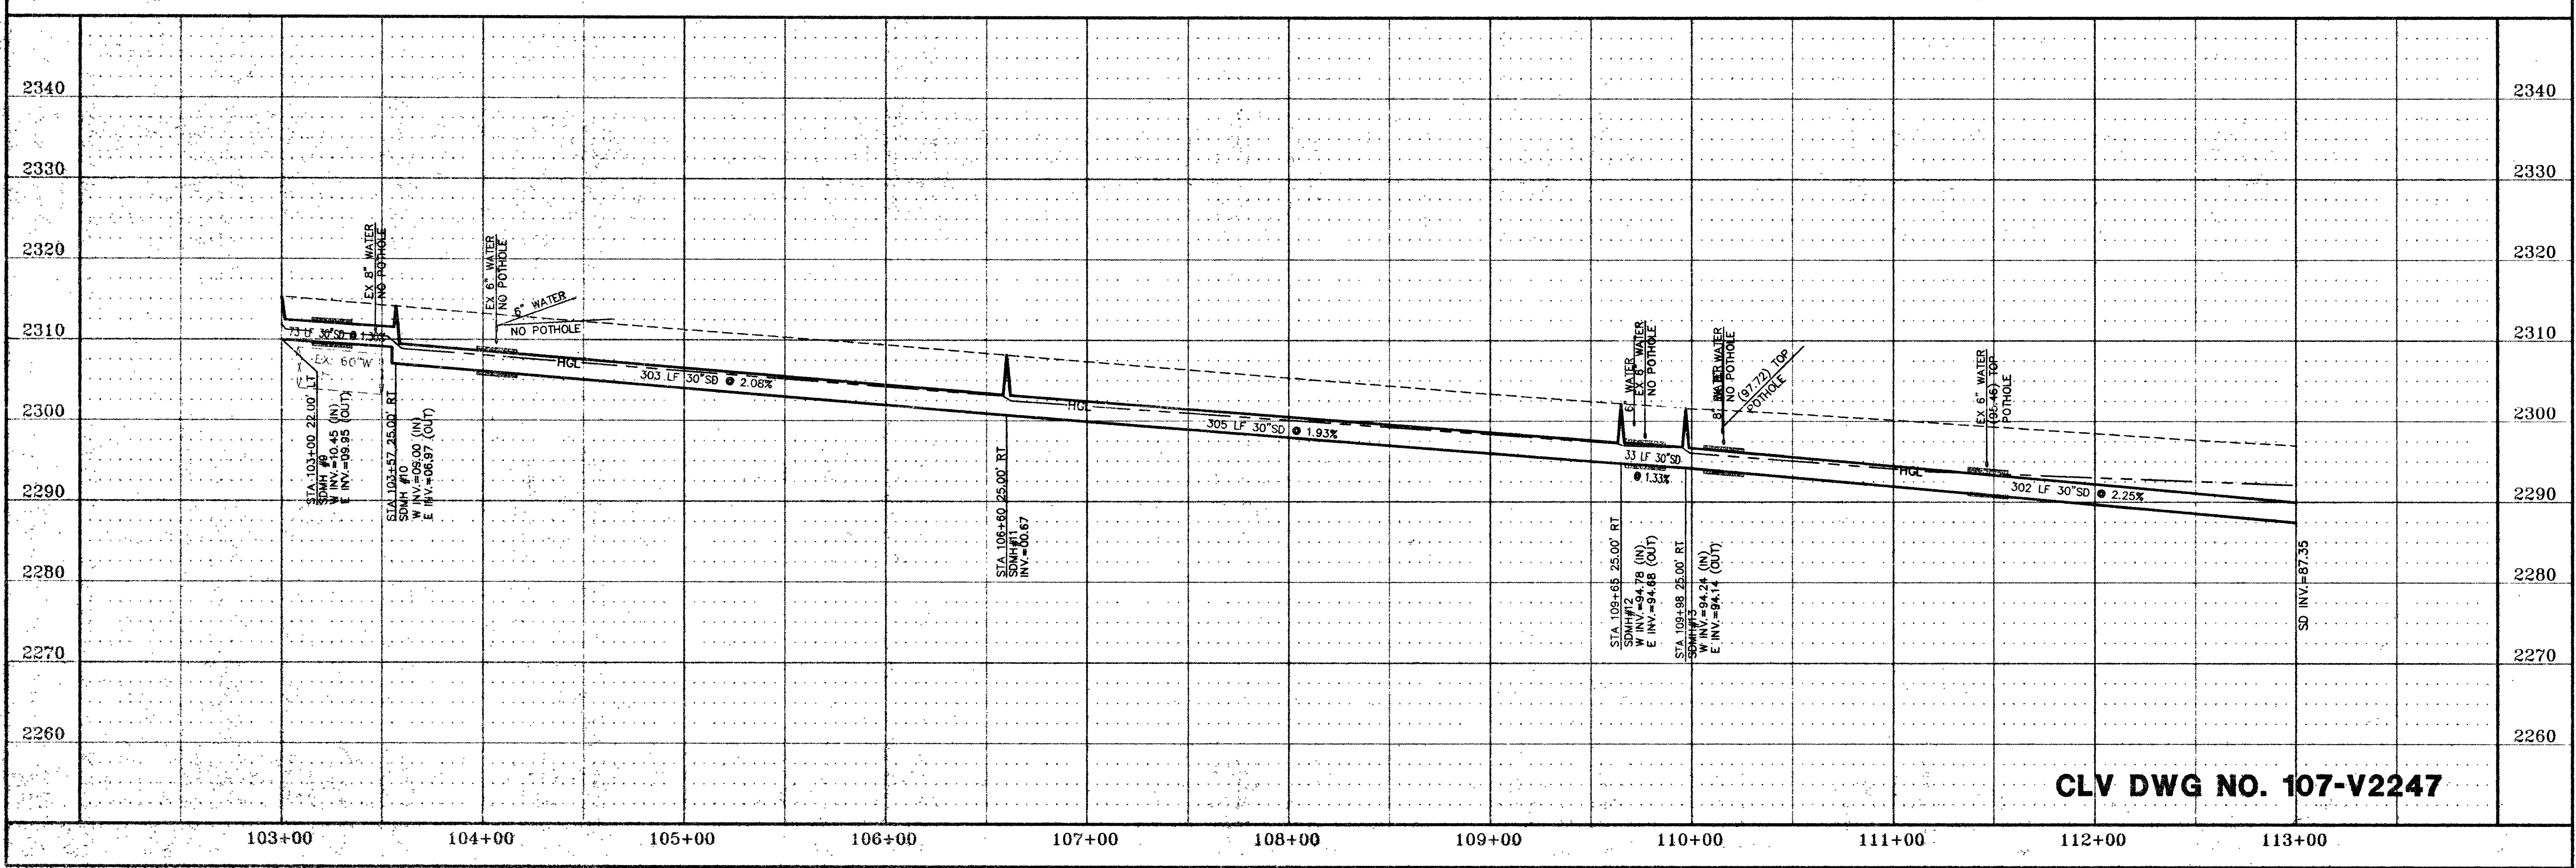

CLV DWG NO. 107-V2247

REVISIONS

NO.	DESCRIPTION/DATE	BY
100 GRIER DRIVE
LAS VEGAS, NEVADA 89119
PHONE (702) 361-0050
FAX (702) 361-0059

INCORPORATED

SDI
CONSULTING ENGINEERS

NEVADA

CITY OF LAS VEGAS
CLARK COUNTY


STORM DRAIN PLAN AND PROFILE
FROM STA. 103+00 TO STA. 113+00
OAKLEY BOULEVARD
RAINBOW BLVD. TO DECATUR BLVD.

JOB NO. 2-241-073
ACAD FILE: OAKESD05
DESIGNED: R.H.S.
DRAWN: T.L.
CHECKED: D.P.
DATE: JUNE 1995

SD5

51 OF 62 SHEETS

12-2-193

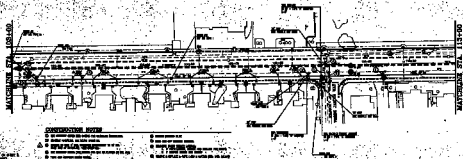








