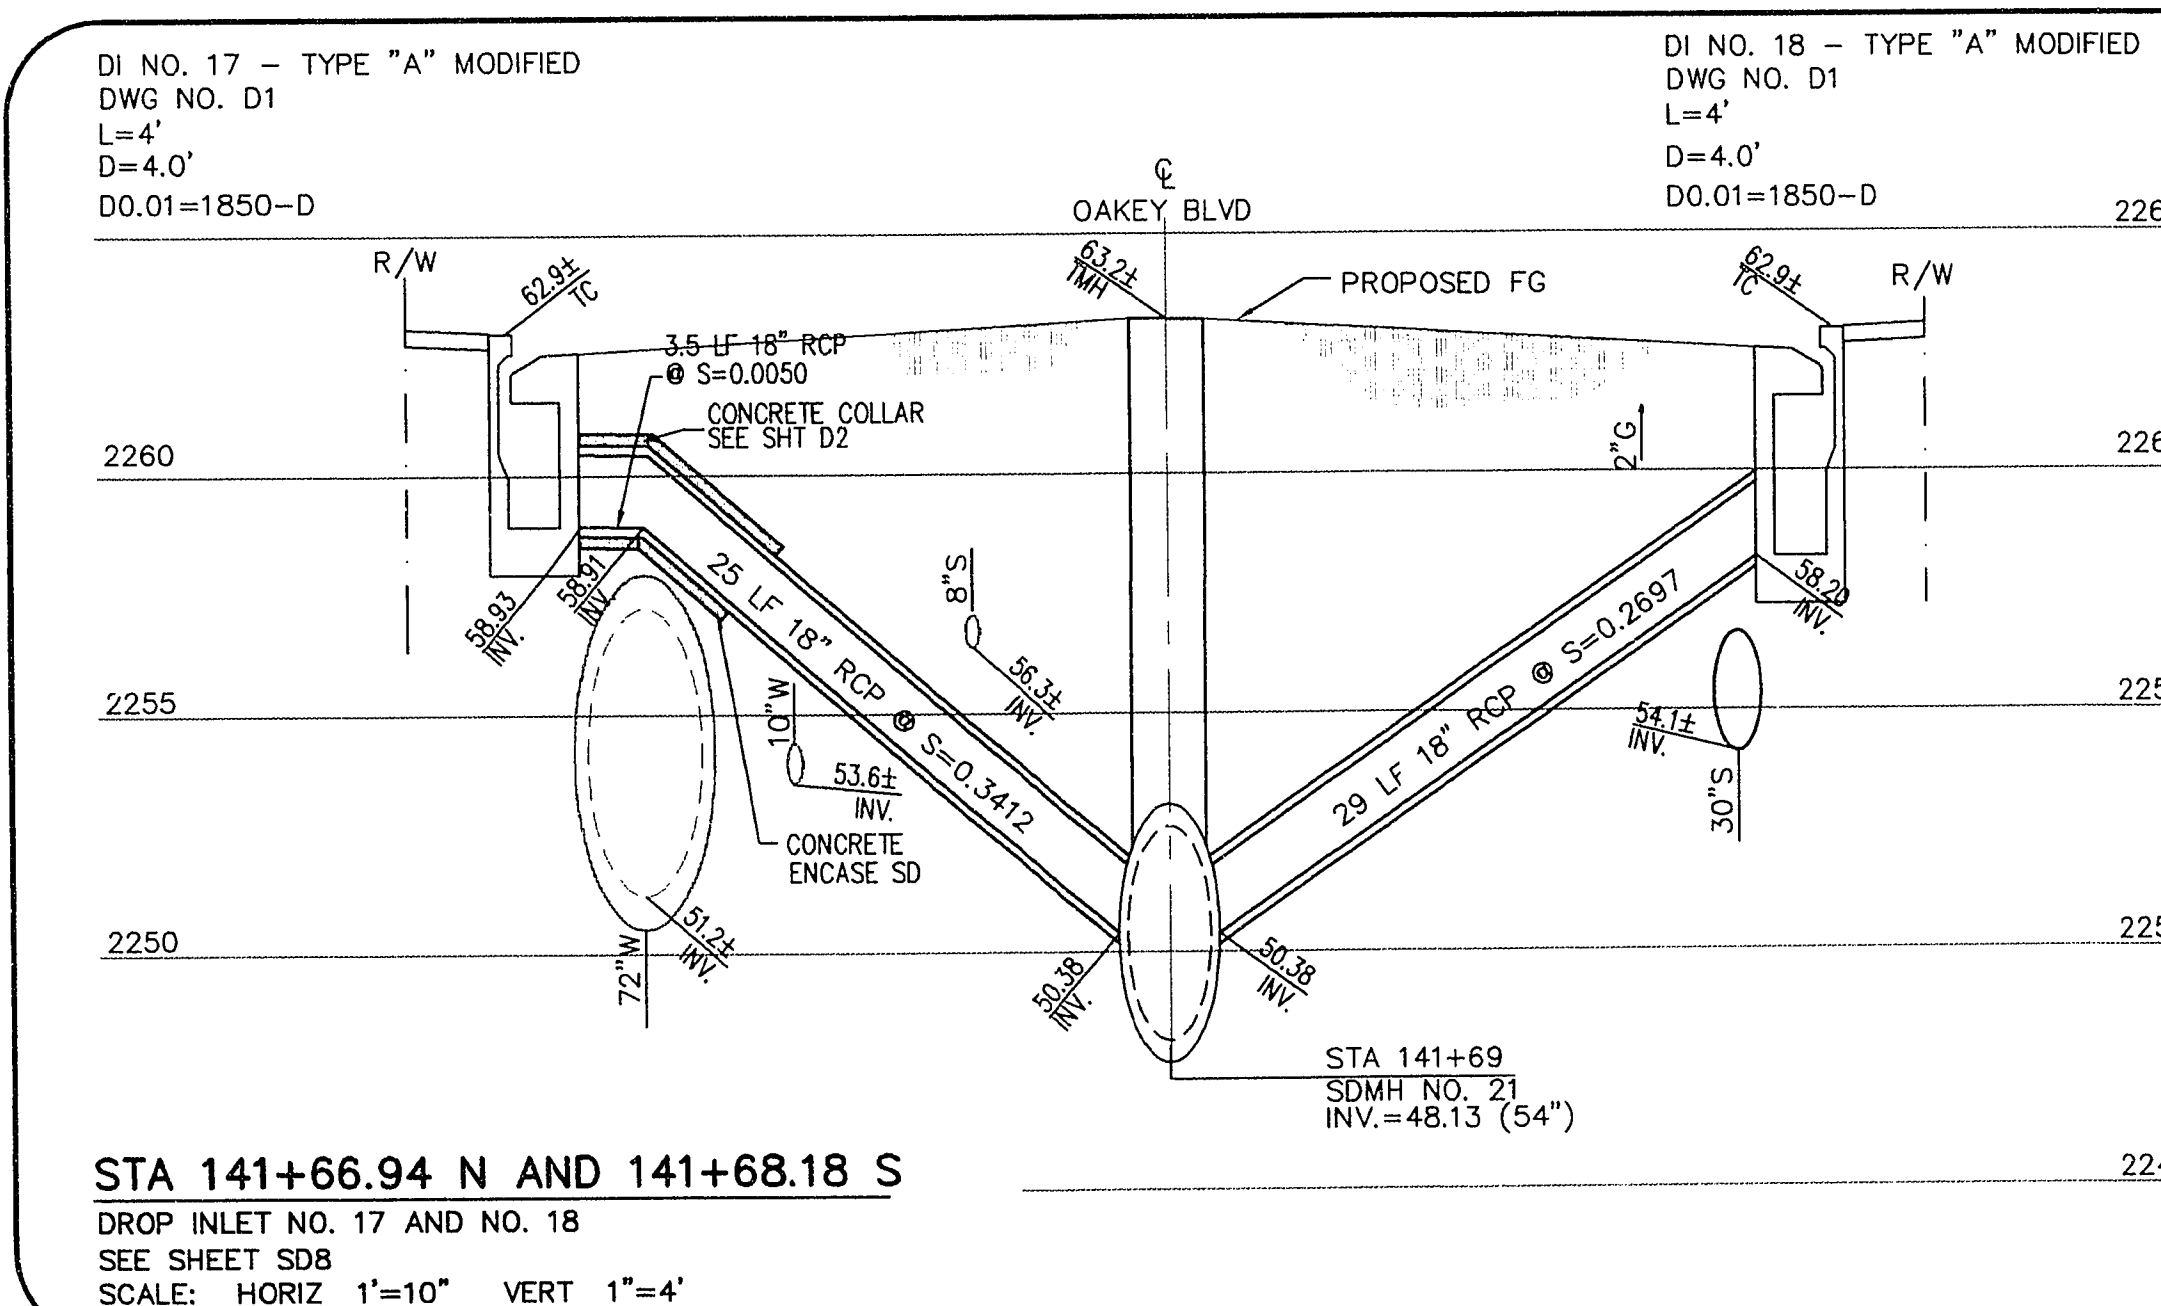
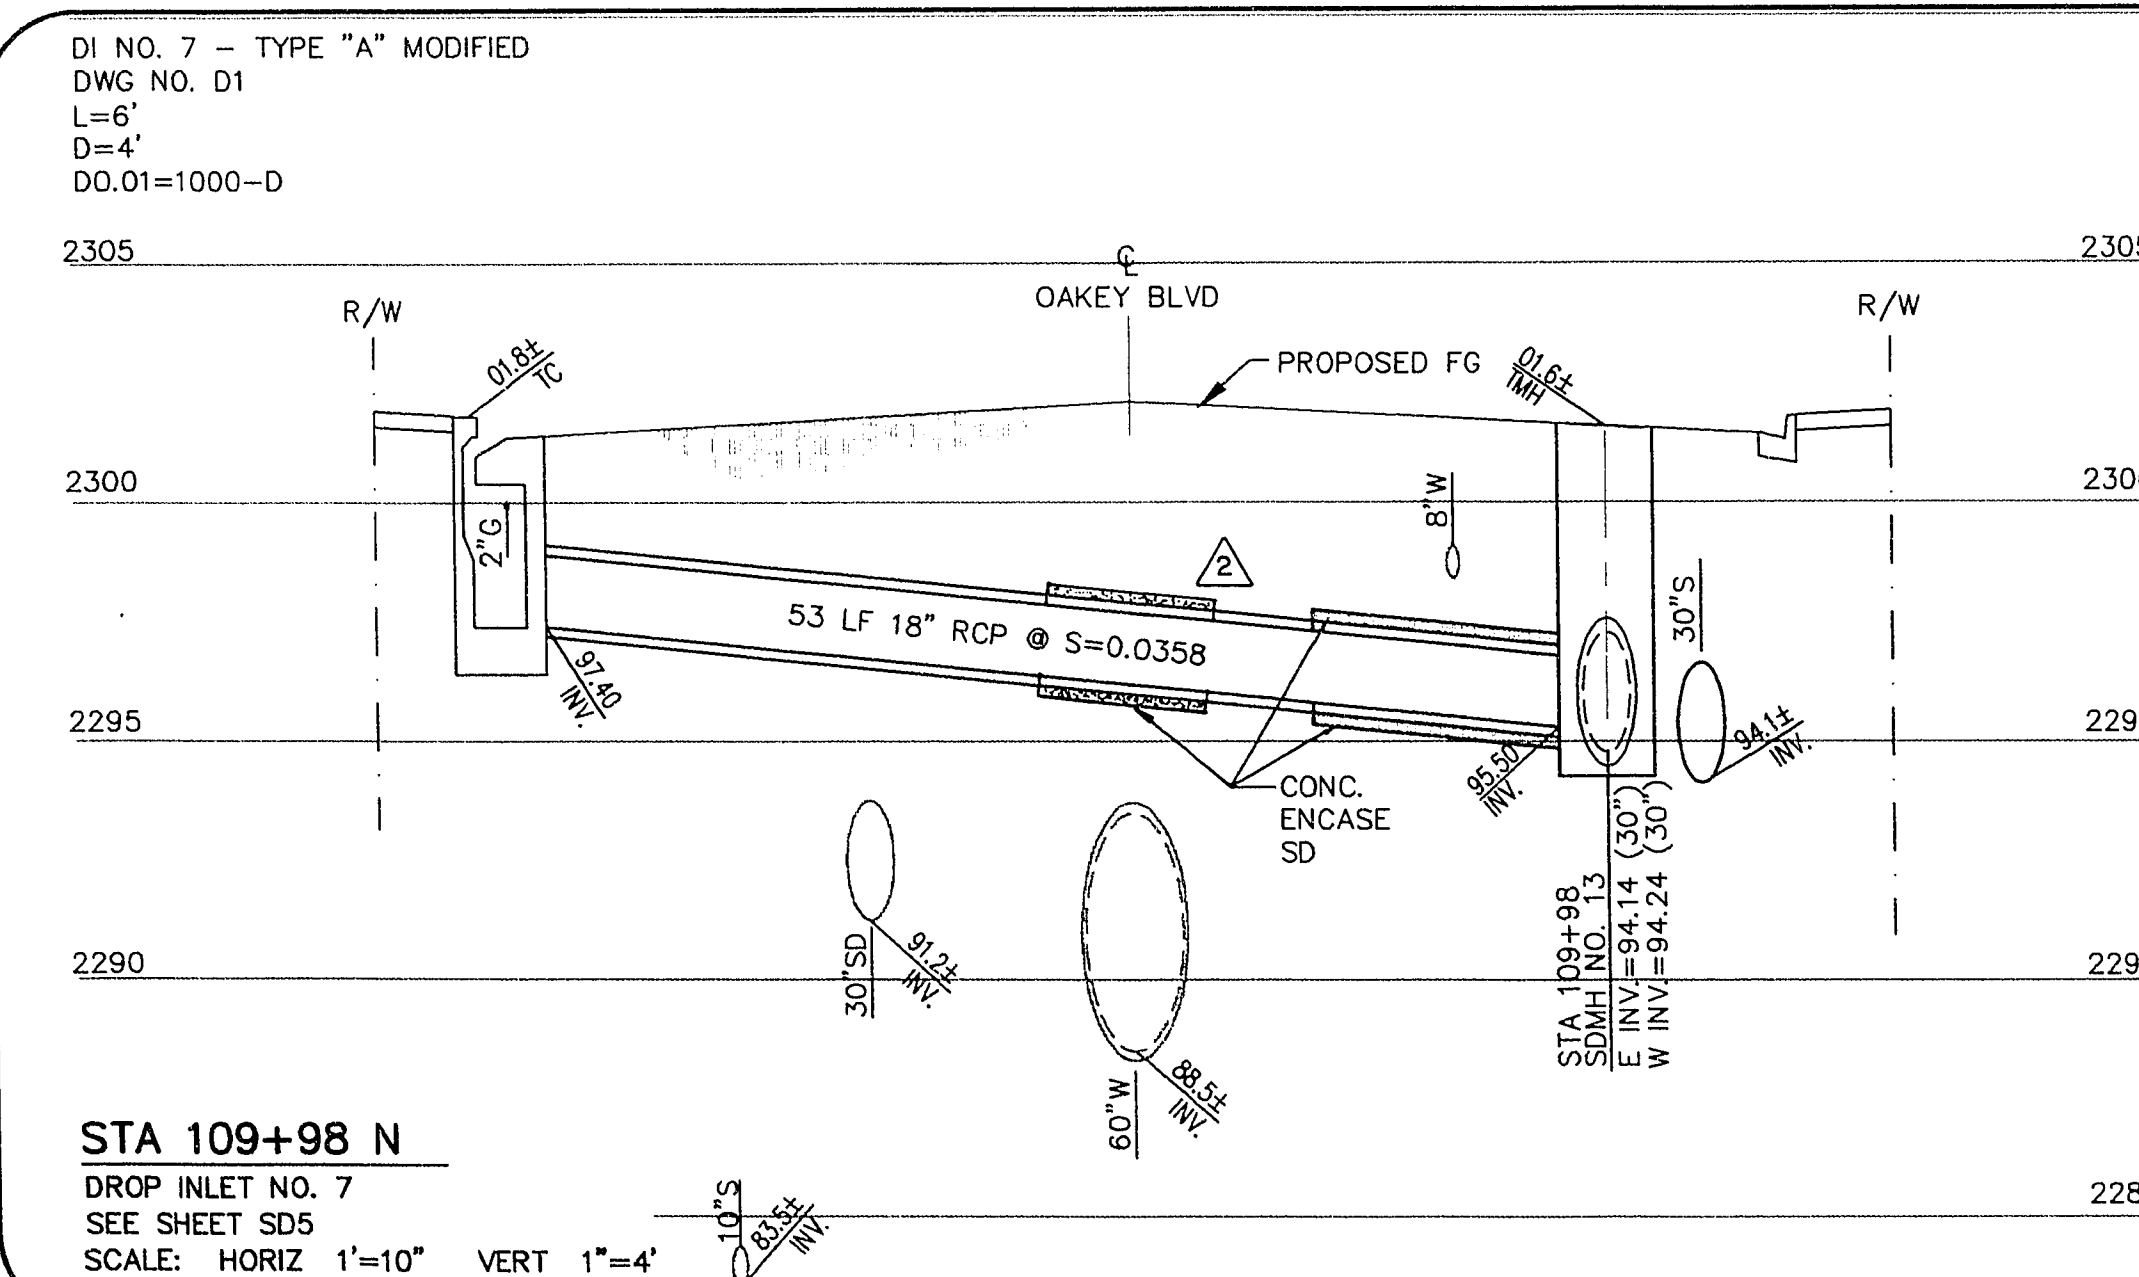
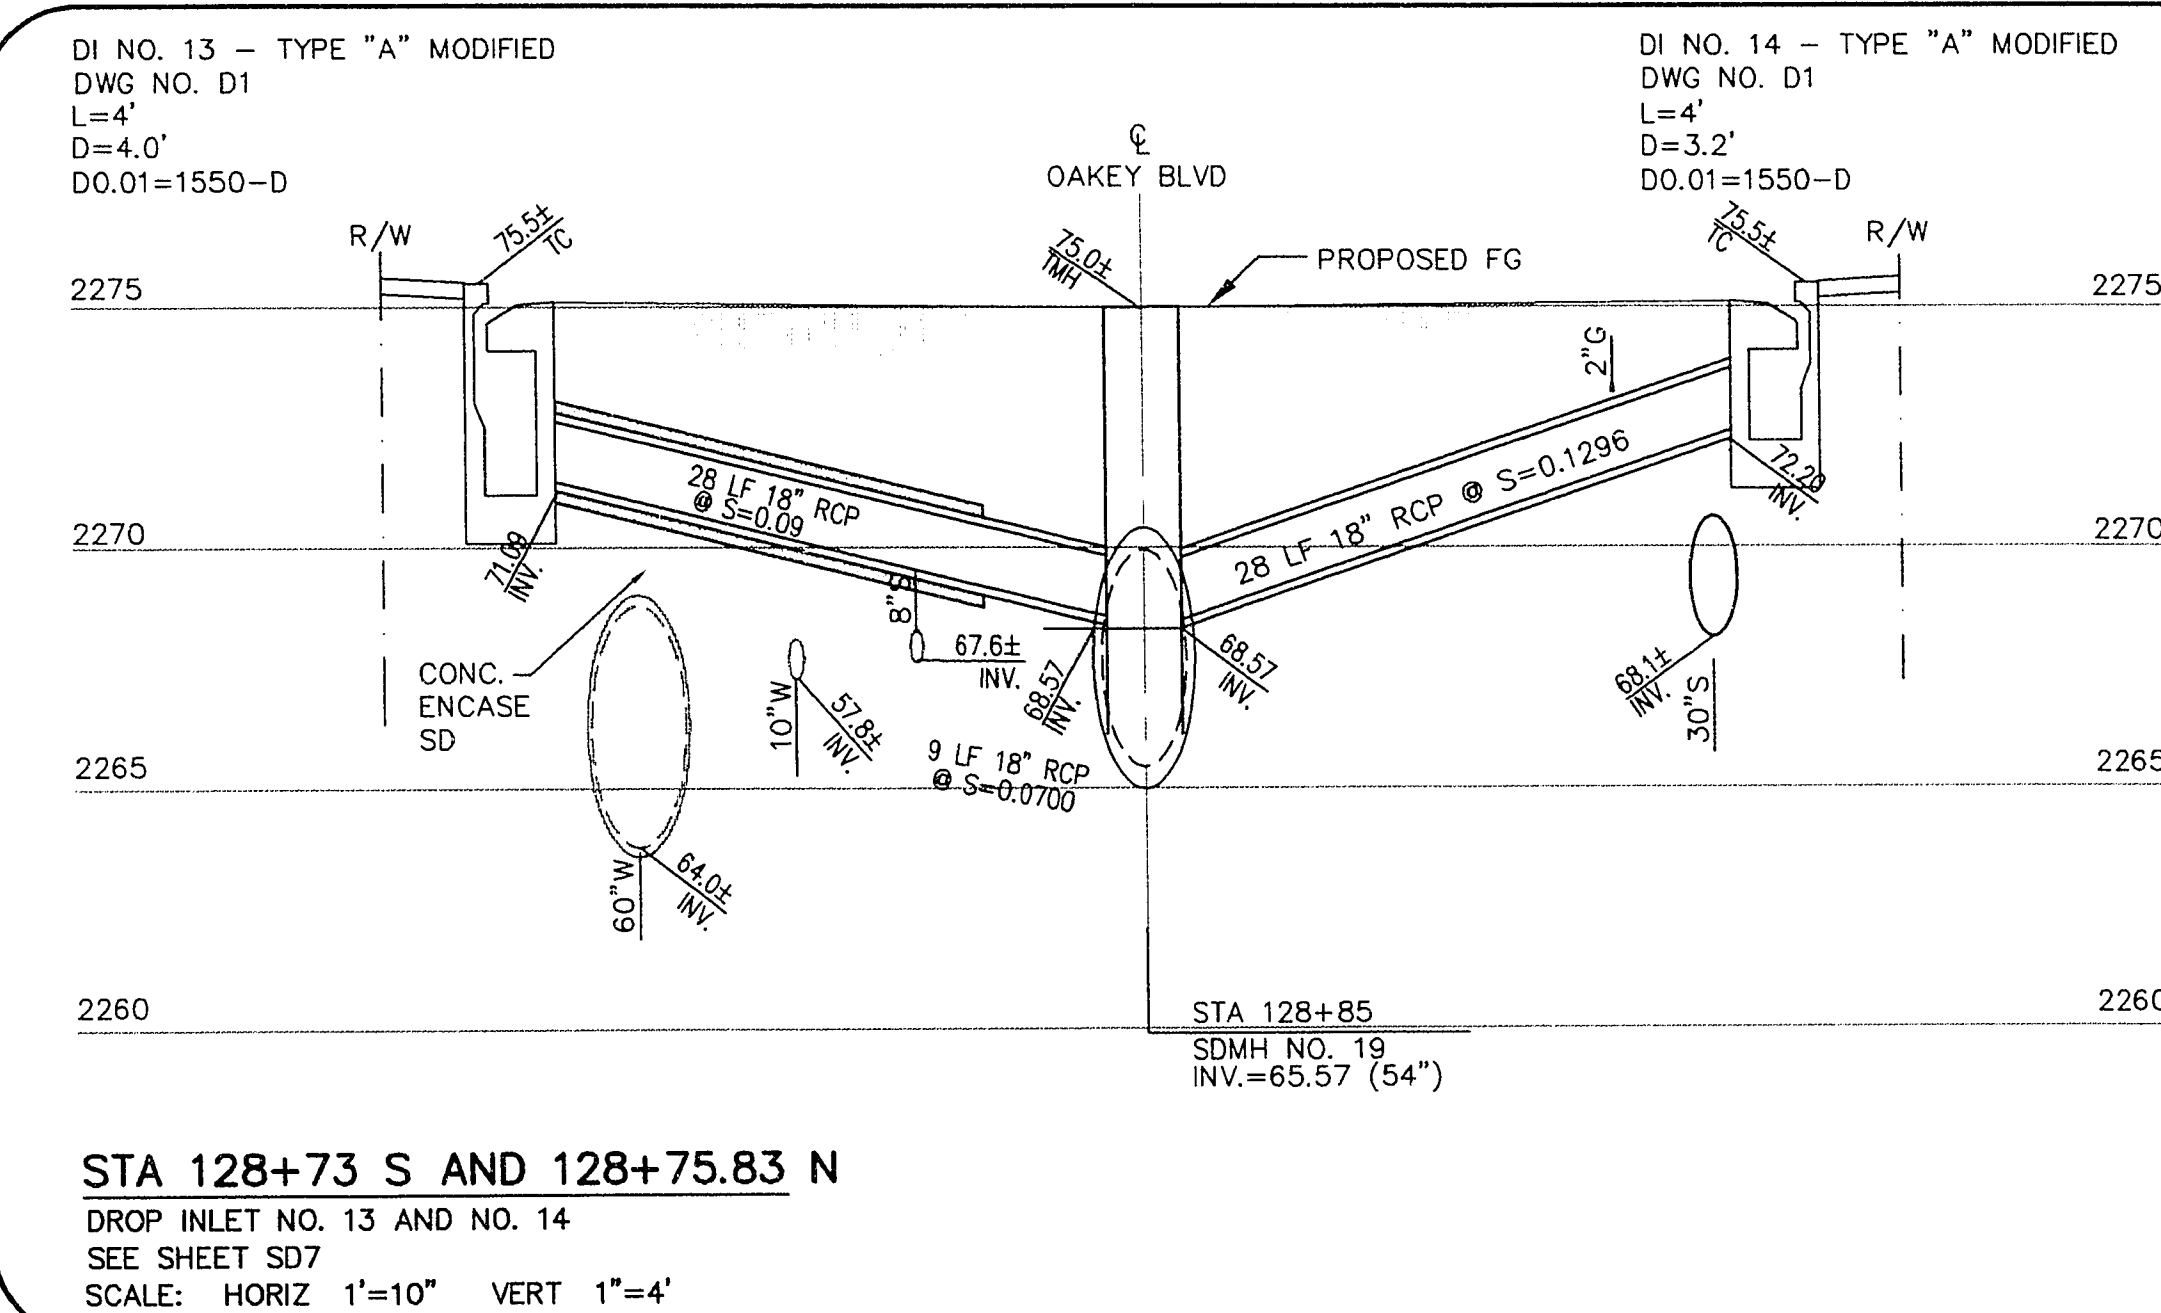
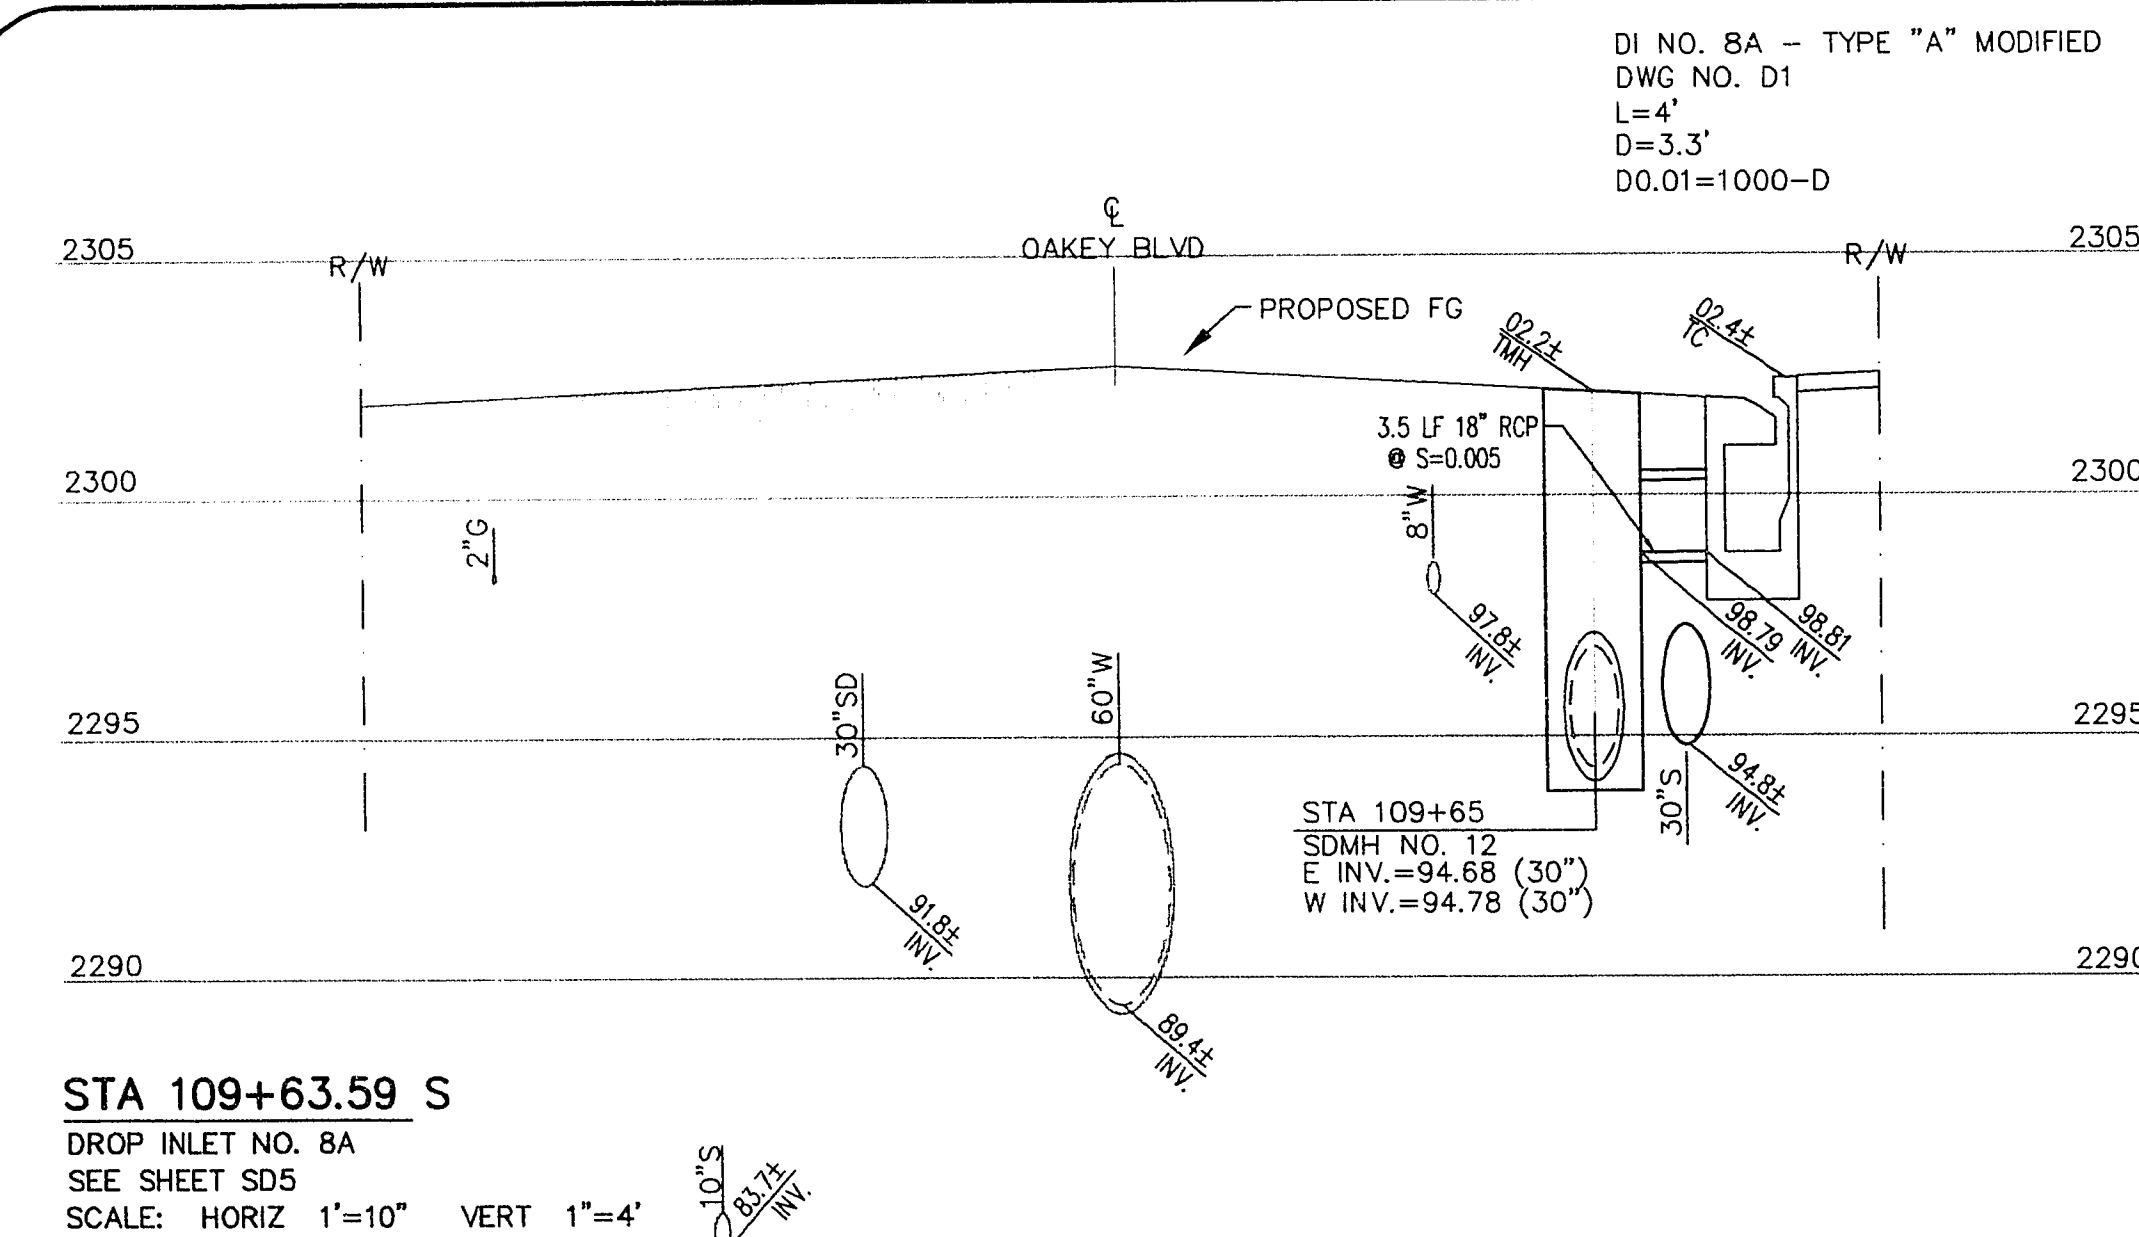
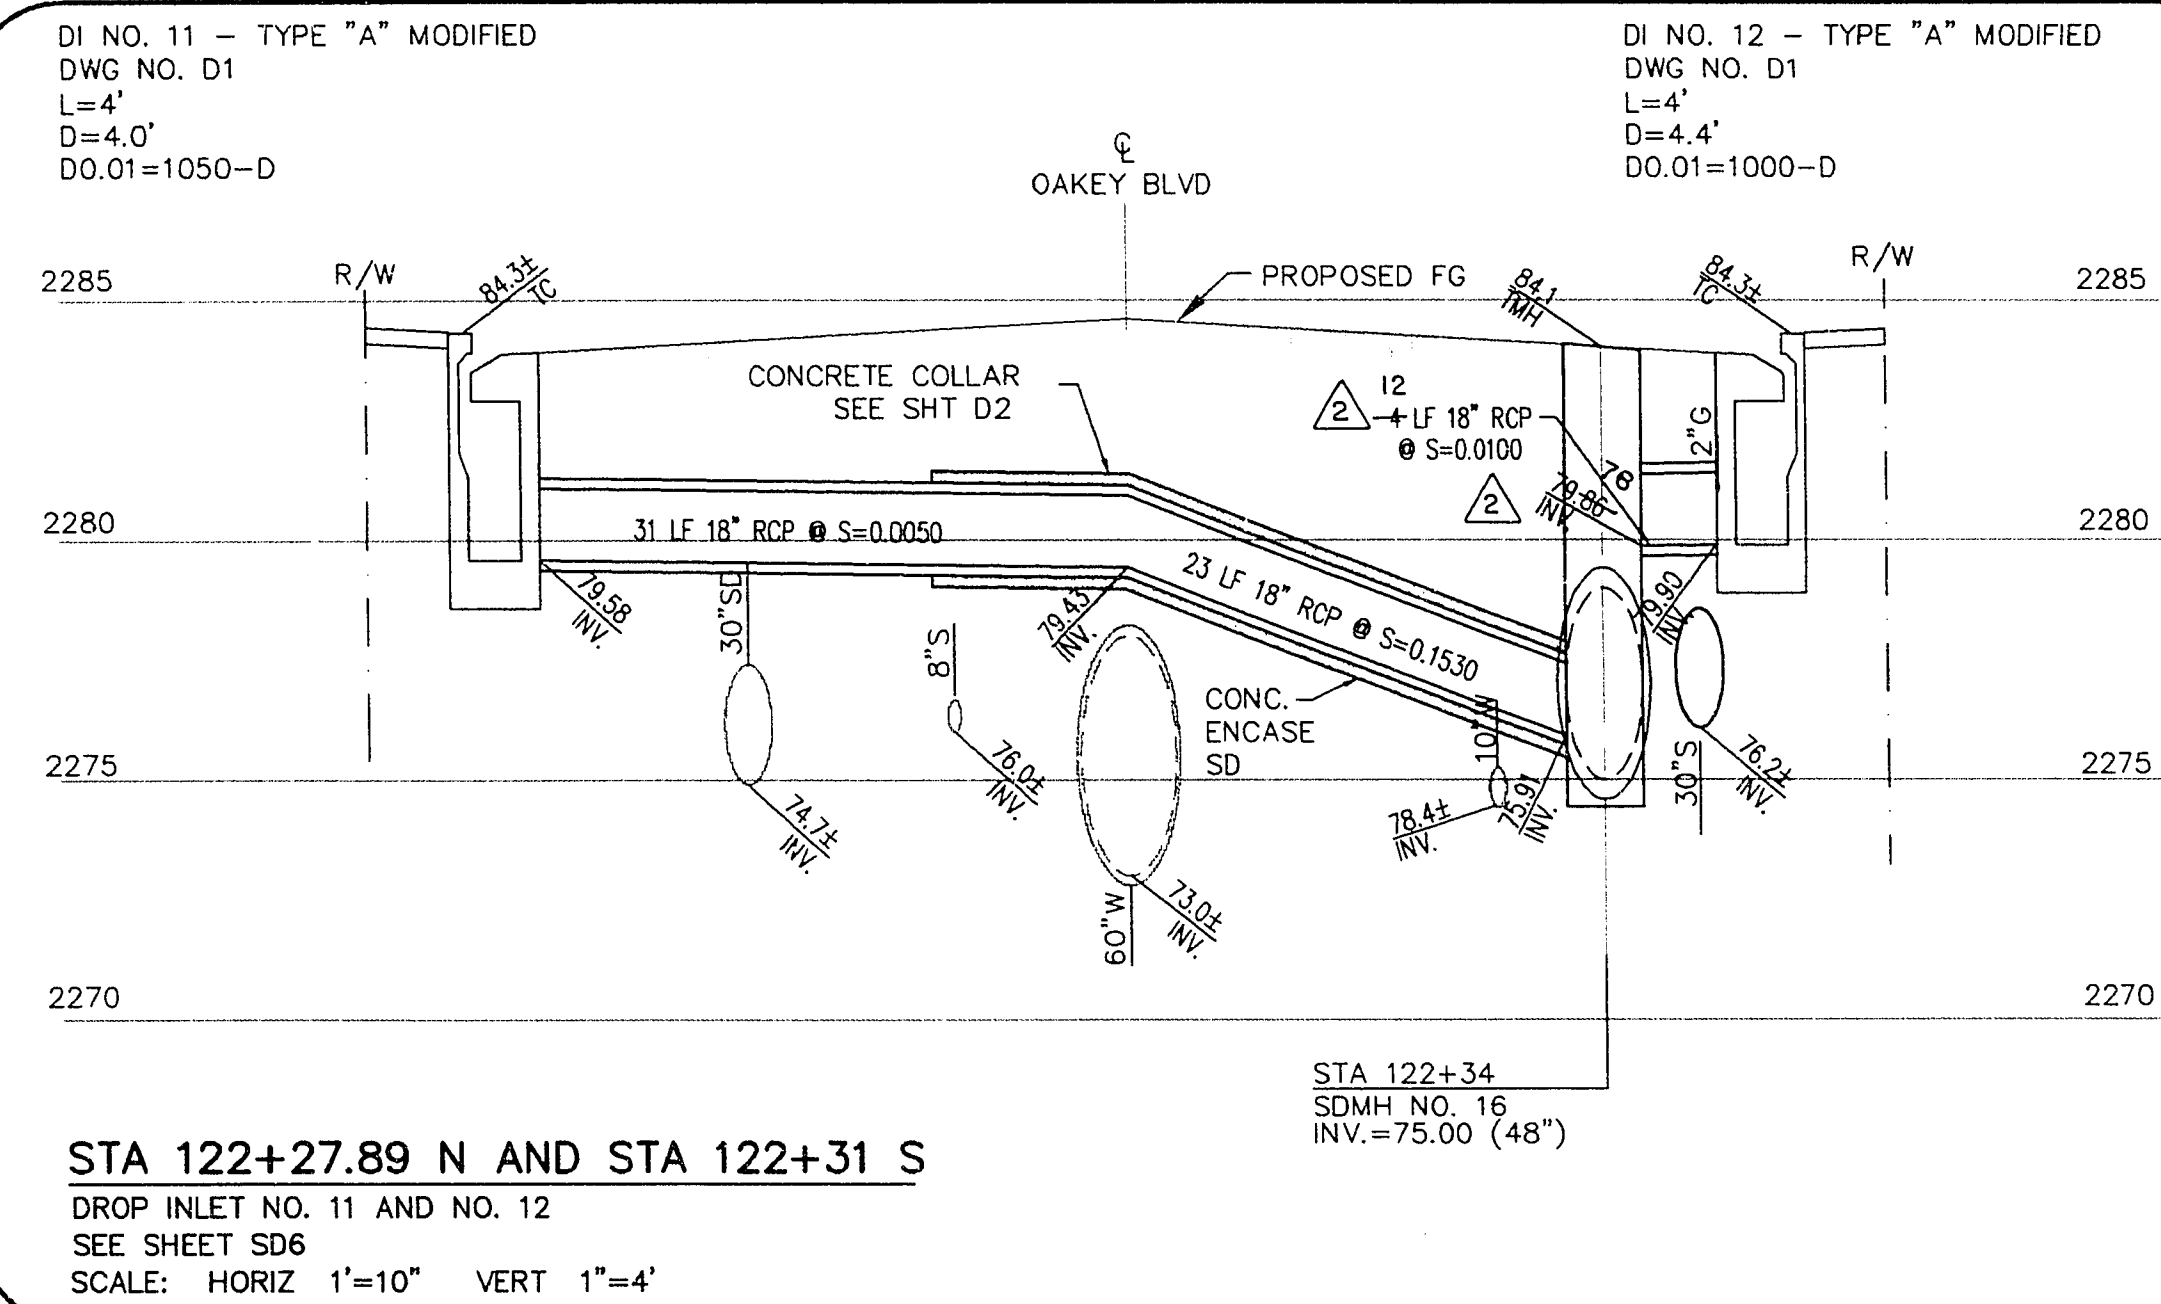
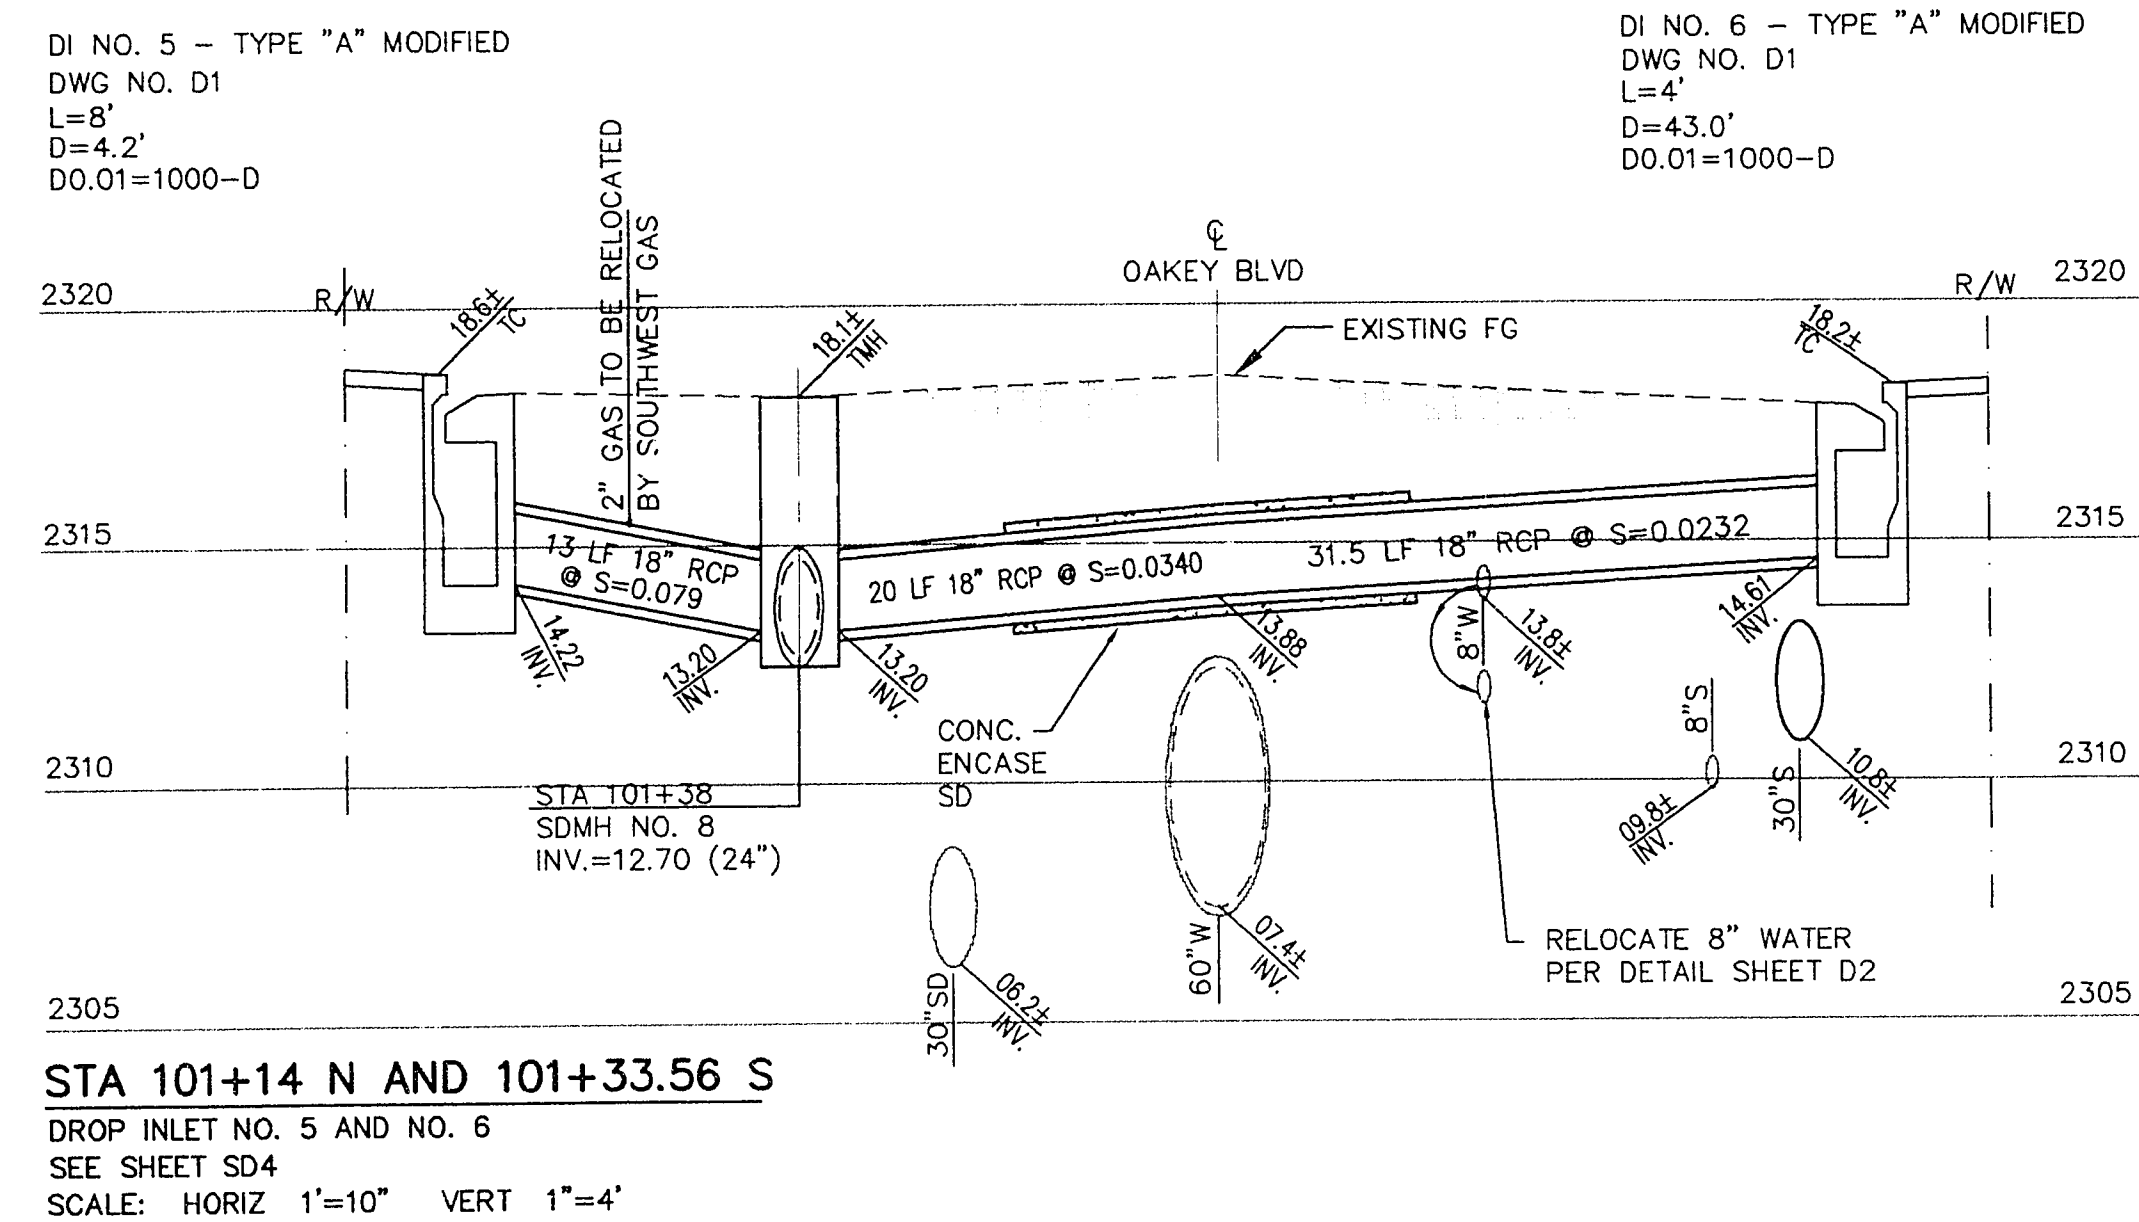
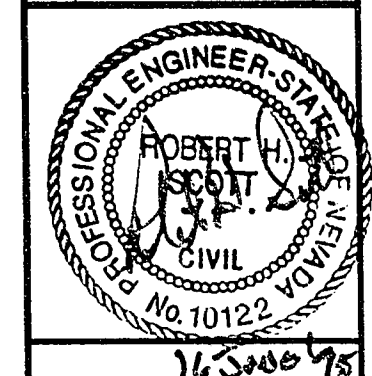


[illegible]

SEA
incorporated
CONSULTING ENGINEERS

1100 GRIER DRIVE
LAS VEGAS, NEVADA 89119
PHONE (702) 361-9050
FAX (702) 361-0659

STORM DRAIN LATERAL PROFILES
OAKLEY BOULEVARD
RAINBOW BLVD. TO DECATUR BLVD.

JOB NO.:	2-241-073
ACAD FILE:	OAKSDL01
DESIGNED:	RHS
DRAWN:	TL
CHECKED:	RHS
DATE:	JUNE 1995

SD13

59 OF 62 SHEETS