




Call before you Dig.
1-800-227-2800
UNDERGROUND SERVICE ALERT (USA)

CURVE TABLE • BACK OF CURB					SIDEWALK RAMP DIMENSIONS	
NUMBER	RADIUS	DELTA	TANGENT	LENGTH	'A'	'B'
①	15.00'	89°10'18"	14.78'	23.35'	8.0'	8.0'
②	15.00'	90°49'42"	15.22'	23.78'	4.5'	9.5'
③	25.00'	90°31'03"	25.23'	39.50'	4.5'	9.5'

NOTE:

APPROVAL OF THESE PLANS FOR WATER STUBOUT INSTALLATION WILL NOT BE CONSIDERED AS A COMMITMENT FOR WATER SERVICE TO THIS PROPERTY.

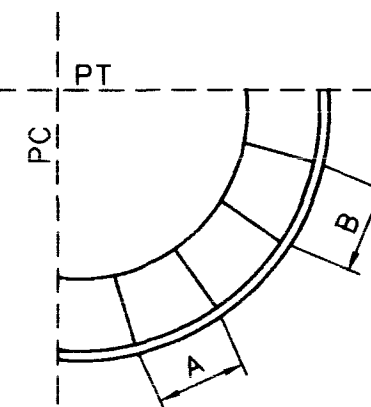

SIDEWALK RAMP
SEE TABLE FOR
TRANSITION LENGTHS


OAKLEY BOULEVARD

HORIZONTAL SCALE 1"=40'
VERTICAL SCALE 1"=10'


REMOVE A.C. PAVEMENT

CONSTRUCTION NOTES


1. CONSTRUCT ASPHALT CONCRETE PAVEMENT (SEE TYP. SECTION SHT. 4)
2. CONSTRUCT TACK ON ISLAND (STD DWG NO. 220)
3. CONSTRUCT CONCRETE SIDEWALK (STD DWG NO. 234)
4. CONSTRUCT L-TYPE CURB AND GUTTER (STD DWG NO. 216)
5. CONSTRUCT SIDEWALK RAMP (STD DWG NO. 235)
6. CONSTRUCT CROSS GUTTER (STD DWG NO. 228)
7. CONSTRUCT RESIDENTIAL DRIVEWAY (STD DWG NO. 223)
8. CONSTRUCT COMMERCIAL DRIVEWAY
9. CONSTRUCT 8' DRIVEWAY TRANSITION (MATCH EXISTING SURFACE)
10. CONSTRUCT TRANSITION PAVEMENT 2" AC OVER 6" TYPE II AGG. BASE
11. CONSTRUCT RETAINING WALL
12. SAWCUT AND MATCH EXISTING
13. SET NEW SURVEY MONUMENT, TYPE I (STD DWG NO. 239)
14. SET NEW SURVEY MONUMENT, TYPE III (STD DWG NO. 241)
15. ADJUST EXISTING MANHOLE (STD DWG NO. 403-408)
16. ADJUST EXISTING WATER VALVE (STD DWG NO. 517)
17. ADJUST UTILITY VAULT OR PULL BOX
18. REMOVE ASPHALT CONCRETE PAVEMENT
19. REMOVE L-TYPE CURB AND GUTTER
20. REMOVE CONCRETE SIDEWALK PC TO PT
21. REMOVE BLOCKWALL
22. REMOVE FENCE
23. REMOVE CROSS GUTTER
24. RELOCATE FIRE HYDRANT (MIN. 20' FROM CURB RETURN)
25. RELOCATE MAIL BOX
26. REMOVE TREE
27. NO CONSTRUCTION EASEMENT
28. RELOCATE WATER METER
29. RELOCATE STREET LIGHT (SEE TRAFFIC SHTS)
30. RELOCATE TRAFFIC SIGN (SEE TRAFFIC SHTS)
31. REMOVE & REPLACE CROSS GUTTER SPANDREL TO ACCOMMODATE NEW WHEELCHAIR RAMP
32. SAWCUT
33. SET NEW SURVEY MONUMENT TYPE IIB (STD DWG NO. 240)
34. ADJUST WATER METER
35. CONSTRUCT TRANSITION PAVEMENT 4" AC OVER 6" TYPE II AGG. BASE FROM END OF RETURN
36. TEMPORARY CONSTRUCTION EASEMENT
37. NEW INLET - SEE STORM DRAIN SHEET
38. RELOCATE FENCE TO NEW R/W
39. REMOVE PLANTER WALL
40. RECONSTRUCT BLOCK WALL
41. CONSTRUCT 3'X5' BUS STOP PAD (STD DWG #234)
42. EXIST POWER POLE TO BE RELOCATED BY NEVADA POWER
43. REMOVE/RECONSTRUCT BLOCK WALL
44. WROUGHT-IRON ORNAMENT
45. INSTALL 6" WATER LINE INCLUDING 8" X 6" TAPPING TEE AND 6" VALVE
46. INSTALL 4" SEWER SERVICE WITH INVERT AT 4' BELOW GRADE AT PROPERTY LINE.

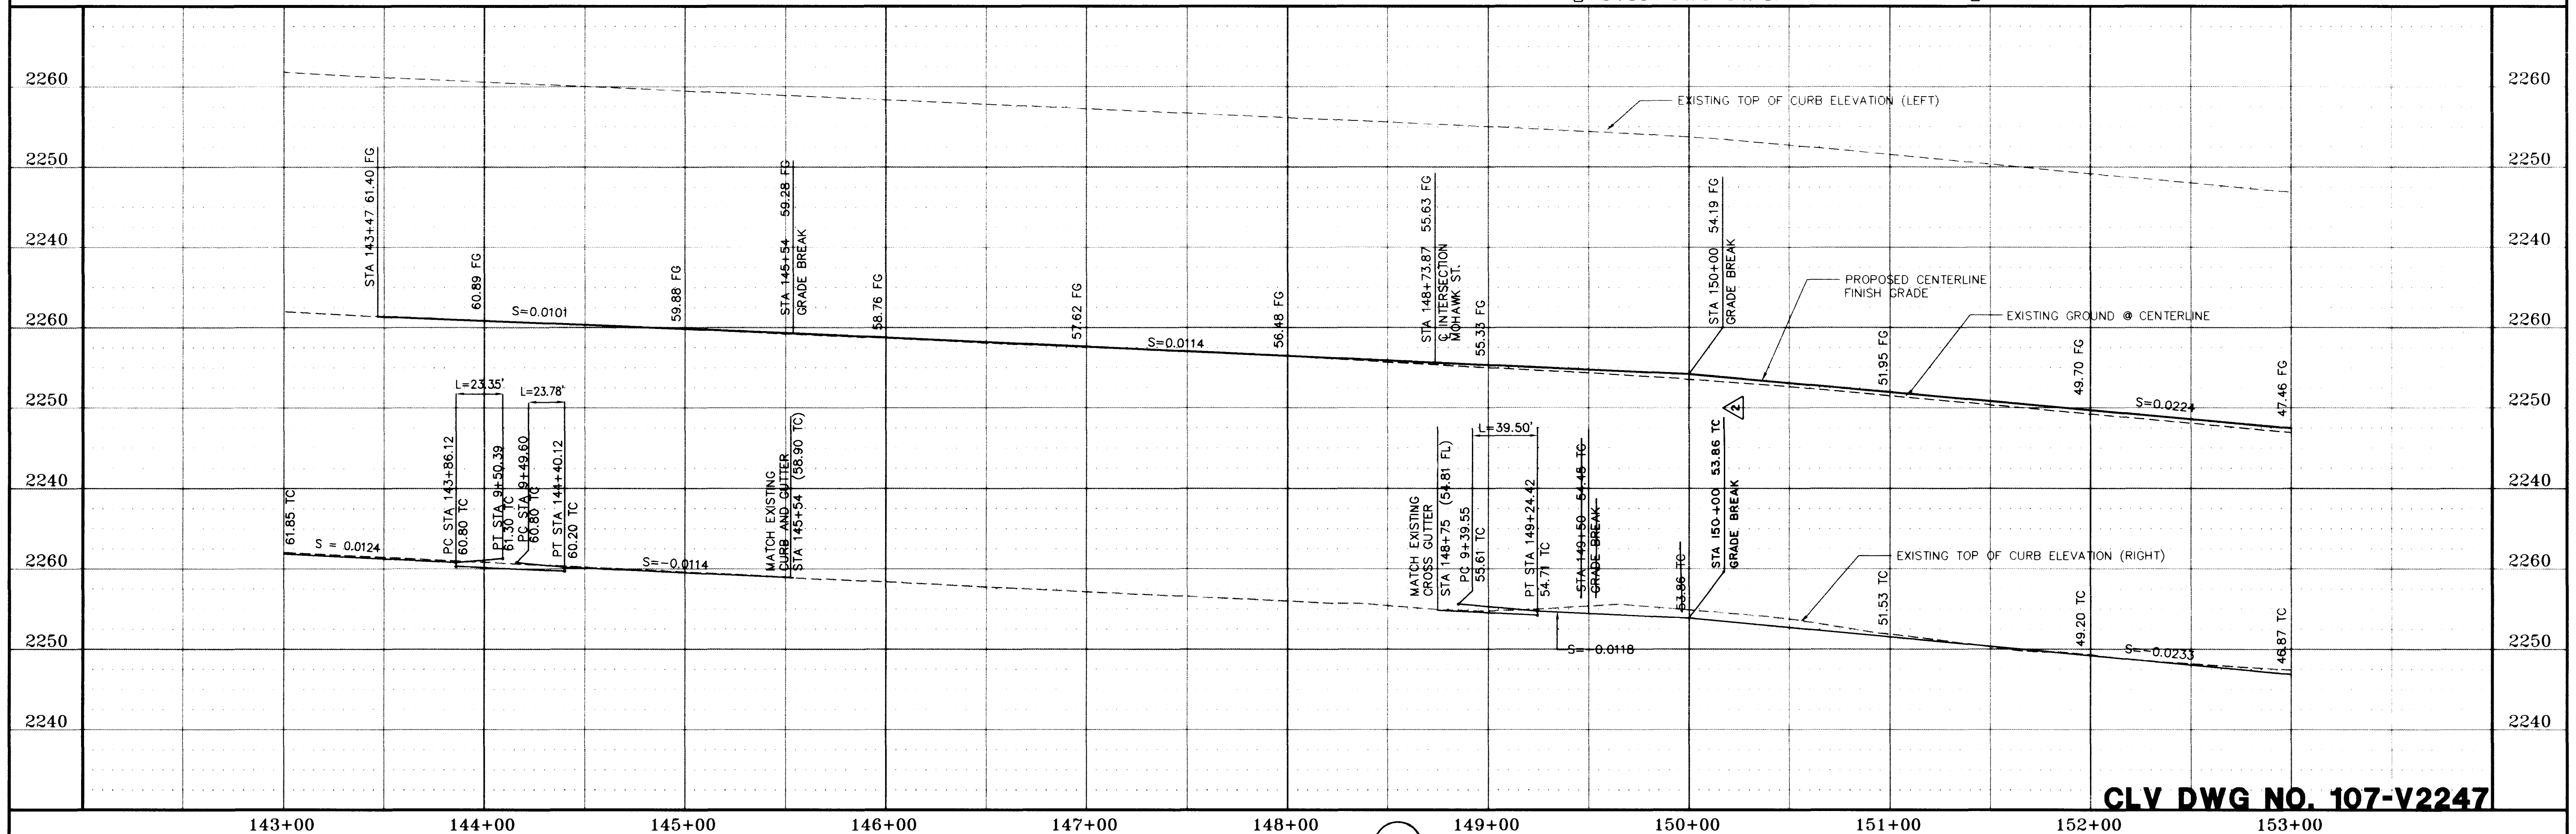

CLV DWG NO. 107-V2247

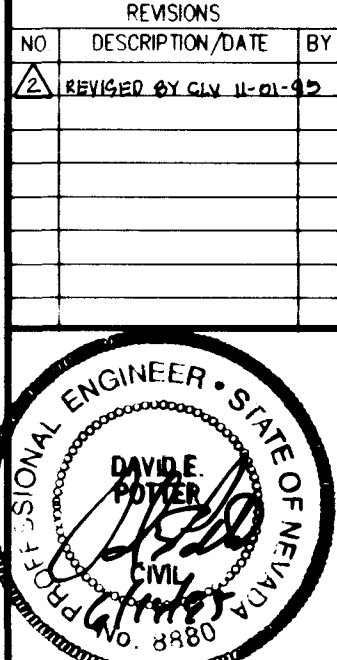

1100 GRIER DRIVE
LAS VEGAS, NEVADA 89119
PHONE (702) 361-9050
FAX (702) 361-0659

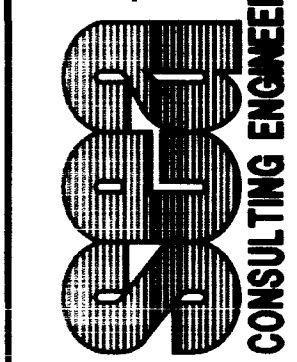

ROADWAY PLAN AND PROFILE
FROM STA. 143+00 TO STA. 153+00
OAKLEY BOULEVARD
RAINBOW BLVD. TO DECATUR BLVD.

JOB NO. 2-241-073
ACAD FILE OAKEPP09
DESIGNED: DP
DRAWN: TL
CHECKED: DP
DATE: JUNE 1995

C9








CONSTRUCTION NOTES									
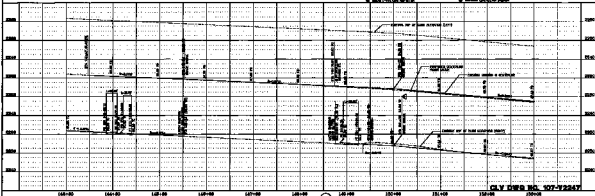







ROADWAY PLAN AND PROFILE


C9

4-2-64