


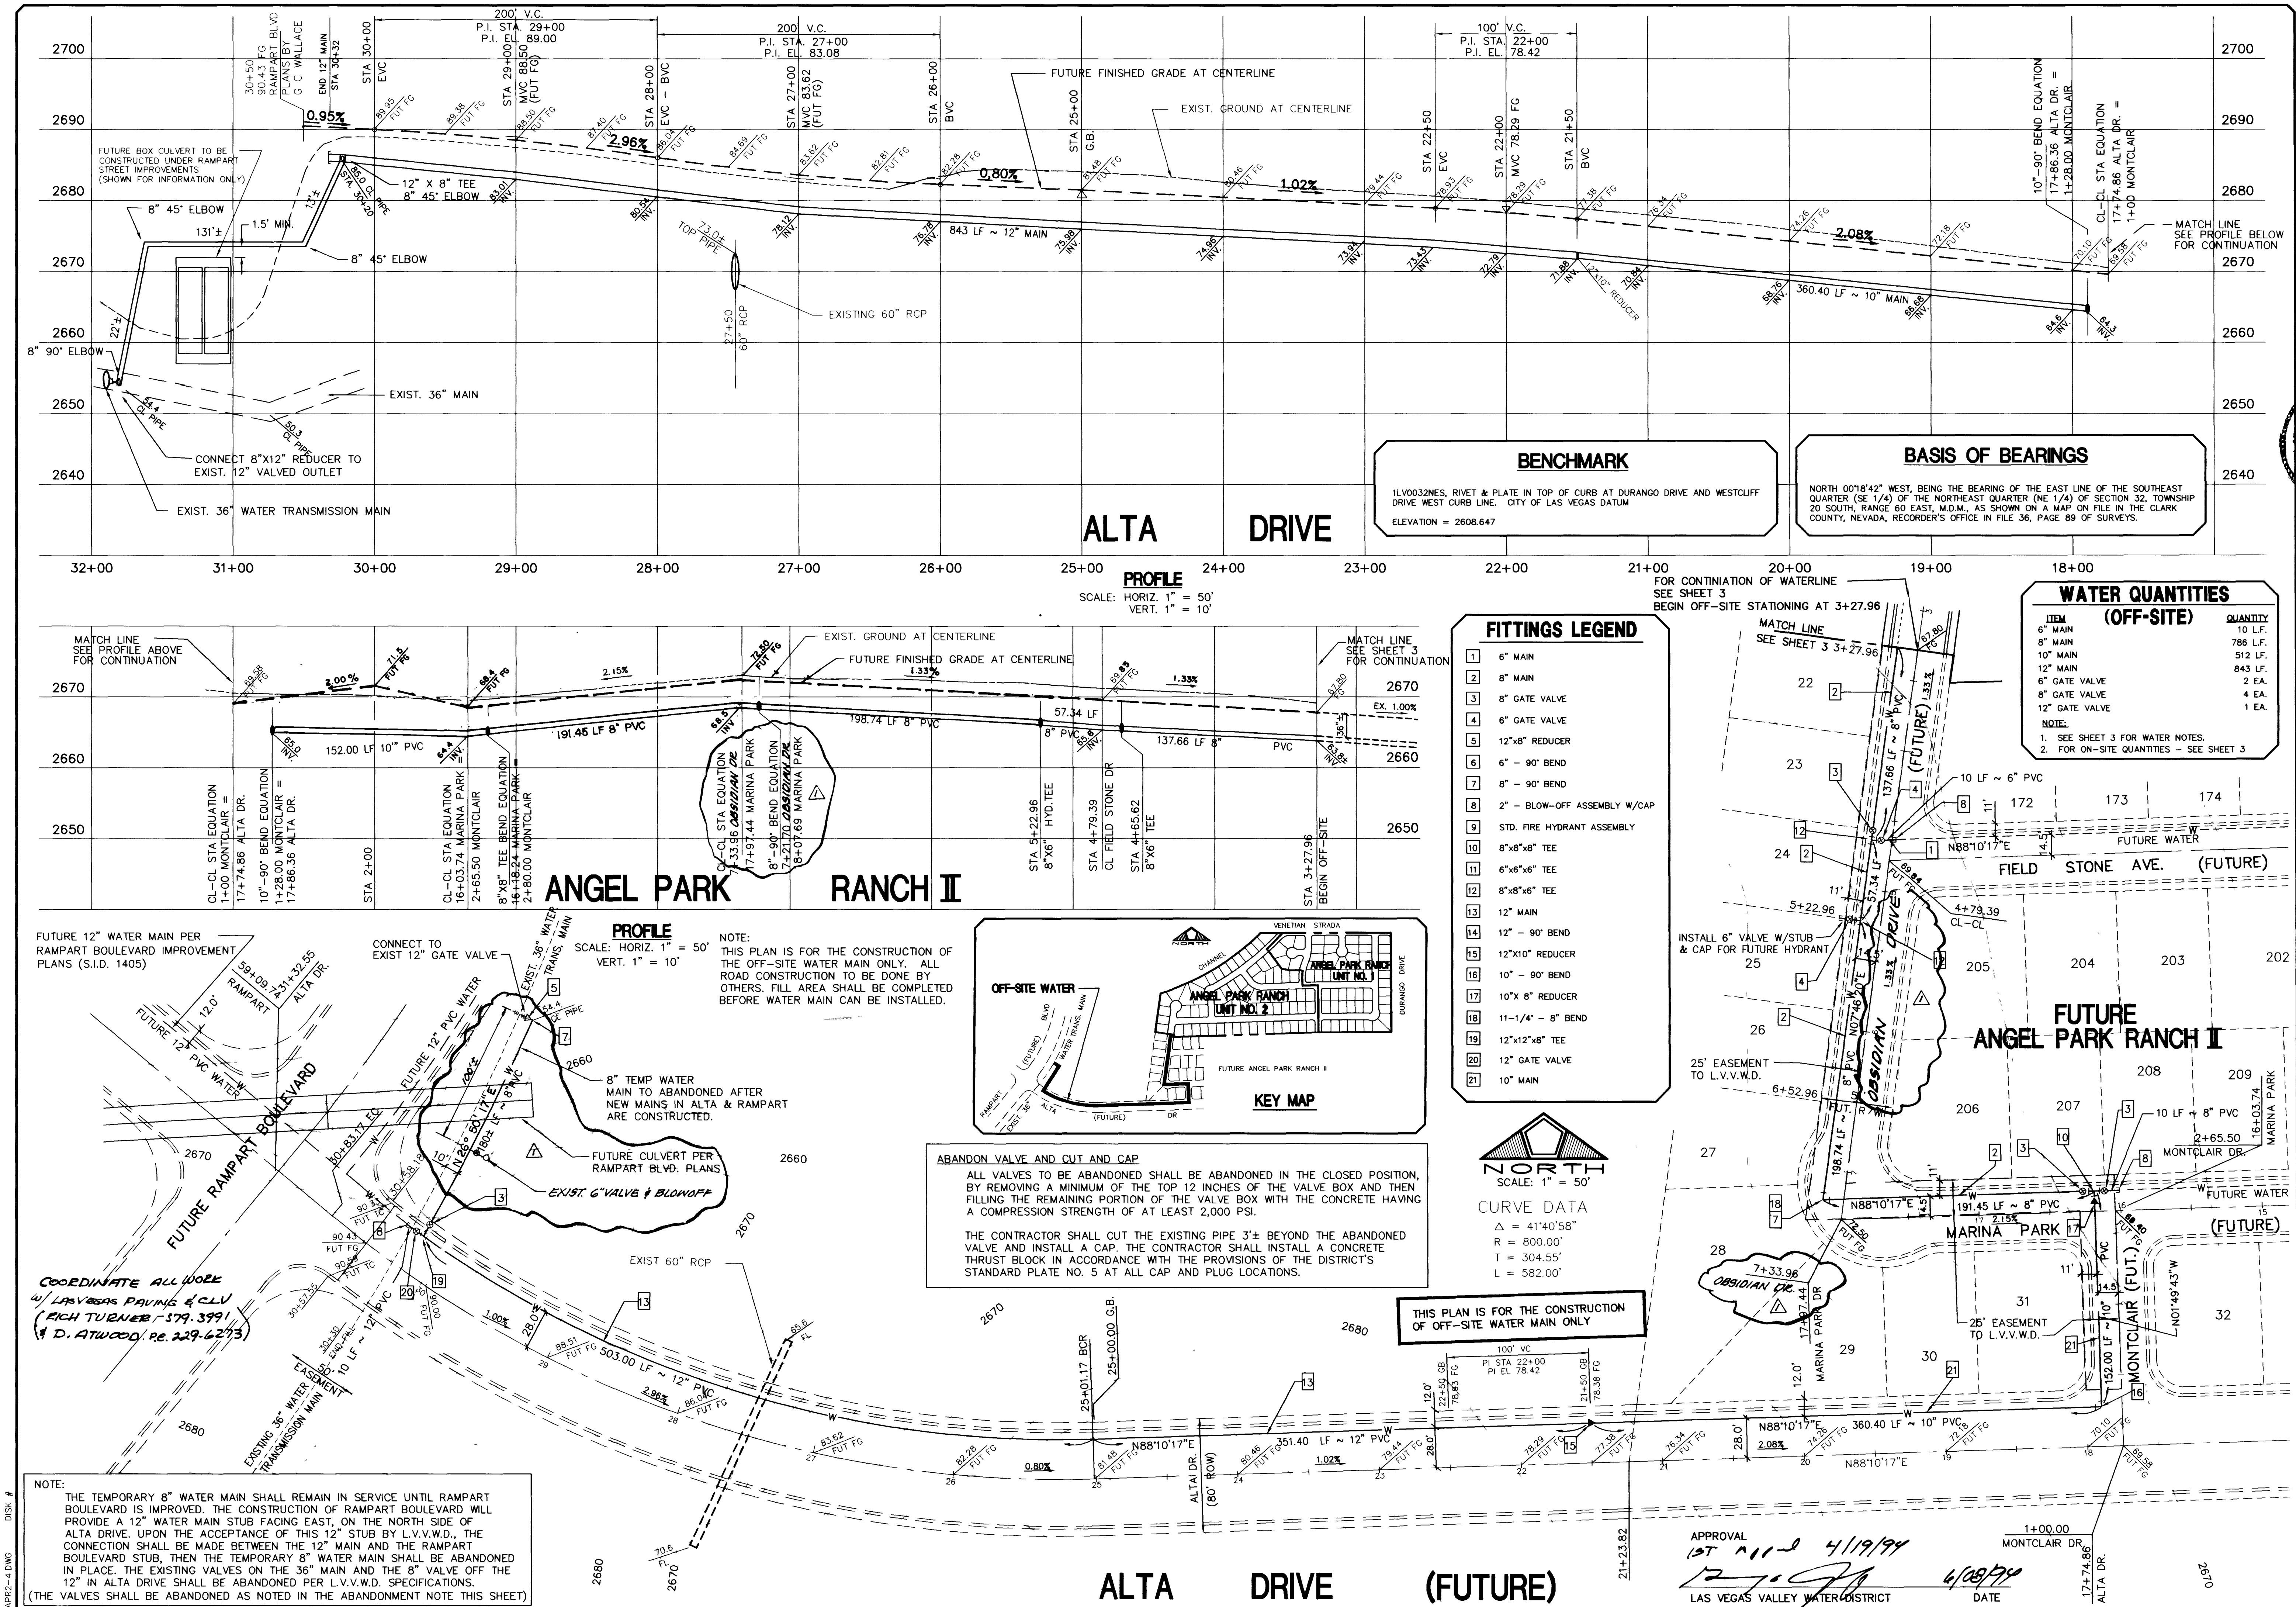

DATE: 09/27/93
DRAWN BY: [Signature]
DESIGNED BY: [Signature]
CHECKED BY: [Signature]
JOB NO.: 147,0002
SCALE: 1" = 50'

NO. DESCRIPTION
DATE
APPROVED







