


Call before
you Dig
1-800-227-2600

Avoid cutting underground
utility lines. It's costly.

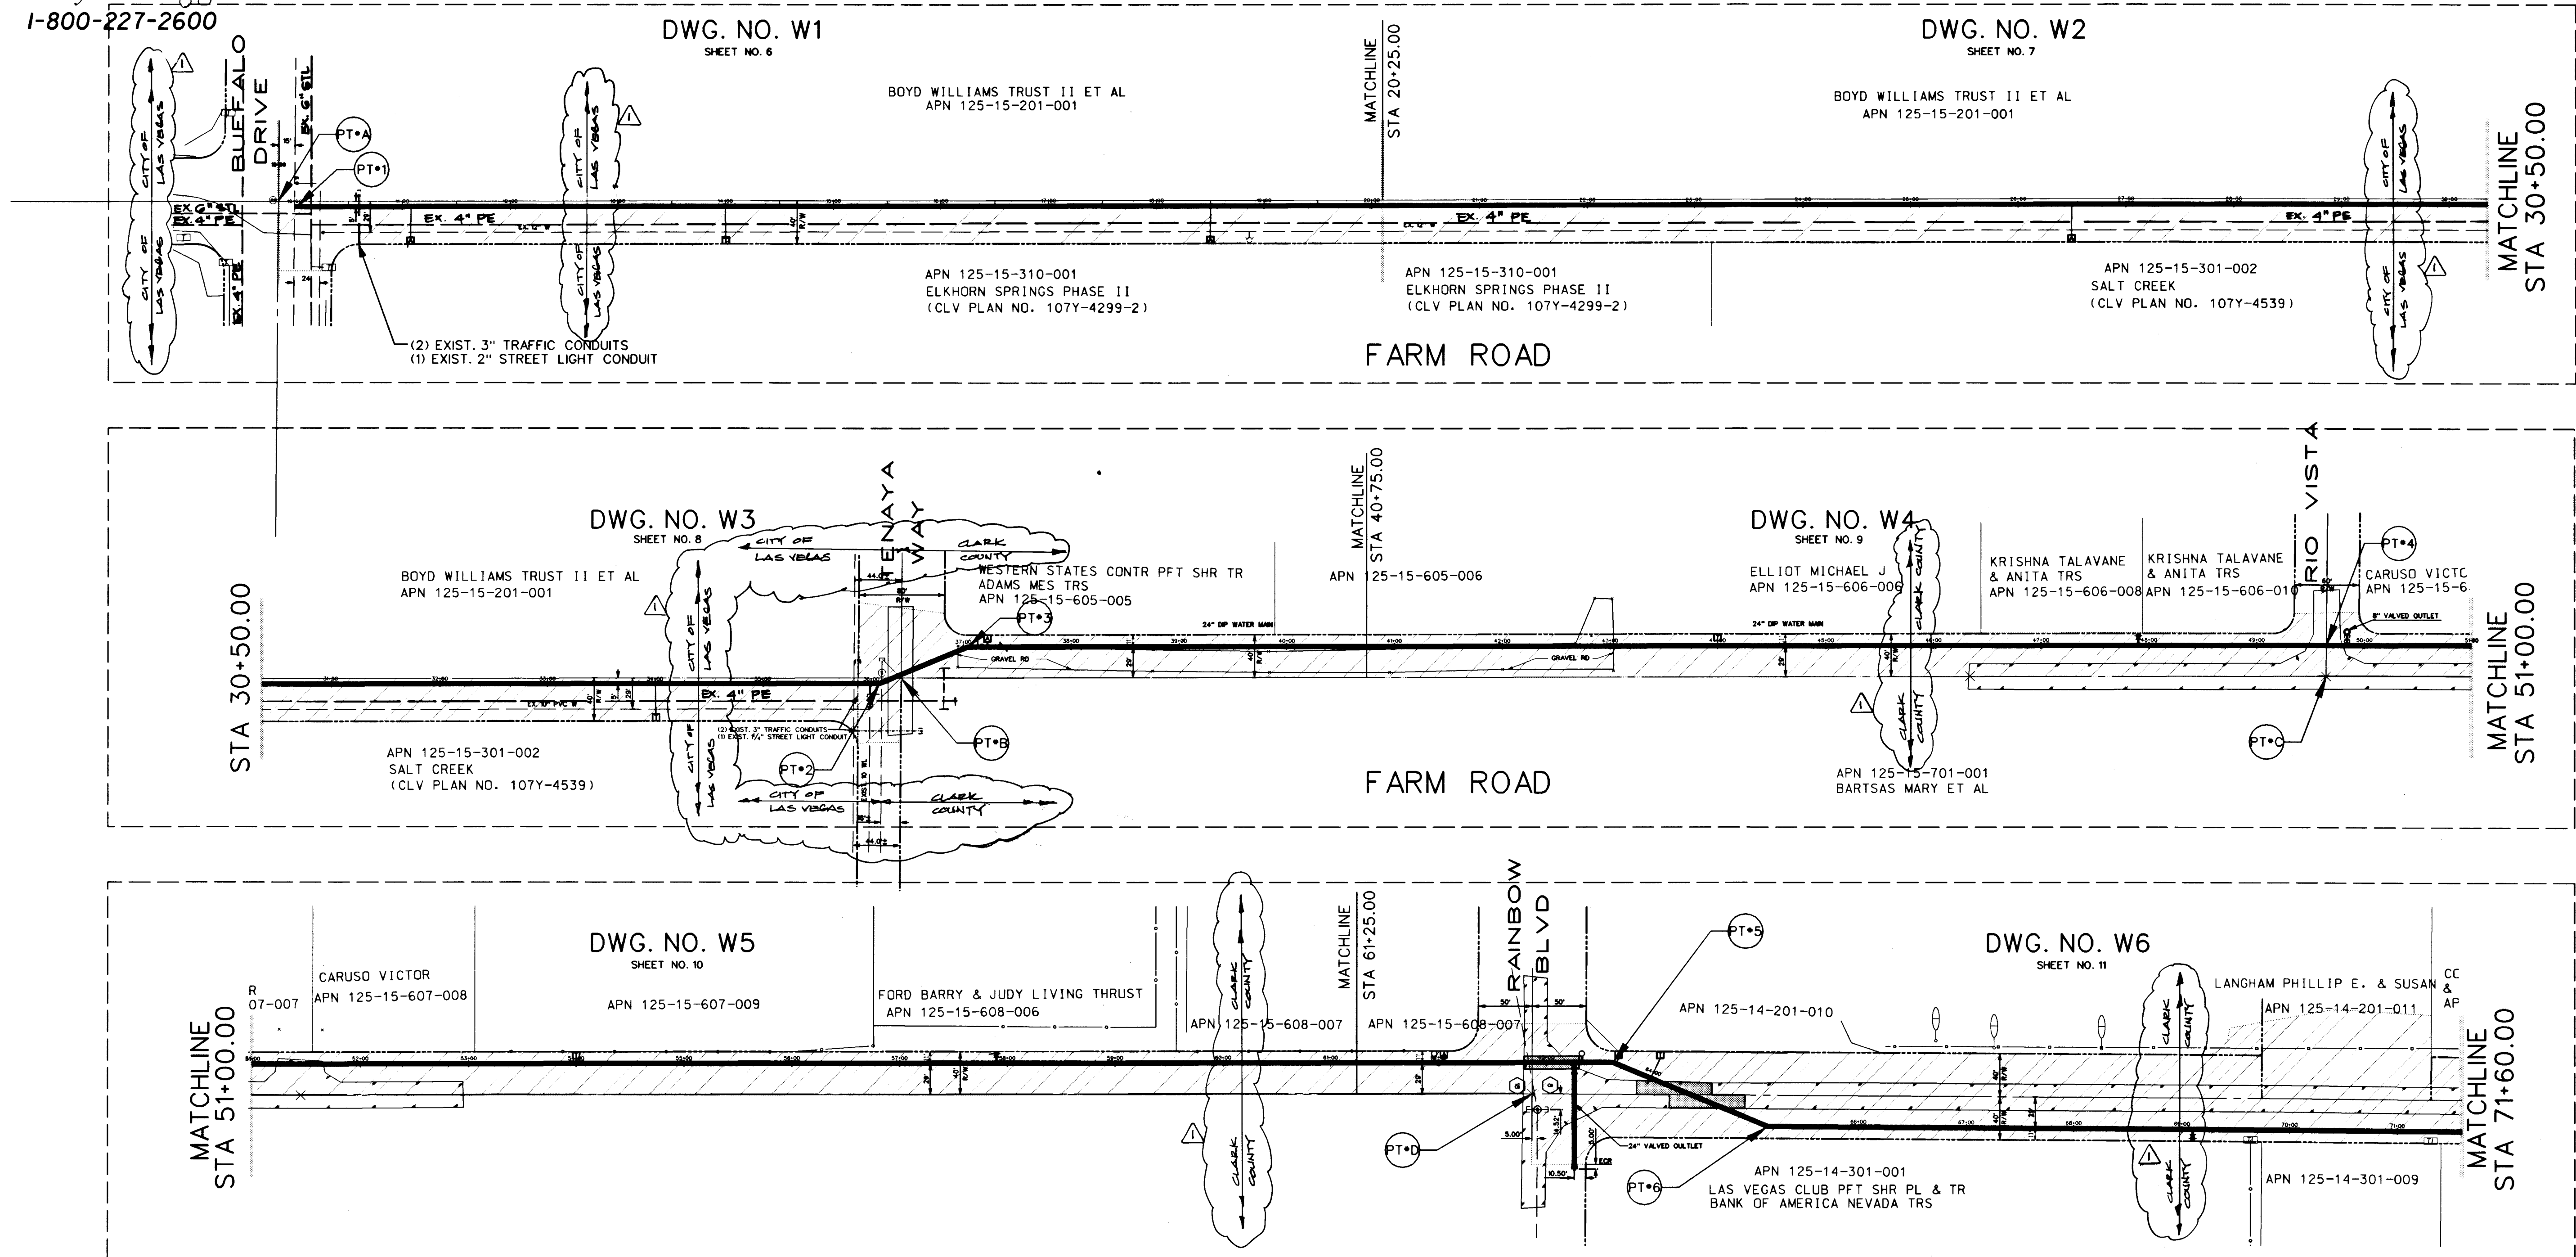

FARM ROAD WATERLINE COORDINATES


PROJECT COORDINATES		PROJECT GEOMETRY		
NO.	NORTHING	EASTING	BEARING	DISTANCE
PT*1	N 52440.5922	E 86916.9957	N89°54'59"E	2608.09'
PT*2	N 52444.3995	E 89525.0820	N67°31'16"E	89.16'
PT*3	N 52478.4892	E 89607.4677	N89°55'01"E	1259.03'
PT*4	N 52480.3460	E 90867.2961	N89°54'56"E	1397.24'
PT*5	N 52482.4058	E 92264.5376	N67°35'04"E	155.83'
PT*6	N 52422.9851	E 92408.5923	N89°39'27"W	2452.06'
PT*7	N 52408.3224	E 94860.6009	N89°39'26"W	1329.86'
PT*8	N 52400.3667	E 96190.4570	N89°38'22"W	1330.04'
PT*9	N 52399.7982	E 97610.6400	N85°03'52"E	90.53'
PT*10	N 52399.7982	E 97610.6400		

SURVEY CONTROL

PROJECT COORDINATES		PROJECT GEOMETRY		
NO.	NORTHING	EASTING	BEARING	DISTANCE
PT#A	N 52445.5710	E 86902.0277	N89°54'59"E	2643.09'
PT#B	N 52449.4289	E 89545.1149	N89°55'01"E	1322.23'
PT#C	N 52451.3461	E 90867.3385	N89°54'56"E	1322.24'
PT#D	N 52453.2953	E 92189.5770	N89°39'27"W	2671.24'
PT#E	N 52437.3218	E 94860.7743	N89°39'26"W	1329.88'
PT#F	N 52429.3662	E 96190.6305	N89°38'22"W	1330.02'
PT#G	N 52420.9971	E 97520.6291		

LEGEND

- DEDICATED RIGHT-OF-WAY
- RIGHT-OF-WAY BNDRY
- EASEMENT BNDRY
- ROADWAY CENTERLINE
- FOUND MONUMENT
- BENCHMARK LOCATION
- ACCESS MANHOLE
- VALVE VAULT
- PROPOSED 24" WATER LINE

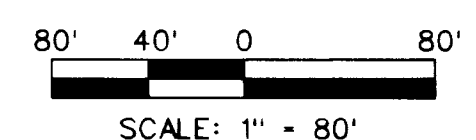

APPROVED FOR CONSTRUCTION

Gregory P. Robinson
LAS VEGAS VALLEY WATER DISTRICT

11/4/98
DATE

THE GATES, L.L.C.
7201 WEST LAKE MEAD BOULEVARD
SUITE 1604
LAS VEGAS, NEVADA 89128

SURVEY CONTROL PLAN
AND KEY MAP

SHEET

DRAWN BY: BB
DESIGNED BY: BB
CHECKED BY: MV
PROJECT NO: 99902003

SCALE: 1" = 80'

APPROVED FOR CONSTRUCTION
Gregory P. Robinson
LAS VEGAS VALLEY WATER DISTRICT

11/4/98
DATE




SHEET
C4
4 OF 19 SHEETS

DRAWING NO.

11/4/98

567Y-4576-OW

Instructions
Call before
you dig

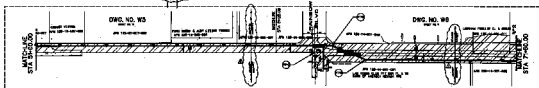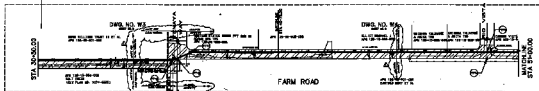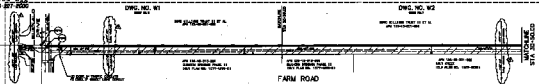

FARM ROAD
WATERLINE COORDINATES




LEGEND



APPROVED FOR CONSTRUCTION

THE GATES, L.L.C.


SURVEY CONTROL, PLAN
AND KEY MAP

