



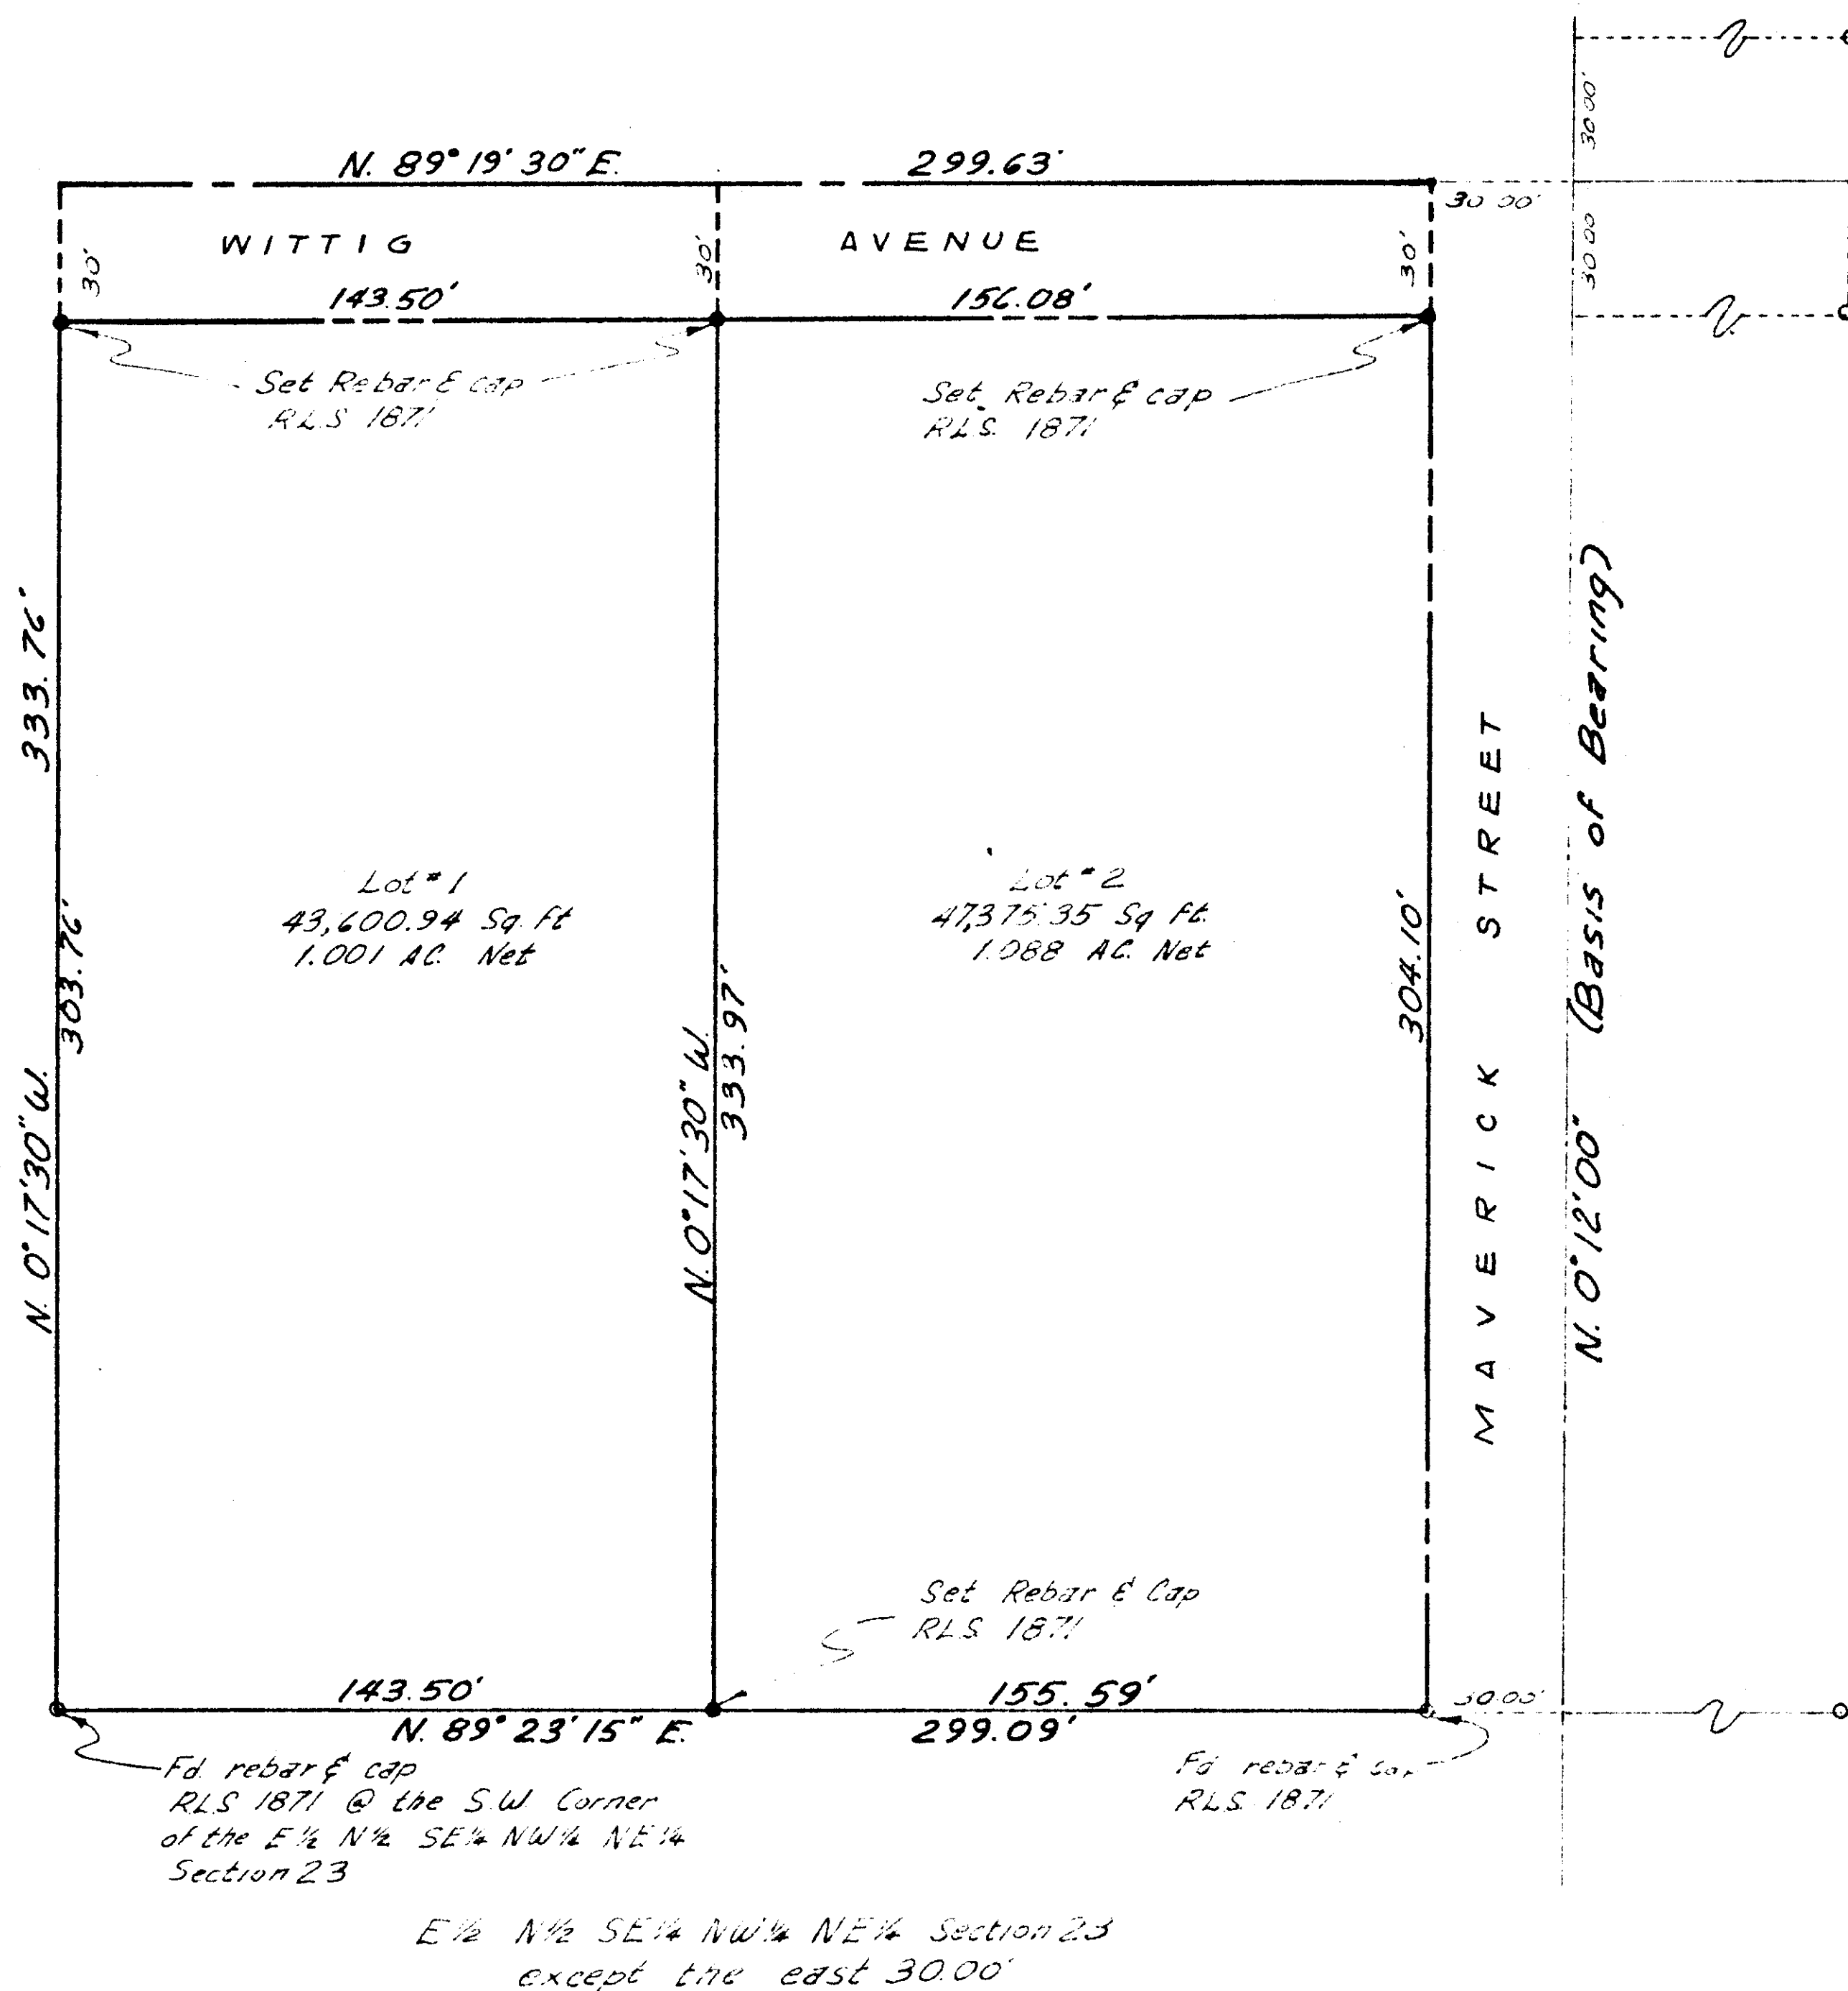

Found rebar Per
File 19 Page 5

North
Scale 1"=30'

North
No Scale

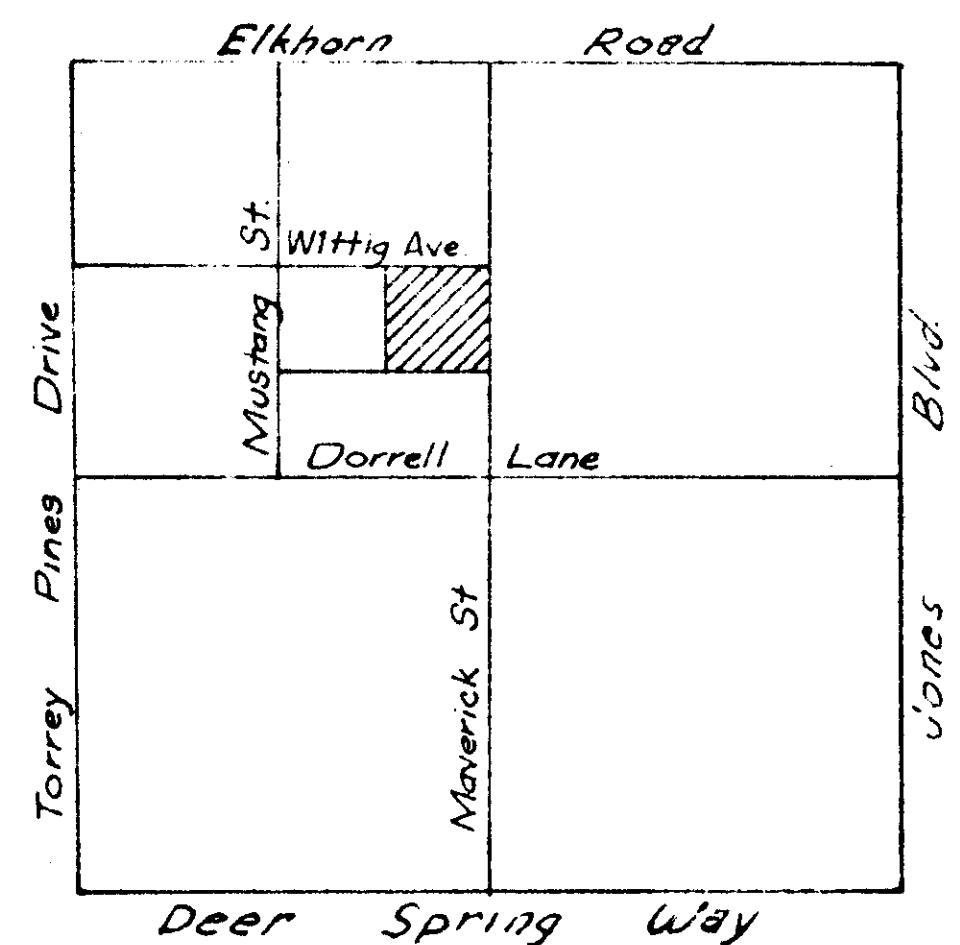

NE 1/4 Section 23
Vicinity Map

Basis of Bearing

East Line NW 1/4 NE 1/4 N. 0° 12' 00" W. as shown
on file 19, Pages, Clark County Recorder's
office.

- Indicates set rebar & RLS 1871 Cap
- Indicates found rebar & RLS 1871 Cap.

Certificate:

This is to certify that the survey of the parcel
Platted hereon was made under the direction and
was completed on the 2nd day of February, 1973
at the instance of Omer L. Glover. This is not a
subdivision as defined in the planning & zoning
laws as shown in the 1943-49 Supp. Nevada
compiled laws.

Person E. Myers RLS 1871

Certificate of Minor Subdivision Map

Approved and accepted as meeting the requirements
of Chapter 28.32 Clark County code for minor
subdivisions, and the conditions of approval as
imposed by the Clark County Planning Commission.

George C. Monahan 4-12-73
George C. Monahan - Director of Public Works Date
E. J. Downey 4-13-73
E. J. Downey - Director of Planning Date

MS-45-73

DELTA ENGINEERING INC.		4239 W SAHARA AVE LAS VEGAS, NEV 89102 PHONE 702-876-0330		No. 277707 Recorded at the recorder's Office Date 4-13-73 File 25 Page 3
RESULTS OF SURVEY OF THE E 1/2 N 1/2 SE 1/4 NW 1/4 NE 1/4 SECTION 23, T.19S, R.60E, MDM., CLARK COUNTY, NEVADA. FOR: OMER L. GLOVER				
DRAWN <i>HR</i> JOB NO. 730208	DES. <i>21</i> H. SCALE 1"=30'	CHKD <i>HEM</i> V. SCALE —	DATE 2/23/73 SHEET 1 OF 1	Official Records Book No. 31 Clerk County, Nevada Record Paul E. Horn Recorder Fee \$2.50 Deputy 9