



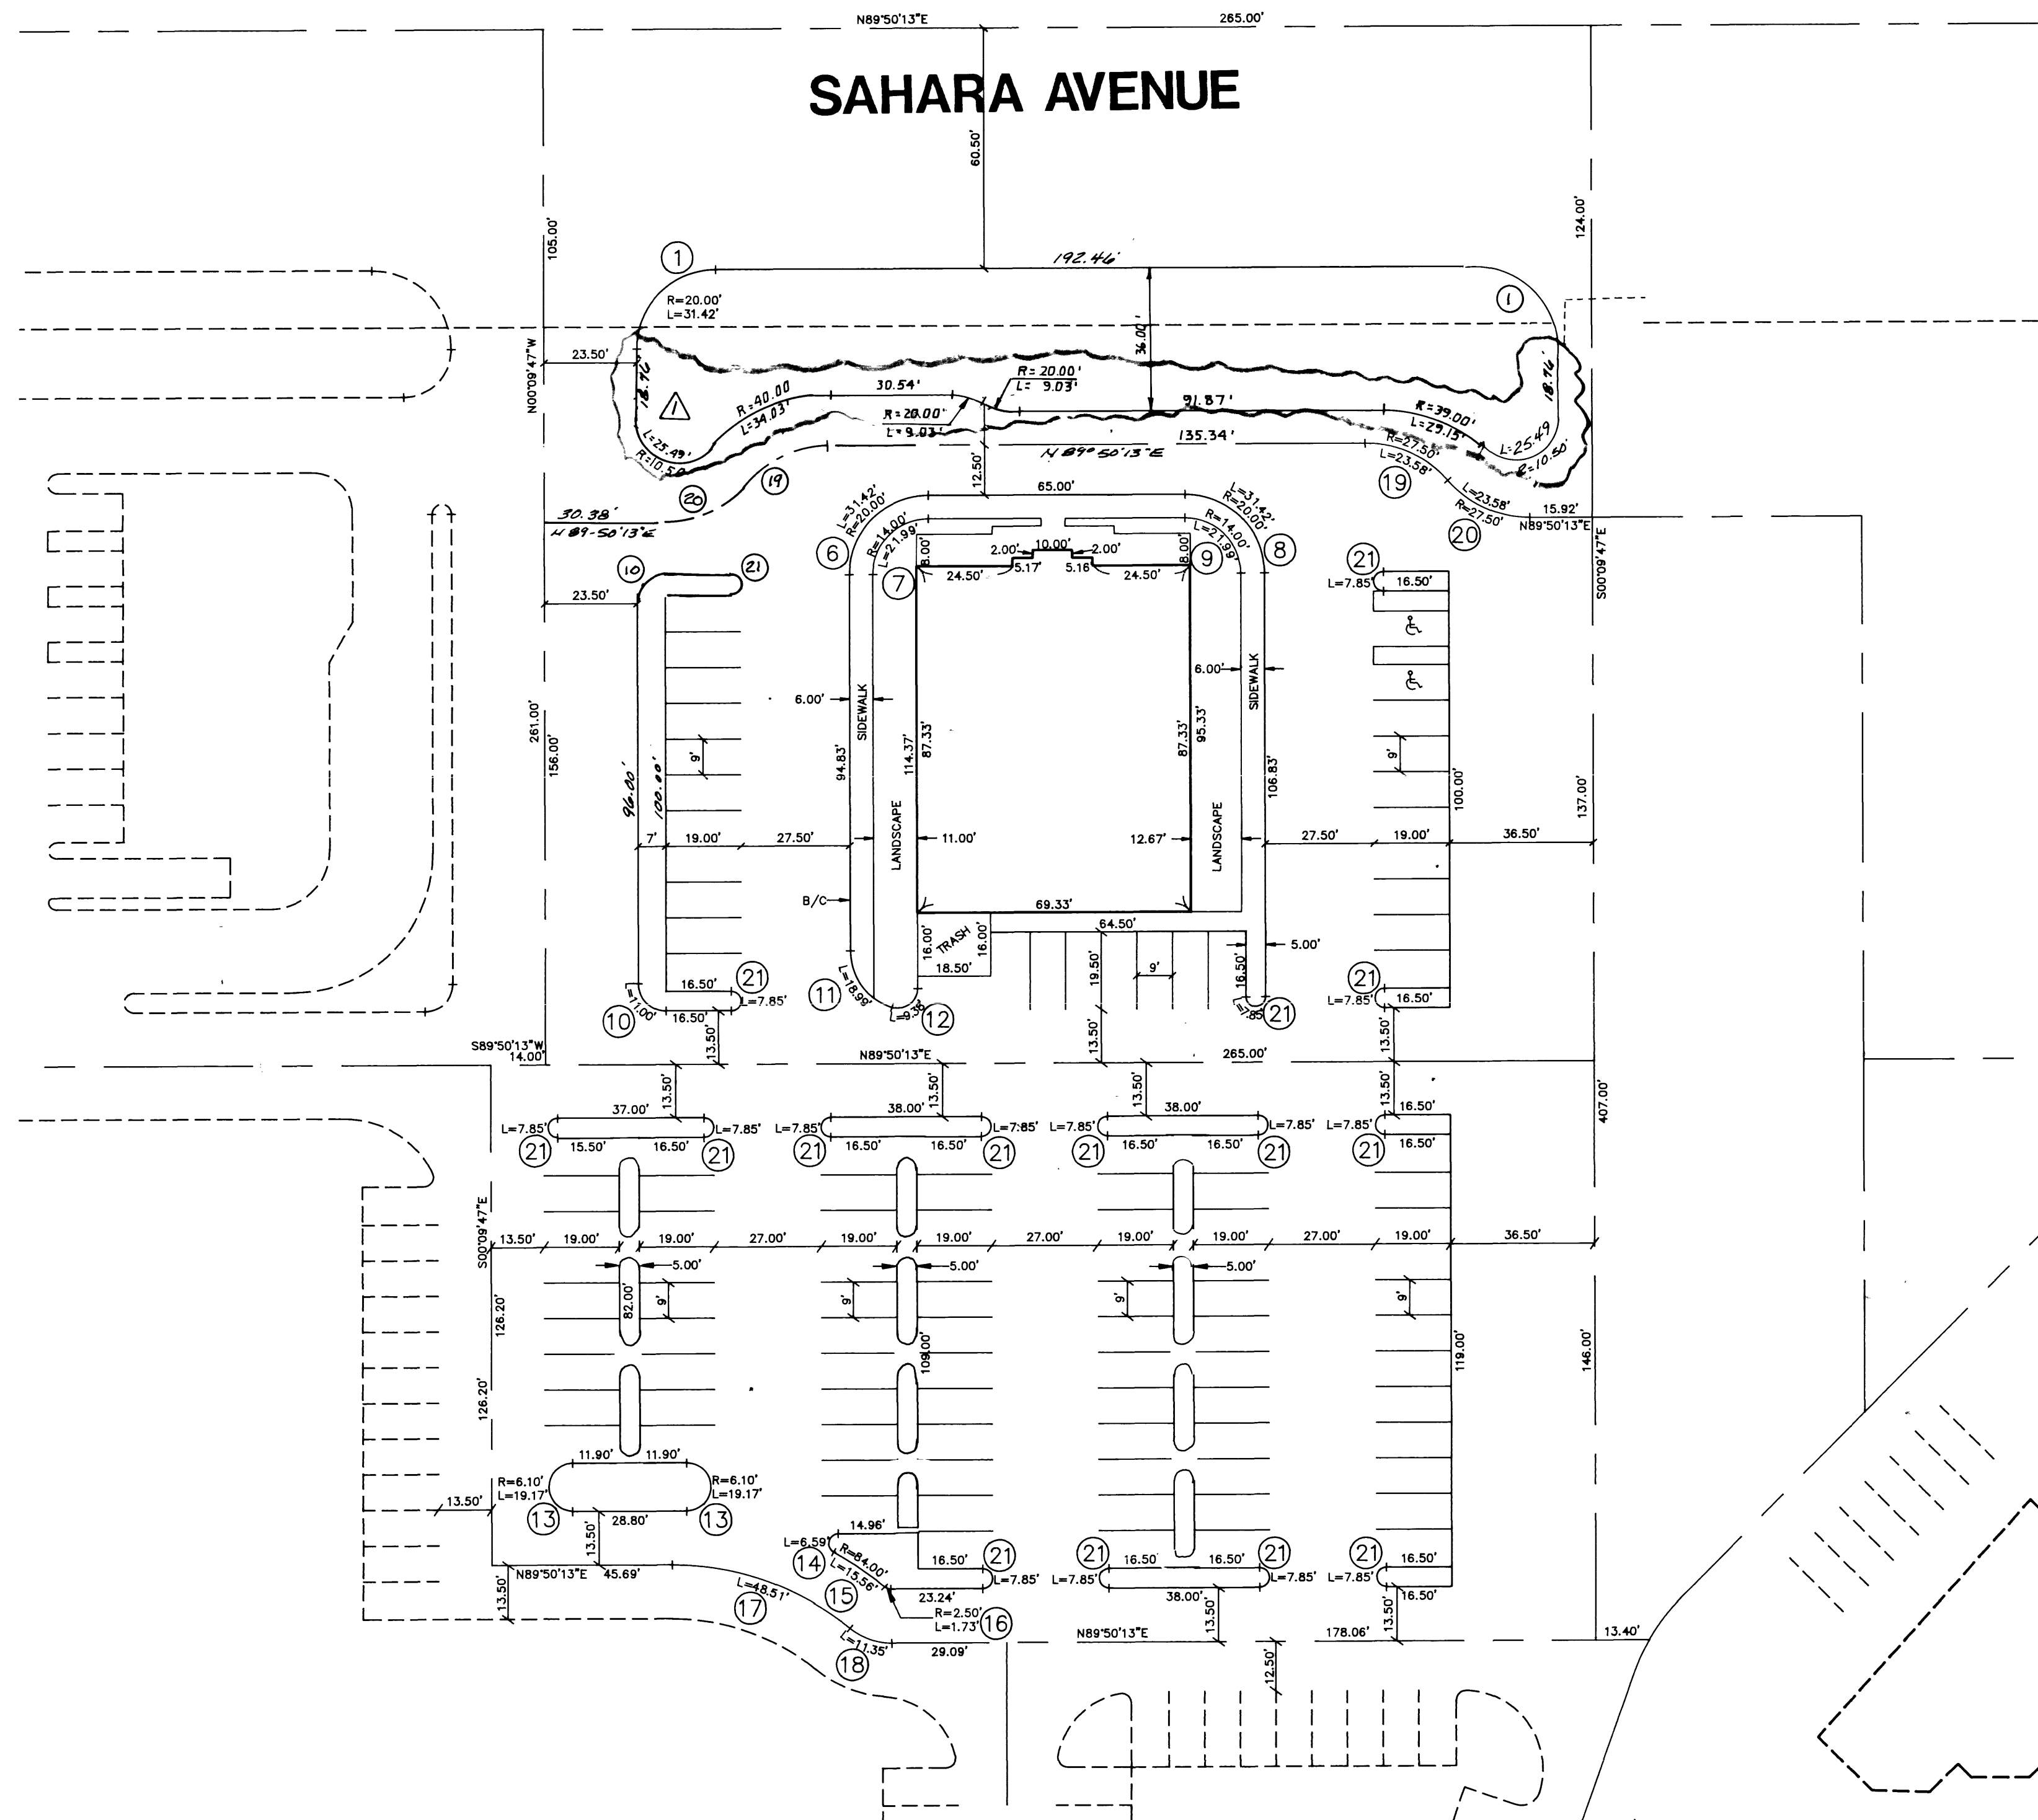


BENCHMARK
CLARK COUNTY BENCHMARK STAMPED "2C10 8NES"
RIVET AND SQUARE ALUMINUM PLATE IN TOP OF
CURB, SOUTHWEST CORNER OF DURANGO DRIVE AND
SAHARA AVENUE.
ELEVATION = 2862.65 FEET

BASIS OF BEARINGS
NORTH 89°50'13" EAST, BEING THE NORTH LINE OF THE
NORTHEAST QUARTER (NE 1/4) OF THE NORTHEAST QUARTER
(NE 1/4) OF SECTION 8, TOWNSHIP 21 SOUTH, RANGE 60
EAST, M.D.M., AS SHOWN ON THAT CERTAIN PLAT OF LAKESIDE
PLAZA ON FILE IN THE OFFICE OF THE COUNTY RECORDER,
CLARK COUNTY, NEVADA IN BOOK 38 OF PLATS, PAGE 08.

2 working days
Call before you Dig
1-800-227-2600

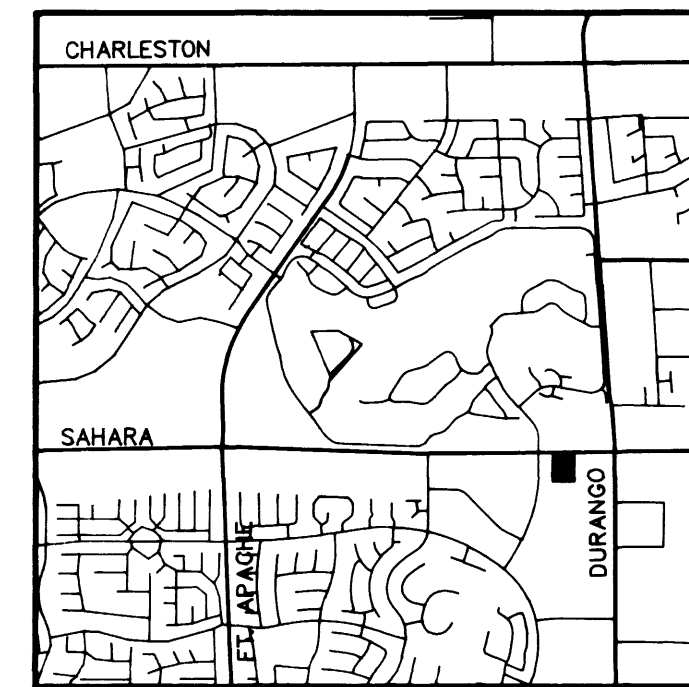

LOCATION MAP

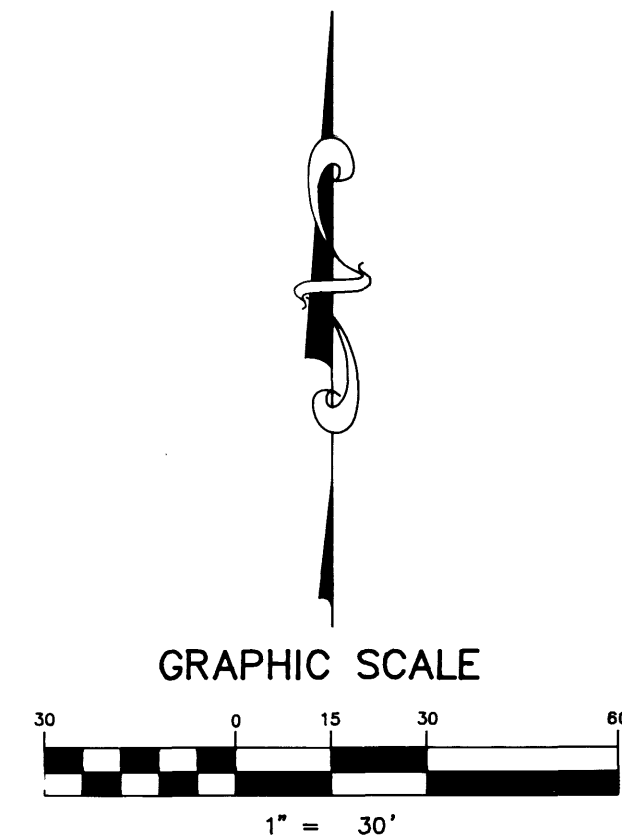


CURVE TABLES				
CURVE	RADIUS	LENGTH	TANGENT	DELTA
1	20.00'	31.42'	20.00'	90°00'00"

OUTBACK STEAKHOUSE
CITY OF LAS VEGAS

vtm nevada

HORIZONTAL CONTROL PLAN

OUTBACK STEAKHOUSE

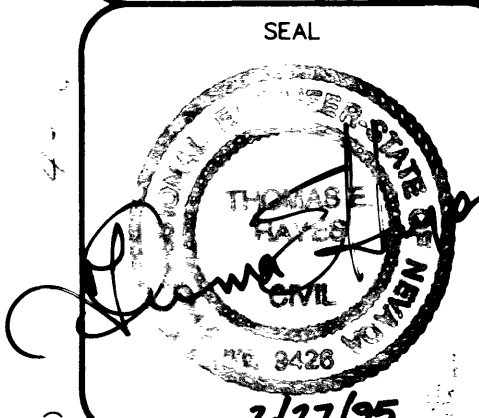

WO NO. 4806
BY
DATE FEB., '95
SCALE 1" = 30'
SHEET 3 OF 4 SHEETS

107-V2345