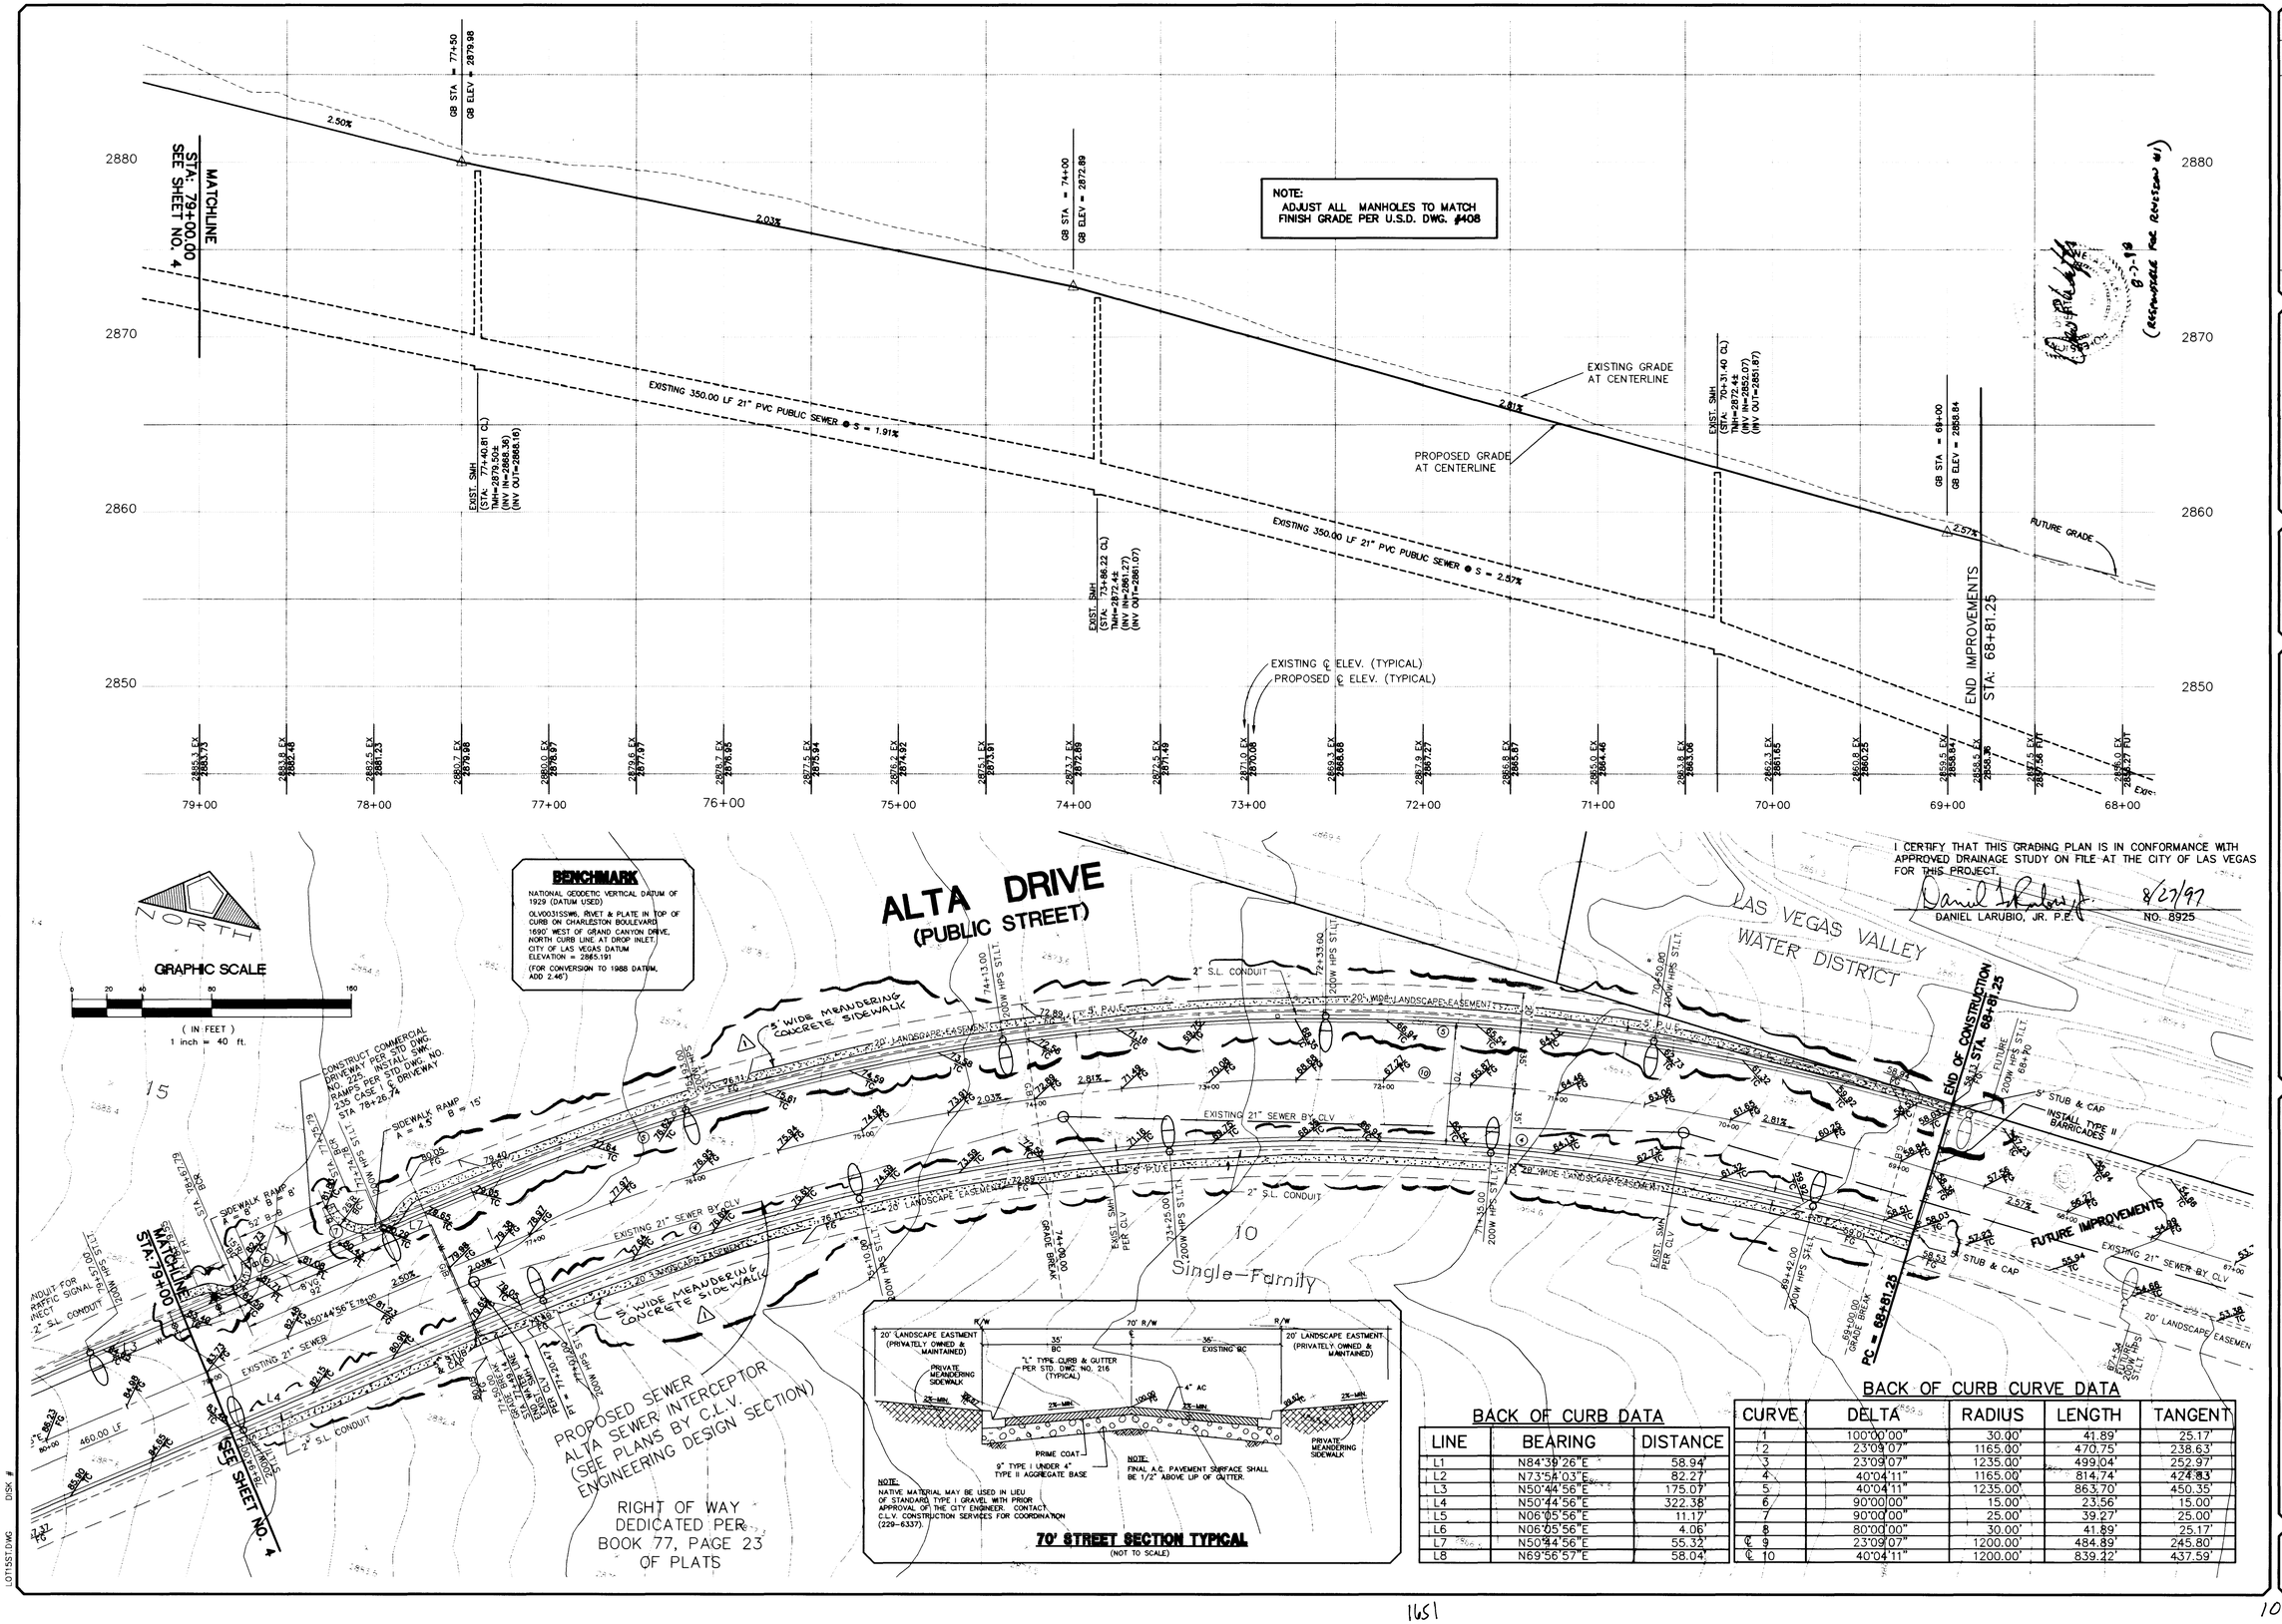

BACK OF CURB DATA

LINE	BEARING	DISTANCE
L1	N84°39'26"E	58.94'
L2	N73°54'03"E	82.27'
L3	N50°44'56"E	175.07'
L4	N50°44'56"E	322.38'
L5	N06°05'56"E	11.17'
L6	N06°05'56"E	4.06'
L7	N50°44'56"E	55.32'
L8	N69°56'57"E	58.04'

BACK OF CURB CURVE DATA

CURVE	DELTA	RADIUS	LENGTH	TANGENT
1	100°00'00"	30.00'	41.89'	25.17'
2	23°09'07"	1165.00'	470.75'	238.63'
3	23°09'07"	1235.00'	499.04'	252.97'
4	40°04'11"	1165.00'	814.74'	424.83'
5	40°04'11"	1235.00'	863.70'	450.35'
6	90°00'00"	15.00'	23.56'	15.00'
7	90°00'00"	25.00'	39.27'	25.00'
8	80°00'00"	30.00'	41.89'	25.17'
℄ 9	23°09'07"	1200.00'	484.89'	245.80'
℄ 10	40°04'11"	1200.00'	839.22'	437.59'

I CERTIFY THAT THIS GRADING PLAN IS IN CONFORMANCE WITH APPROVED DRAINAGE STUDY ON FILE AT THE CITY OF LAS VEGAS FOR THIS PROJECT.

DANIEL LARUBIO, JR. P.E. 8/27/97 NO. 8925

NO.	DESCRIPTION	DATE	APP'D
1	ADDED SIDEWALK	KOP 8/11	

RECOMMENDED: DAN LA RUBIO, JR. P. E. # 8925 DATE 8/27/97

(RESUBMITTAL FOR REVISION #1) 8-27-98

DATE: 1/16/97
DRAWN BY:
DESIGNED BY:
CHECKED BY:
JOB NO.: 0145.0017
SCALE: 1" = 40'

PENTACORE
CIVIL ENGINEERING • LAND SURVEYING • PLANNING
CONSTRUCTION MANAGEMENT • ADA CONSULTING
6763 WEST CHARLESTON BOULEVARD
LAS VEGAS, NEVADA 89102 (702)258-0115

PECCOLE NEVADA CORP.
PECCOLE WEST - ALTA DRIVE IMPROVEMENTS
(STA. 79+00 TO STA. 68+81.25)
PLAN AND PROFILE - PHASE I

SHEET 5 OF 6

Q:\0145\0017\ALTA-PH1\LOT15ST Wed Aug 27 11:58:39 1997 Charlie Bell
LOT15ST.DWG DISK #

1651

107-V2725

 
ALTA DRIVE
LAS VEGAS VALLEY WATER DISTRICT
NORTH
GRAPHIC SCALE
RIGHT OF WAY DEDICATED PER BOOK 77, PAGE 23 OF PLATS
TO
Single-Family
BACK OF CURB DATA
LINE
BEARING
DISTANCE
BACK-OF-CURB CURVE DATA
CURVE
DELTA
RADIUS
LENGTH
TANGENT
PENTACORE
5
107-72726