


6-6-106

BOOK 860829

PAINTED DESERT

A PLANNED RESIDENTIAL DEVELOPMENT

A PORTION OF THE N1/2 AND THE SE1/4 OF SECTION 34 AND A PORTION OF THE N1/2 OF SECTION 33, T 19 S, R 60 E, M.D.M., CITY OF LAS VEGAS, CLARK COUNTY, NEVADA.

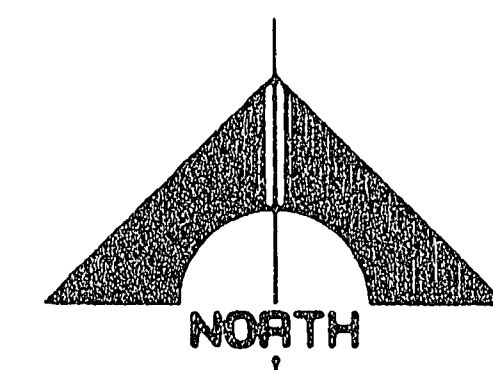


SCALE: 1" = 100'

LEGEND

- ◆ SET BRASS CAP & CONC. IN WELL (TYPE I)
- ▲ SET BRASS CAP & CONC. (TYPE II)
- SET REBAR & ALI CAP
- SET BRASS CAP IN TOP OF CURB (TYPE III A)

LINE	BEARING	DISTANCE
1	S 43° 54' 13" E (R)	30.00
2	S 43° 54' 13" E (R)	30.00
3	S 00° 54' 32" E	50.00
4	S 53° 47' 04" E	24.85
5	S 85° 55' 00" E	47.84
6	N 89° 48' 01" E	54.70
7	N 87° 58' 06" E	47.43
8	N 00° 11' 59" W	70.00

CURVE	DELTA	ARC	RADIUS	TANGENT
1	89° 17' 27"	38.98	25.00	24.88
2	90° 00' 00"	39.27	25.00	25.00
3	30° 00' 00"	178.98	338.00	90.57
4	2° 25' 45"	10.00	235.83	5.00
5	2° 25' 45"	10.00	235.83	5.00
6	5° 20' 57"	32.36	346.60	16.9
7	38° 16' 23"	231.53	346.60	120.27
8	30° 00' 00"	215.72	412.00	110.40
9	90° 00' 00"	39.27	25.00	25.00
10	36° 52' 12"	16.09	25.00	8.33
12	53° 07' 48"	23.18	25.00	12.50
13	78° 27' 44"	34.24	25.00	20.41
14	30° 00' 00"	198.35	375.00	100.48
15	11° 32' 16"	5.03	25.00	2.53

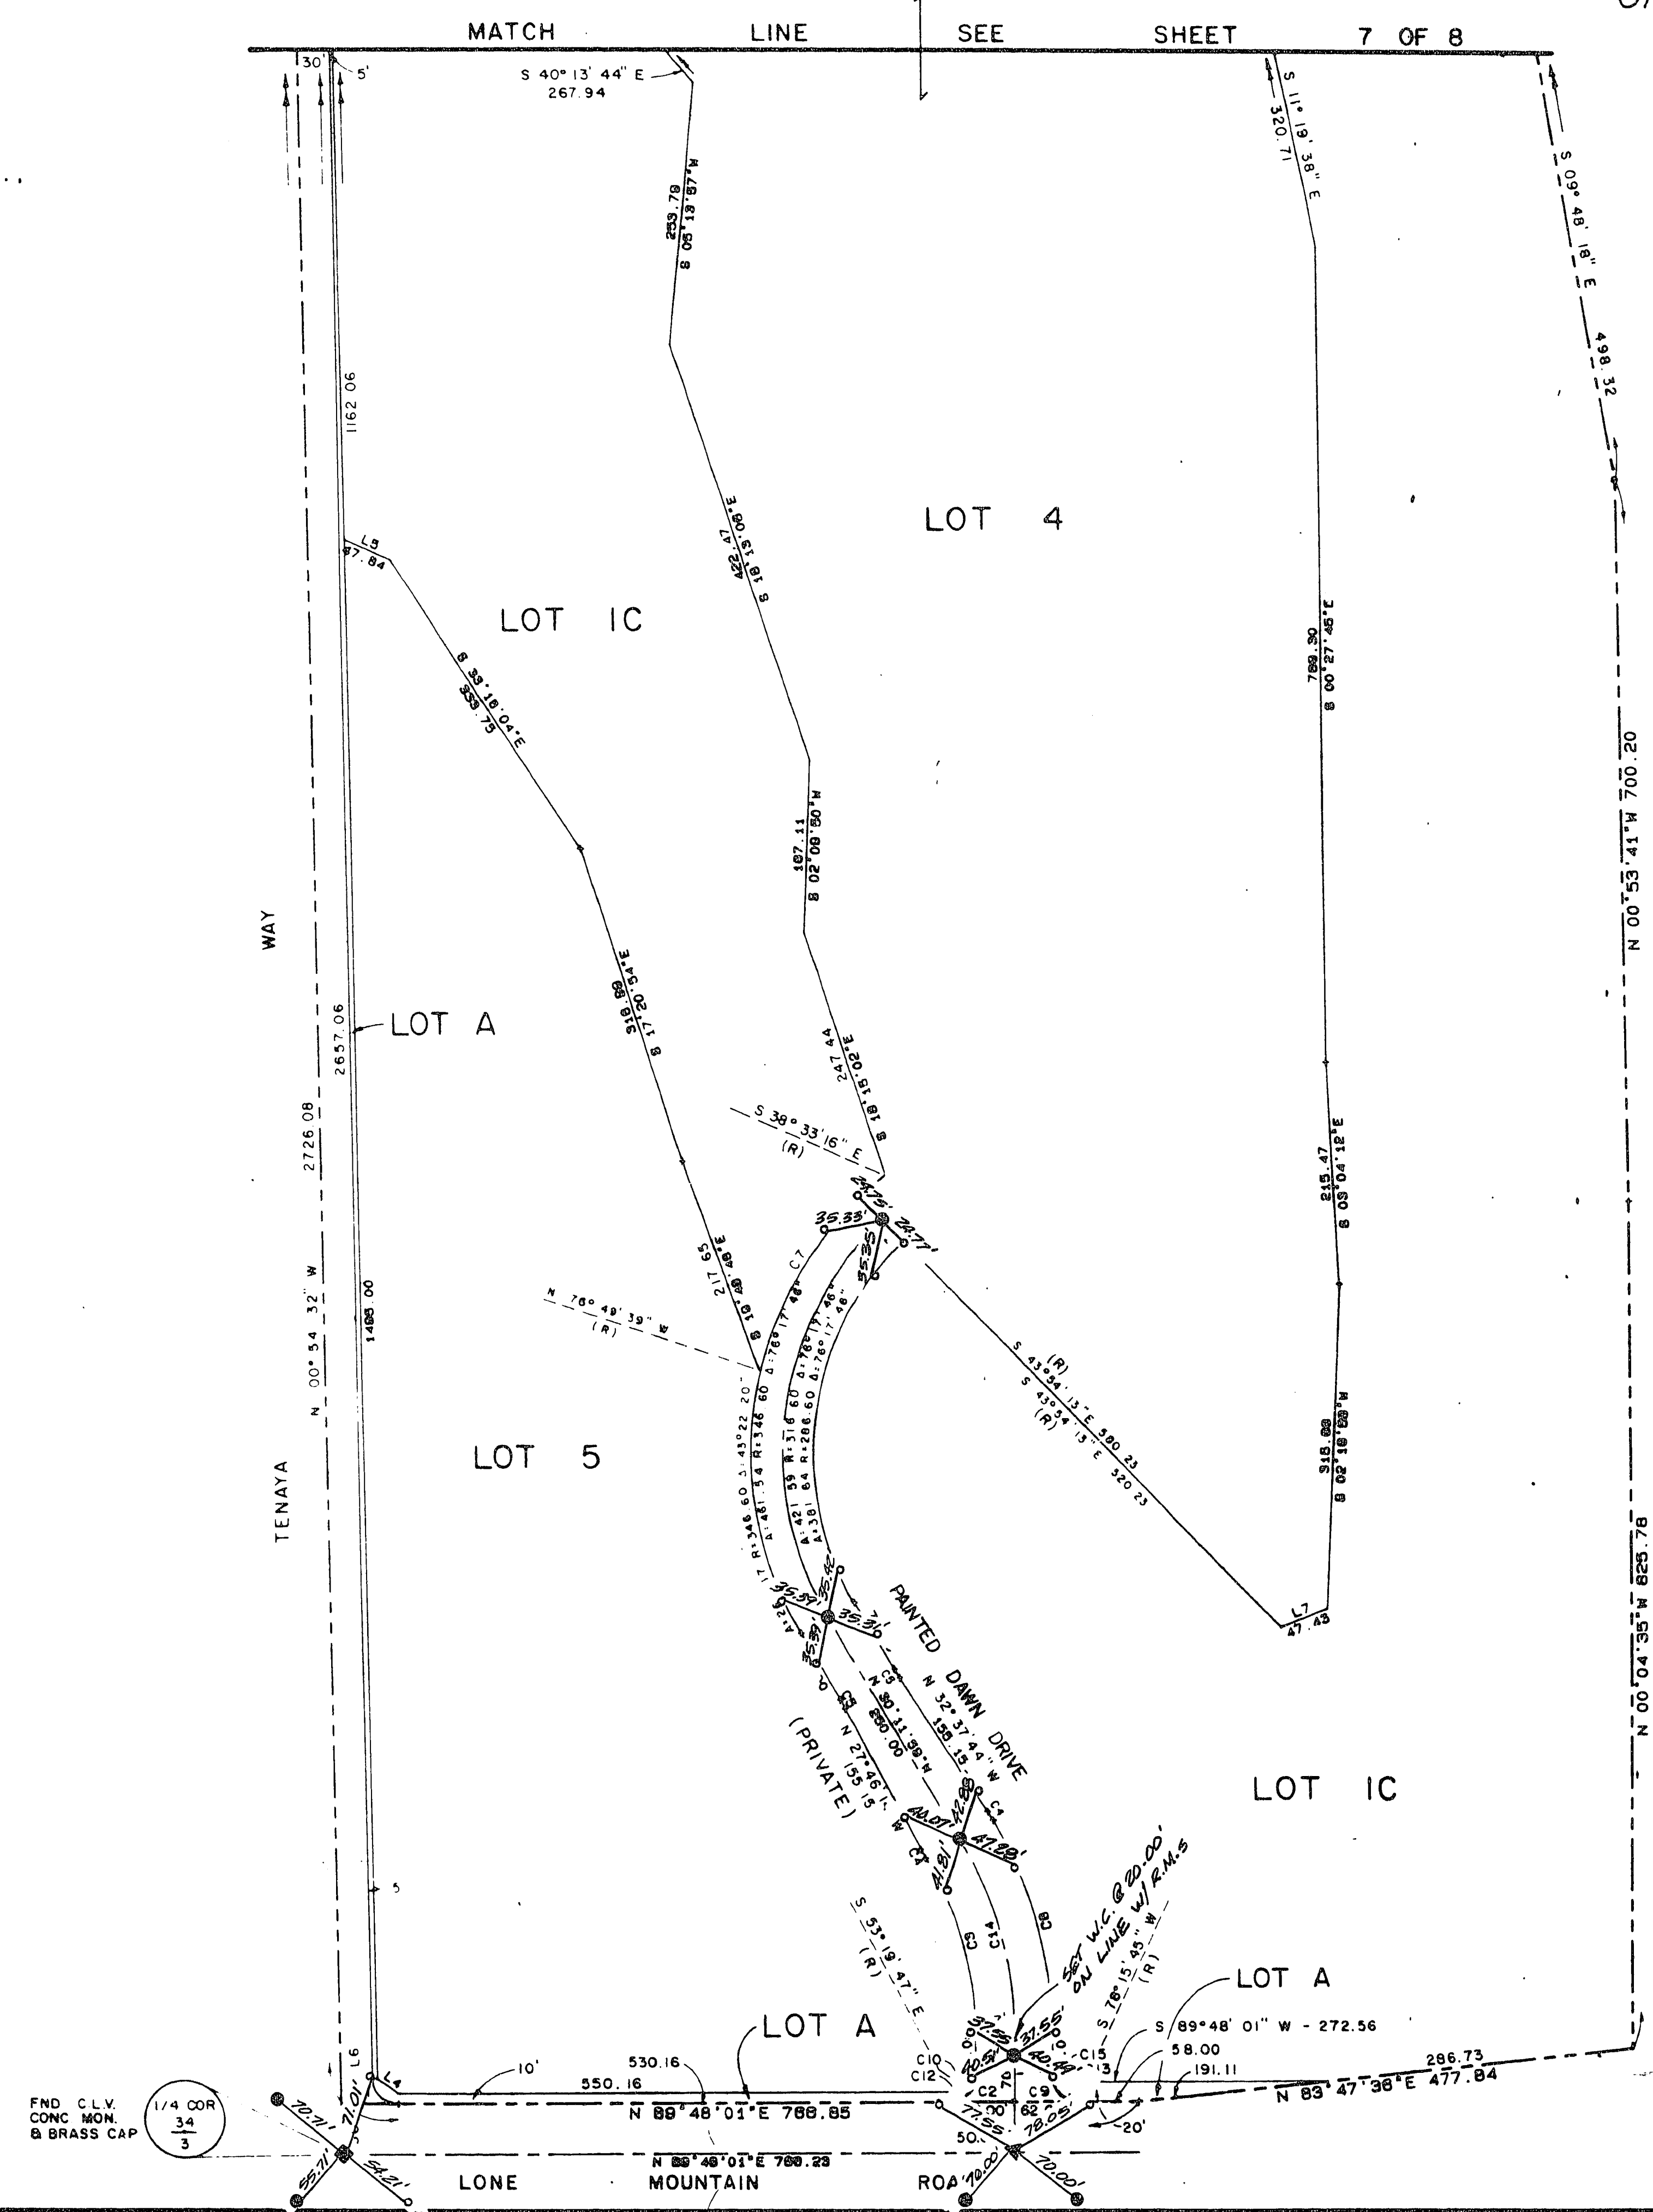

01119

MATCH LINE SEE SHEET 7 OF 8

ORAN K. GRAGSON HIGHWAY

MONUMENT TIE MAP

SHEET 8 OF 8
Book 35 Page 39