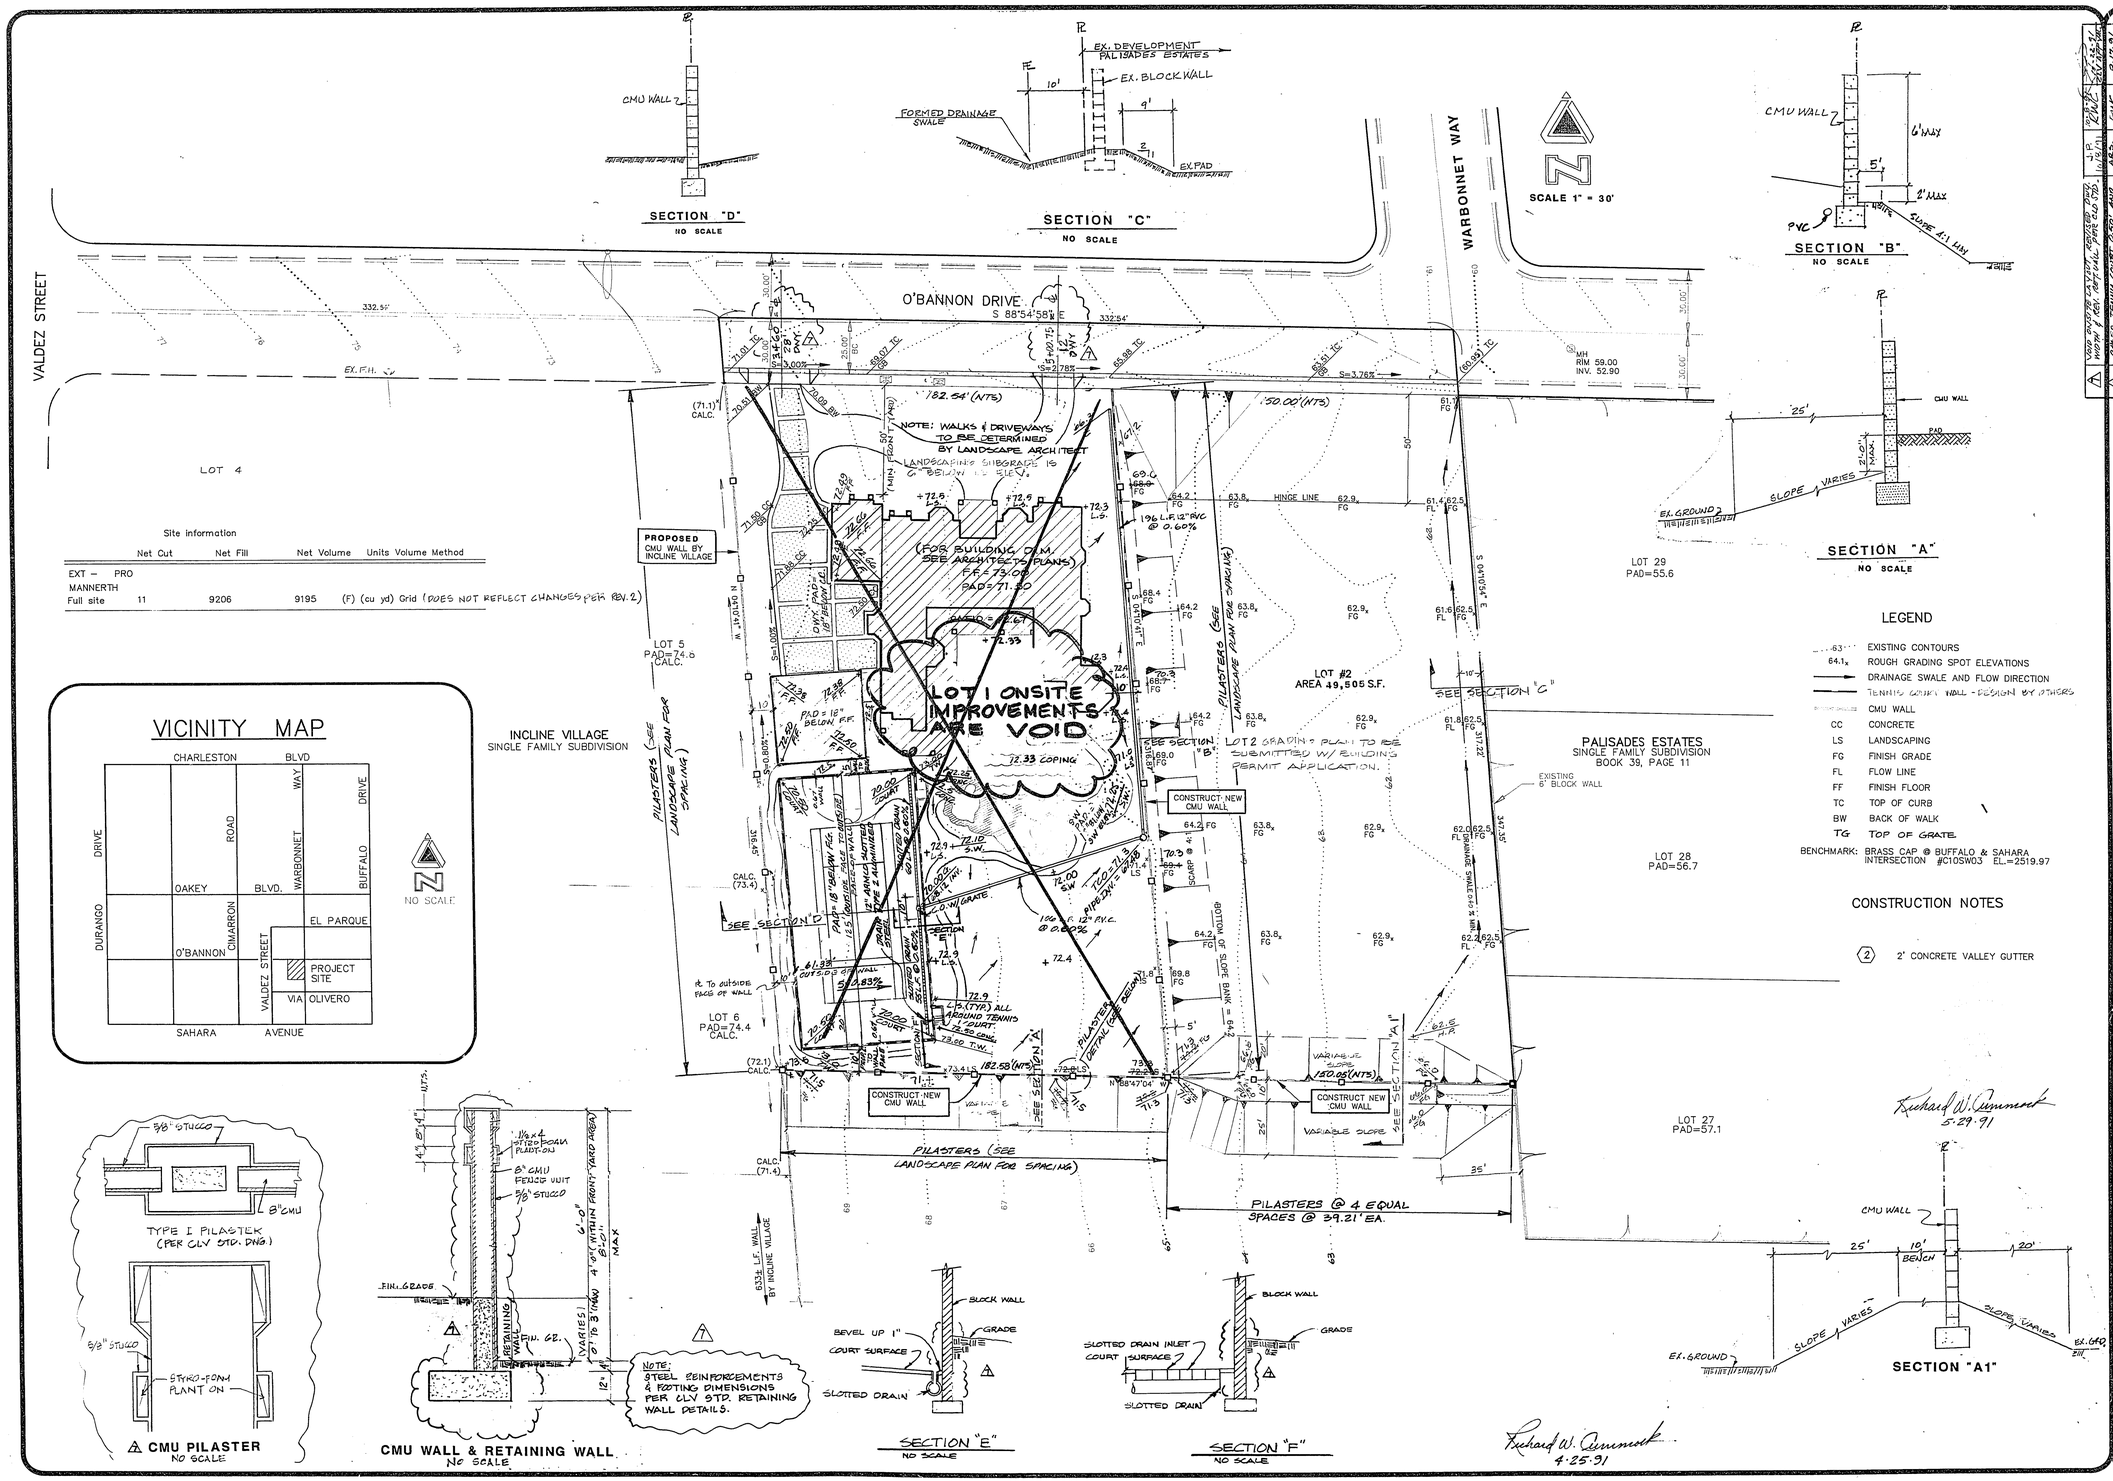

SYM	DESCRIPTION	BY	DATE
7	VOID ROOFS CANOPY, ROCKER PAD, WORK & REV. REFUSE PER ELD TRD.	J.P. 11/16/90	RWC 12/13/90 RWC 12/20/90
6	REVISED PALISADES SINGLE FAMILY SUBDIVISION BOUNDARY PER ALTA SURVEY	RWC 2/25/91	RWC 2/27/91
5	REVISED TENNIS COURT DRAIN LINE & TENNIS COURT CORNERS.	A.R.S. 8/5/91	RWC 8/5/91
4	REVISED SLOPE & DRAIN LOCATION IN TENNIS COURT	A.R.S. 8/11/91	RWC 8/11/91
3	REV. TENNIS COURT LENGTH, ADD PAD HEIGHTS & REVISE CUT & FILL	J.P. 7/24/91	RWC 7/25/91
2	REVISED PADS & REGRADE PER ALTA SURVEY	7/18/91	RWC 7/25/91
1	REMOVE (2) UNDERSIDE WALK DRAINS ON O'BANNON	J.P. 6/13/91	RWC 7/25/91
REV. NO.		BY	APPROVAL DATE

SCALE (H) 1" = 30' SCALE (V)
DES. RWC
DR. JLB
SECTION 4 T. 21 S. R. 60 E.

ALCA
ENGINEERING & SURVEYING, INC.
820 S. VALLEY VIEW BOULEVARD
LAS VEGAS, NEVADA 89107-4411
(702) 878-3358 FAX: 878-1092

JOB TITLE
PLOT AND GRADING PLAN
FOR LOT #1
HOWARD MANN RESIDENCE
LAS VEGAS NEVADA

.DWG NAME MANNHSE
.DWG DATE 4/25/91

JOB NO. 88010105

SHEET 2 OF 4

26-36 107-V1898