

950927

CC 156

FINAL MAP OF THE CROSSING AT SUMMERLIN VILLAGE 8 UNIT NO. 3

A PLANNED COMMUNITY
BEING A SUBDIVISION OF A PORTION OF SECTION 25, TOWNSHIP 20 SOUTH,
RANGE 59 EAST, M.D.M., CITY OF LAS VEGAS, CLARK COUNTY, NEVADA


CURVE	DELTA	RADIUS	LENGTH	TANGENT
1	01°37'02"	2008.33'	56.69'	28.35'
2	01°37'02"	2000.00'	56.45'	28.23'
3	05°08'50"	1961.00'	176.17'	88.14'
4	05°08'50"	1945.00'	174.73'	87.42'
5	11°38'08"	300.00'	60.92'	30.57'
6	47°54'07"	60.00'	50.16'	26.65'
7	180°00'00"	2.16'	6.79'	—
8	88°53'54"	30.00'	46.55'	29.43'
9	180°00'00"	2.67'	8.39'	—
10	12°40'20"	300.00'	66.35'	33.31'
11	11°57'06"	328.00'	68.42'	34.34'
12	11°57'06"	300.00'	62.58'	31.40'
13	10°06'04"	272.00'	47.95'	24.04'
14	10°41'03"	300.00'	55.94'	28.05'
15	10°06'04"	300.00'	52.89'	26.51'
16	12°40'14"	300.00'	66.34'	33.31'
17	10°40'58"	300.00'	55.93'	28.05'
18	48°51'14"	60.00'	51.16'	27.25'
19	88°56'06"	30.00'	46.57'	29.45'
20	180°00'00"	2.66'	8.36'	—

LEGEND.

- SET 5/8" REBAR AND ALUM. CAP STAMPED P.L.S. 7755 W/ALUMINUM REFERENCE TIES IN TOP OF CURB (UNLESS OTHERWISE NOTED)
- SET 5/8" REBAR AND ALUM. CAP STAMPED P.L.S. 7755
- REFERENCE POINT
- 7 LOT NUMBER
TOTAL COMMON LOTS = 7
- 5 BLOCK NUMBER
- ① CURVE NUMBER
- SUBDIVISION BOUNDARY LINE
- STREET CENTERLINE
- SET 5/8" REBAR AND ALCAP STAMPED P.L.S. 9390
- ▲ SET 2" ALUMINUM REFERENCE MARKER STAMPED P.L.S. 9390

62008.403

PLATTED 01/28/08

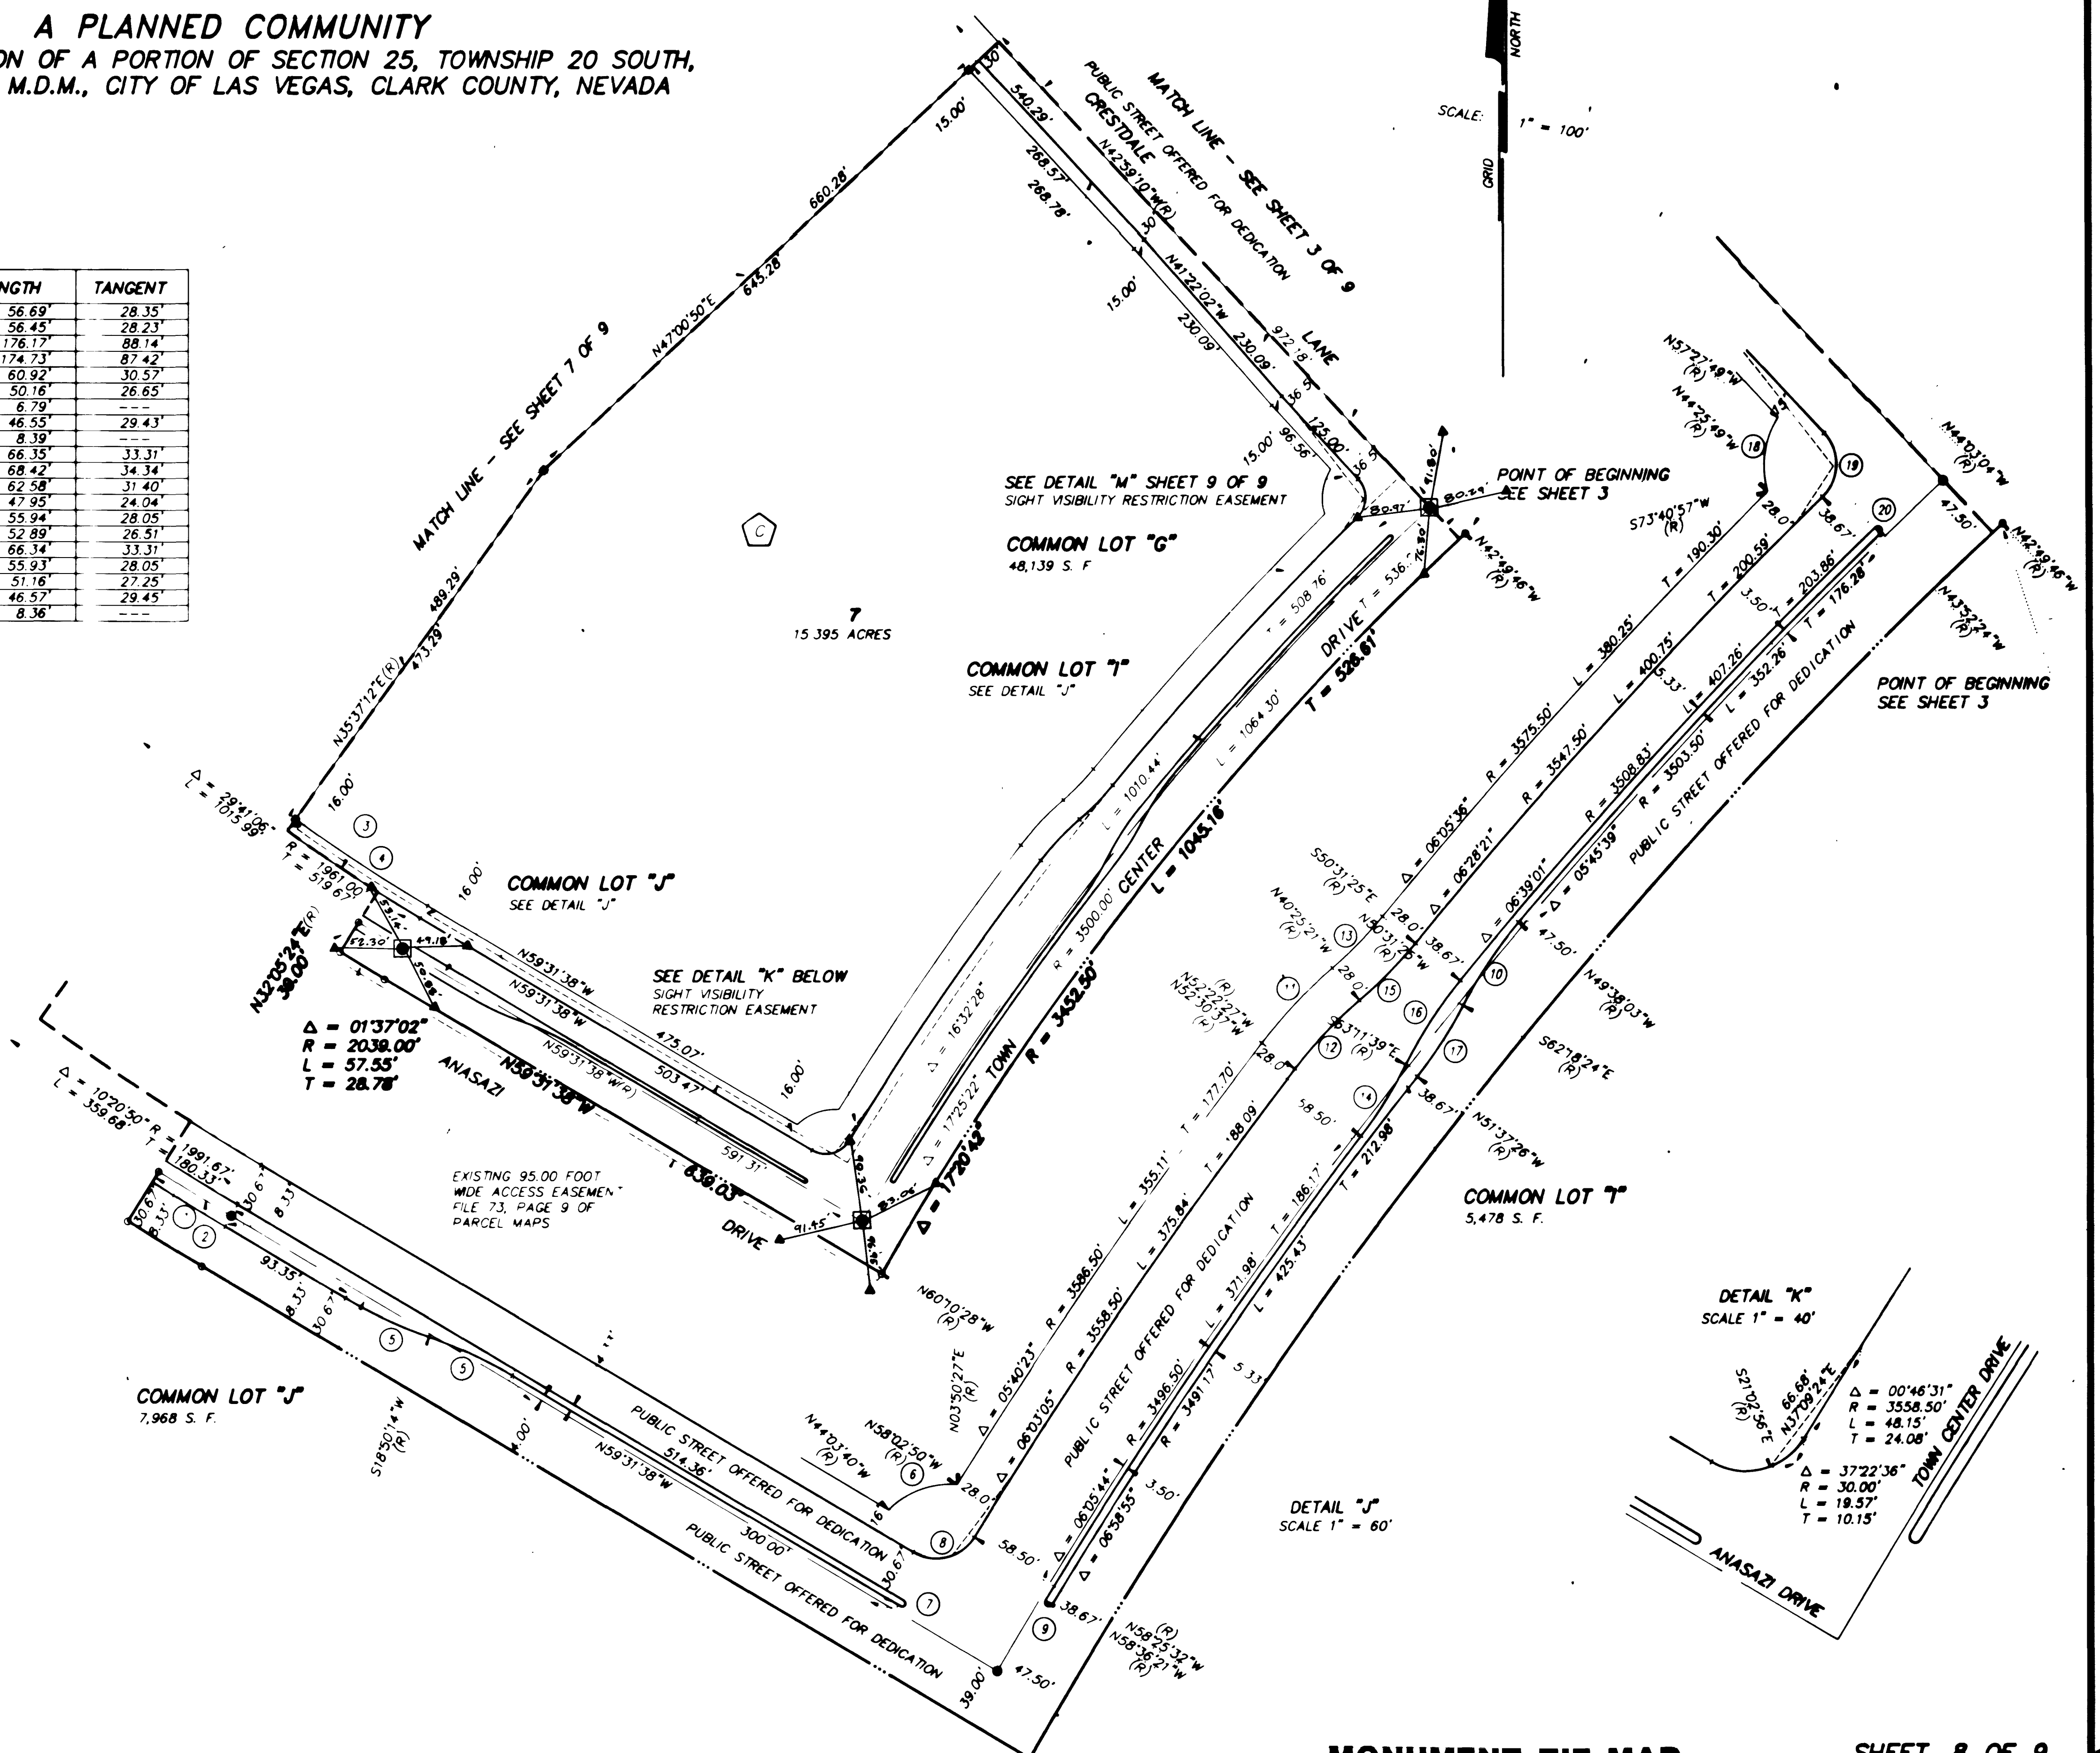

MONUMENT TIE MAP

SHEET 8 OF 9

(See #107-V22310, #107-V2289) Book 69 Page 99
#107-V2259, #731-593 15-6-13 058-4294-3

